


FED. ROAD DIST. NO.	STATE	PROJ. NO.	FISCAL YEAR	SHEET NO.	TOTAL SHEETS
HAWAII	HAW.	580A-01-06M	2006	15	28

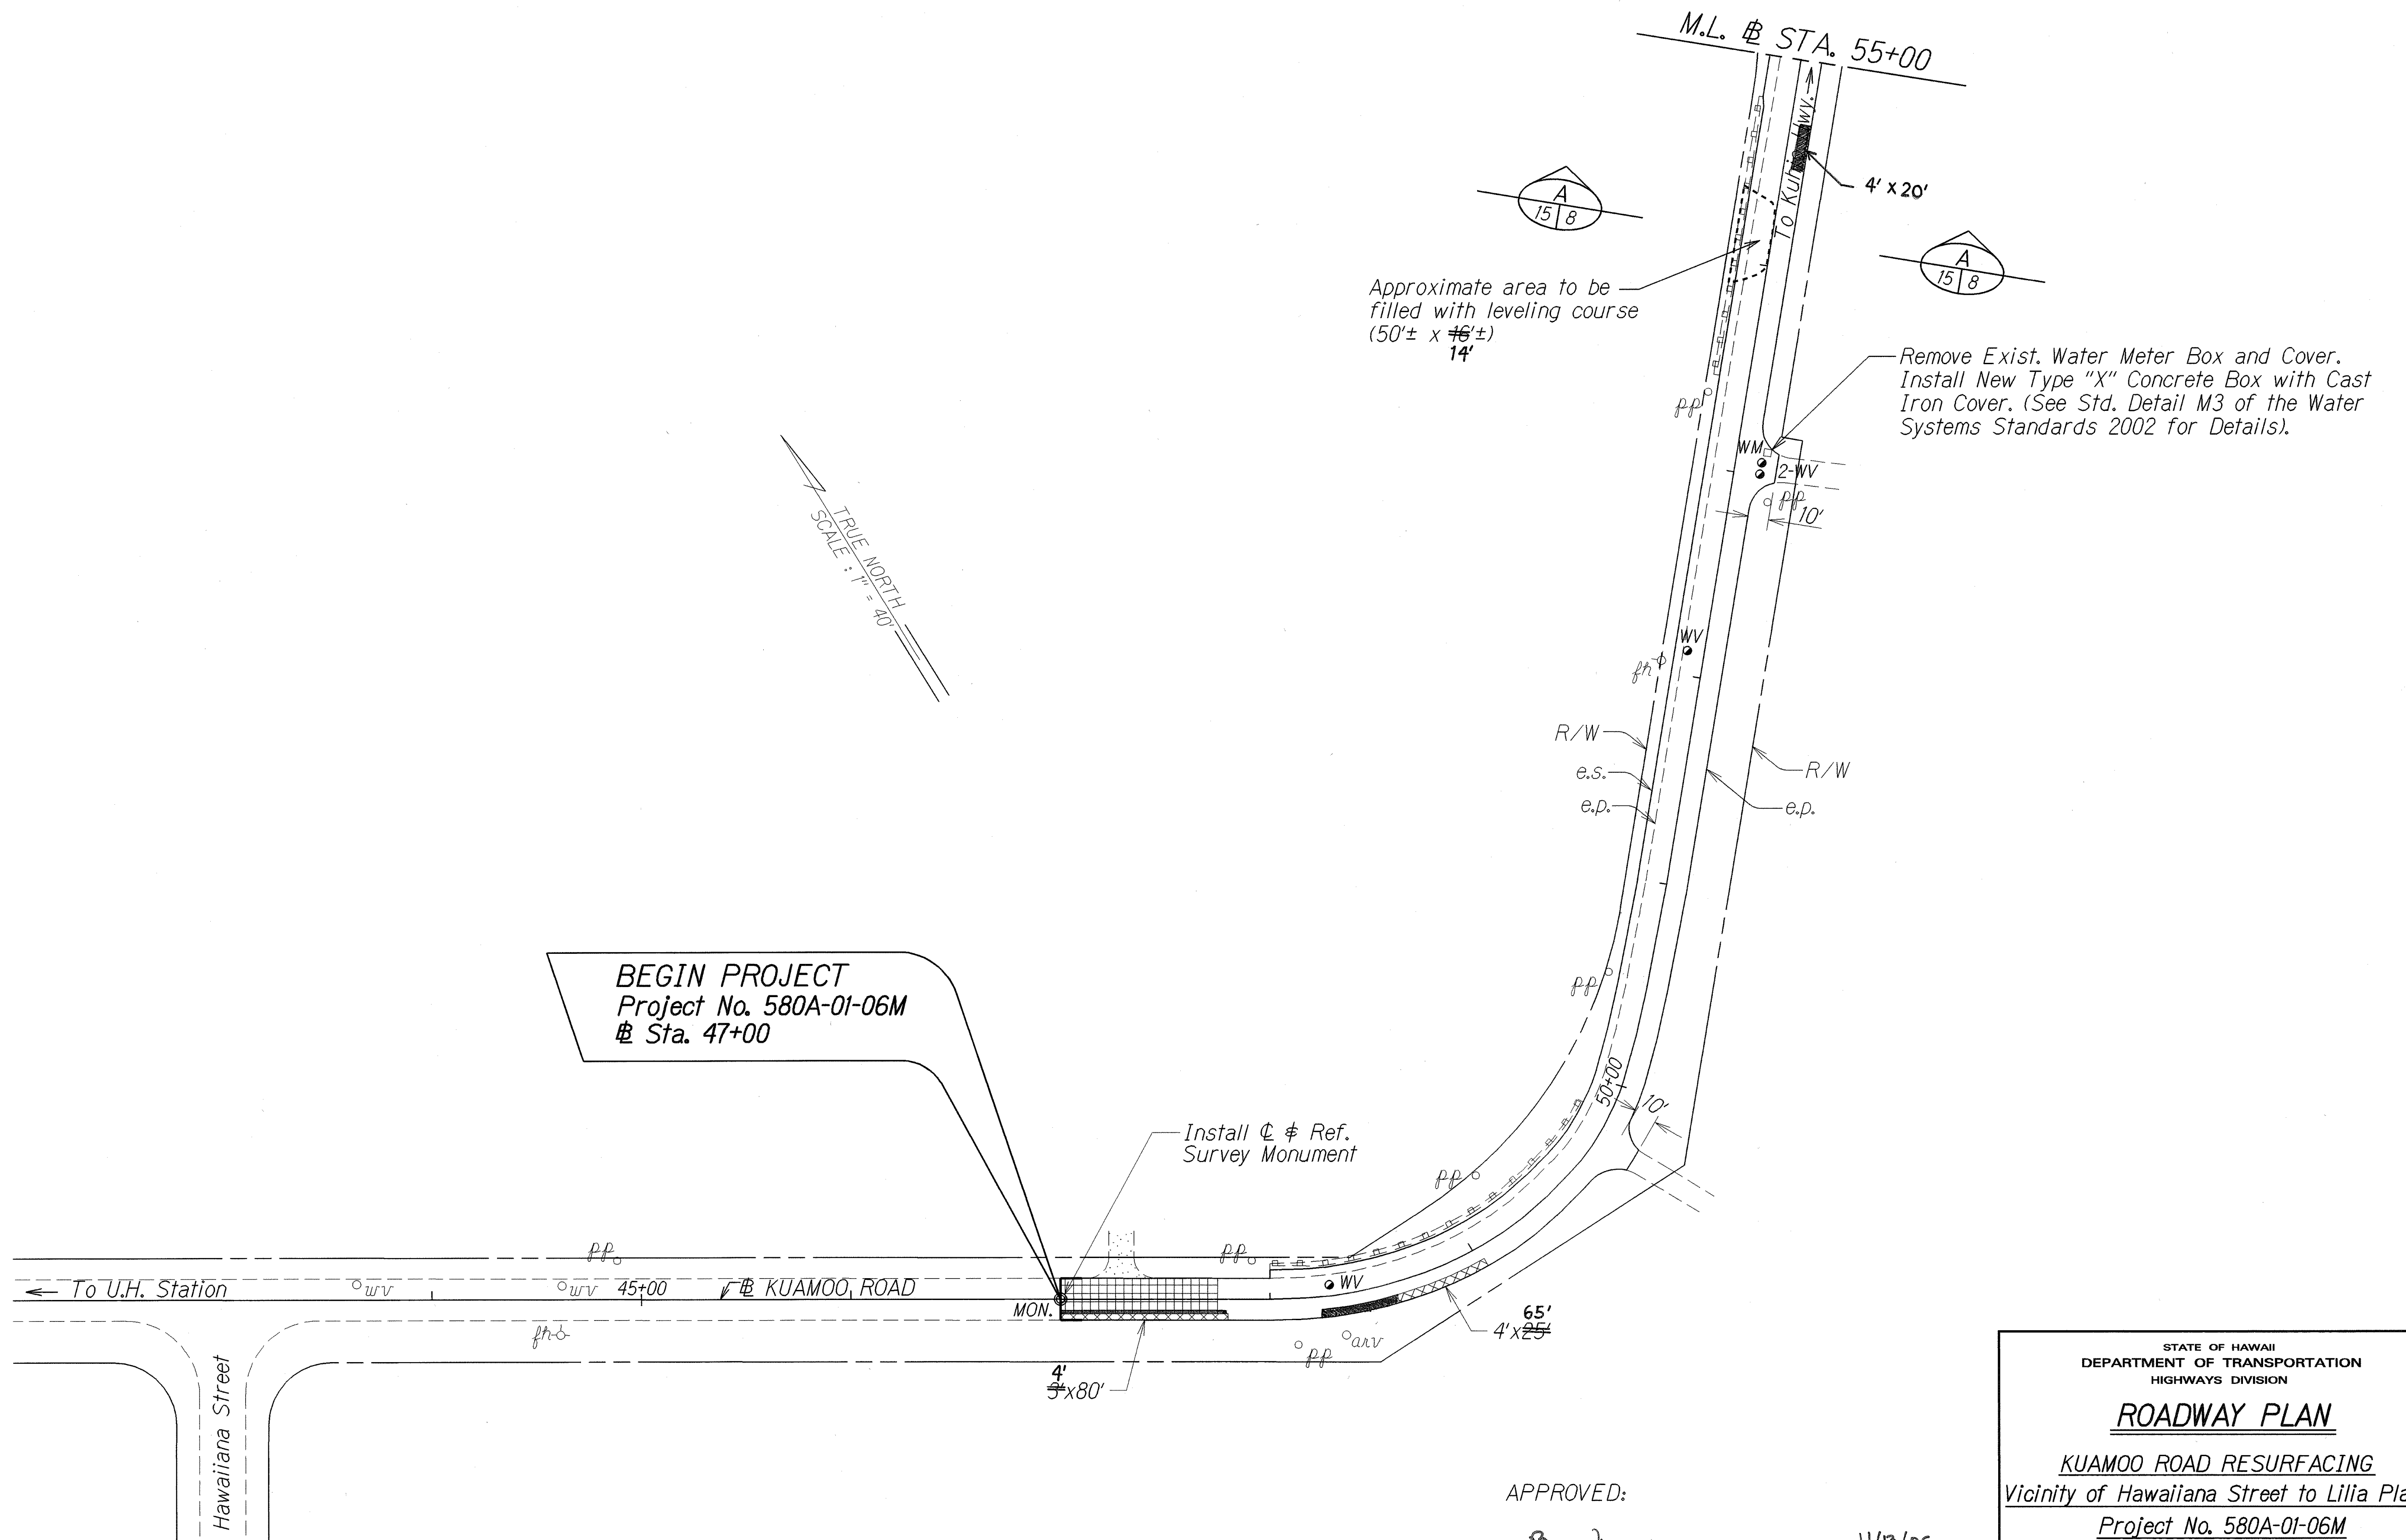


APPROVED: *Bruce Inoué* 4/13/06
 for Manager & Chief Engineer Date
 Department of Water

STATE OF HAWAII
 DEPARTMENT OF TRANSPORTATION
 HIGHWAYS DIVISION
ROADWAY PLAN
 KUAMOO ROAD RESURFACING
 Vicinity of Hawaiiana Street to Lilia Place
 Project No. 580A-01-06M
 Scale: 1" = 40' Date: March 2006
 SHEET No. 1 OF 6 SHEETS

ORIGINAL PLAN	SURVEY PLOTTED BY	DATE
NOTE BOOK	DRAWN BY	10/05
RELATION	DESIGNED BY	
NO.	QUANTITIES BY	
	CHECKED BY	

"AS-BUILT"

FED. ROAD DIST. NO.	STATE	PROJ. NO.	FISCAL YEAR	SHEET NO.	TOTAL SHEETS
HAWAII	HAW.	580A-01-06M	2006	16	28

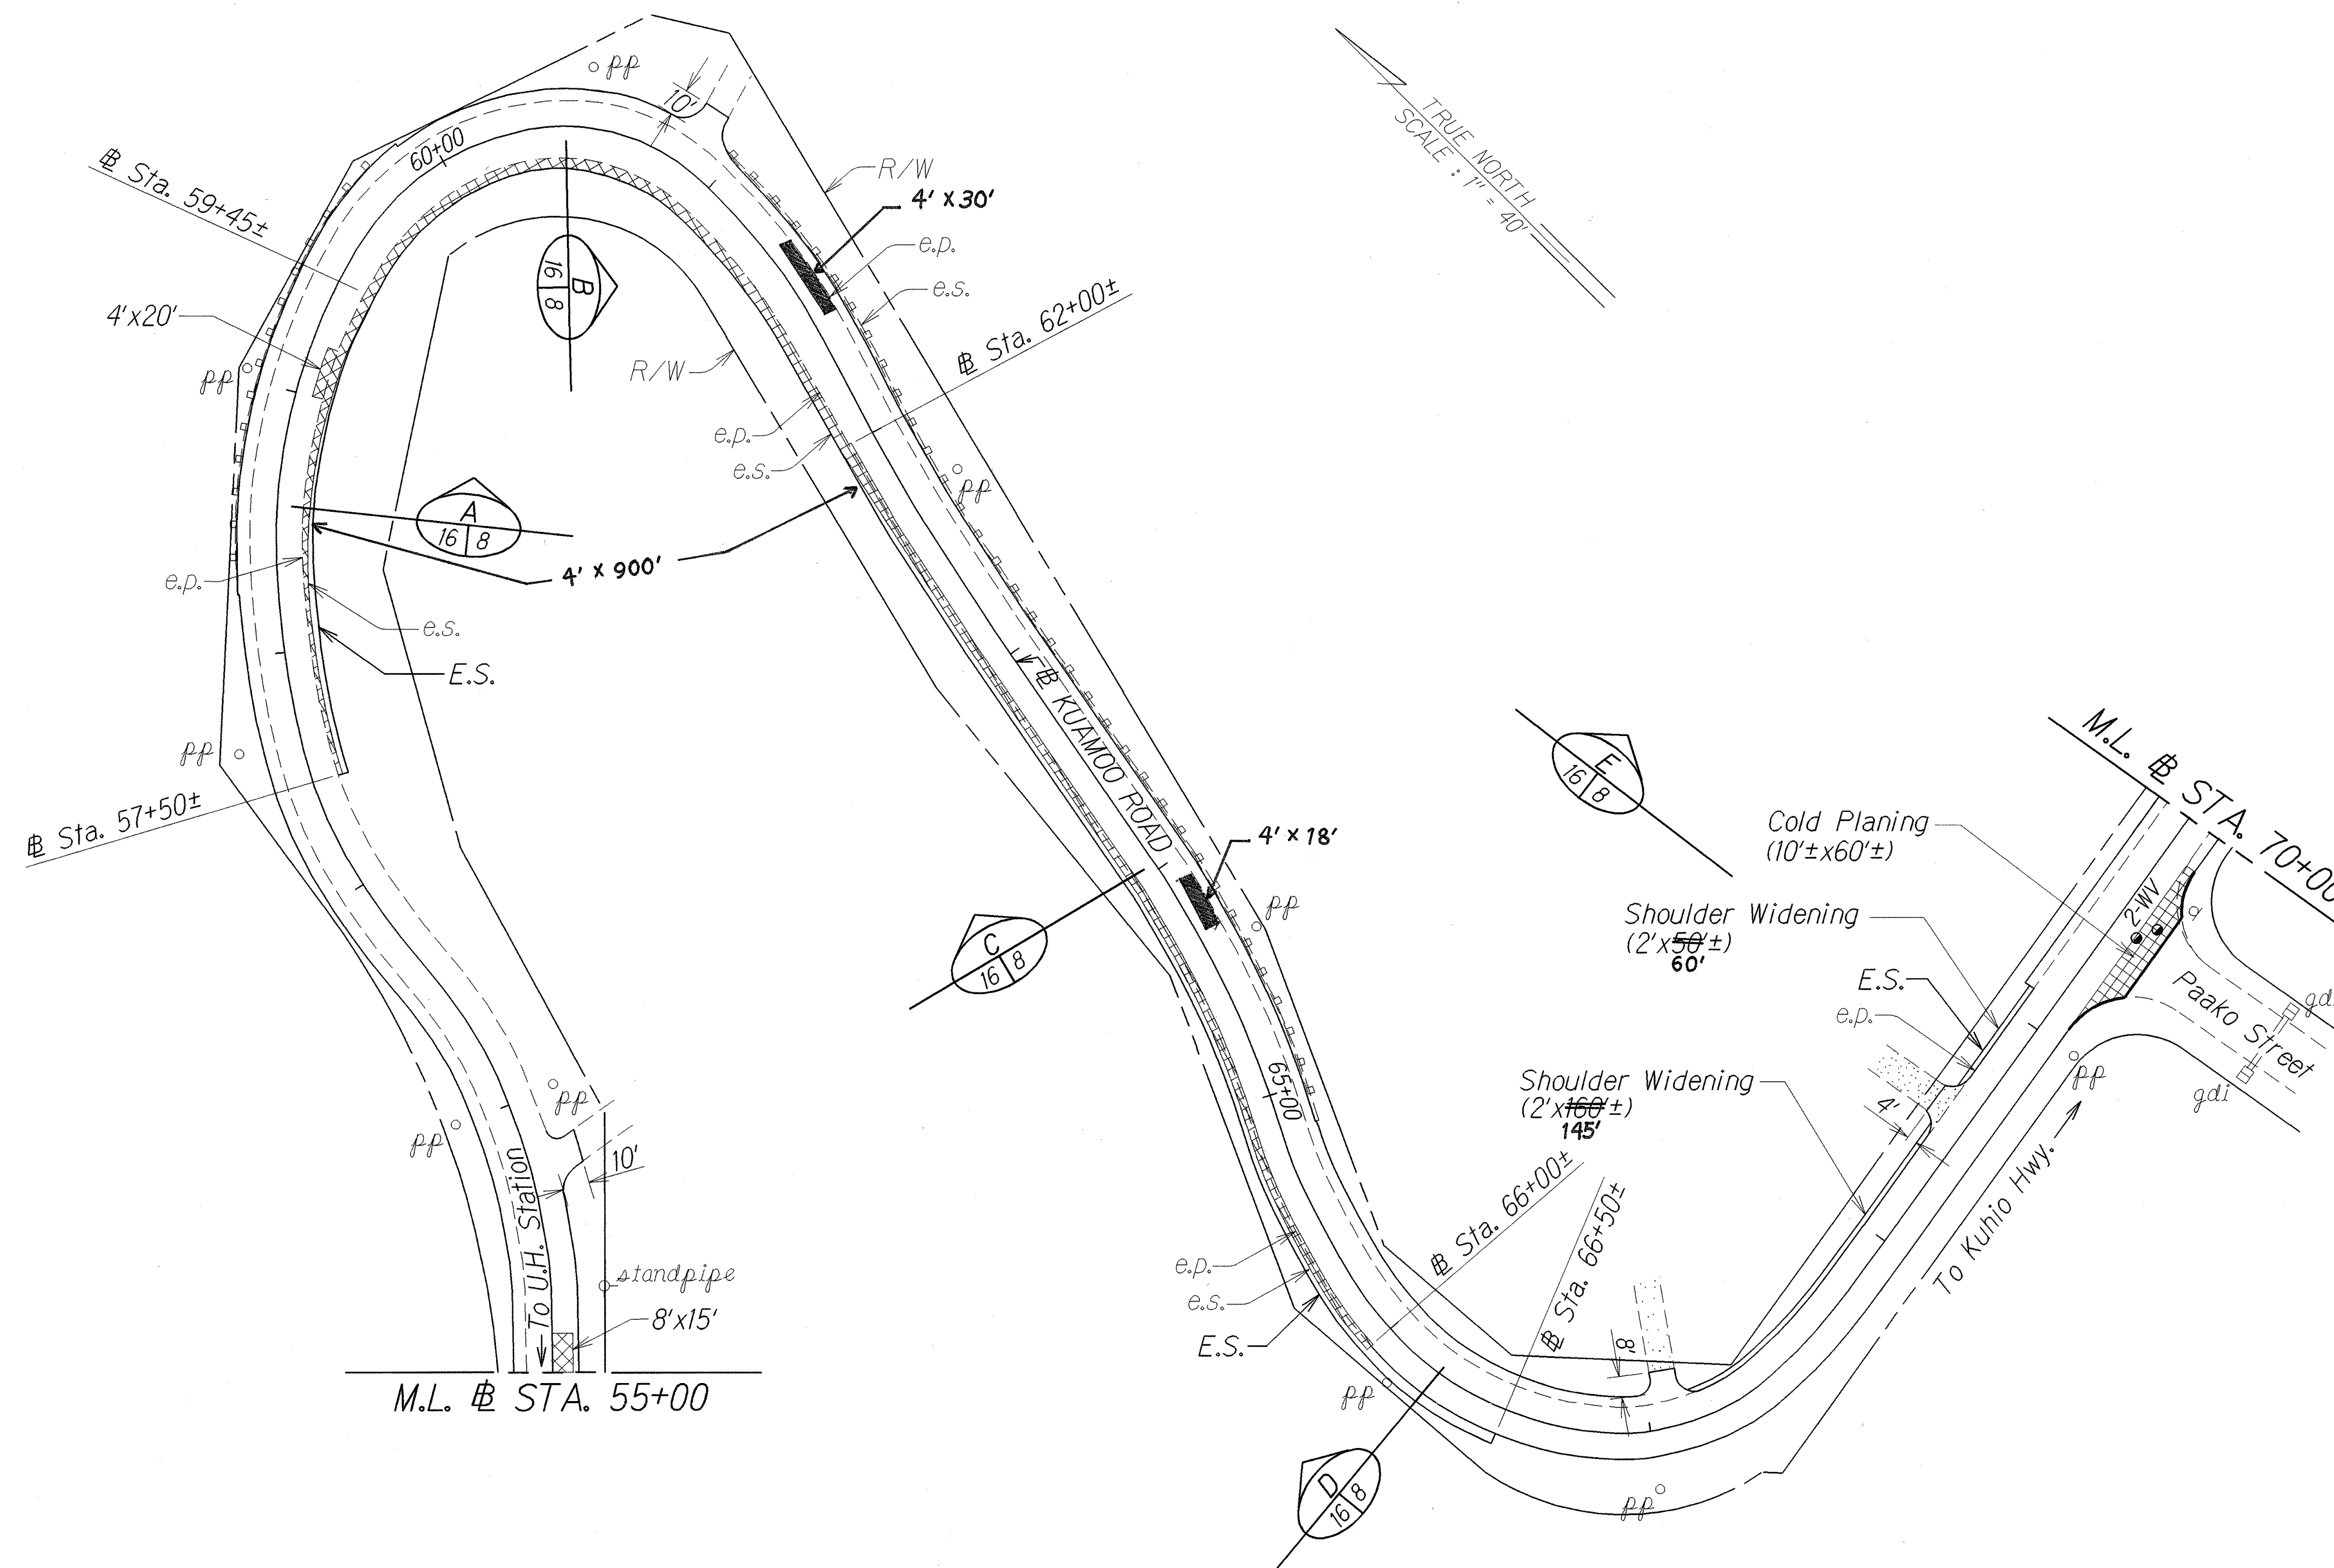

ORIGINAL PLAN	SURVEY PLOTTED BY	DATE
NOTE BOOK	DESIGNED BY	
	QUANTITIES BY	
	CHECKED BY	

APPROVED:
for Manager & Chief Engineer
Department of Water
Date: 4/13/06

STATE OF HAWAII
DEPARTMENT OF TRANSPORTATION
HIGHWAYS DIVISION

ROADWAY PLAN

KUAMOO ROAD RESURFACING
Vicinity of Hawaiiana Street to Lilia Place
Project No. 580A-01-06M



Scale: 1" = 40' Date: March 2006

SHEET No. 2 OF 6 SHEETS

"AS-BUILT"

FED. ROAD DIST. NO.	STATE	PROJ. NO.	FISCAL YEAR	SHEET NO.	TOTAL SHEETS
HAWAII	HAW.	580A-01-06M	2006	17	28

TRUE NORTH
SCALE: 1" = 40'

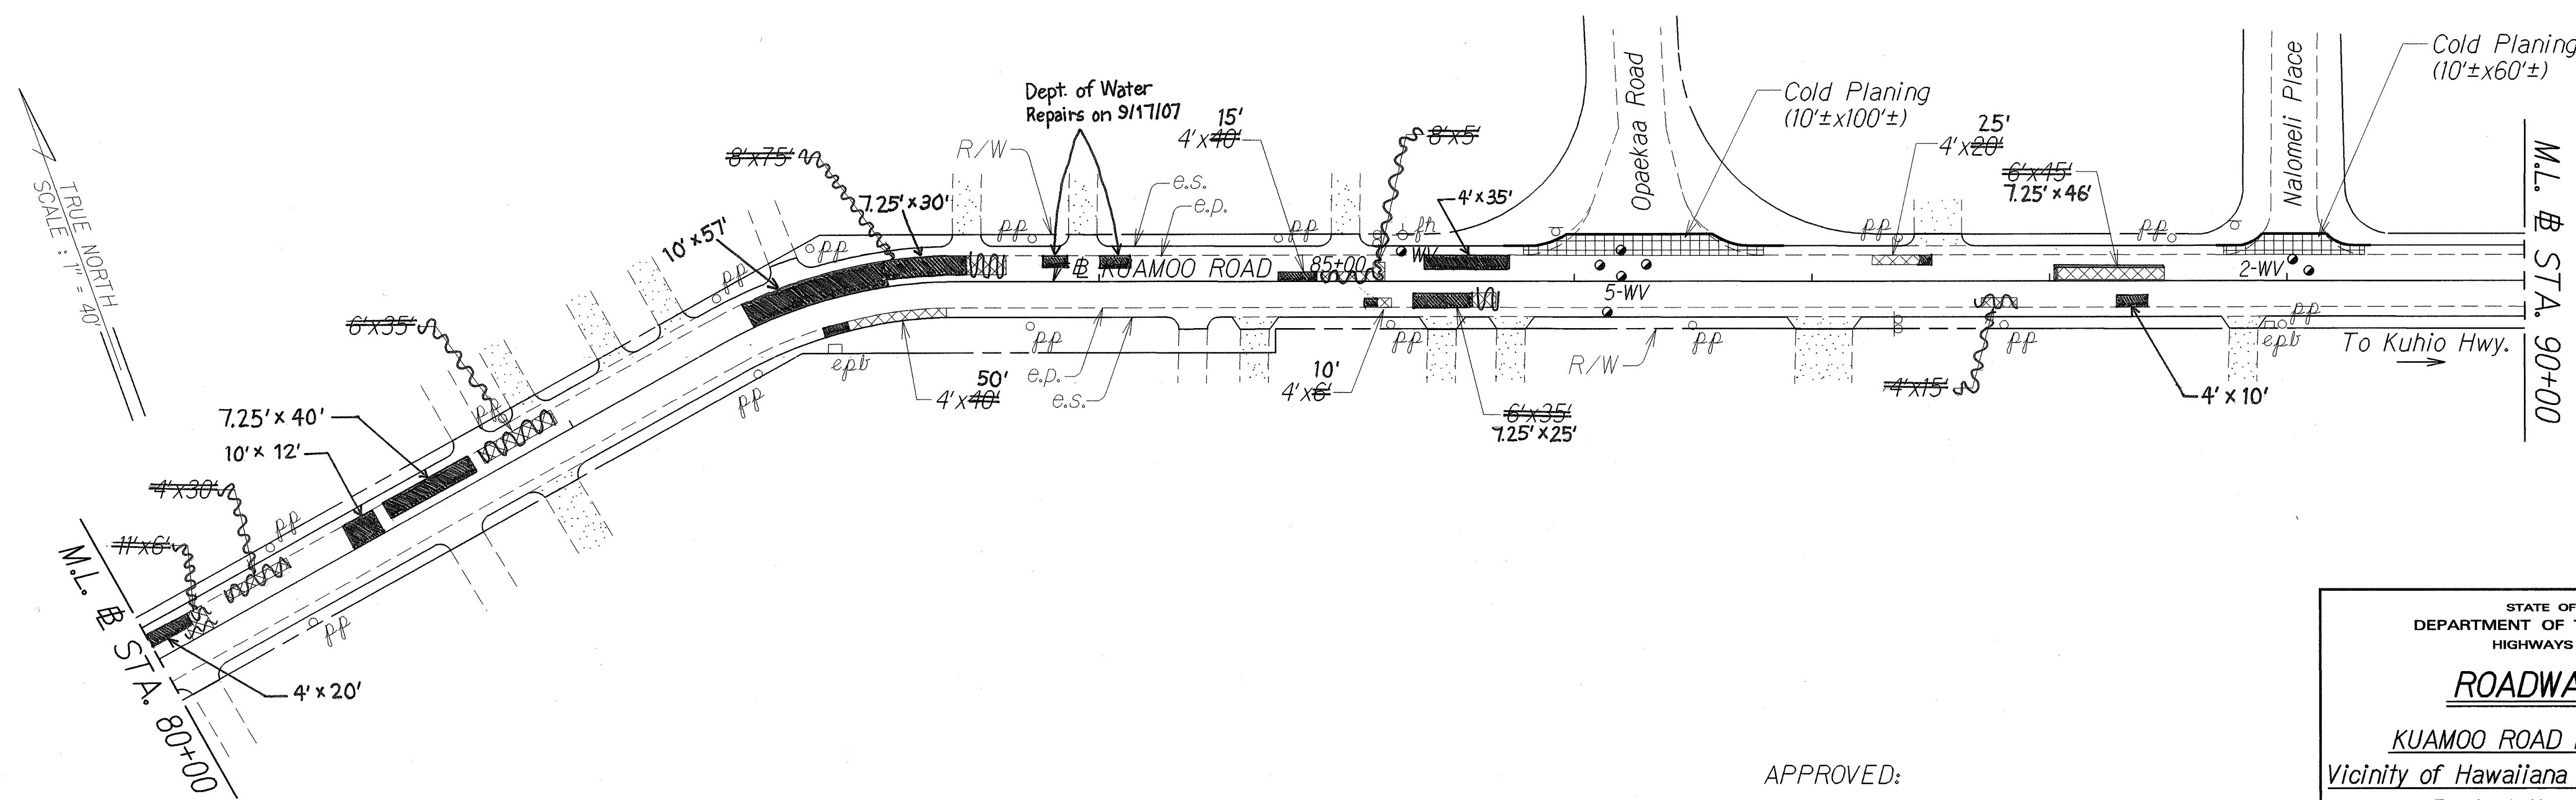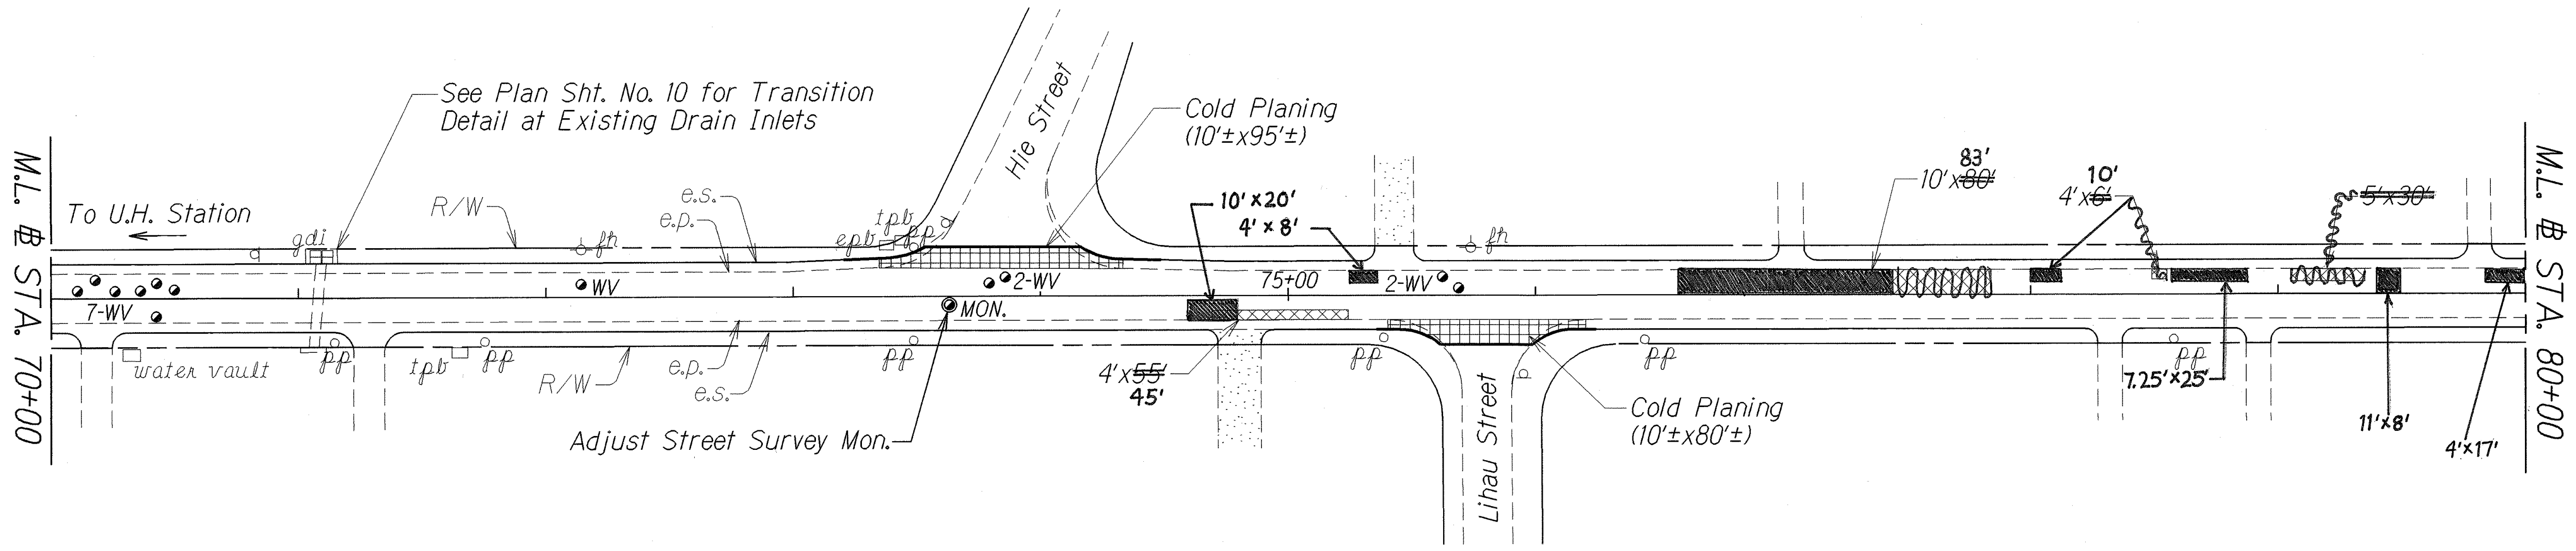

SURVEY PLOTTED BY	DATE
DRAWN BY	10/05
TRACED BY	
NOTED BY	
QUANTITIES BY	
CHECKED BY	

APPROVED:

for Bruce Inoué 4/13/06
Manager & Chief Engineer Date
Department of Water

STATE OF HAWAII
DEPARTMENT OF TRANSPORTATION
HIGHWAYS DIVISION

ROADWAY PLAN



KUAMOO ROAD RESURFACING
Vicinity of Hawaiiana Street to Lilia Place
Project No. 580A-01-06M

Scale: 1" = 40' Date: March 2006

SHEET No. 3 OF 6 SHEETS

"AS-BUILT"

FED. ROAD DIST. NO.	STATE	PROJ. NO.	FISCAL YEAR	SHEET NO.	TOTAL SHEETS
HAWAII	HAW.	580A-01-06M	2006	18	28

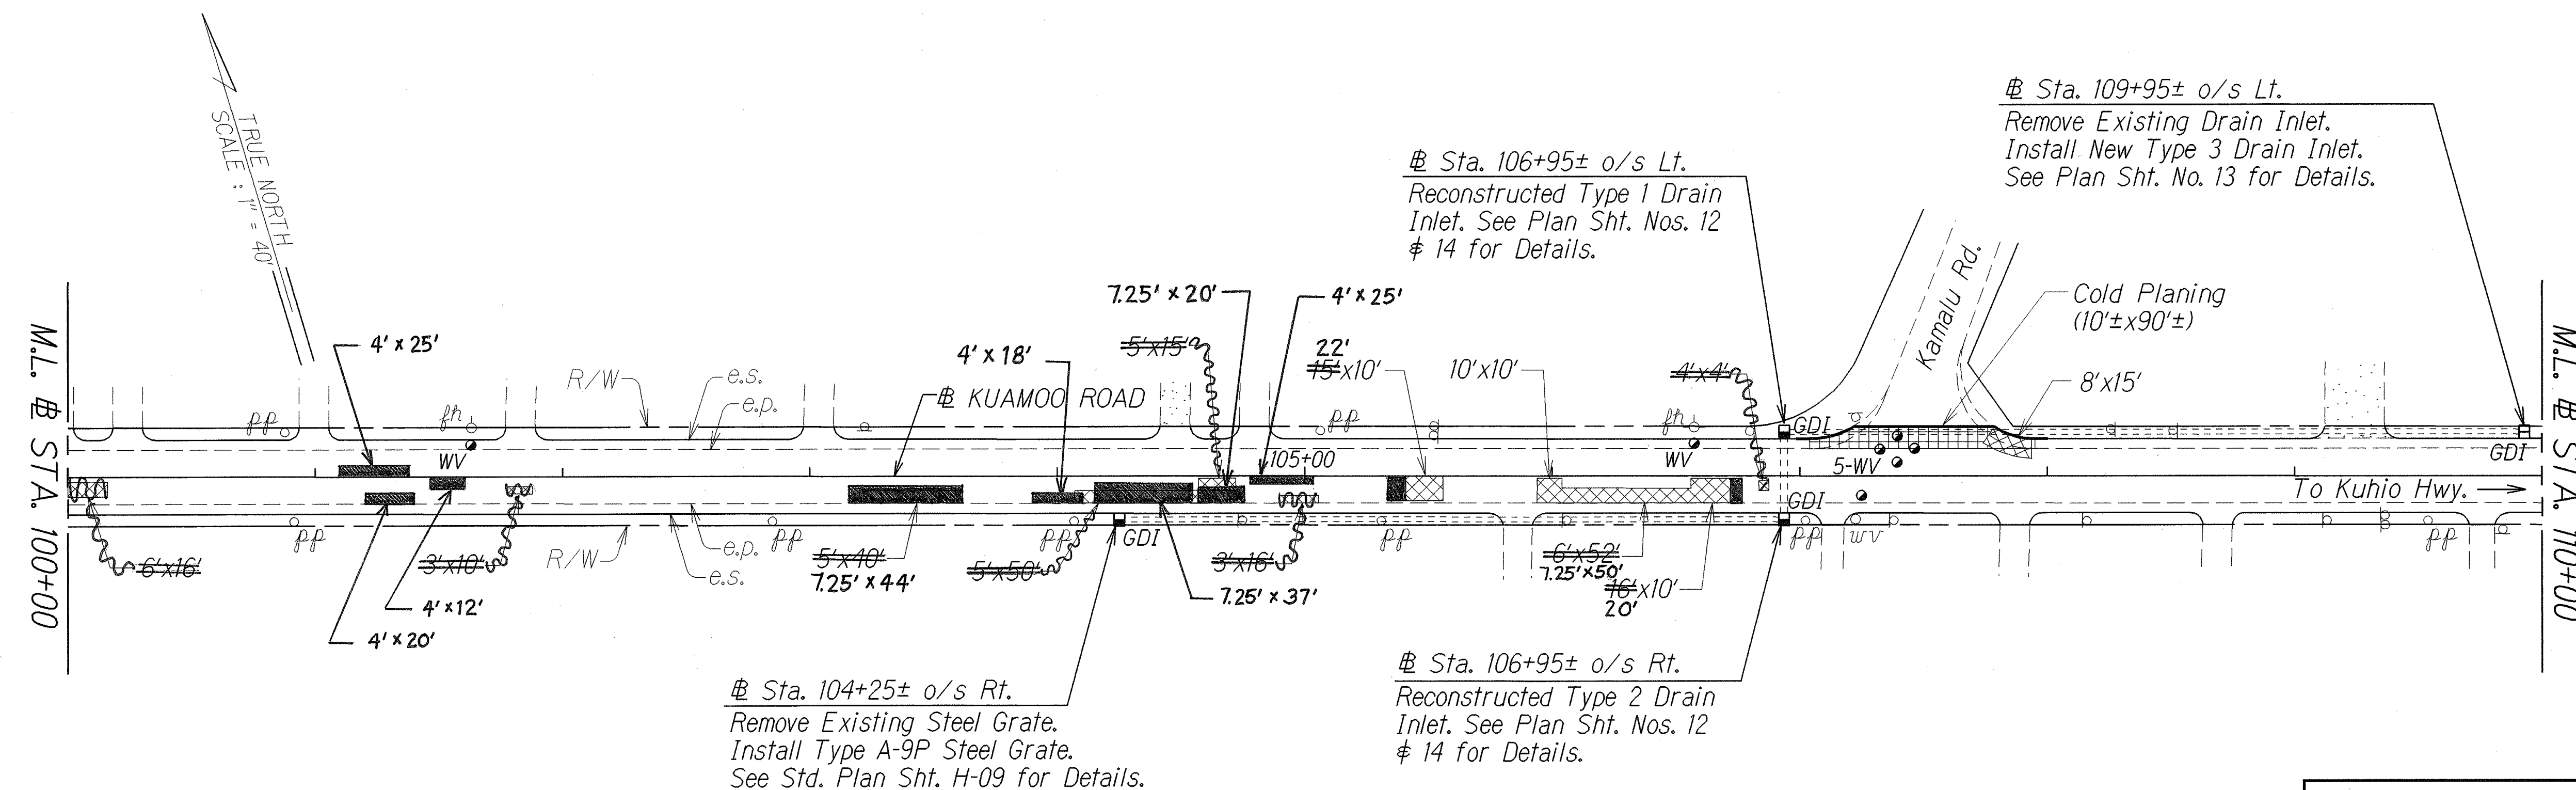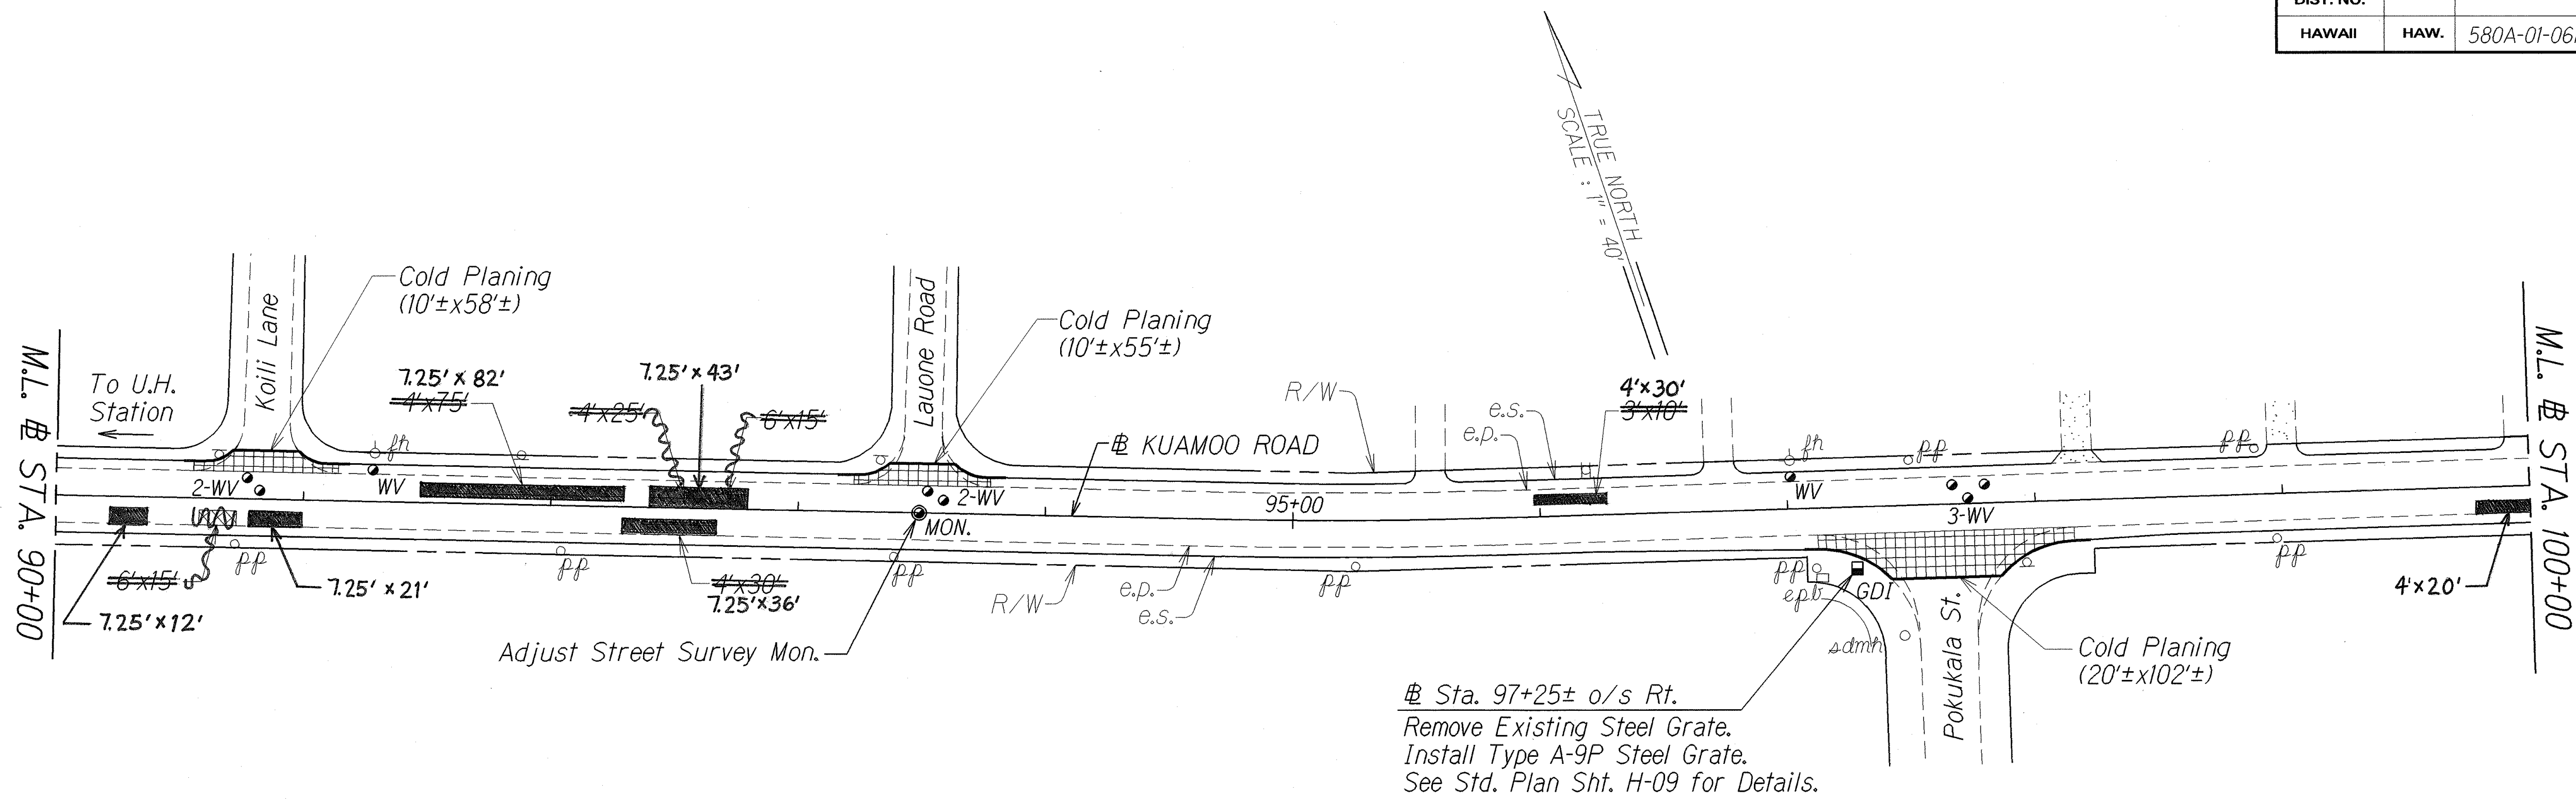

ORIGINAL PLAN	DATE	10/05
SURVEY PLOTTED BY		
DESIGNED BY		
QUANTITIES BY		
CHECKED BY		

APPROVED:

Donna Inoué 4/13/06
for Manager & Chief Engineer Date
Department of Water

STATE OF HAWAII
DEPARTMENT OF TRANSPORTATION
HIGHWAYS DIVISION

ROADWAY PLAN



KUAMOO ROAD RESURFACING
Vicinity of Hawaiiana Street to Lilia Place
Project No. 580A-01-06M

Scale: 1" = 40' Date: March 2006

SHEET No. 4 OF 6 SHEETS

"AS-BUILT"

FED. ROAD DIST. NO.	STATE	PROJ. NO.	FISCAL YEAR	SHEET NO.	TOTAL SHEETS
HAWAII	HAW.	580A-01-06M	2006	19	28

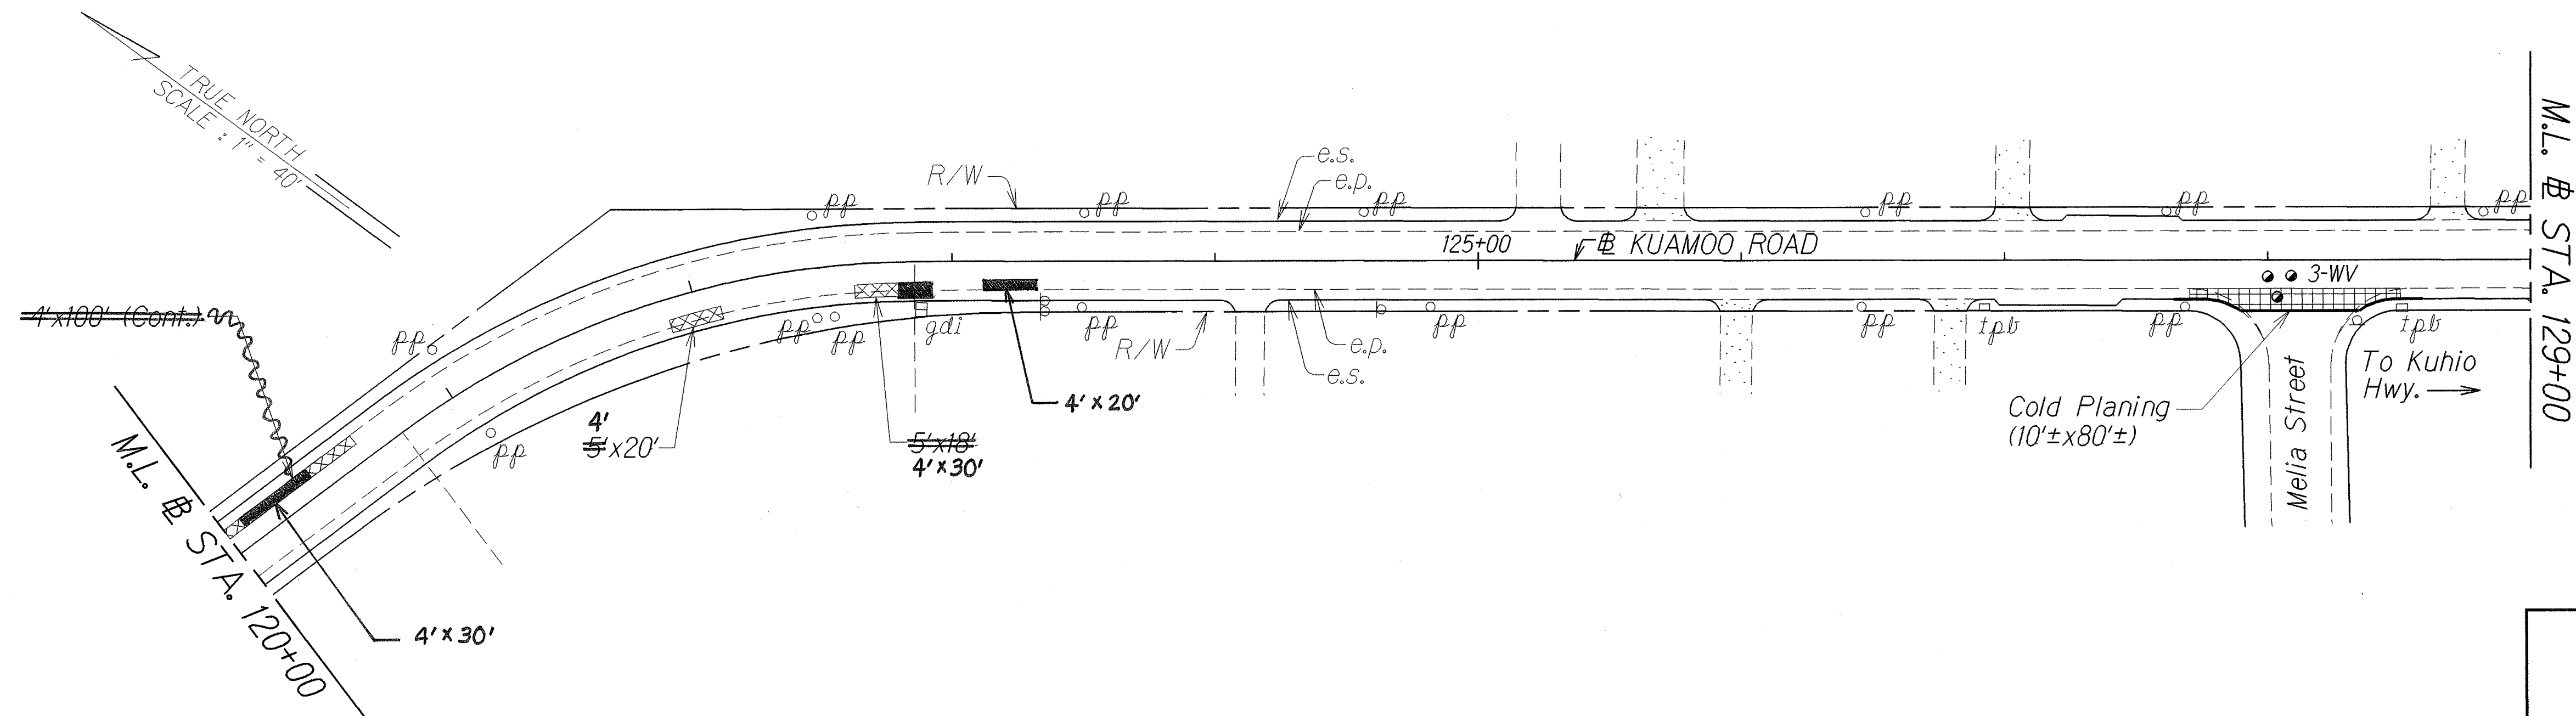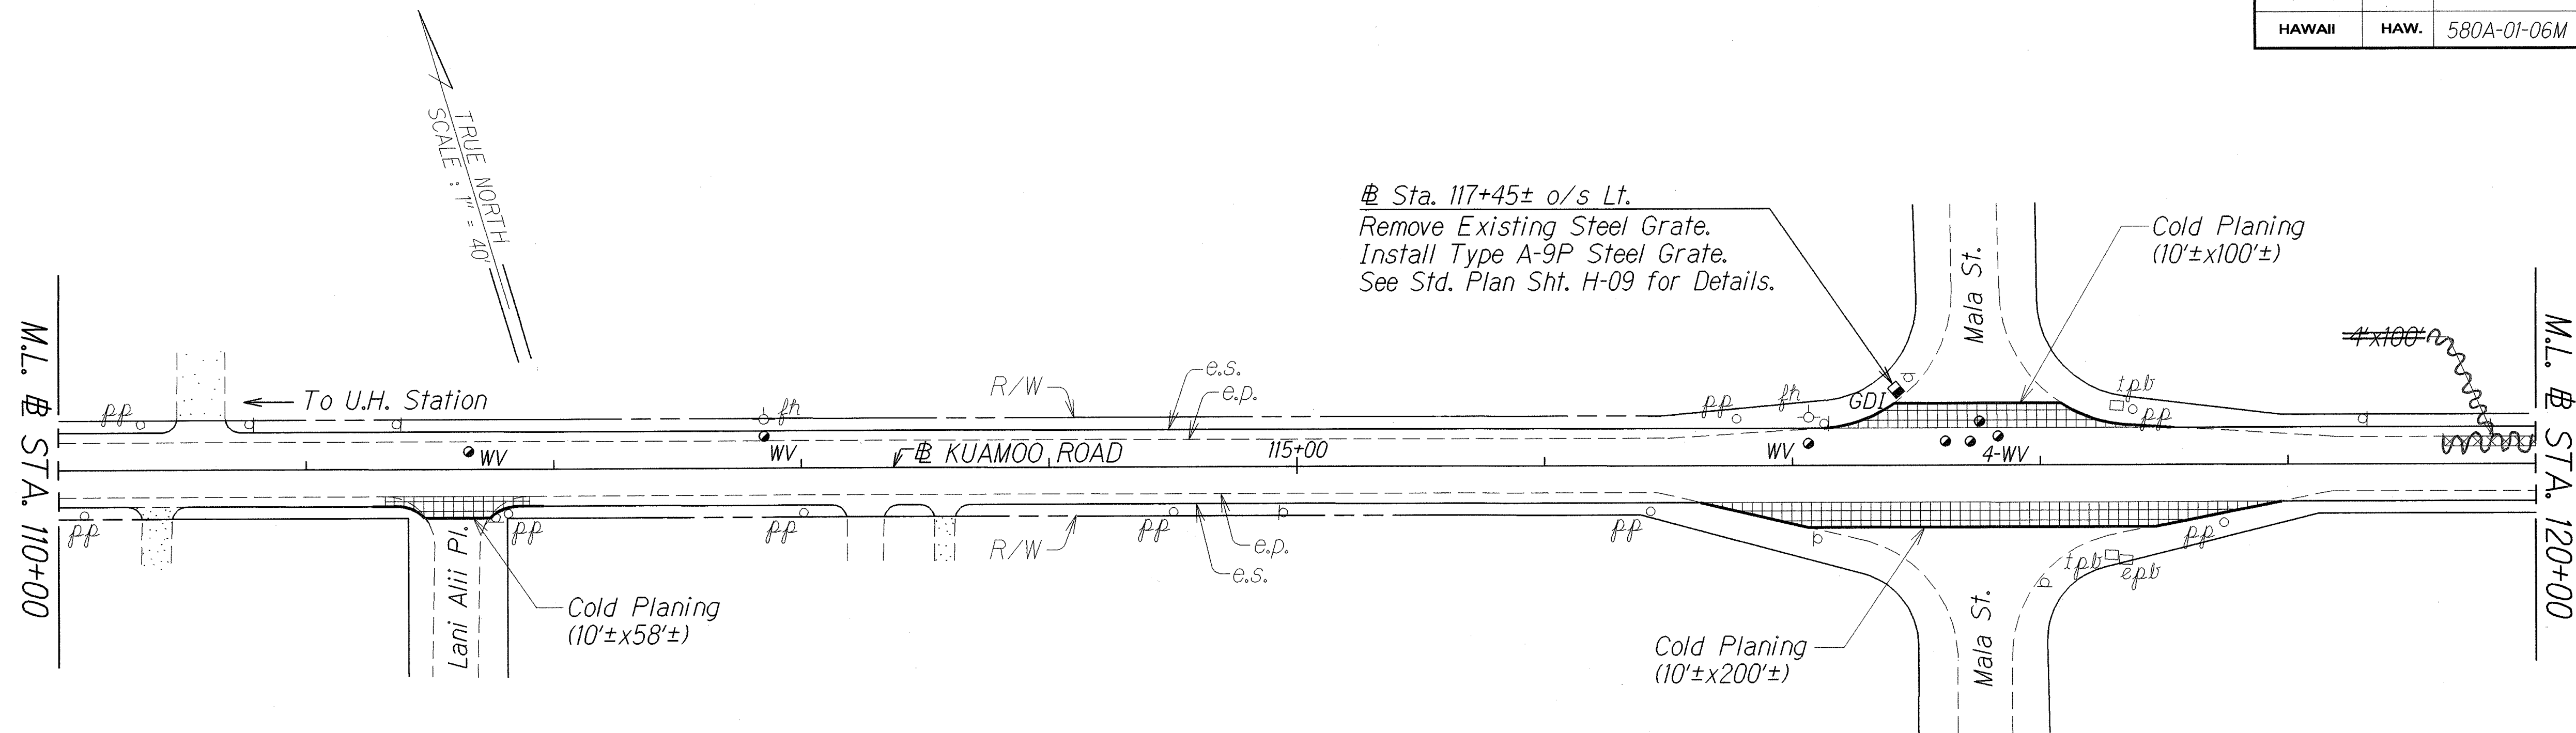

ORIGINAL PLAN	SURVEY PLOTTED BY	DATE
NOTE BOOK	DRAWN BY	10/05
REVISION	TRACED BY	
CHECKED BY	QUANTITIES BY	
	CHECKED BY	



APPROVED:

Bruce Inoué 4/13/06
for Manager & Chief Engineer Date
Department of Water

STATE OF HAWAII
DEPARTMENT OF TRANSPORTATION
HIGHWAYS DIVISION
ROADWAY PLAN
KUAMOO ROAD RESURFACING
Vicinity of Hawaiiana Street to Lilia Place
Project No. 580A-01-06M
Scale: 1" = 40' Date: March 2006
SHEET No. 5 OF 6 SHEETS

"AS-BUILT"

FED. ROAD DIST. NO.	STATE	PROJ. NO.	FISCAL YEAR	SHEET NO.	TOTAL SHEETS
HAWAII	HAW.	580A-01-06M	2006	20	28

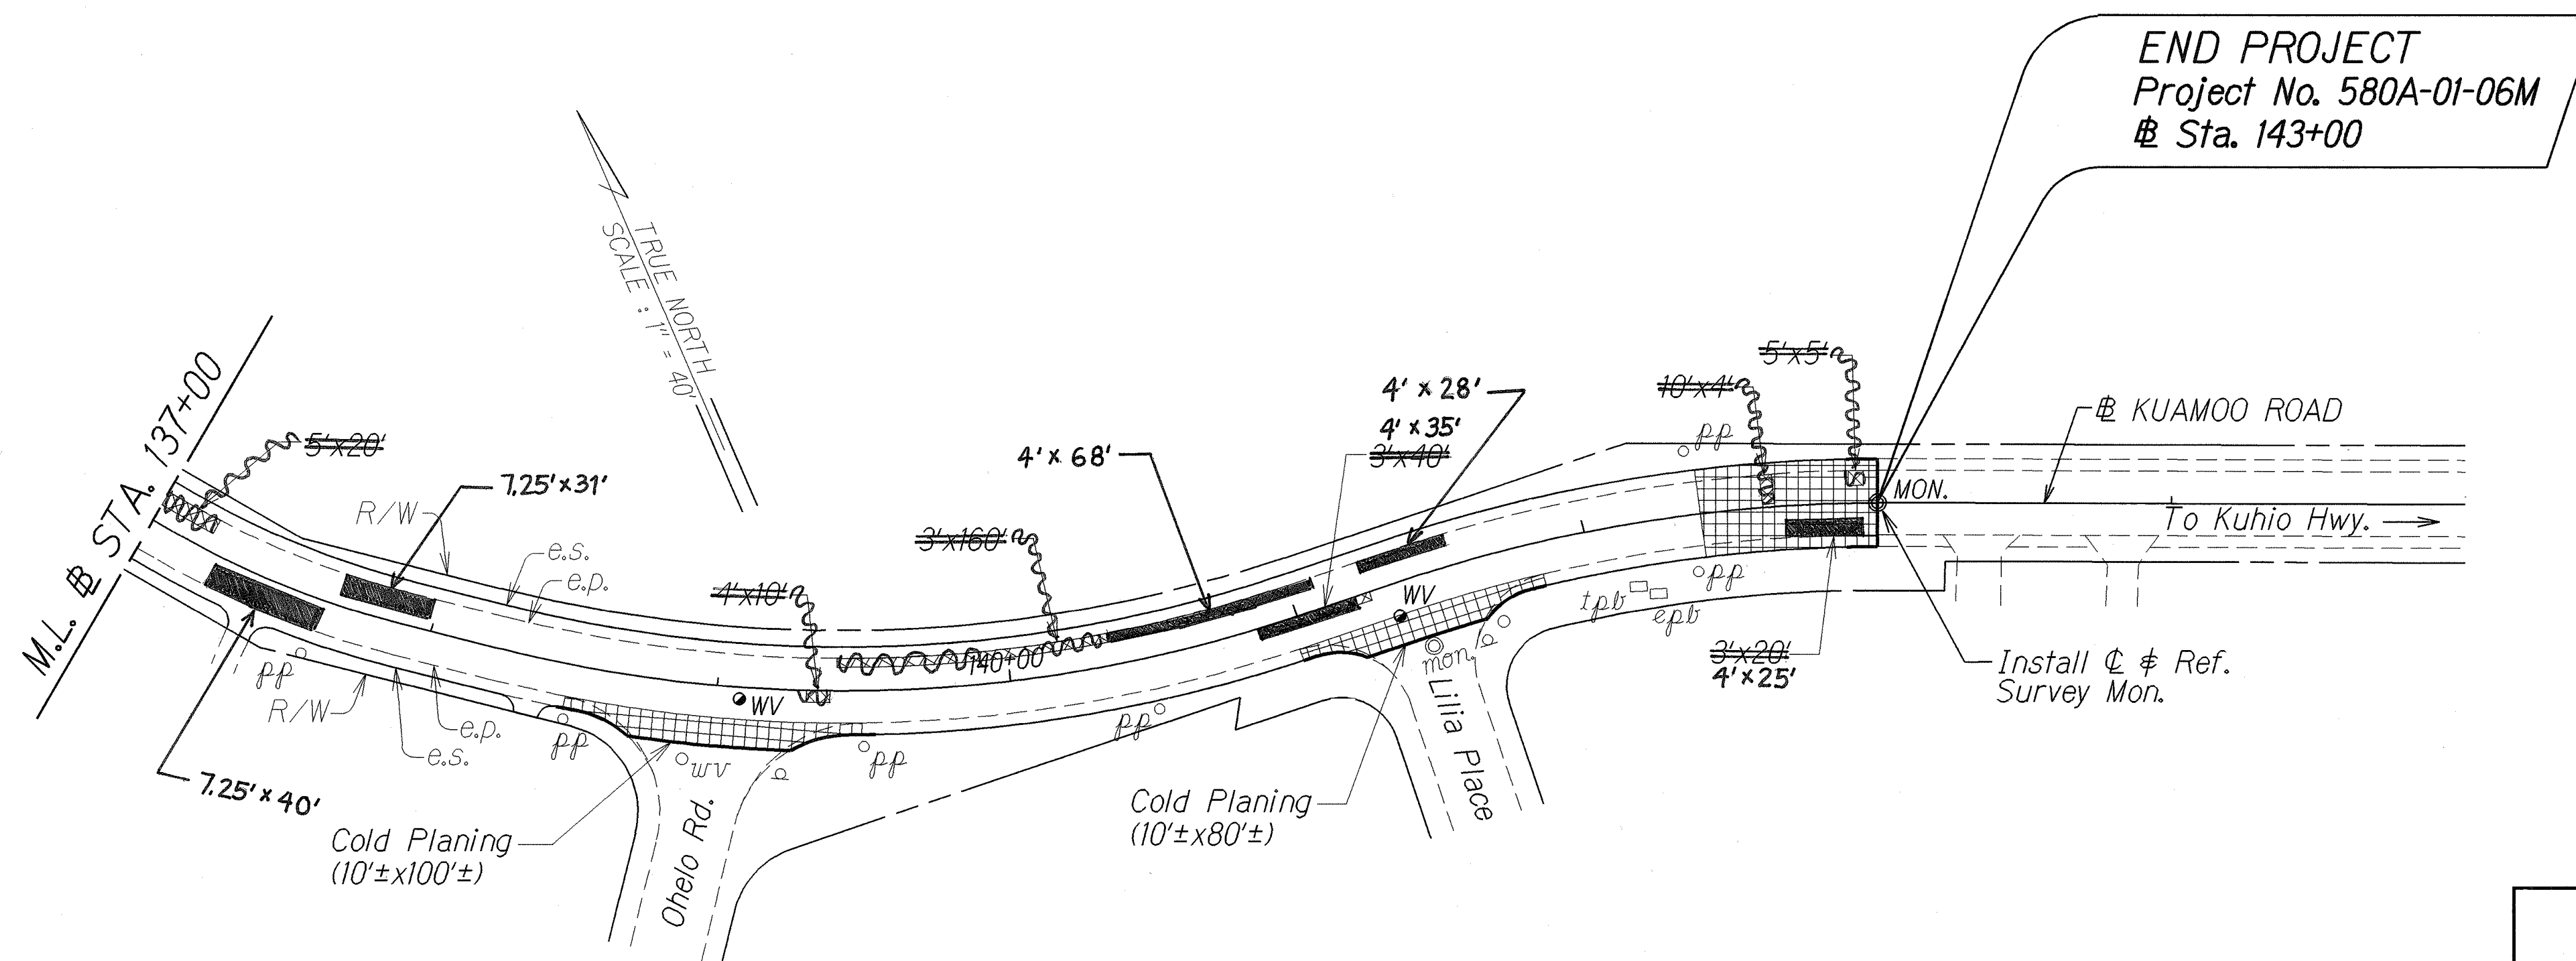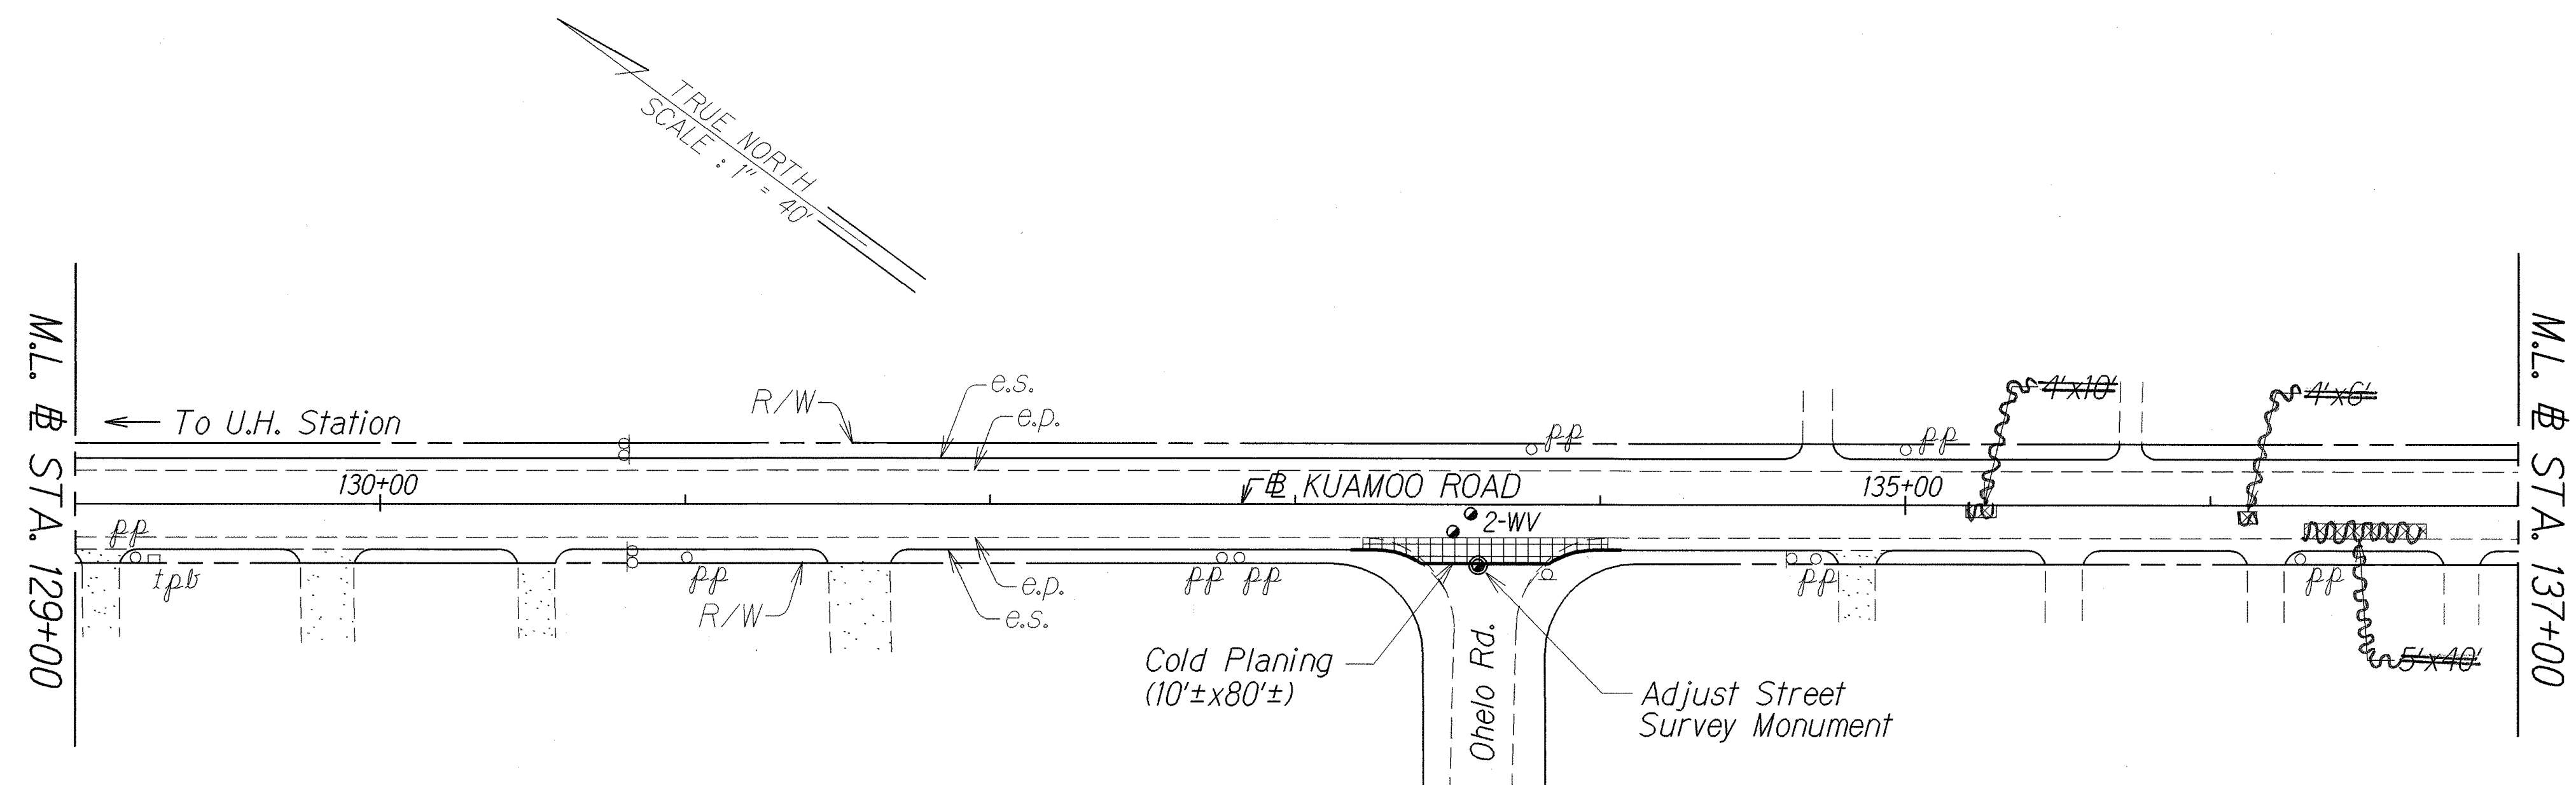

ORIGINAL PLAN	SURVEY PLOTTED BY	DATE
NOTE BOOK	DRAWN BY	10/05
DESIGNED BY	CHECKED BY	
QUANTITIES BY		

APPROVED: Bruce Inoué 4/13/06
 for Manager & Chief Engineer Date
 Department of Water

STATE OF HAWAII
 DEPARTMENT OF TRANSPORTATION
 HIGHWAYS DIVISION

ROADWAY PLAN

KUAMOO ROAD RESURFACING
 Vicinity of Hawaiiana Street to Lilia Place
 Project No. 580A-01-06M

Scale: 1" = 40' Date: March 2006

SHEET No. 6 OF 6 SHEETS

"AS-BUILT"