

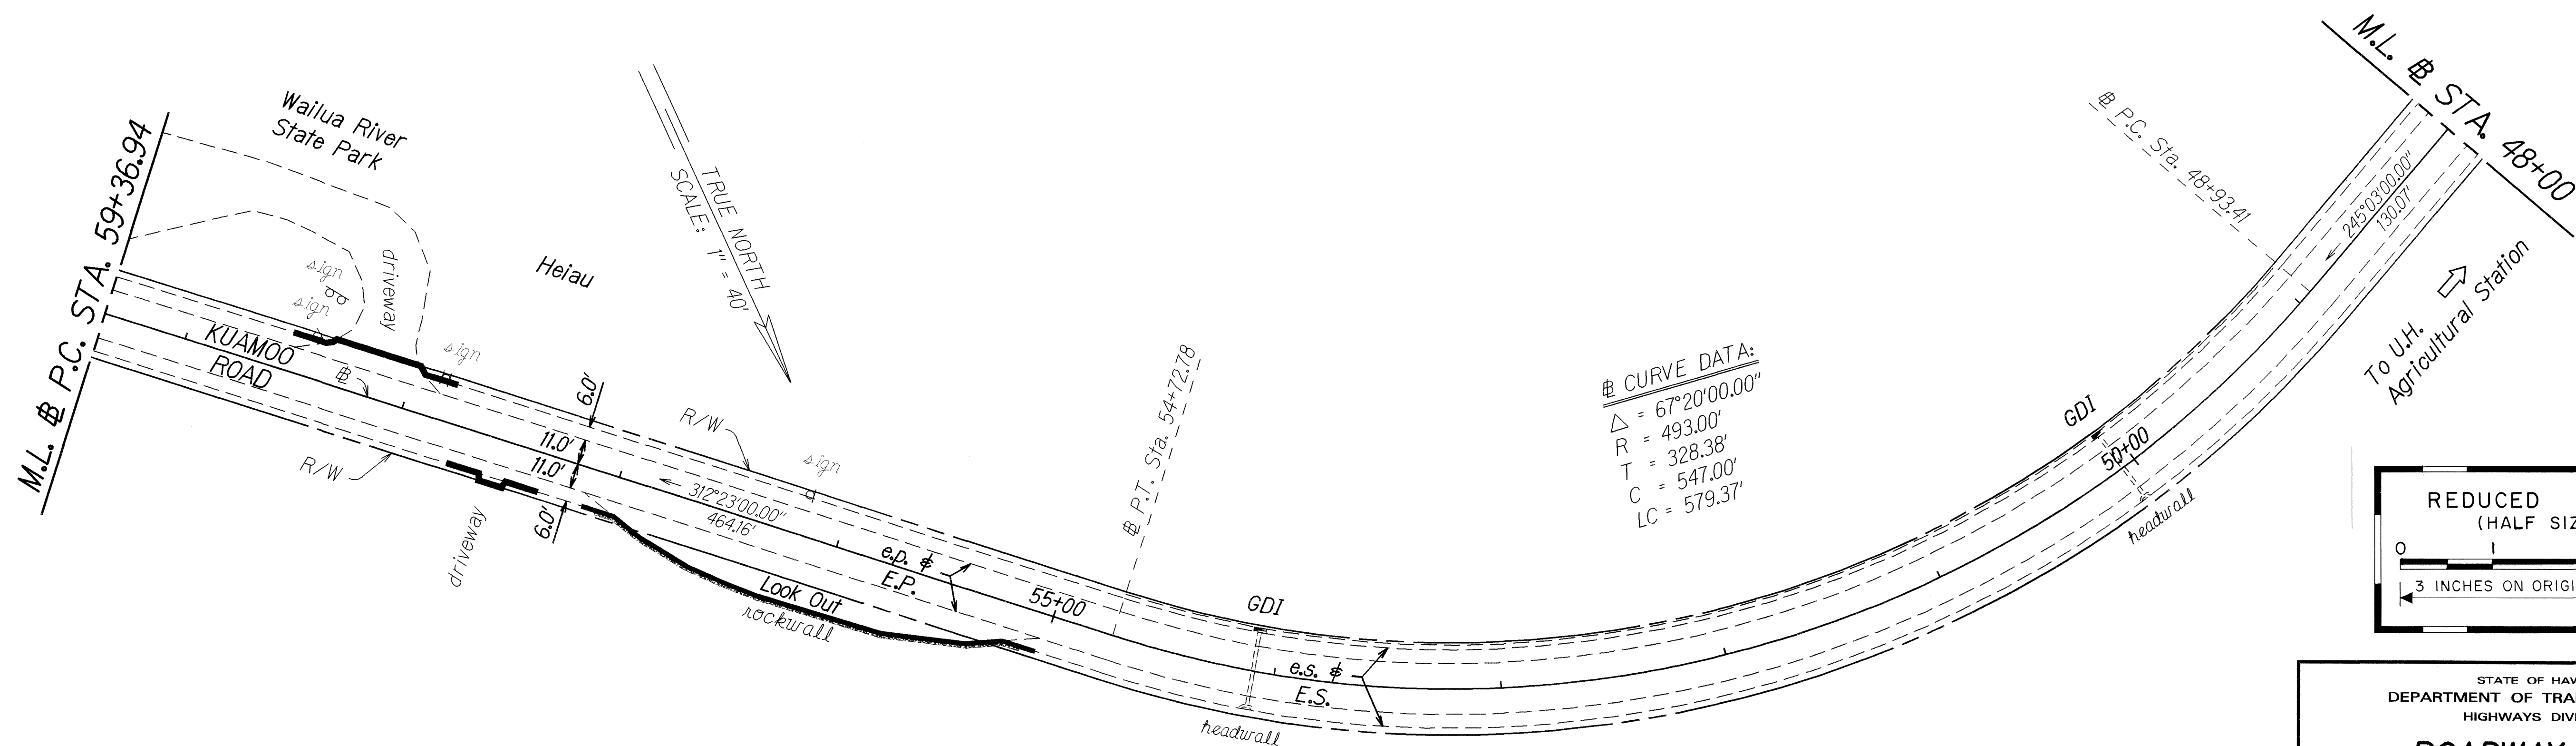


FED. ROAD DIST. NO.	STATE	PROJ. NO.	FISCAL YEAR	SHEET NO.	TOTAL SHEETS
HAWAII	HAW.	580A-01-07M	2007	7	17

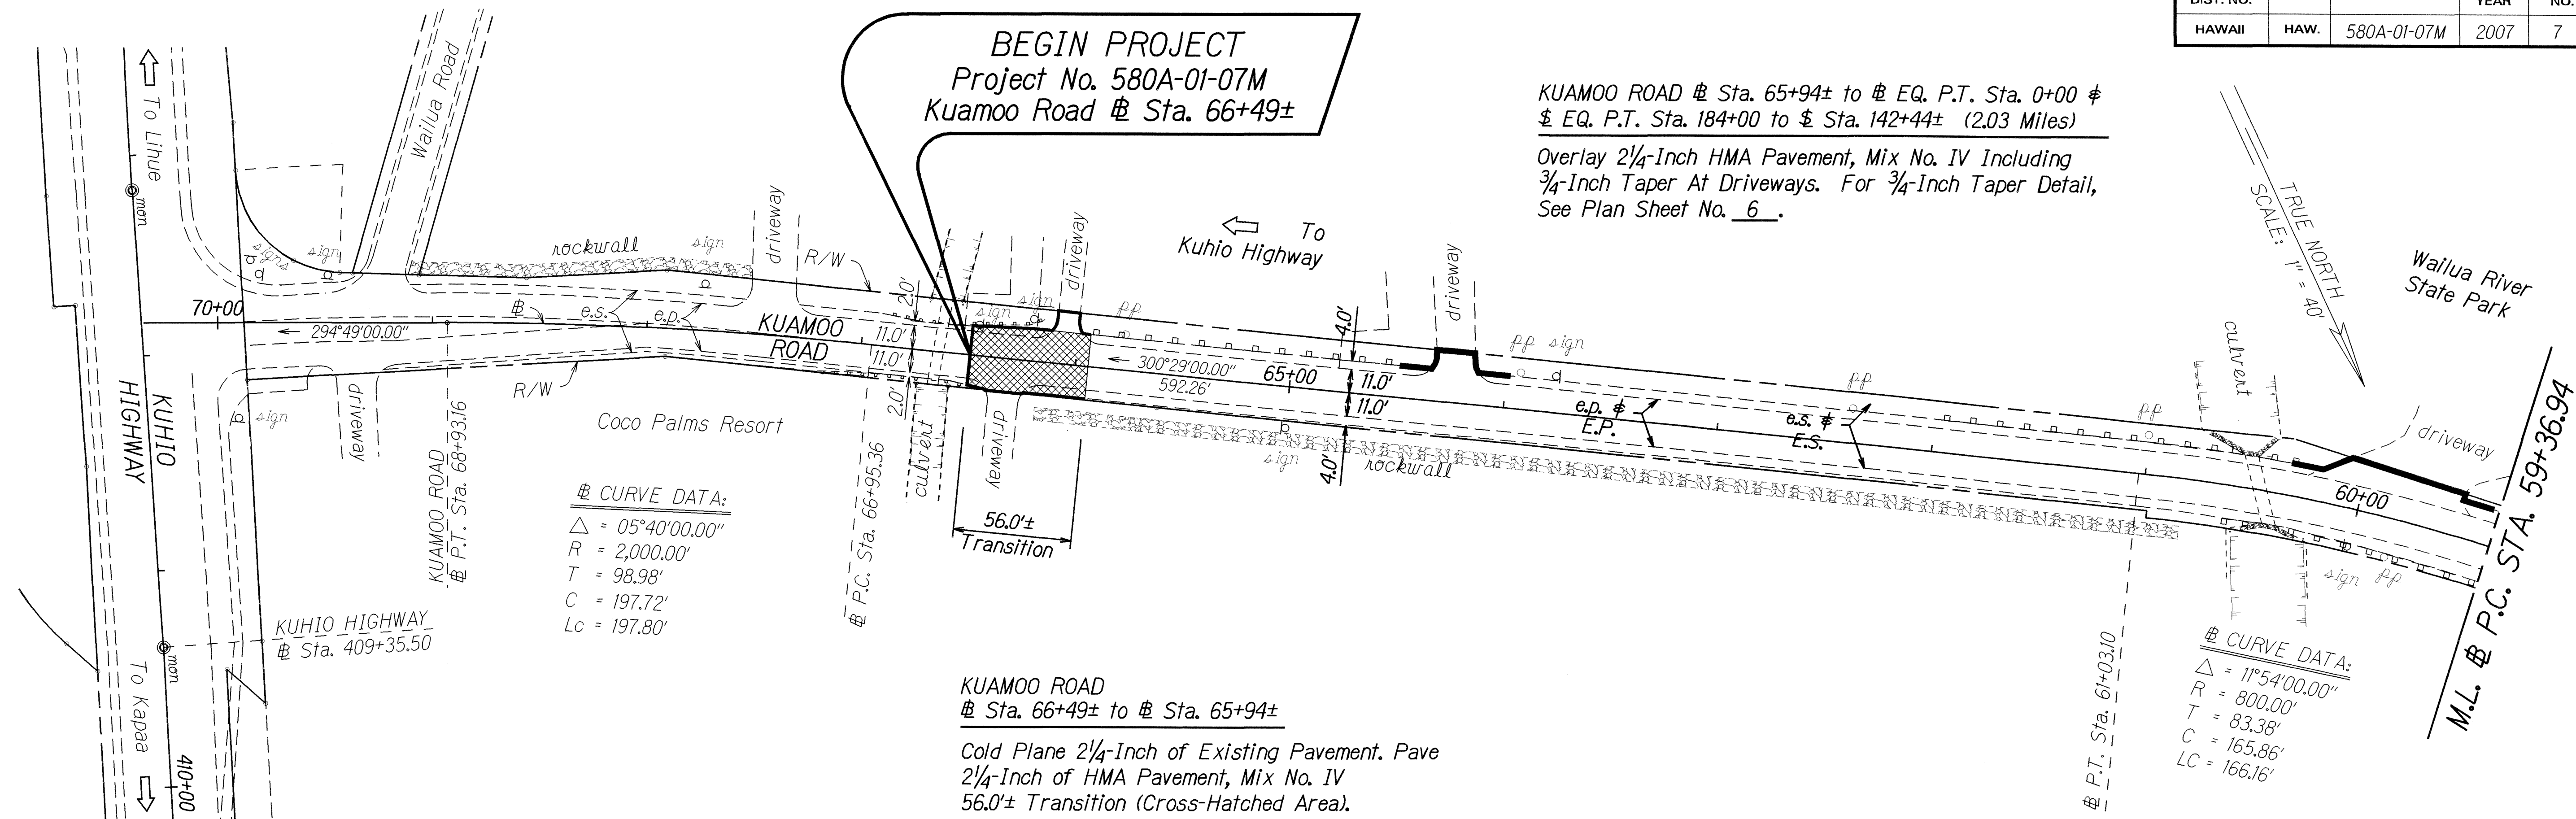

NOTE:
Origin of Azimuths: "NONOU" 

SURVEY PLOTTED BY	DATE
DRAWN BY	02/24/07
DESIGNED BY	MG
QUANTITIES BY	
CHECKED BY	

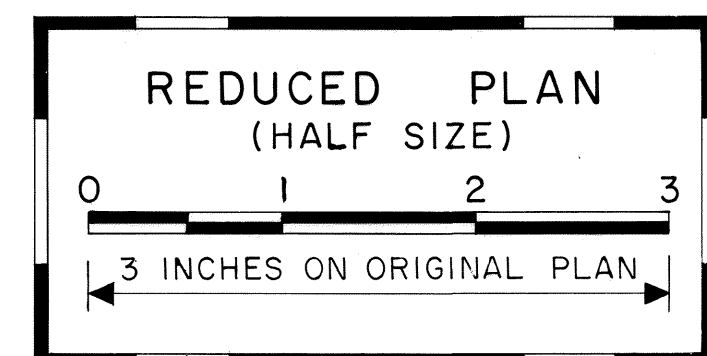

STATE OF HAWAII
DEPARTMENT OF TRANSPORTATION
HIGHWAYS DIVISION


ROADWAY PLAN

**KUAMOO ROAD RESURFACING
KUHIO HIGHWAY TO LILIA PLACE**

PROJECT NO. 580A-01-07M

Scale: 1" = 40' Date: April, 2007

FED. ROAD DIST. NO.	STATE	PROJ. NO.	FISCAL YEAR	SHEET NO.	TOTAL SHEETS
HAWAII	HAW.	580A-01-07M	2007	8	17

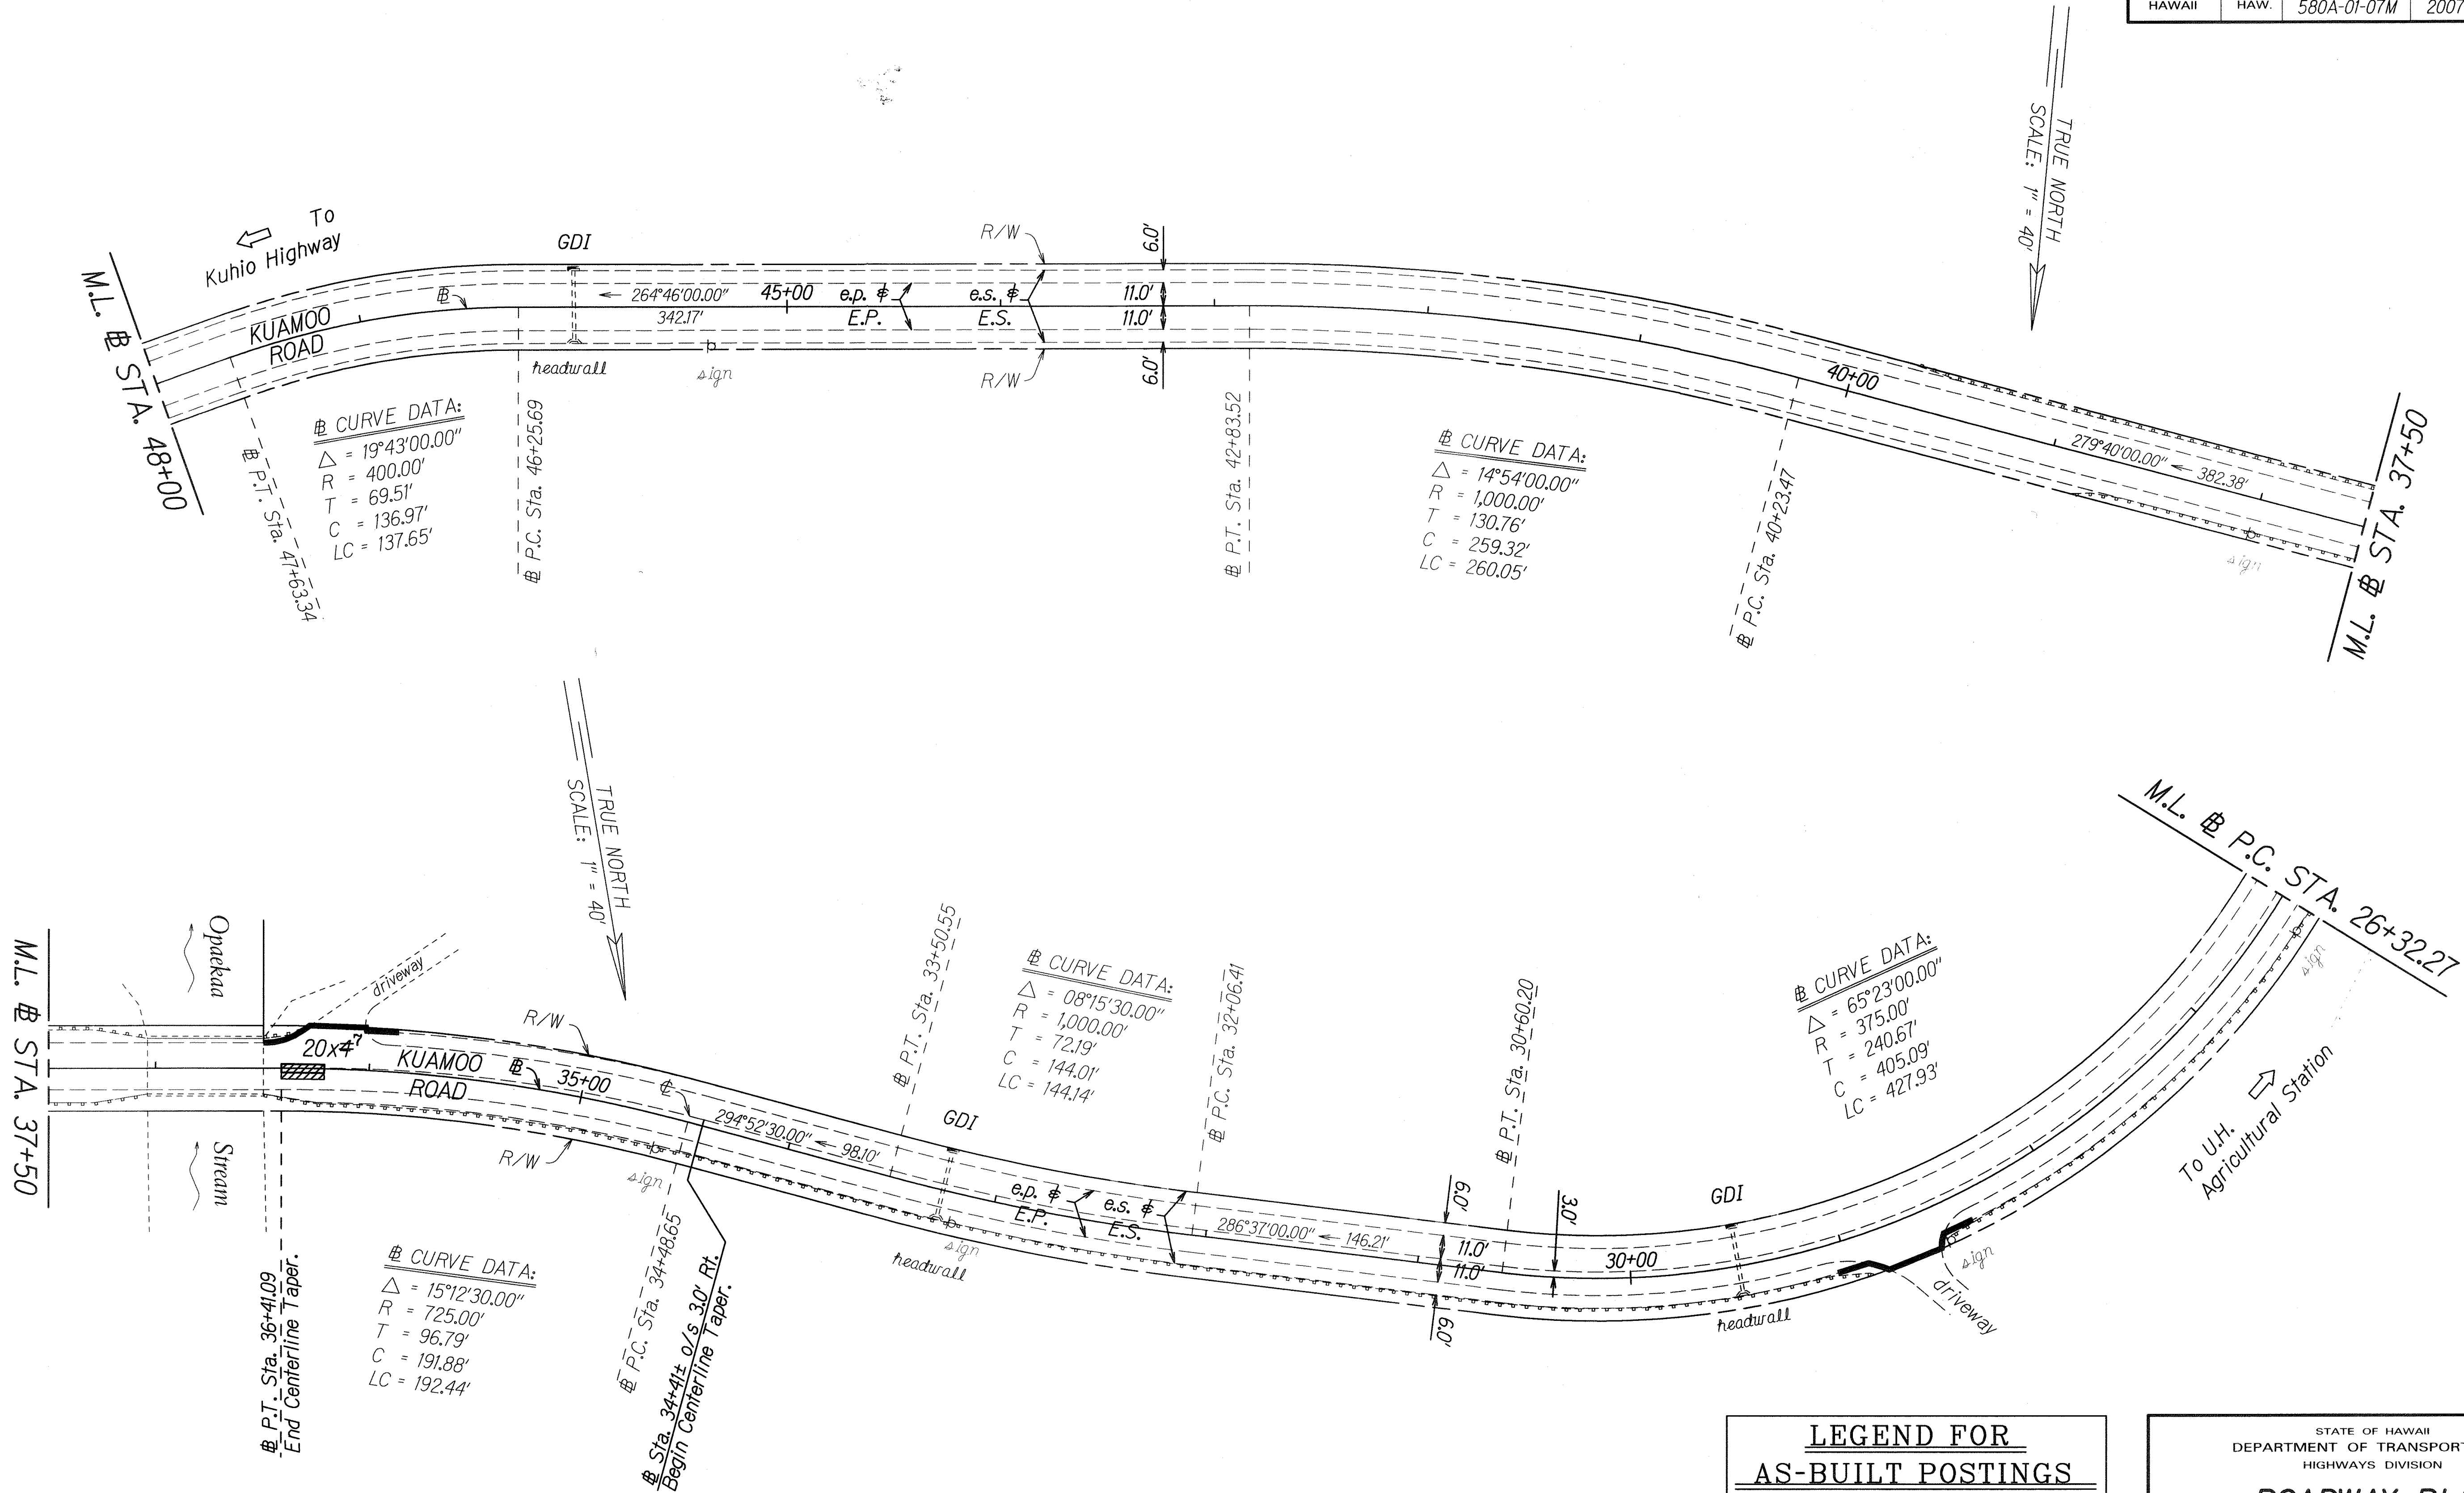

DATE	13/24/07
DESIGNED BY	MQ
CHECKED BY	MQ
NOTED BY	MQ
ORIGINAL PLAN	08/01/07

LEGEND FOR AS-BUILT POSTINGS	
	Squiggly line for as-built deletion
	Double line for as-built deletion
Roadway	Text for as-built posting

STATE OF HAWAII
DEPARTMENT OF TRANSPORTATION
HIGHWAYS DIVISION


ROADWAY PLAN

**KUAMOO ROAD RESURFACING
KUHIU HIGHWAY TO LILIA PLACE**

PROJECT NO. 580A-01-07M

Scale: 1" = 40' Date: April, 2007

FED. ROAD DIST. NO.	STATE	PROJ. NO.	FISCAL YEAR	SHEET NO.	TOTAL SHEETS
HAWAII	HAW.	580A-01-07M	2007	9	17

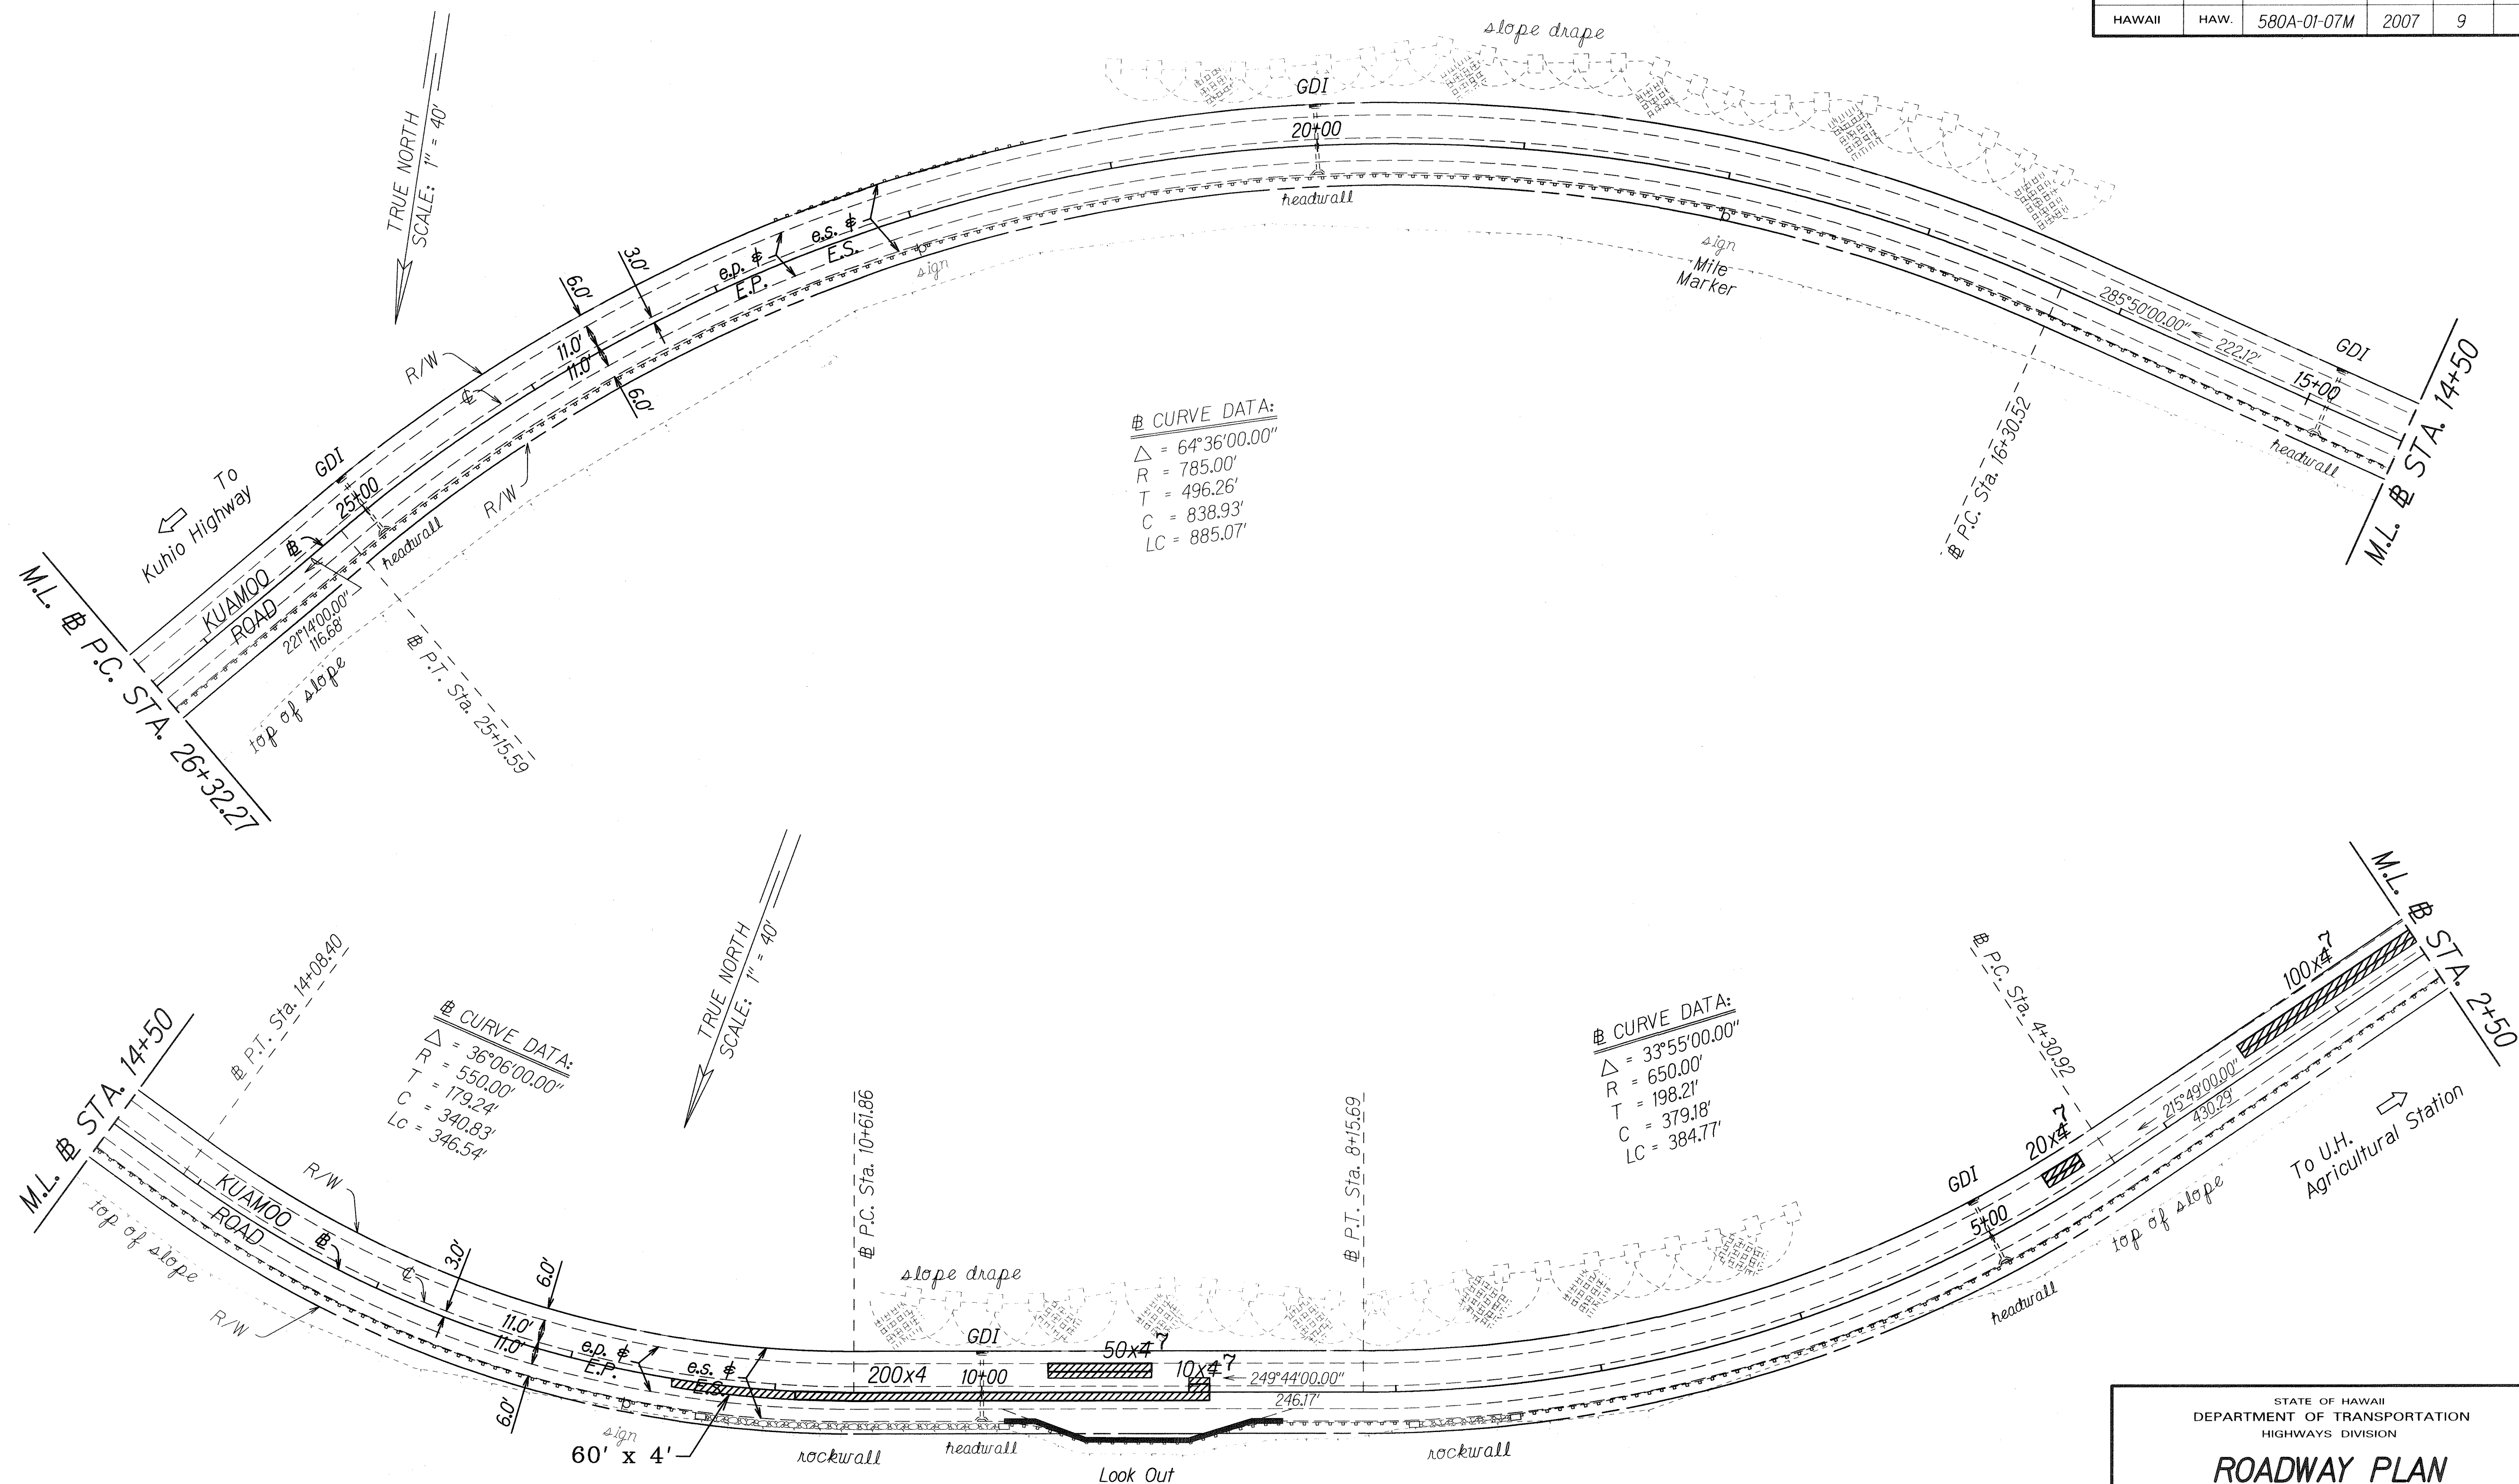

ORIGINAL PLAN	SURVEY PLOTTED BY _____	DATE <u>03/24/07</u>
NOTE BOOK addis 2 mgd hwa 09dkwadp03gen Nc.	DRAWN BY <u>mg</u>	
	TRACED BY _____	
	DESIGNED BY <u>MQ</u>	<u>02/17/07</u>
	QUANTITIES BY _____	
	CHECKED BY _____	

LEGEND FOR AS-BUILT POSTINGS	
	Squiggly line for as-built deletion
	Double line for as-built deletion
Roadway	Text for as-built posting

STATE OF HAWAII
DEPARTMENT OF TRANSPORTATION
HIGHWAYS DIVISION


ROADWAY PLAN

KUAMOO ROAD RESURFACING
KUHIO HIGHWAY TO LILIA PLACE
PROJECT NO. 580A-01-07M

Scale: 1" = 40' Date: April, 2007

SHEET No. 3 OF 5 SHEETS

FED. ROAD DIST. NO.	STATE	PROJ. NO.	FISCAL YEAR	SHEET NO.	TOTAL SHEETS
HAWAII	HAW.	580A-01-07M	2007	10	17

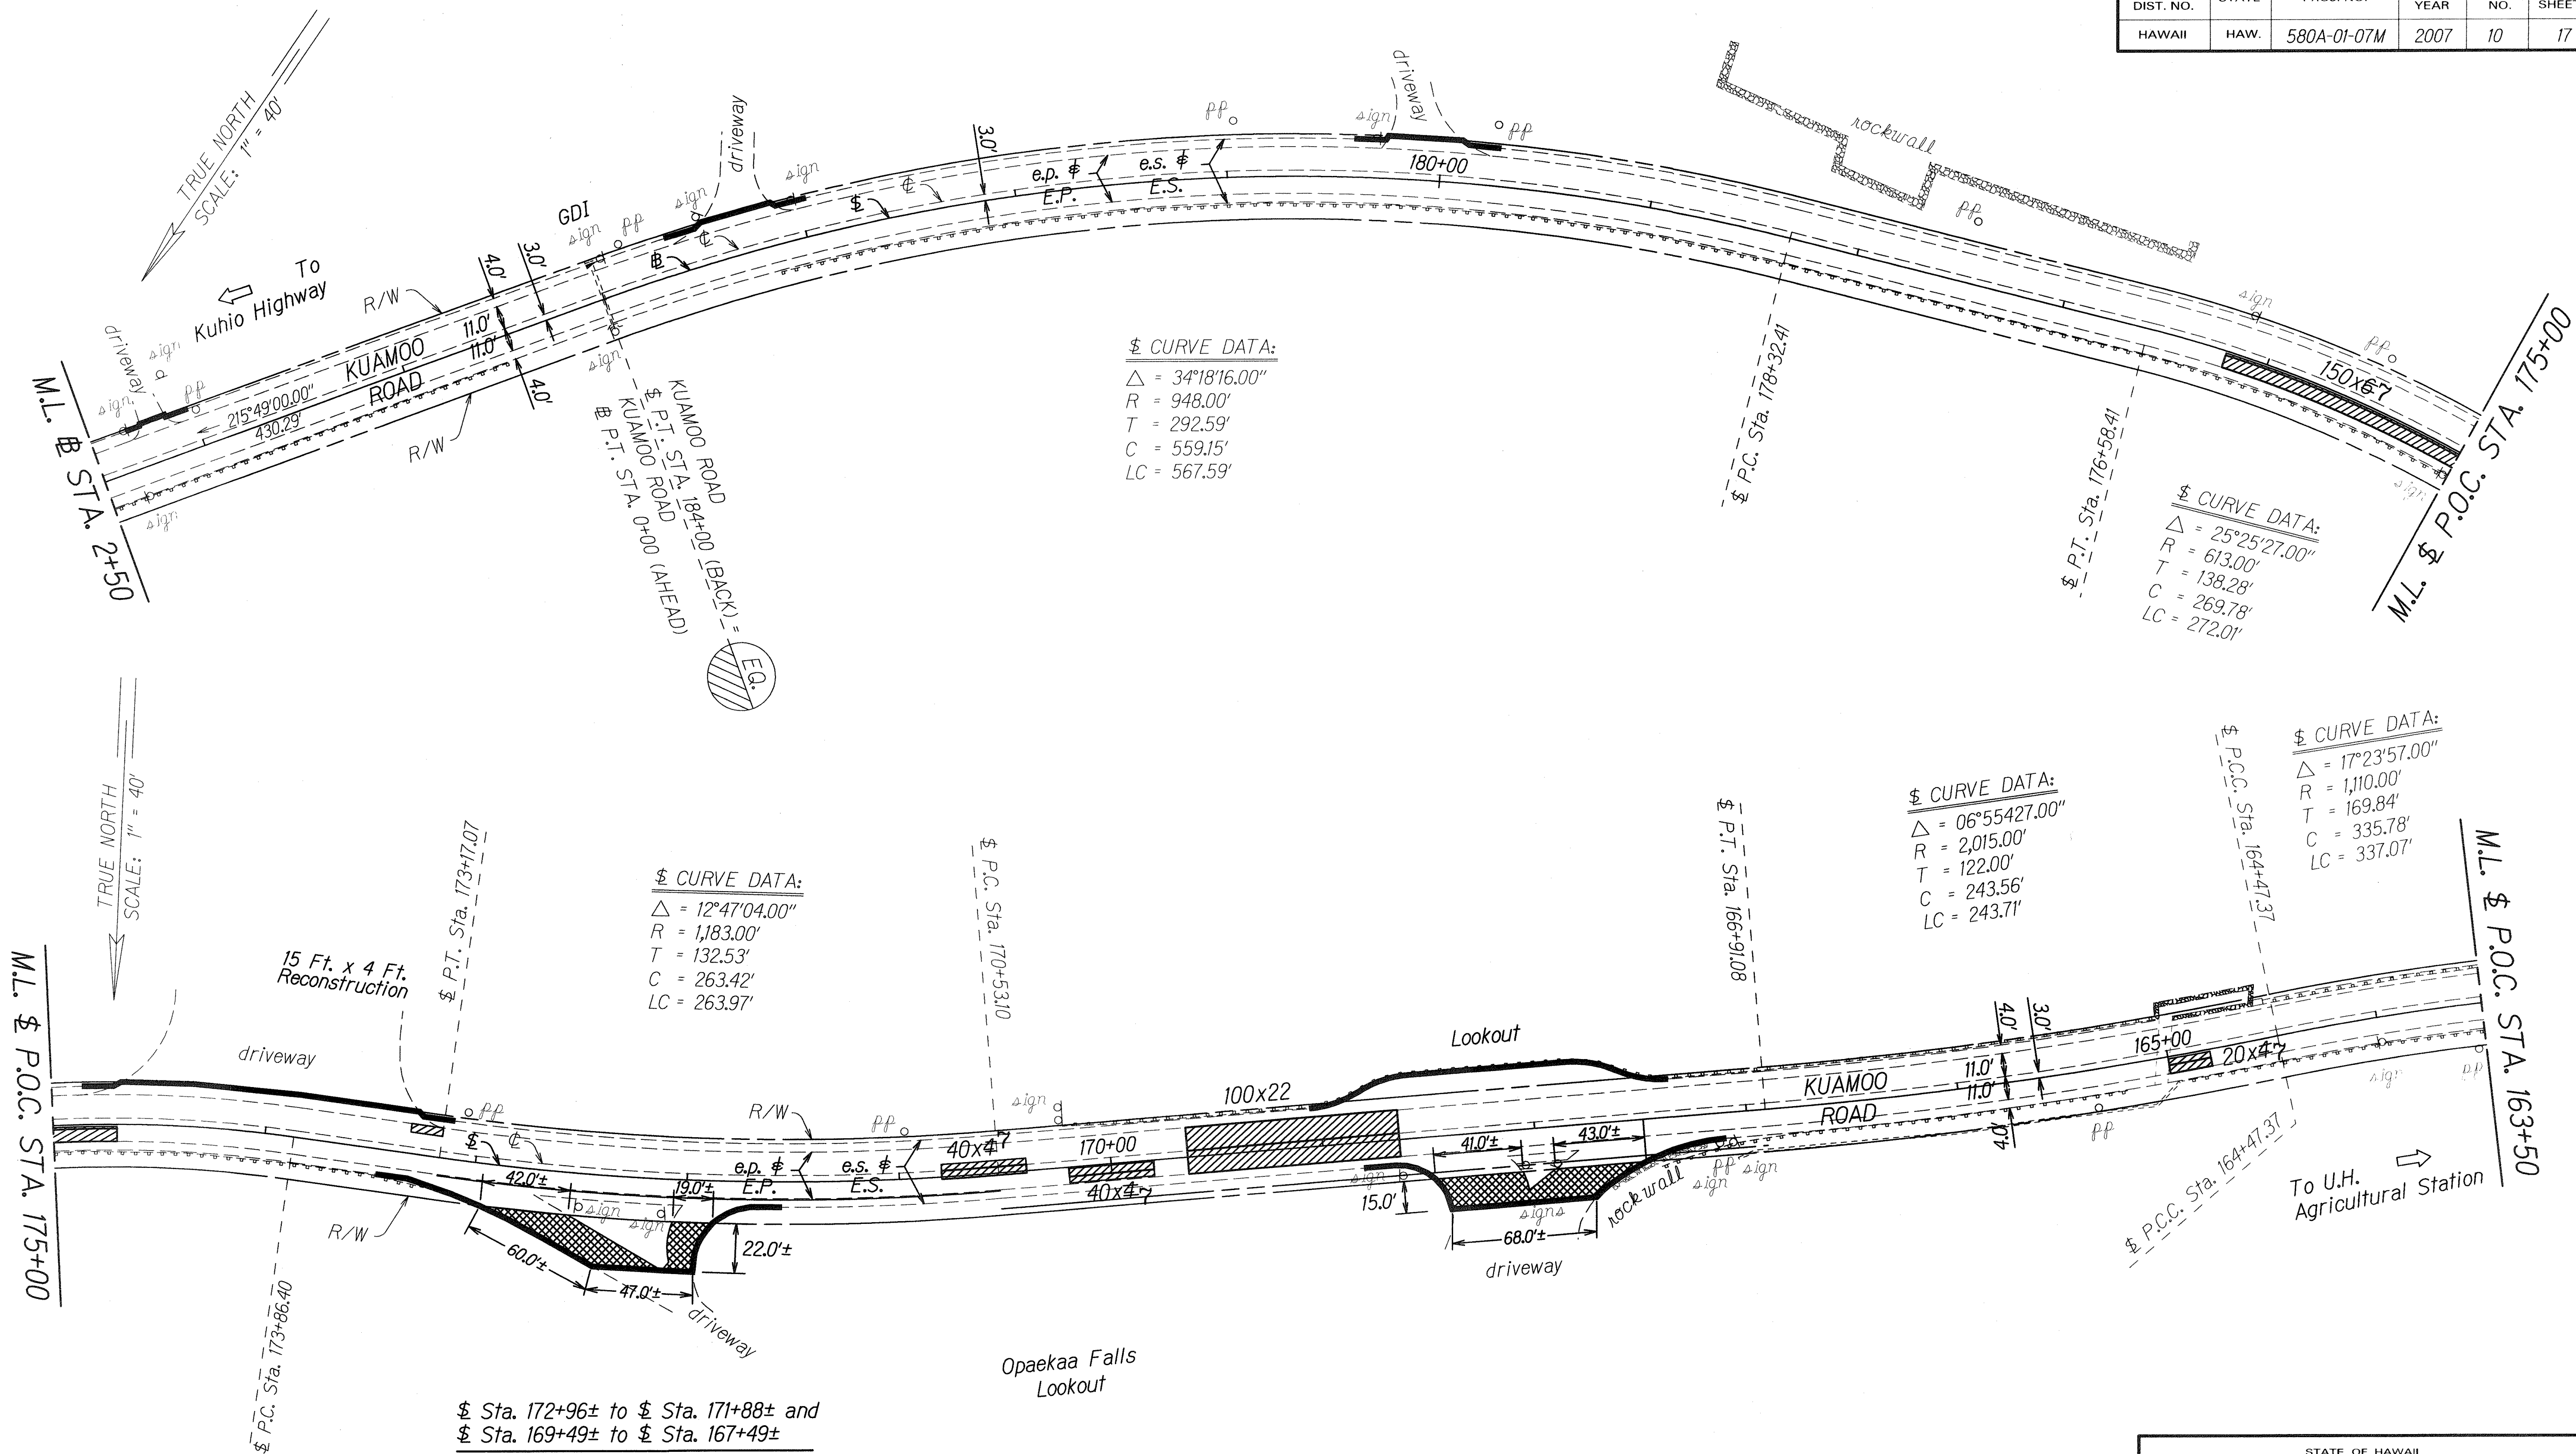

NOTE:
Station Line and Stations Are
For Information Purposes Only.

Sta. 172+96± to Sta. 171+88± and
Sta. 169+49± to Sta. 167+49±
Cold Plane 2 1/4-Inch of Existing Pavement. Pave
2 1/4-Inch of HMA Pavement, Mix No. IV
Transitions (Cross-Hatched Area).

LEGEND FOR AS-BUILT POSTINGS	
	Squiggly line for as-built deletion
	Double line for as-built deletion
Roadway	Text for as-built posting



STATE OF HAWAII
DEPARTMENT OF TRANSPORTATION
HIGHWAYS DIVISION

ROADWAY PLAN
KUAMOO ROAD RESURFACING
KUHIU HIGHWAY TO LILIA PLACE
PROJECT NO. 580A-01-07M
Scale: 1" = 40'
Date: April, 2007

SHEET No. 4 OF 5 SHEETS

AS-BUILT

FED. ROAD DIST. NO.	STATE	PROJ. NO.	FISCAL YEAR	SHEET NO.	TOTAL SHEETS
HAWAII	HAW.	580A-01-07M	2007	11	17

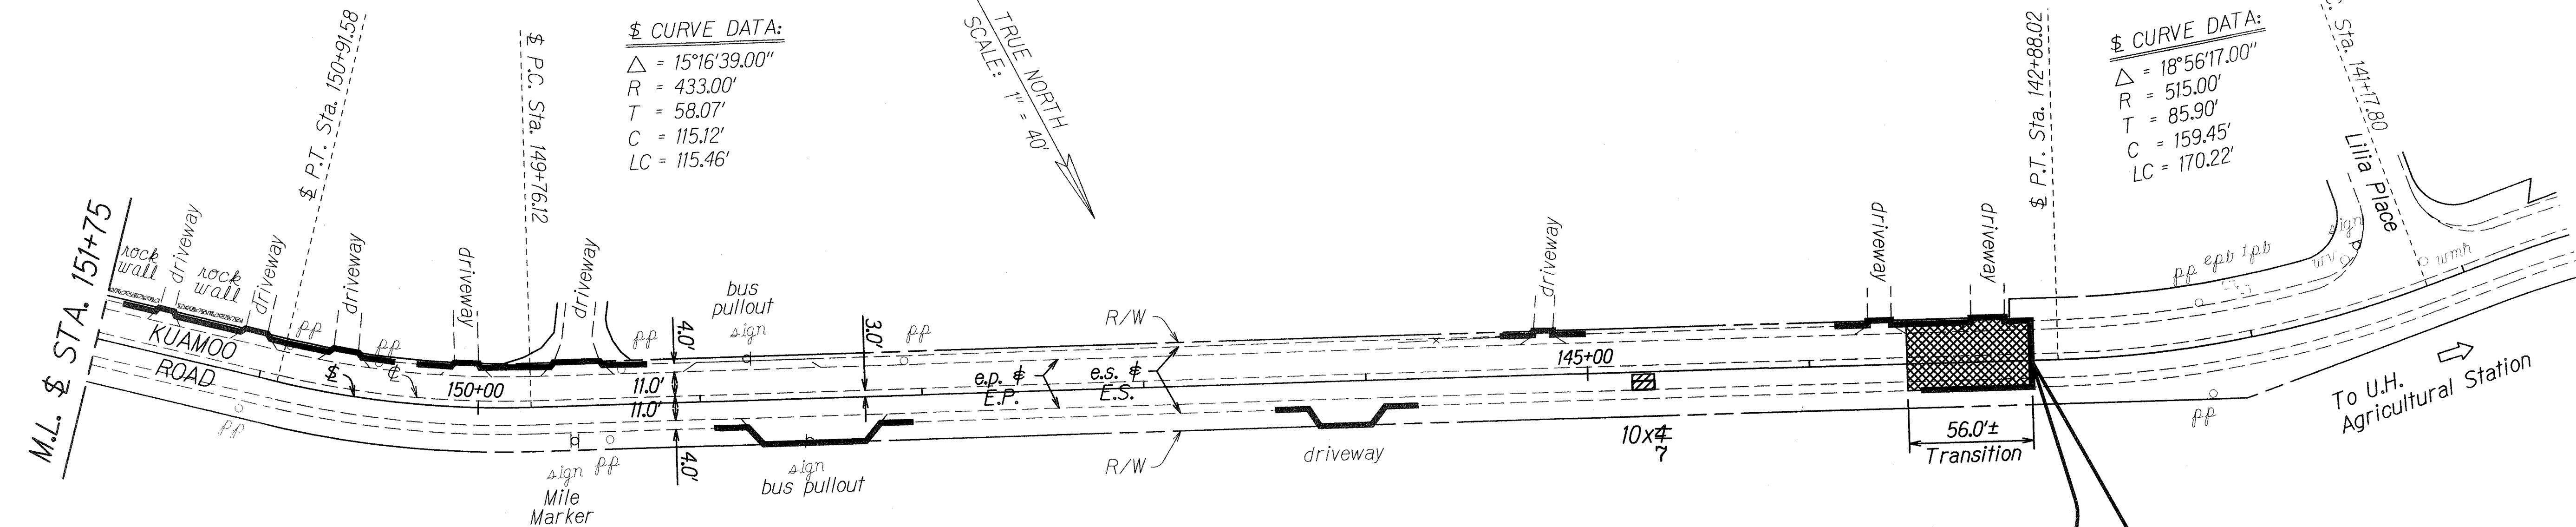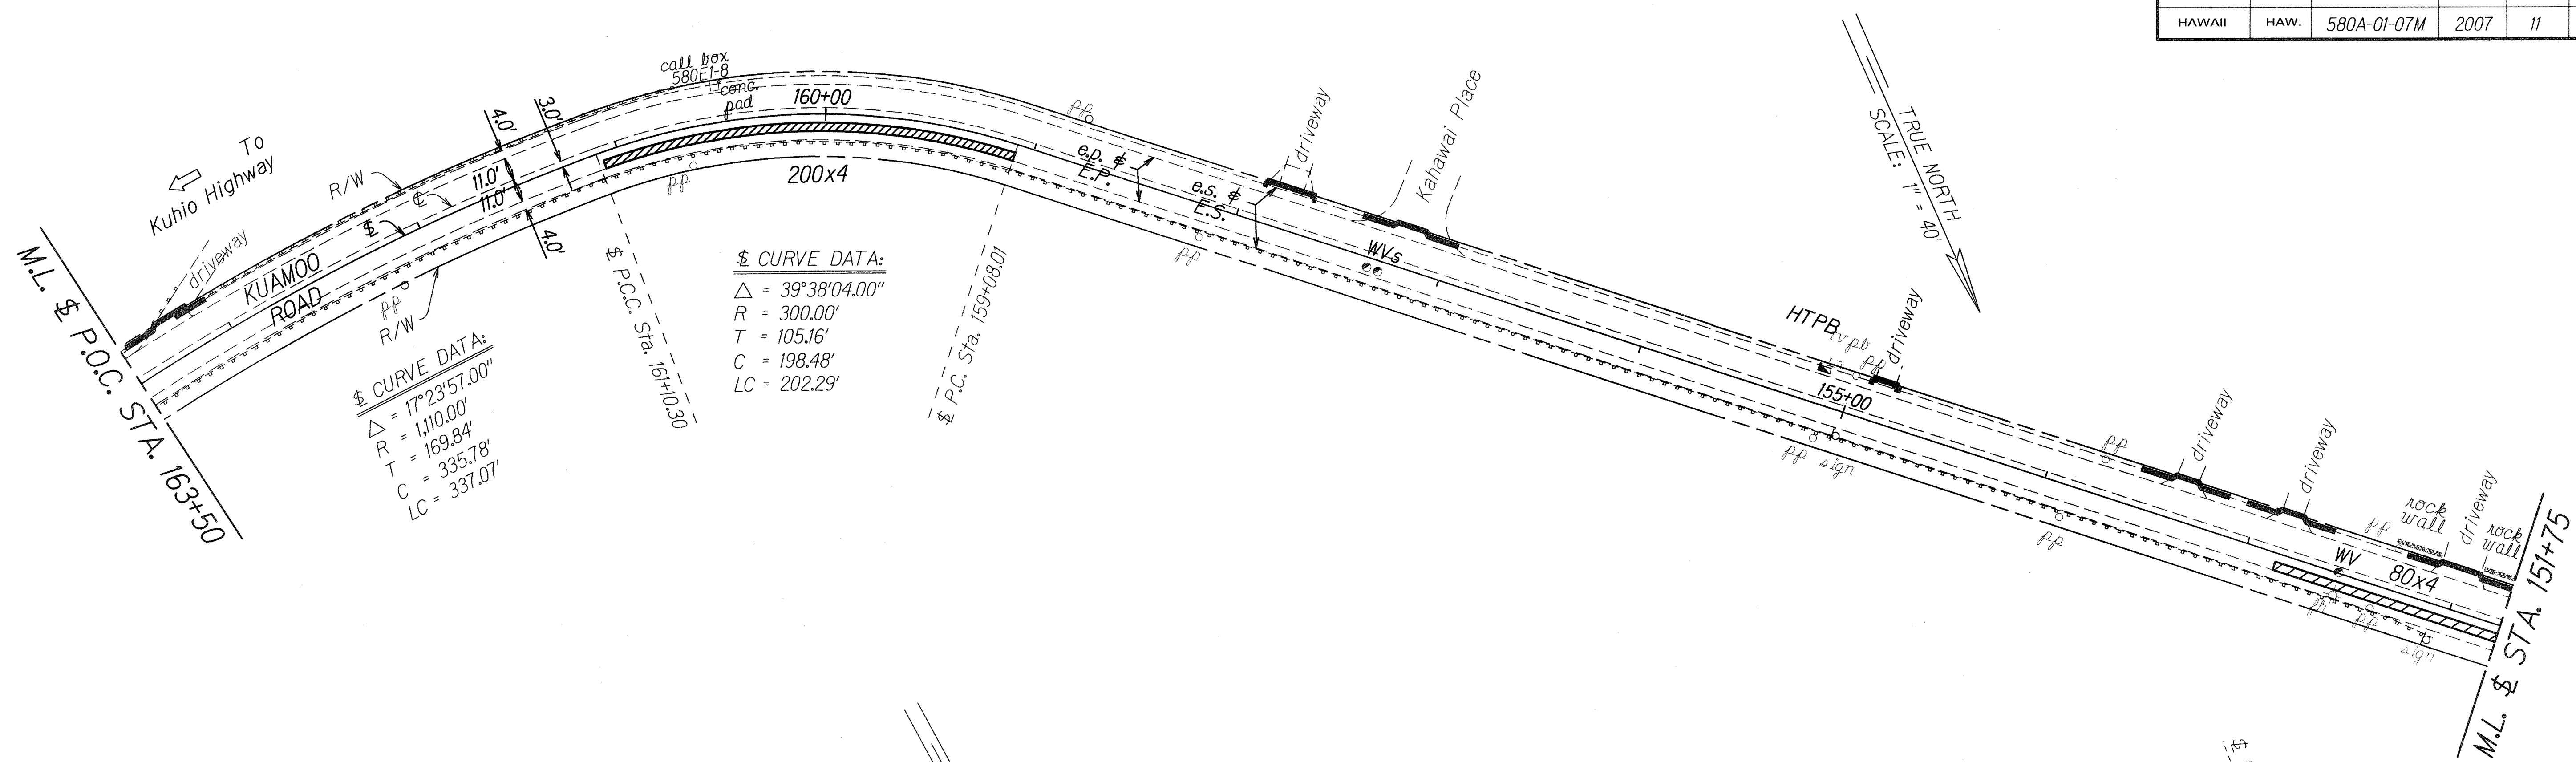

Sta. 143+56± to Sta. 143+00±
Cold Plane 2¼-Inch of Existing Pavement. Pave
2¼-Inch of HMA Pavement, Mix No. IV
Transition (Cross-Hatched Area).

END PROJECT
Project No. 580A-01-07M
Kuamoo Road Sta. 143+00±

LEGEND FOR AS-BUILT POSTINGS	
	Squiggly line for as-built deletion
	Double line for as-built deletion
Roadway	Text for as-built posting

STATE OF HAWAII
DEPARTMENT OF TRANSPORTATION
HIGHWAYS DIVISION

ROADWAY PLAN
KUAMOO ROAD RESURFACING
KUHIO HIGHWAY TO LILIA PLACE
PROJECT NO. 580A-01-07M
Scale: 1" = 40' Date: April, 2007

SHEET No. 5 OF 5 SHEETS

ORIGINAL PLAN	SURVEY PLOTTED BY	DATE
NOTE BOOK	DRAWN BY	03/24/07
adj. 2/2/07	TRACED BY	02/17/07
checked by	QUANTITIES BY	
	CHECKED BY	

AS-BUILT