


FED. ROAD DIST. NO.	STATE	FED. AID PROJ. NO.	FISCAL YEAR	SHEET NO.	TOTAL SHEETS
HAWAII	HAW.	HRRP-0580(4)	2009	ADD. 9	14

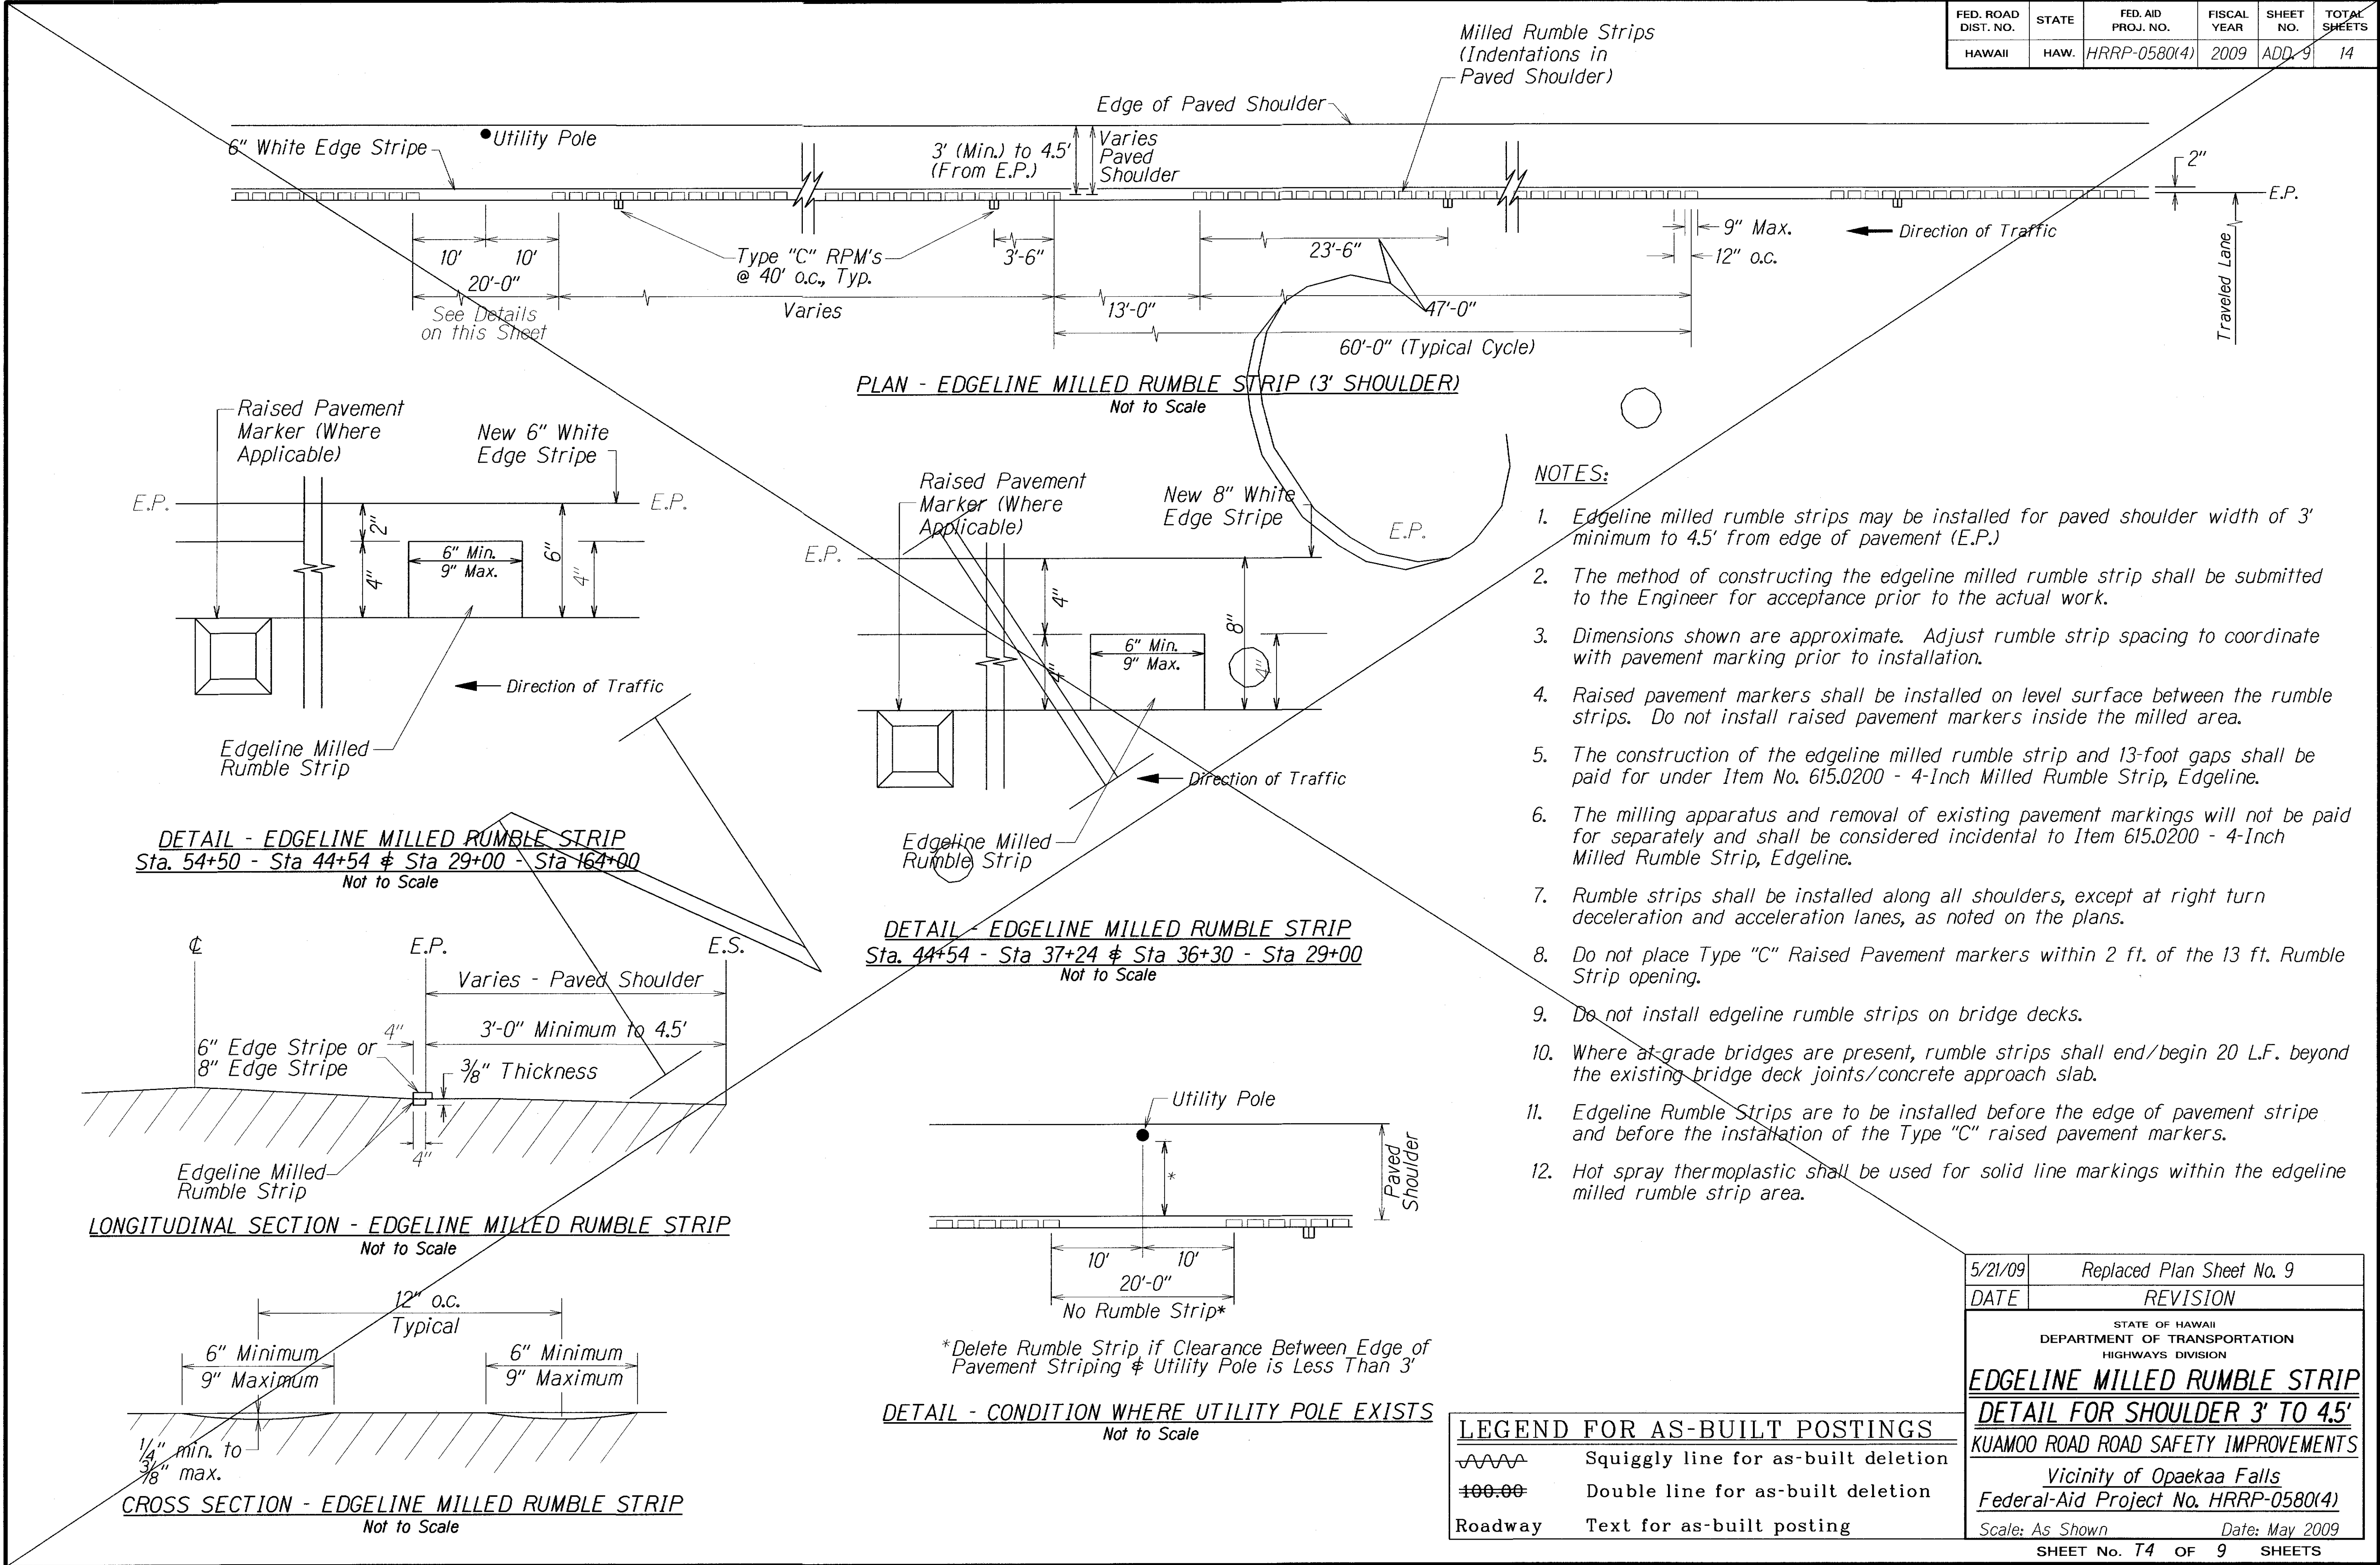

"AS-BUILT"

ADD. 9