	INDEX TO DRAWINGS
SHEET NO.	DESCRIPTION
1	TITLE SHEET
2	STANDARD PLANS SUMMARY
3 - 4	GENERAL NOTES
5 - 7	WATER POLLUTION AND EROSION CONTROL NOTES AND DETAILS
8	SITE PLAN
9	ROADWAY PLAN
10	TYPICAL SECTION
11	RING NET DRAPERY DETAILS
12	MISCELLANEOUS DETAILS
13 - 14	TRAFFIC CONTROL PLAN & NOTES
15	LOW SPEED UNDIVIDED HIGHWAY WORK ZONE SIGNING PLAN, NOTES & DETAILS

STATE OF HAWAII

DEPARTMENT OF TRANSPORTATION

HIGHWAYS

DIVISION

HONOLULU, HAWAII

"AS-SUMIT"


PLANS FOR

KUAMOO ROAD EMERGENCY SLOPE STABILIZATION

VICINITY OF MILEPOST 0.3

PROJECT NO. 580A-01-14

DISTRICT OF KAWAIHAU
ISLAND OF KAUAI

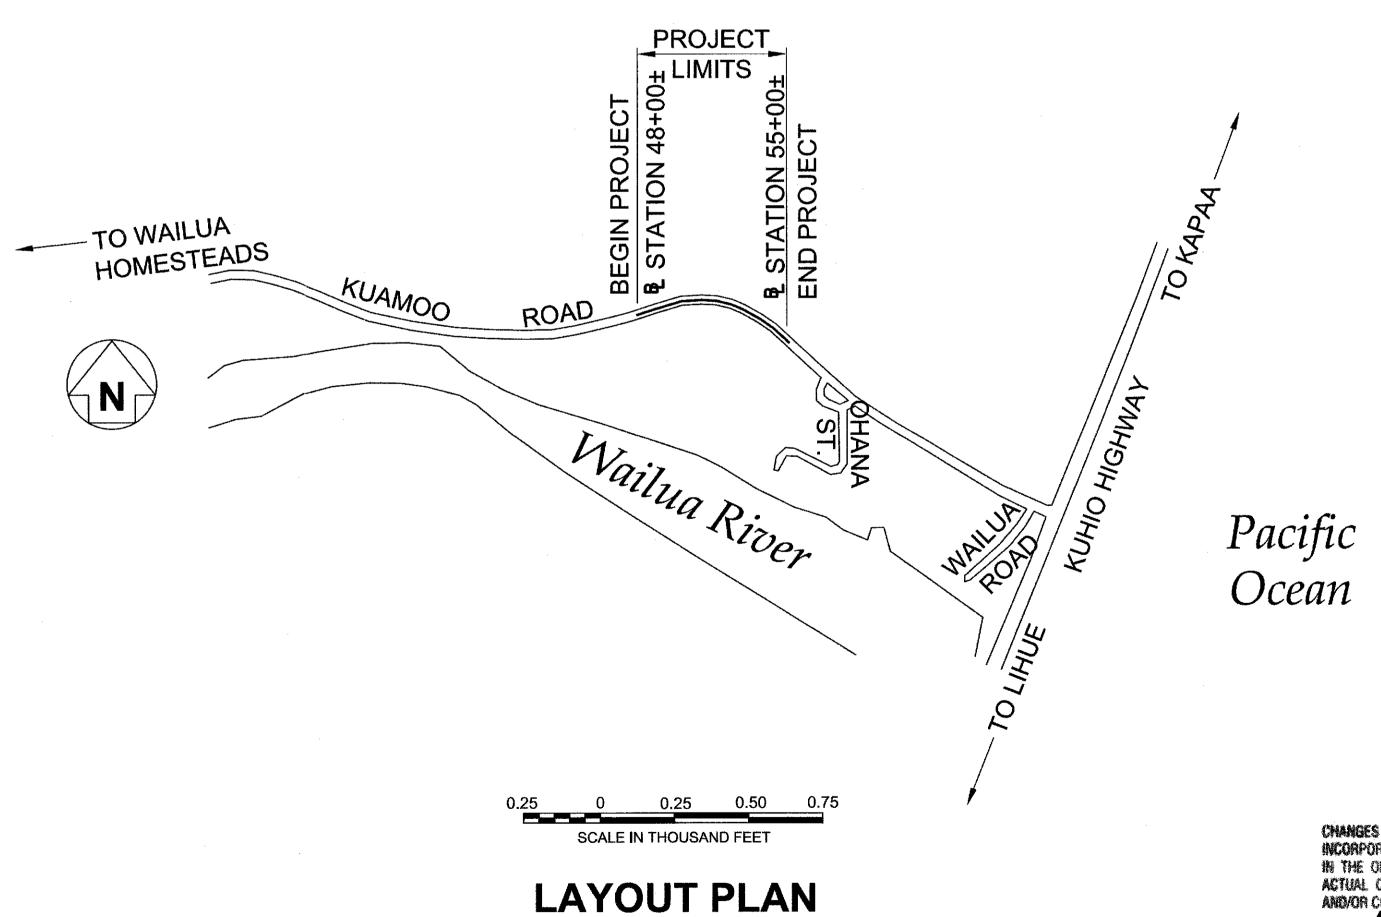

GROSS LENGTH OF PROJECT.

NET LENGTH OF PROJECT

Hanalei
Bay
Haena

Hanalei
A N A L E I

Anahola

Kapaa

Waitua

Ahukini
Landing
Puhi

Kilauea

Kilauea

Bay

Kilauea

Kilauea

Moloaa

Kapaa


Maloaa

Kapaa

Kapaa

Waitua

STATE OF HAWALL

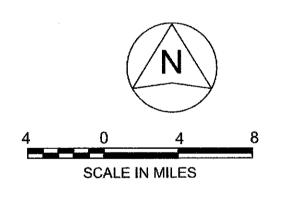

LOCATION

OF PROJECT

FEDERAL AID PROJECTS PREVIOUSLY CONSTRUCTED OR UNDER CONSTRUCTION

MILE POST <u>0.20</u> TO MILE POST <u>0.40</u>

CHANGES MADE DURING CONSTRUCTION HAVE BEEN INCORPORATED ON THESE PLANS EXCEPT CHANGES

IN THE ORIGINAL THEORETICAL QUANTITIES. FOR DEPARTMENT OF TRANSPORTATION ACTUAL QUANTITIES, REFER TO PROJECT LEDGER STATE OF HAWAII

AND/OR COMPUTATION BOCK.

APPROVED:

South A. Yalush

For DIR. OF TRANSPORTATION

AECOM SIGNED BY

6/03/14

DATE