



DRAWING NAME: W:\CAD\BIKE PATH LYDCATE-KAPAA PHASE B\AS-BUILTS\L-06-KNL-PHASE B-100 2011-11-28 AS-BUILDING PLOT TIME: 12-20-13, 11:36 AM)

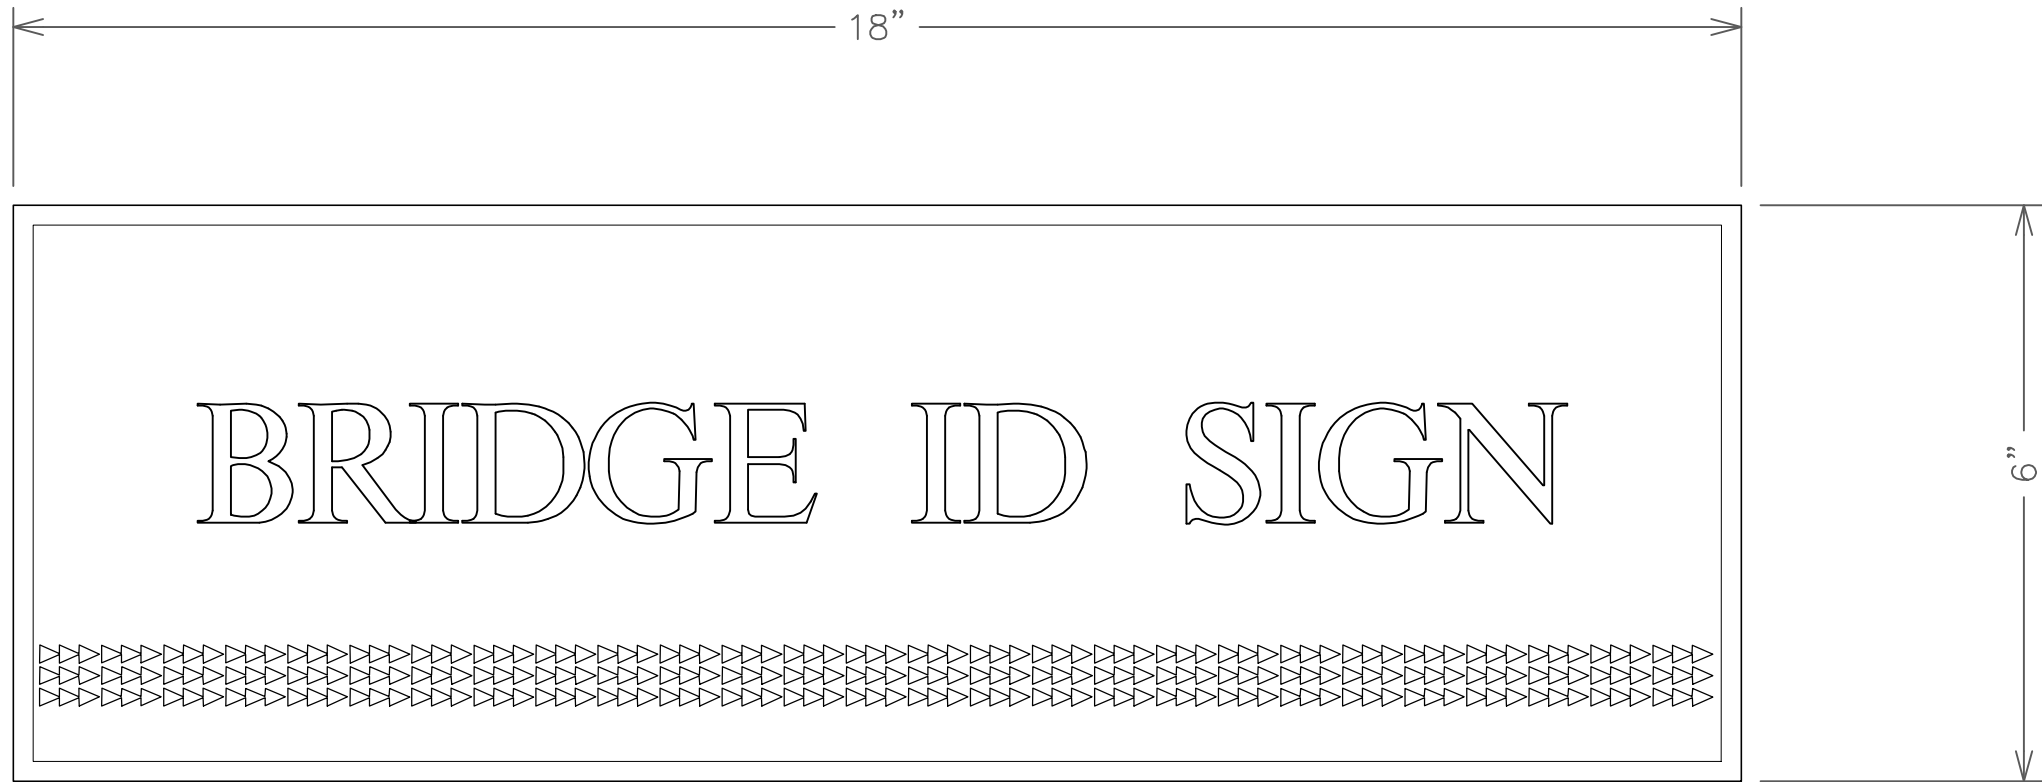

NOTE: ARTWORK IS REPRESENTATIVE; CONTRACTOR TO RECEIVE ARTWORK FROM FROM OWNER FOR EACH BRIDGE FOR FABRICATION


CAST BRONZE PLAQUE BRIDGE ID SIGN DETAIL FRONT ELEVATION (TYP.)  
SCALE: N.T.S.

NOT PART OF PHASE B-WORK

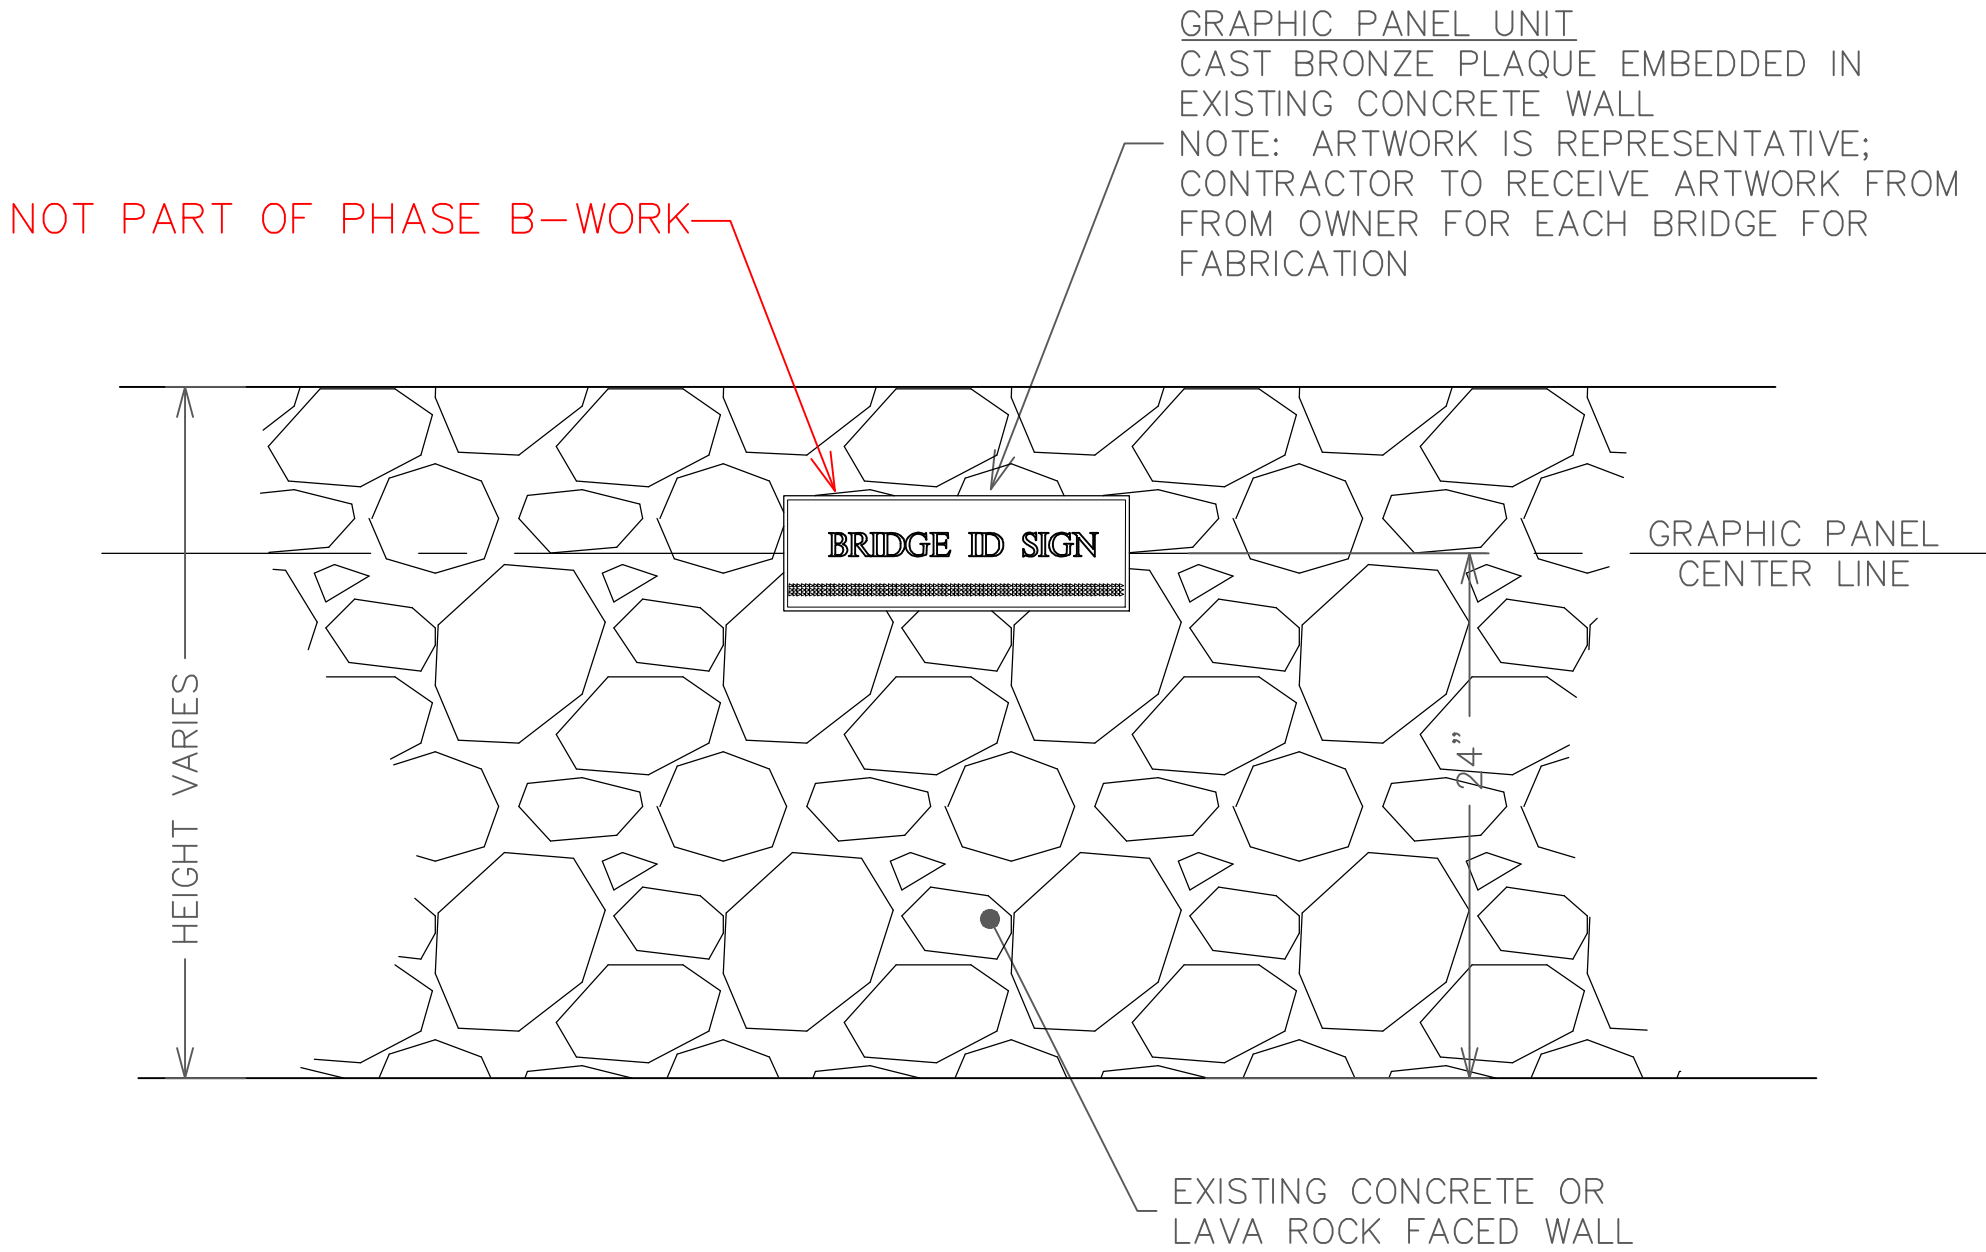

BRIDGE ID SIGN WALL FRONT ELEVATION (TYP.)  
SCALE: N.T.S.


AS-BUILT

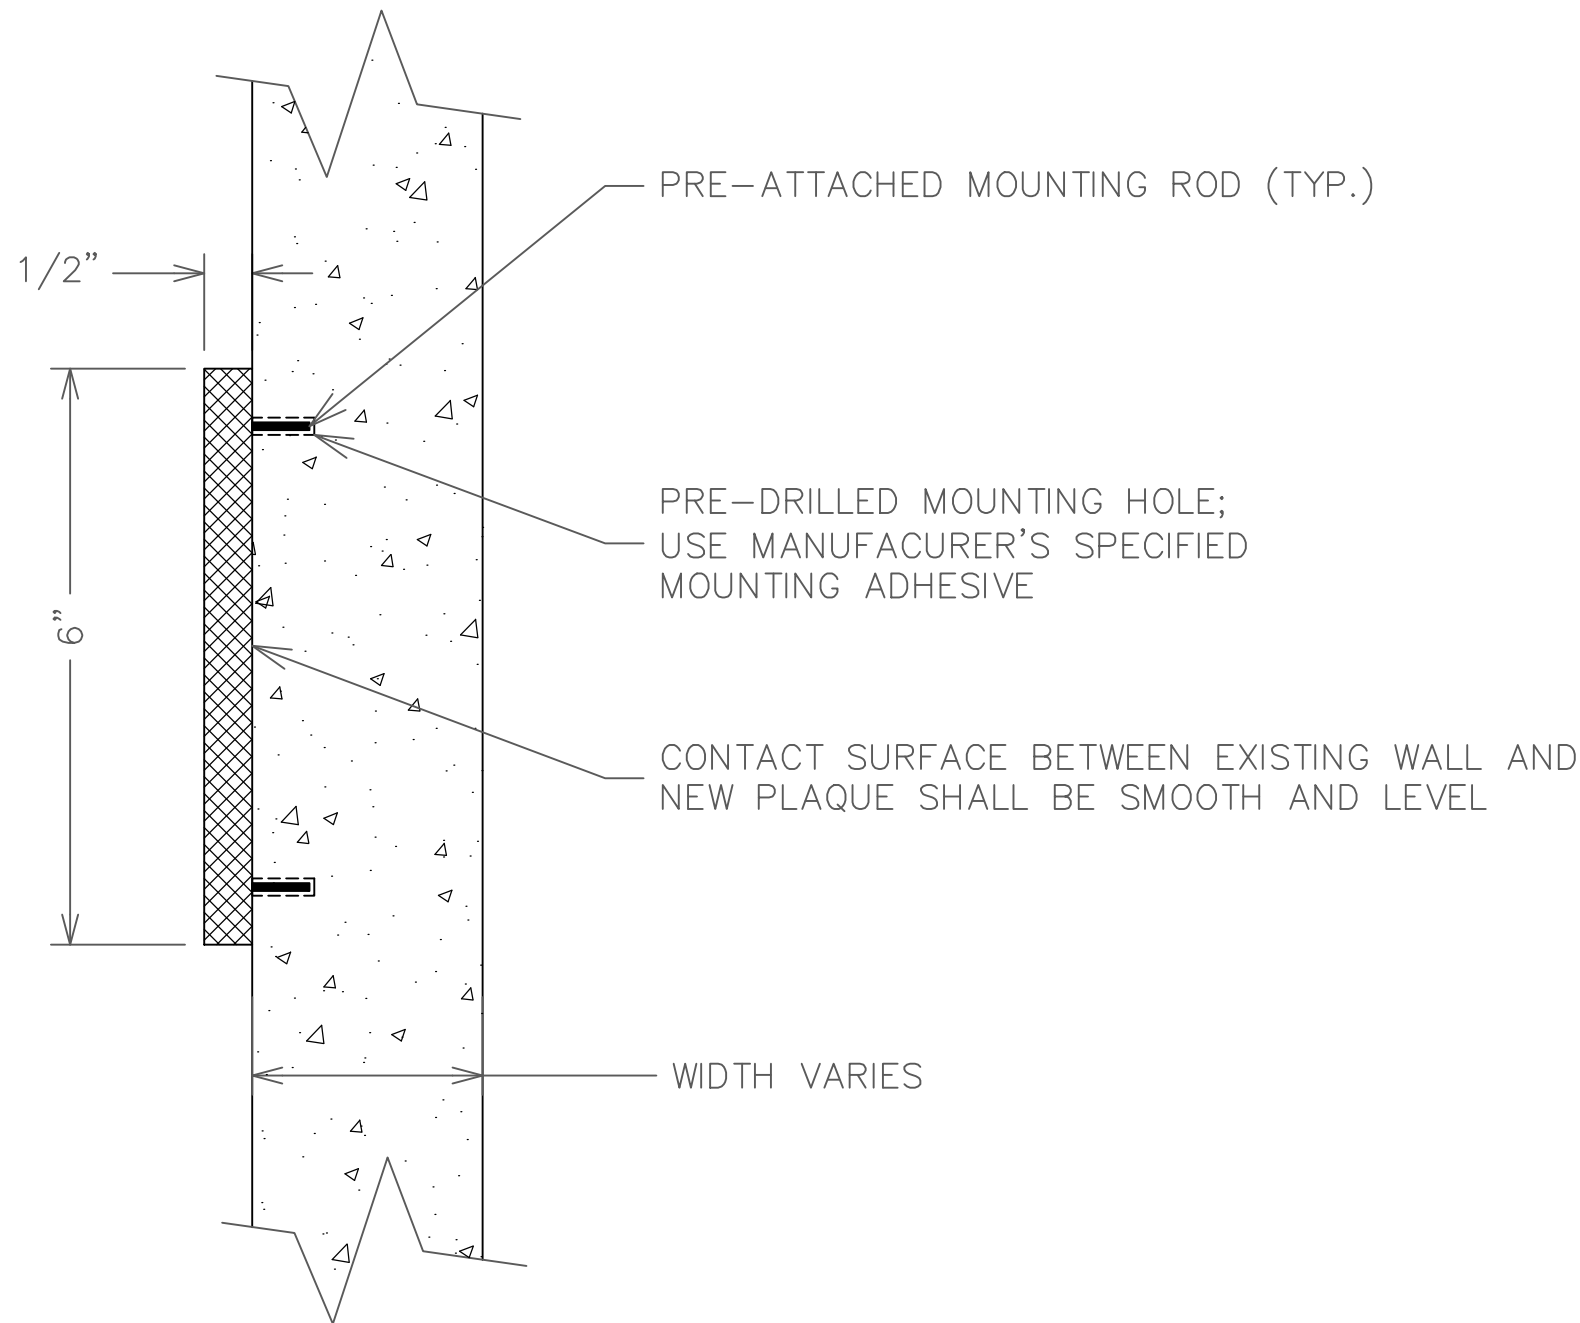

CAST BRONZE PLAQUE BRIDGE ID SIGN DETAIL SIDE ELEVATION (TYP.)  
BARE CONCRETE WALL APPLICATION  
SCALE: N.T.S.

CONTRACTOR TO CUT OUT AND REMOVE EXISTING LAVA ROCK VENEER PRIOR TO INSTALLING NEW PLAQUE; CONTRACTOR SHALL ENSURE THAT ANY REQUIRED SAW-CUTS SHALL BE SMOOTH AND STRAIGHT.

FILL GAPS BETWEEN PLAQUE AND VENEER WITH TRAFFIC-GRADE GROUT SEALANT (COLOR TO MATCH EXISTING VENEER)

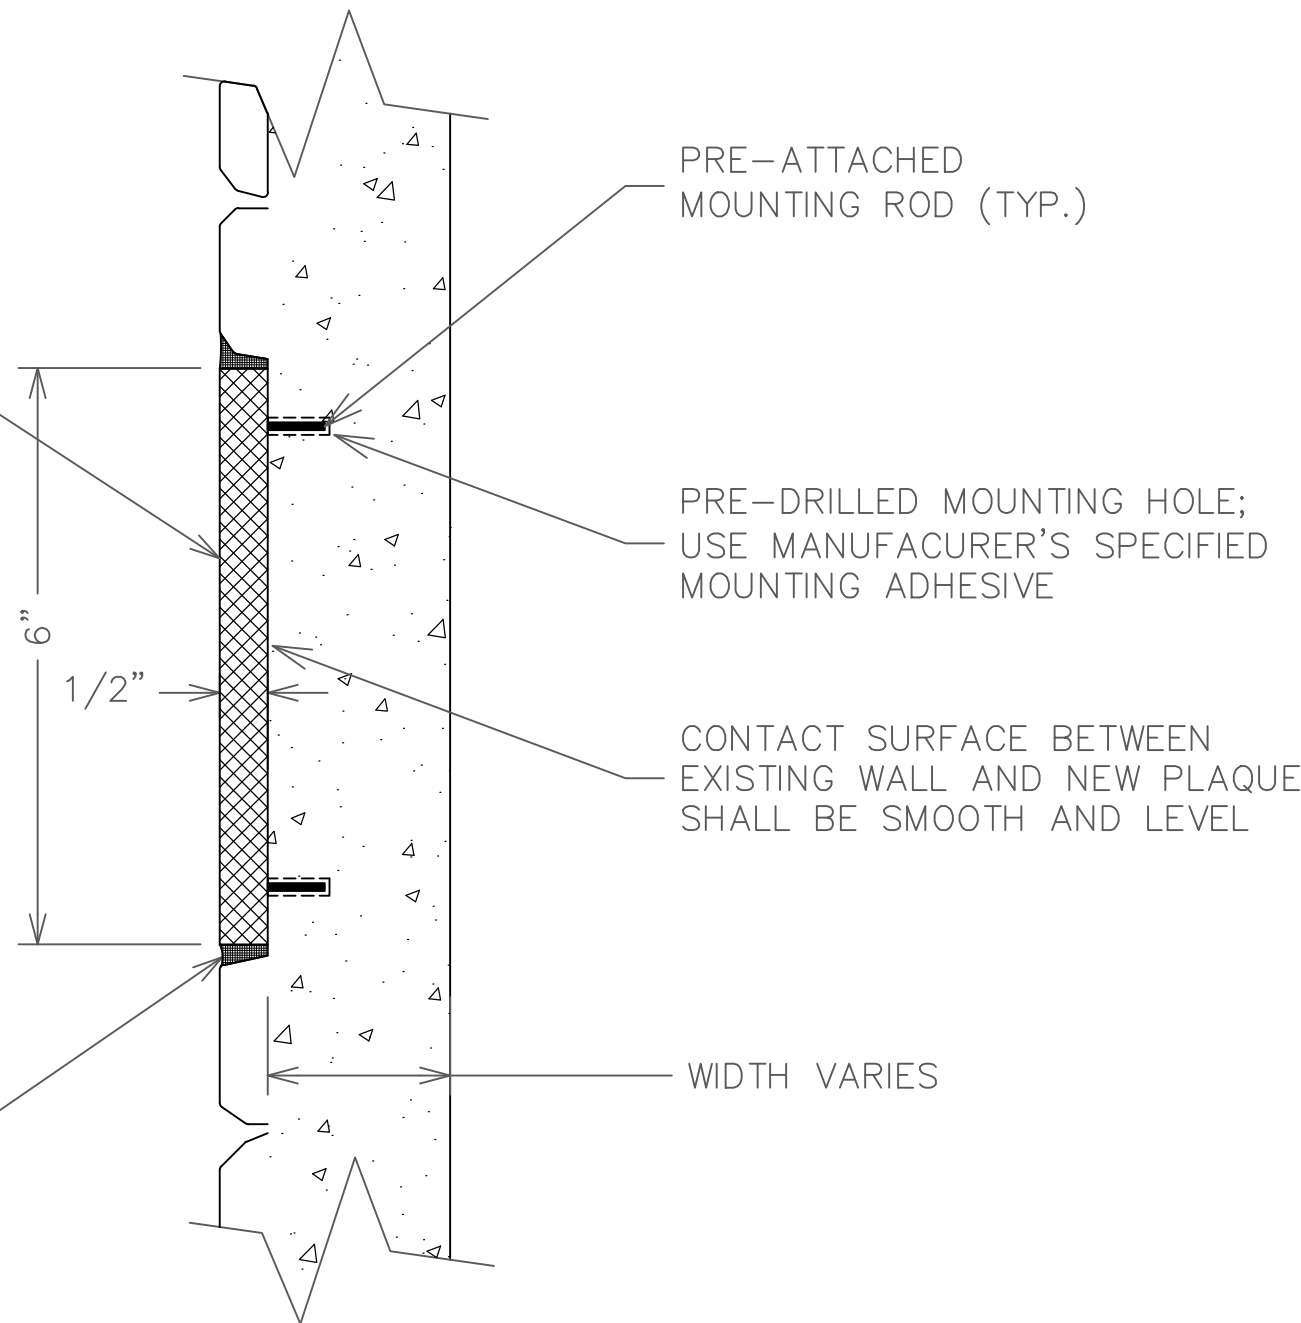

CAST BRONZE PLAQUE BRIDGE ID SIGN DETAIL SIDE ELEVATION (TYP.)  
LAVA ROCK FACED CONCRETE WALL APPLICATION  
SCALE: N.T.S.

FED. ROAD DIST. NO.	STATE	FED. AID PROJ. NO.	FISCAL YEAR	SHEET NO.	TOTAL SHEETS
HAWAII	HAW.	STP-0700(61)	2011	109	143

GENERAL NOTES:

UNLESS OTHERWISE NOTED ON THESE PLANS, CONTRACTOR SHALL CONFORM TO THE FOLLOWING DOCUMENTS IN THE STATE 2005 STANDARD SPECIFICATIONS FOR ROADS AND BRIDGES FOR ALL MATERIALS AND INSTALLATION:

- SECTION 601 – STRUCTURAL CONCRETE
- SECTION 602 – REINFORCING STEEL
- SECTION 634 – PORTLAND CEMENT CONCRETE SIDEWALKS
- SECTION 701 – HYDRAULIC CEMENT
- SECTION 703 – AGGREGATES
- SECTION 705 – JOINT MATERIALS FOR CONCRETE STRUCTURES
- SECTION 709 – REINFORCING STEEL, WIRE ROPE, AND PRESTRESSING STEEL
- SECTION 711 – CONCRETE CURING MATERIALS AND ADMIXTURES
- SECTION 718 – STEEL FASTENERS

CONTRACTOR SHALL FIELD VERIFY ALL WALL LOCATIONS AND DIMENSIONS PRIOR TO INSTALLATION.

CONTRACTOR SHALL BE RESPONSIBLE FOR LOCATING AND PROTECTING EXISTING UTILITIES

PRODUCT NOTES:

GRAPHIC PANEL SHALL BE 1/2" THICK RHINO GRAPHIC PANEL OR APPROVED EQUAL.

ALL SURFACES TO MEET APPLICABLE ADA GUIDELINES

PORTLAND CEMENT:  
ASTM C150 SPECIFICATIONS FOR PORTLAND CEMENT.  
AGGREGATES:  
ALL AGGREGATES TO MEET ASTM C33 SPECIFICATIONS; TO BE CLEAN OF FOREIGN MATTER AND PROPERLY GRADED TO SIZE.


COLORING:  
PIGMENTS USED SHALL BE INORGANIC, RESISTANT TO ALKALINITY, AND USED PER MANUFACTURER INSTRUCTIONS

INSTALLATION NOTES:

CONTRACTOR SHALL INSTALL PLAQUE IN ACCORDANCE WITH MANUFACTURER'S SPECIFICATIONS.

CONTRACTOR SHALL PROVIDE SHOP DRAWINGS FOR BRONZE PLAQUE ALONG WITH MANUFACTURER'S SPECIFIED ATTACHMENT DETAILS TO OWNER'S REPRESENTATIVE FOR APPROVAL PRIOR TO MANUFACTURING AND INSTALLING PLAQUE.

ARTWORK:  
OWNER SHALL PROVIDE ARTWORK TO CONTRACTOR IN ADOBE INDESIGN, ADOBE ILLUSTRATOR, OR ADOBE PHOTOSHOP FORMAT TO SUBMIT TO THE GRAPHIC PANEL FABRICATOR.

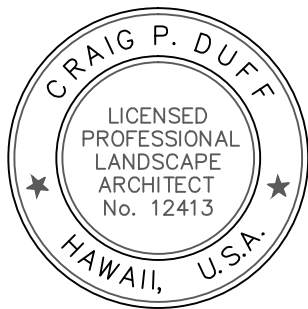

THIS WORK WAS PREPARED BY ME OR UNDER MY SUPERVISION.

SIGNATURE  
EXPIRATION DATE OF THE LICENSE

COUNTY OF KAUAI DEPARTMENT OF PUBLIC WORKS				
LYDGATE PARK TO KAPA'A BIKE/ PEDESTRIAN PATH PHASE B KAPA'A, KAUAI, HAWAII				
LANDSCAPE PLAN - 06 BRIDGE ID SIGN DETAILS FEDERAL-AID PROJECT NO. STP-0700(61) DATE: NOVEMBER 2011				
DRAWN BY: TRACED BY: CHECKED BY:	HL  CD	F.B.	C.B. SHEET	L-06 OF 6 SHEETS