


FED. ROAD DIST. NO.	STATE	FED. AID PROJ. NO.	FISCAL YEAR	SHEET NO.	TOTAL SHEETS
HAWAII	HAW.	STP-0700(61)	2011	89	143

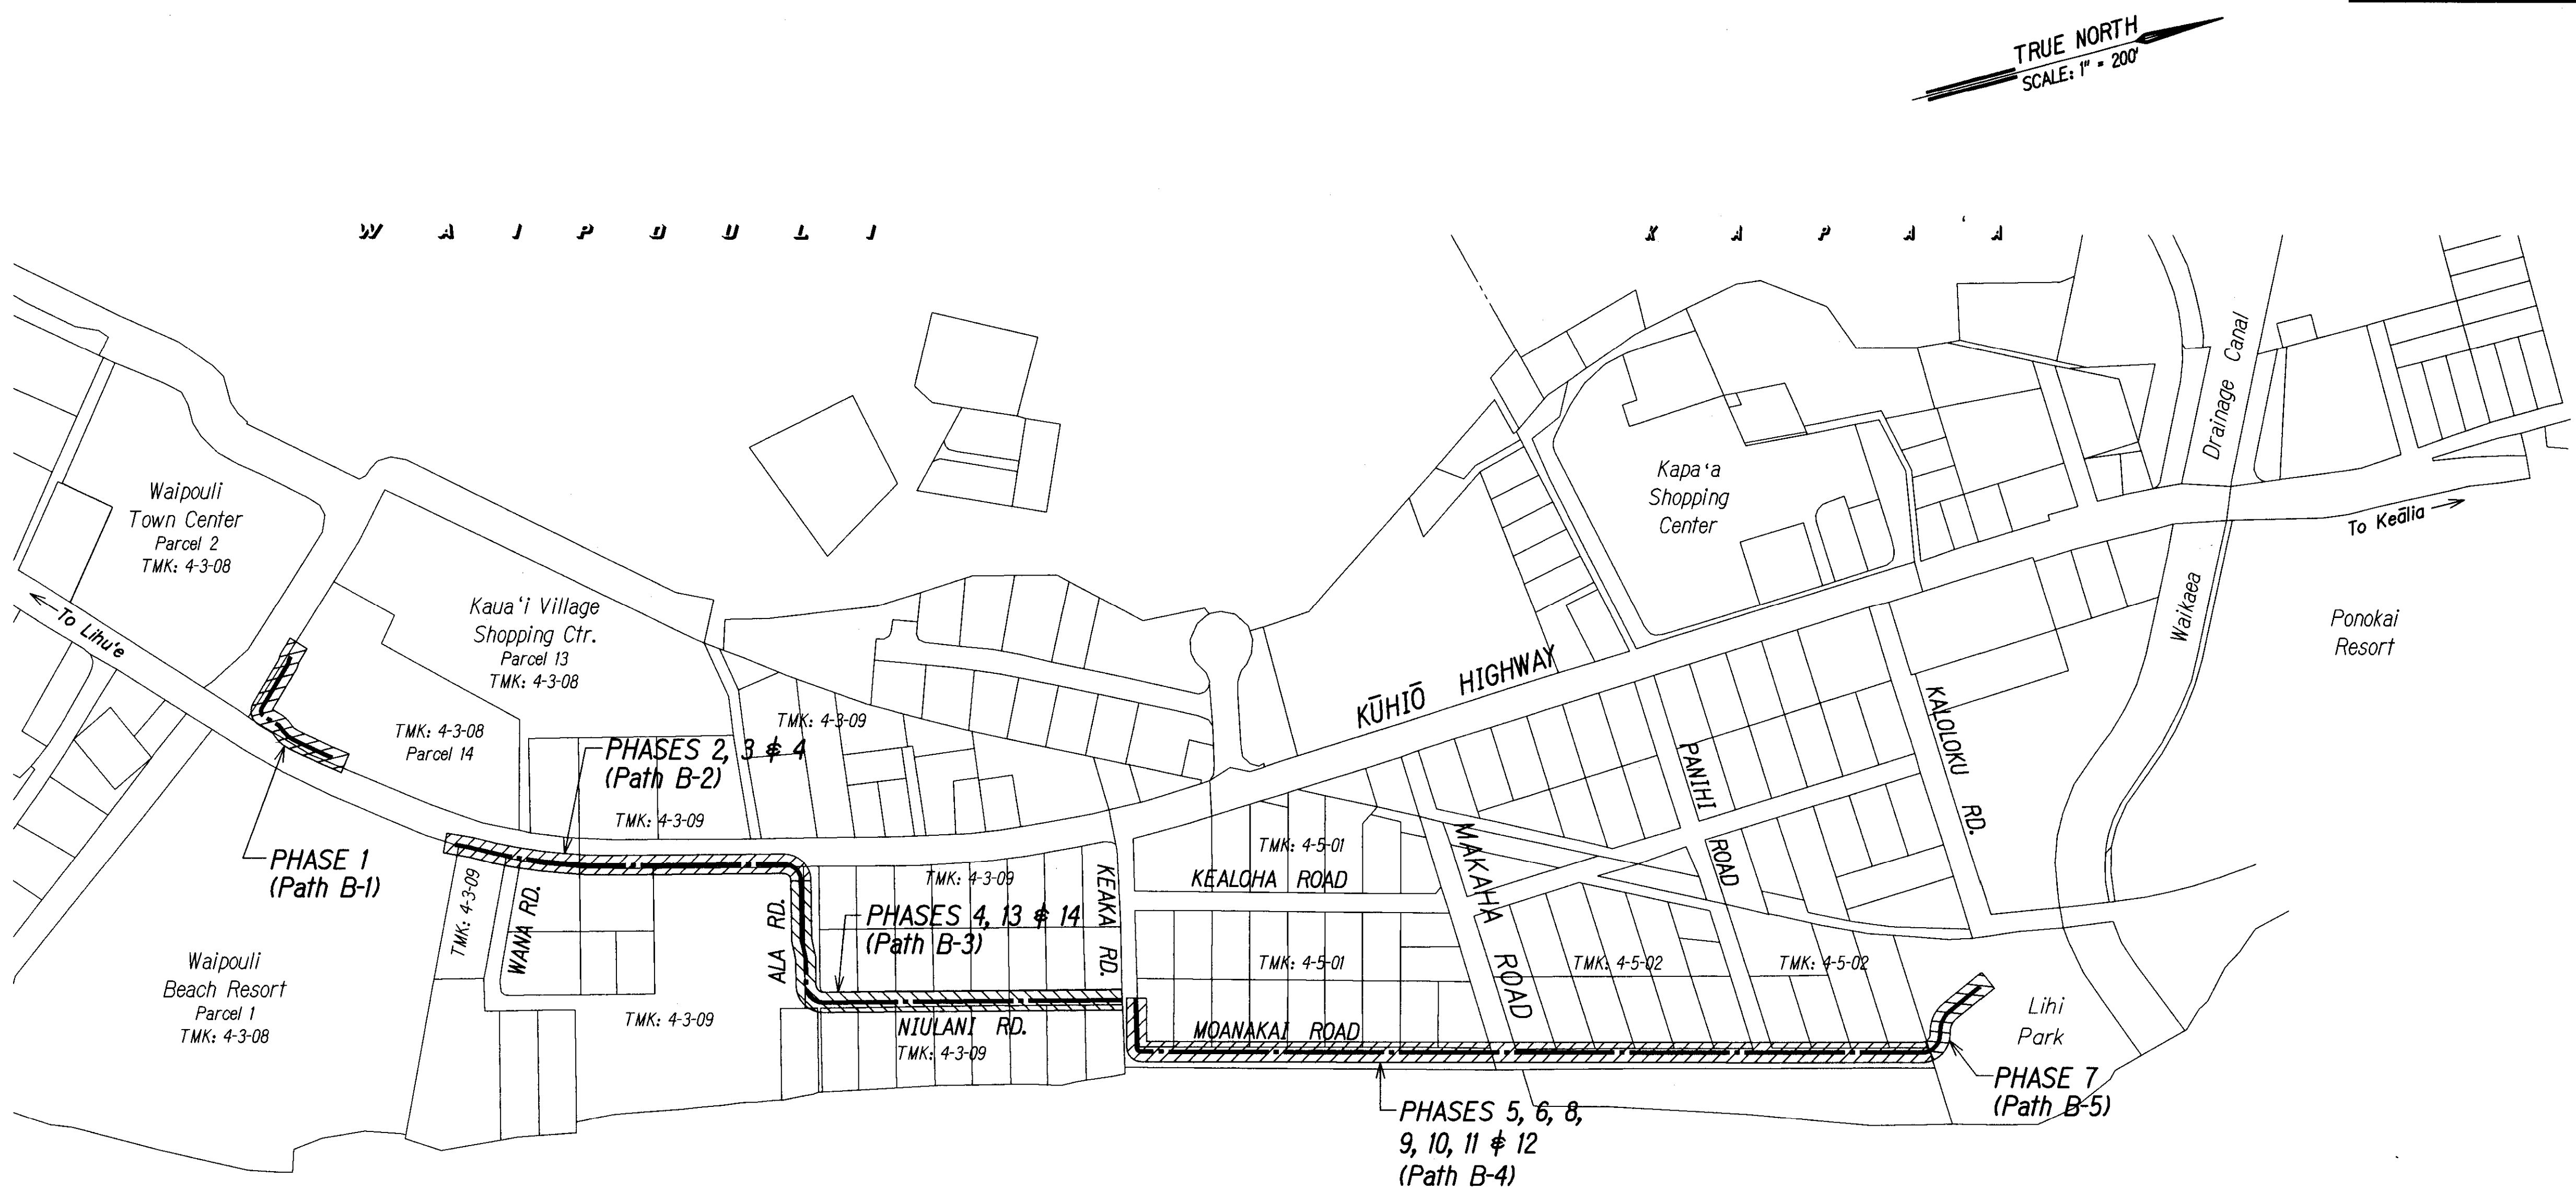

OVERALL CONSTRUCTION PHASING PLAN
SCALE: 1" = 200'

APPROVED:


COUNTY ENGINEER
(FOR WORK WITHIN COUNTY RIGHT OF WAY)
DATE: 12-21-11

THIS WORK WAS PREPARED BY ME OR UNDER MY SUPERVISION.

SIGNATURE
EXPIRATION DATE OF THE LICENSE: 4-30-12


COUNTY OF KAUAI DEPARTMENT OF PUBLIC WORKS			
LYDGATE PARK TO KAPA'A BIKE/ PEDESTRIAN PATH PHASE B KAPA'A, KAUAI, HAWAII			
OVERALL CONSTRUCTION PHASING PLAN			
FEDERAL-AID PROJECT NO. STP-0700(61) DATE: NOVEMBER 2011			
DRAWN BY: NGA	F.B.	C.B.	SHEET
TRACED BY:			
CHECKED BY: RMA			
			C12.1 OF SHEETS

FED. ROAD DIST. NO.	STATE	FED. AID PROJ. NO.	FISCAL YEAR	SHEET NO.	TOTAL SHEETS
HAWAII	HAW.	STP-0700(61)	2011	90	143

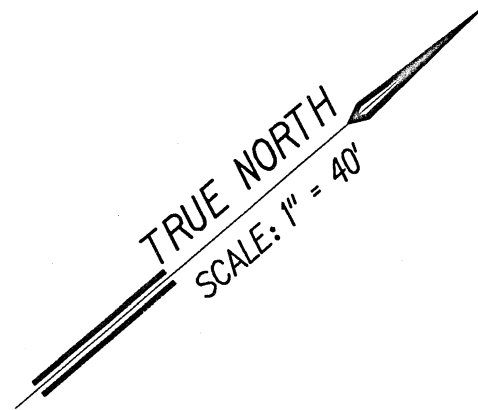

LEGEND:

- Work Zones with Cones at 10' o.c.
- Cones or Channelizing Device
- Travel Lane near Work Zone
- Construction Sign
- Flagman or Police Officer
- High Level Warning Device (Flag Tree)
- Arrow Panel

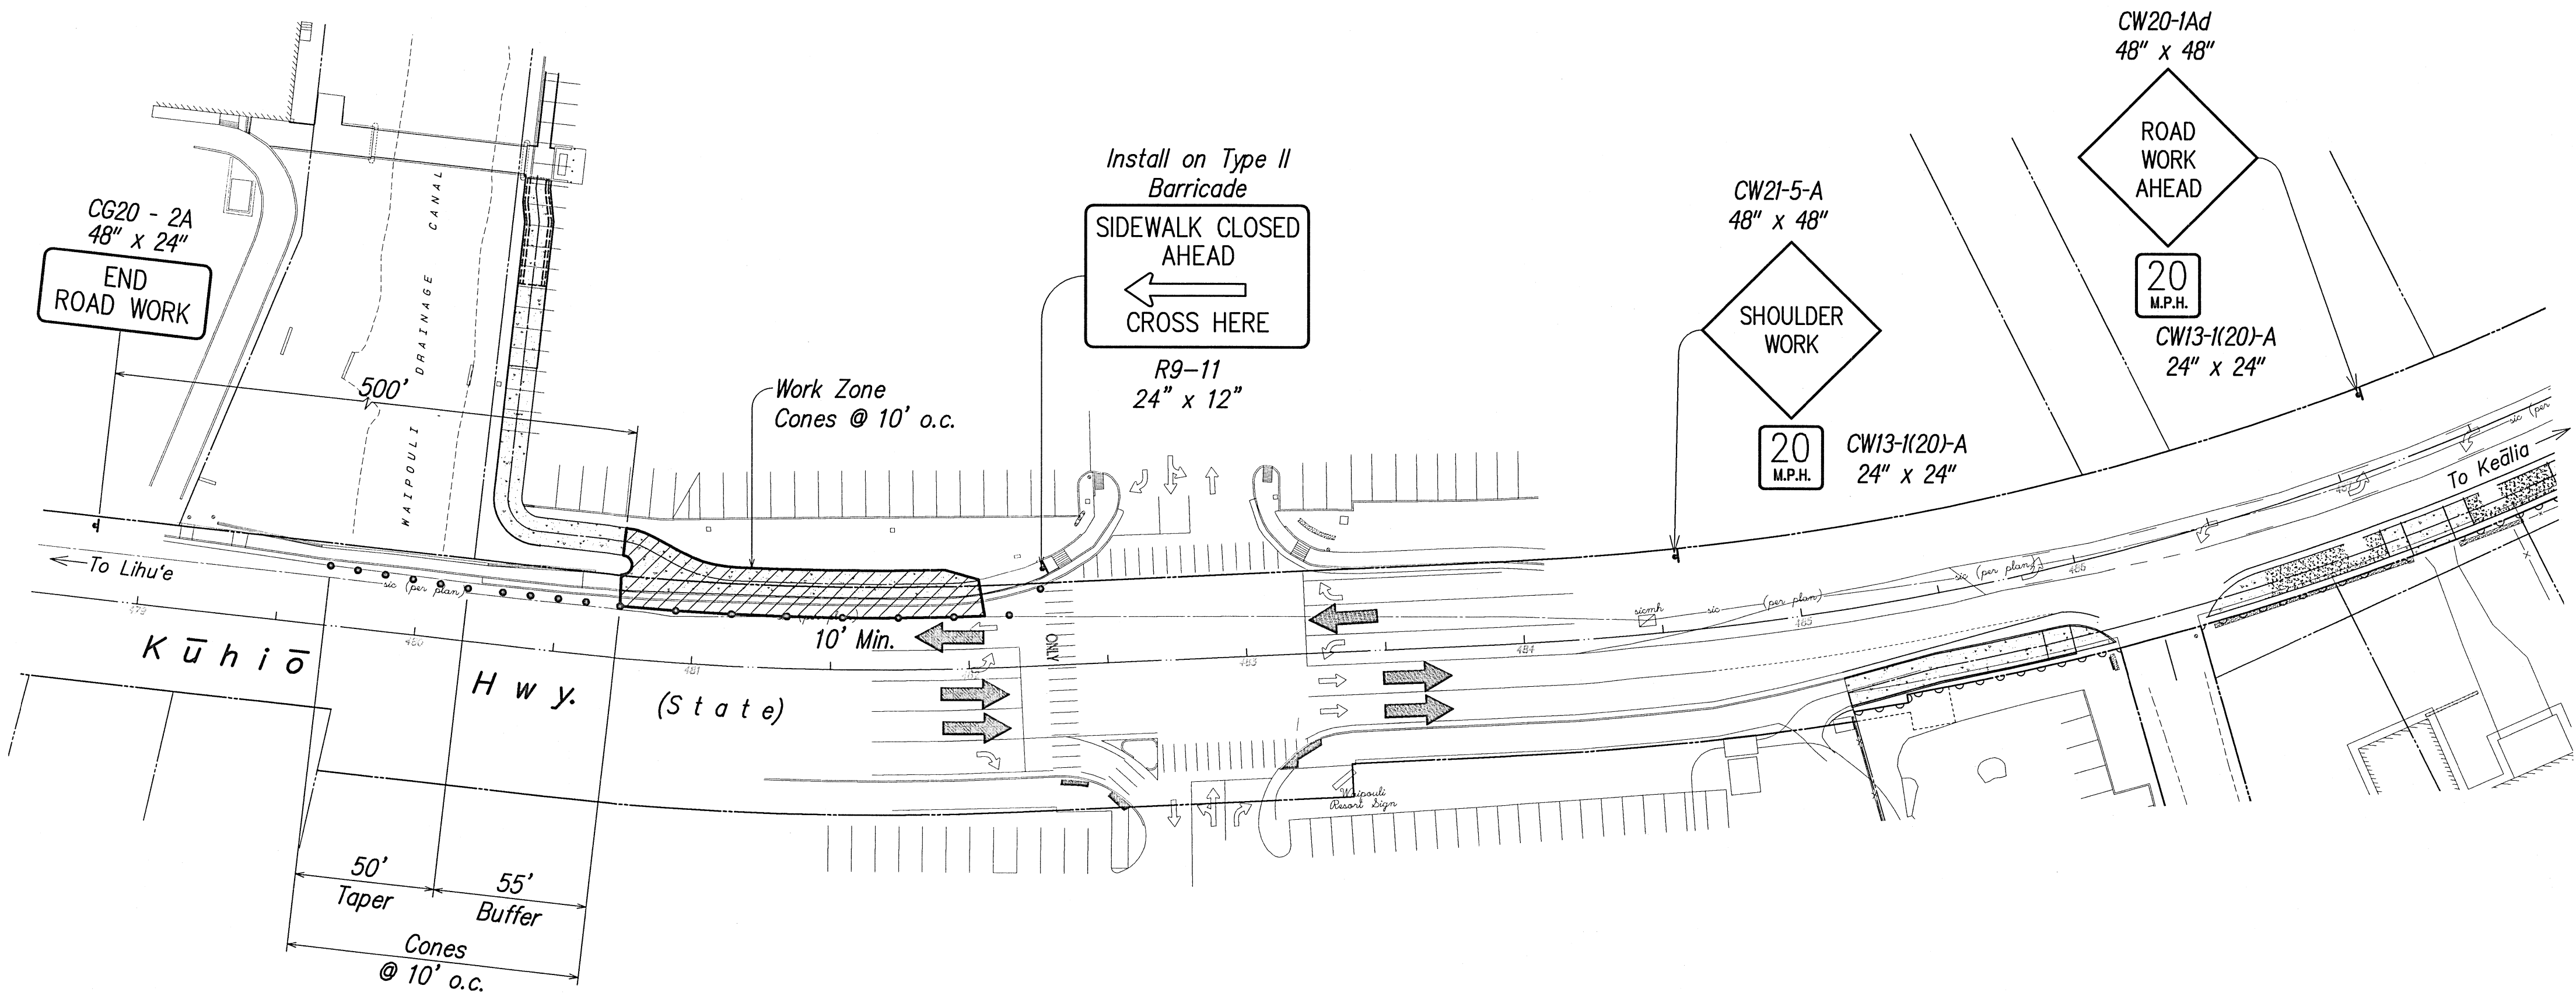


CONSTRUCTION PHASE - 1
SCALE: 1" = 40'

THIS WORK WAS PREPARED BY ME OR UNDER MY SUPERVISION. <i>Russell M. Araki</i> SIGNATURE 4-30-12 EXPIRATION DATE OF THE LICENSE	COUNTY OF KAUAI DEPARTMENT OF PUBLIC WORKS LYDGATE PARK TO KAPA'A BIKE/ PEDESTRIAN PATH PHASE B KAPA'A, KAUAI, HAWAII			
	CONSTRUCTION TRAFFIC CONTROL - PHASE 1 FEDERAL-AID PROJECT NO. STP-0700(61) DATE: NOVEMBER 2011			
	DRAWN BY: NGA	F.B.	C.B.	SHEET
	TRACED BY: RMA			C12.2 OF SHEETS

"AS-BUILT"

FED. ROAD DIST. NO.	STATE	FED. AID PROJ. NO.	FISCAL YEAR	SHEET NO.	TOTAL SHEETS
HAWAII	HAW.	STP-0700(61)	2011	91	143

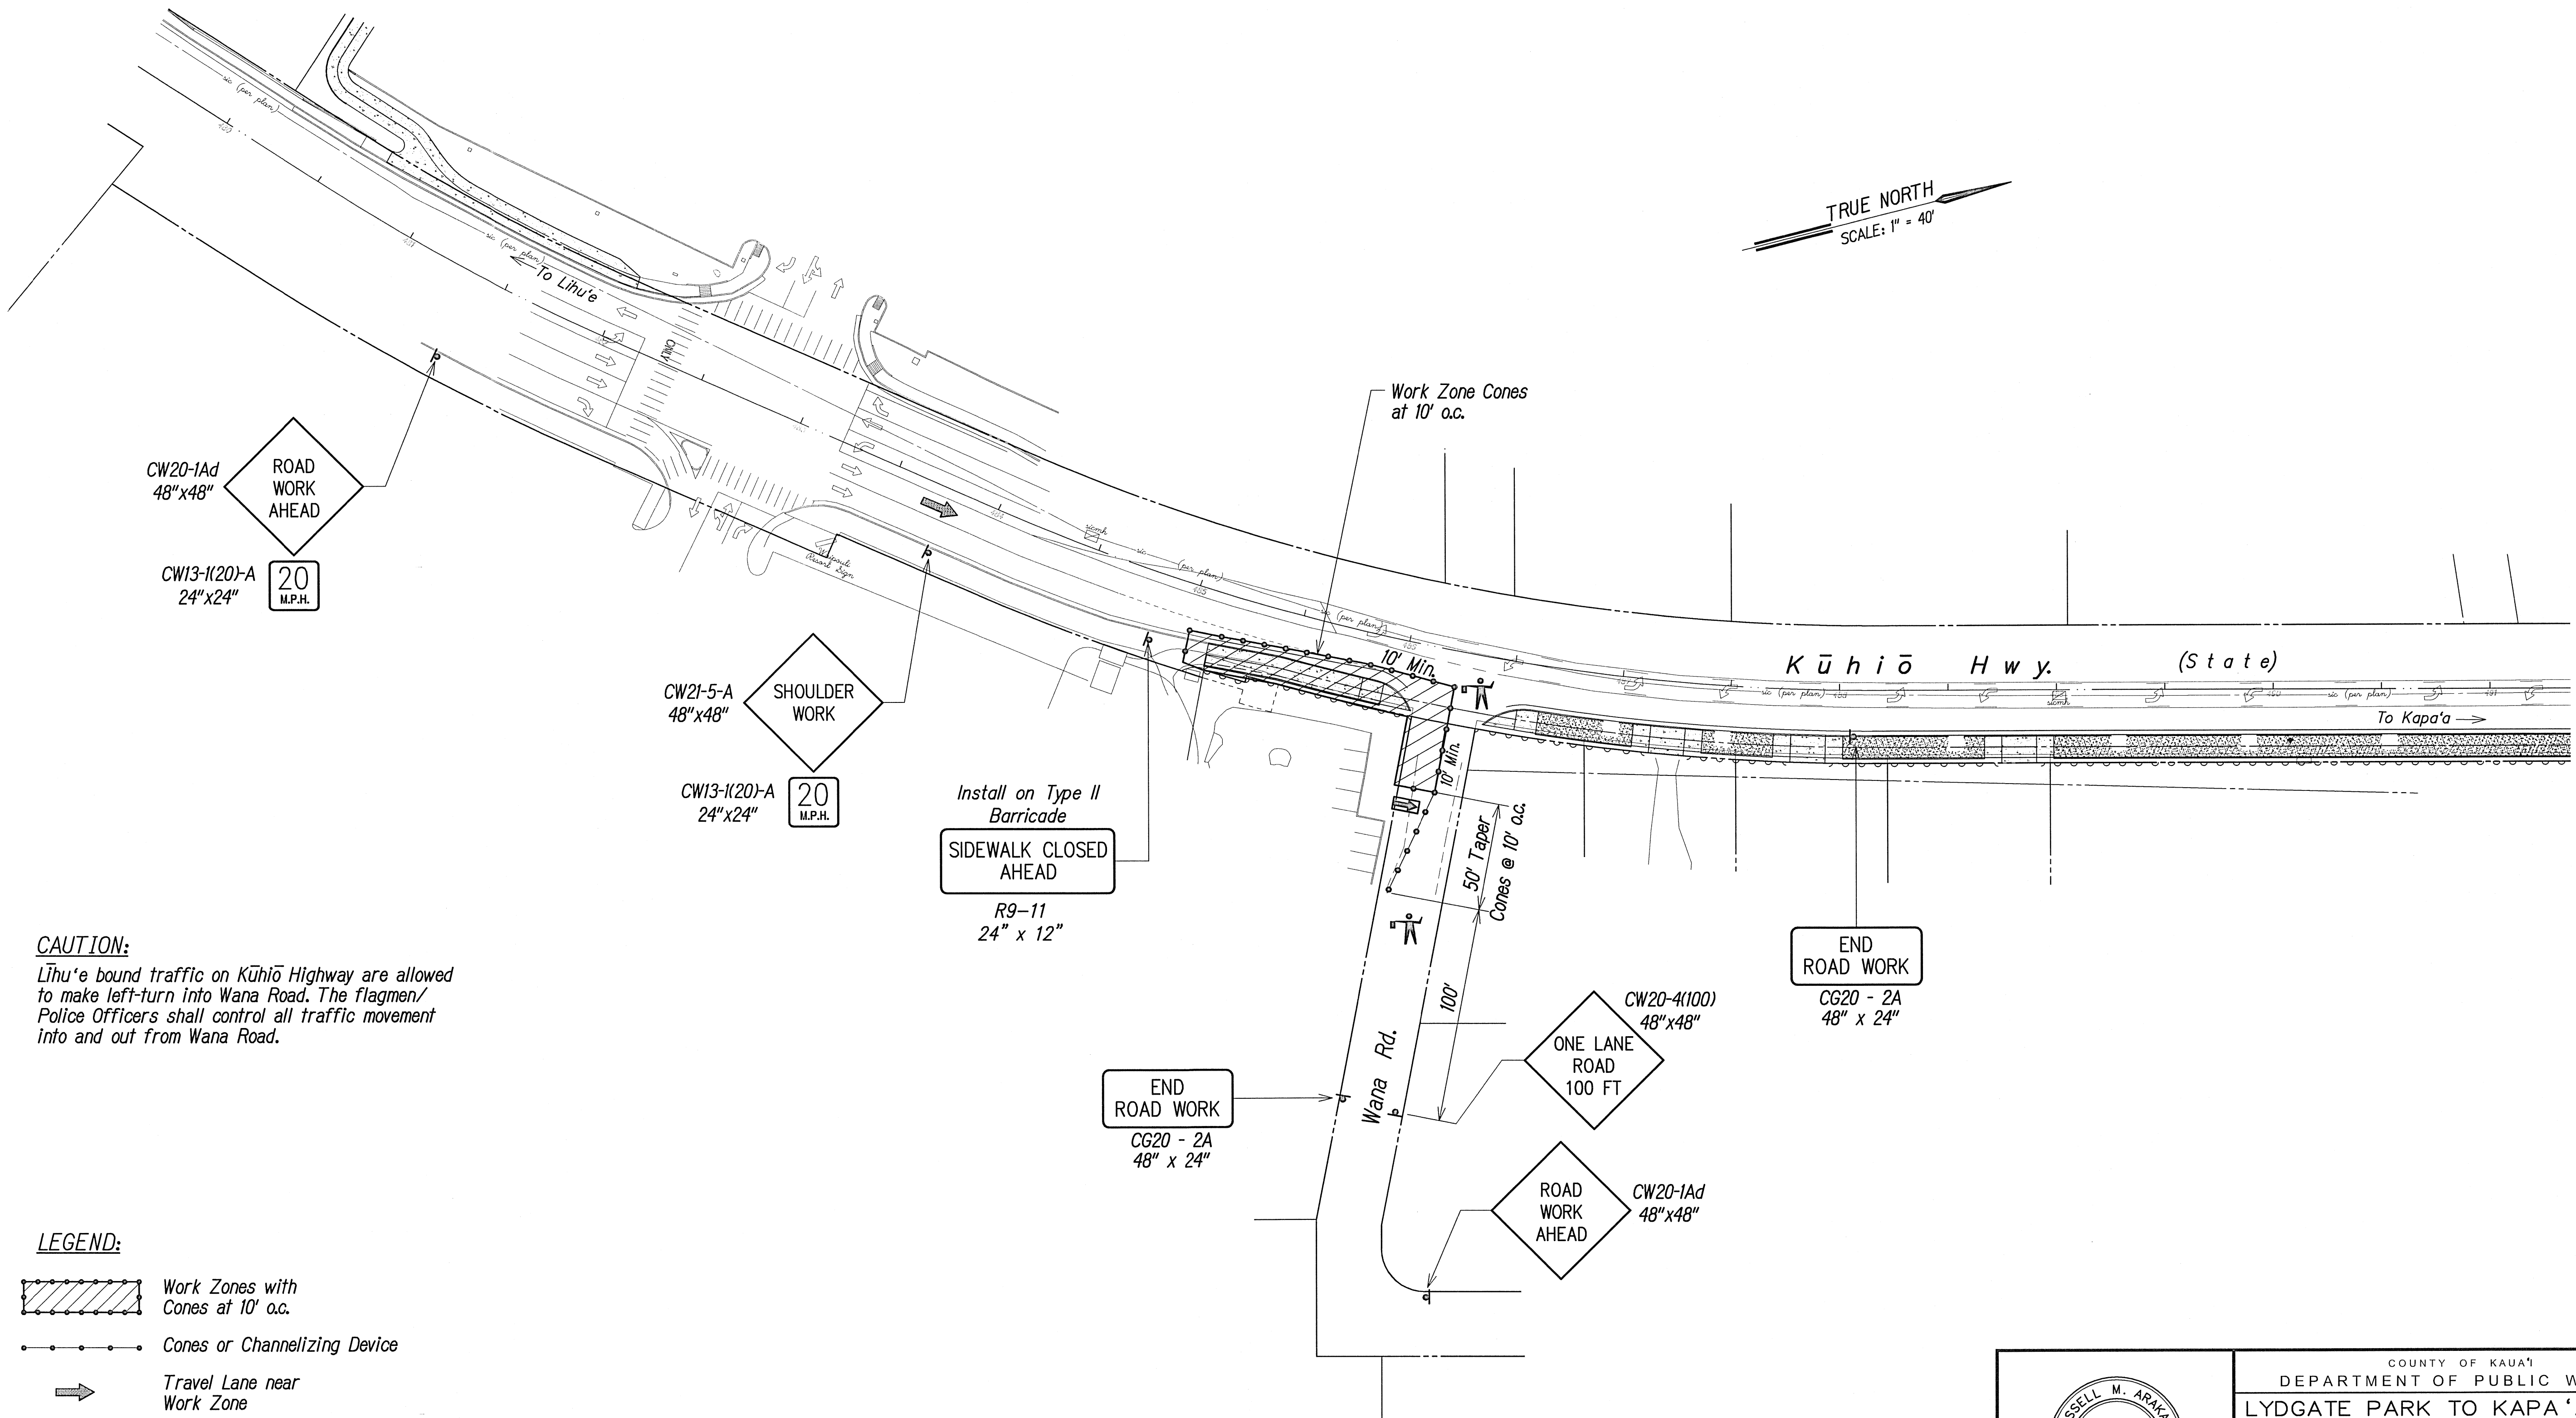

CAUTION:
Līhu'e bound traffic on Kūhiō Highway are allowed to make left-turn into Wana Road. The flagmen/Police Officers shall control all traffic movement into and out from Wana Road.

- LEGEND:**
- Work Zones with Cones at 10' o.c.
 - Cones or Channelizing Device
 - Travel Lane near Work Zone
 - Construction Sign
 - Flagman or Police Officer
 - High Level Warning Device (Flag Tree)
 - Arrow Panel

CONSTRUCTION PHASE - 2
SCALE: 1" = 40'

THIS WORK WAS PREPARED BY ME OR UNDER MY SUPERVISION.


Russell M. Arakaki 4-30-12
SIGNATURE EXPIRATION DATE OF THE LICENSE

COUNTY OF KAUAI
DEPARTMENT OF PUBLIC WORKS
LYDGATE PARK TO KAPA'A BIKE/
PEDESTRIAN PATH PHASE B
KAPA'A, KAUAI, HAWAII

**CONSTRUCTION TRAFFIC
CONTROL PLAN - PHASE 2**
FEDERAL-AID PROJECT NO. STP-0700(61)
DATE: NOVEMBER 2011

DRAWN BY: NGA	F.B.	C.B.	SHEET
CHECKED BY: RMA			C12.3 OF SHEETS

FED. ROAD DIST. NO.	STATE	FED. AID PROJ. NO.	FISCAL YEAR	SHEET NO.	TOTAL SHEETS
HAWAII	HAW.	STP-0700(61)	2011	92	143

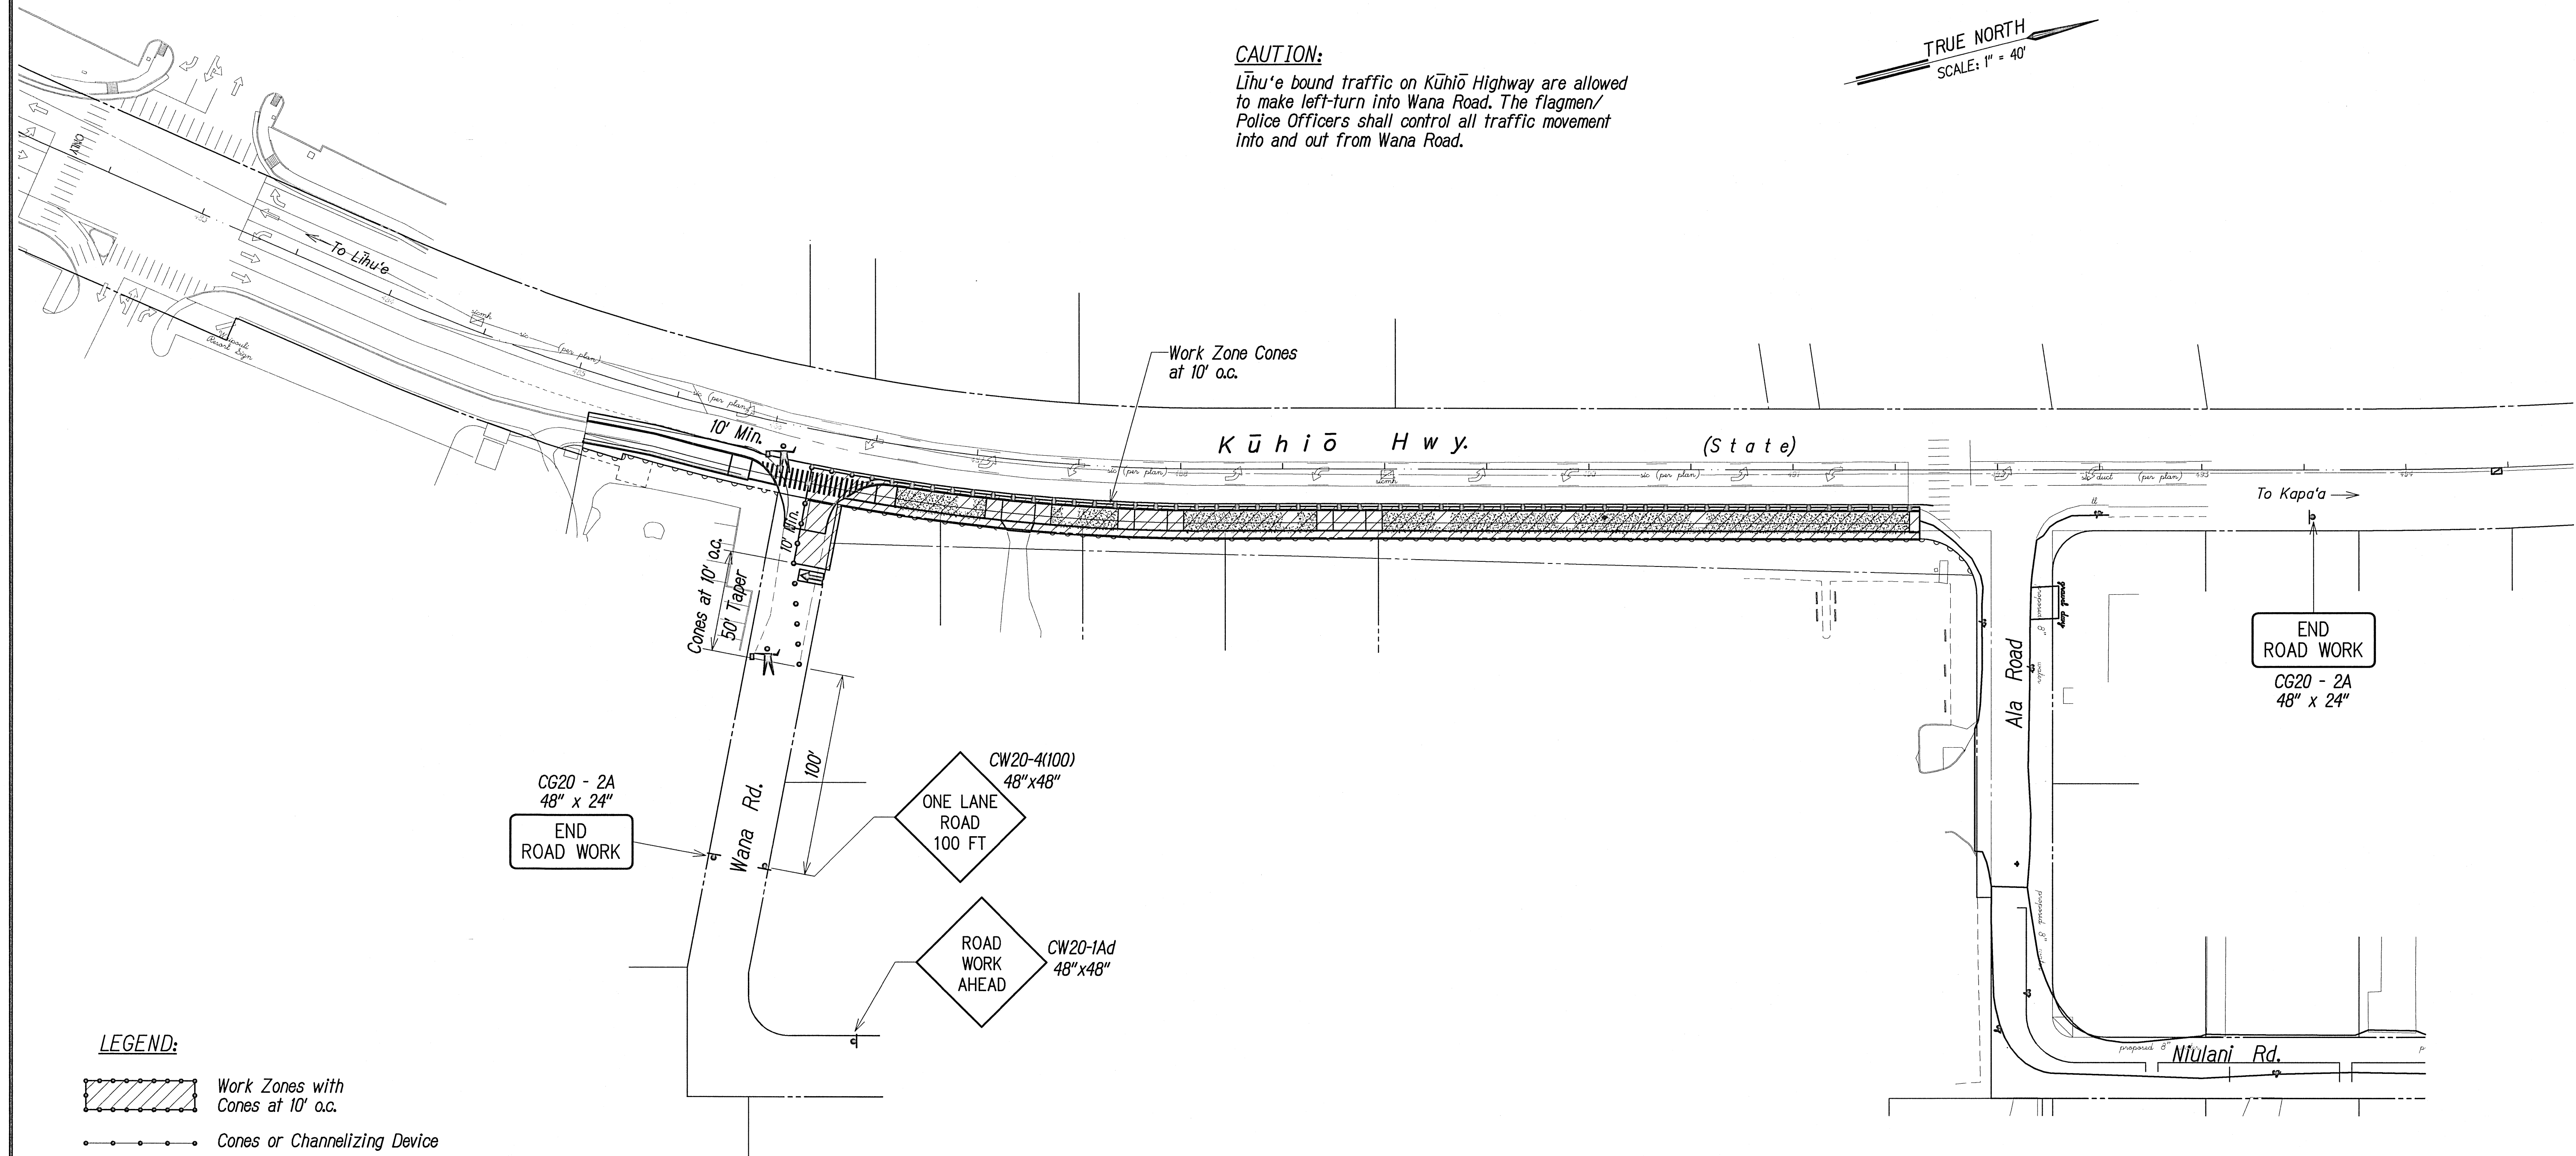


CONSTRUCTION PHASE - 3
SCALE: 1" = 40'

THIS WORK WAS PREPARED BY ME OR UNDER MY SUPERVISION. <i>Russell M. Arakawa</i> SIGNATURE 4-30-12 EXPIRATION DATE OF THE LICENSE	COUNTY OF KAUAI DEPARTMENT OF PUBLIC WORKS LYDGATE PARK TO KAPA'A BIKE/PEDESTRIAN PATH PHASE B KAPA'A, KAUAI, HAWAII			
	CONSTRUCTION TRAFFIC CONTROL PLAN - PHASE 3 FEDERAL-AID PROJECT NO. STP-0700(61) DATE: NOVEMBER 2011			
	DRAWN BY: NGA	F.B.	C.B.	SHEET
	TRACED BY: RMA			C12.4 OF SHEETS

"AS-BUILT"

FED. ROAD DIST. NO.	STATE	FED. AID PROJ. NO.	FISCAL YEAR	SHEET NO.	TOTAL SHEETS
HAWAII	HAW.	STP-0700(61)	2011	93	143

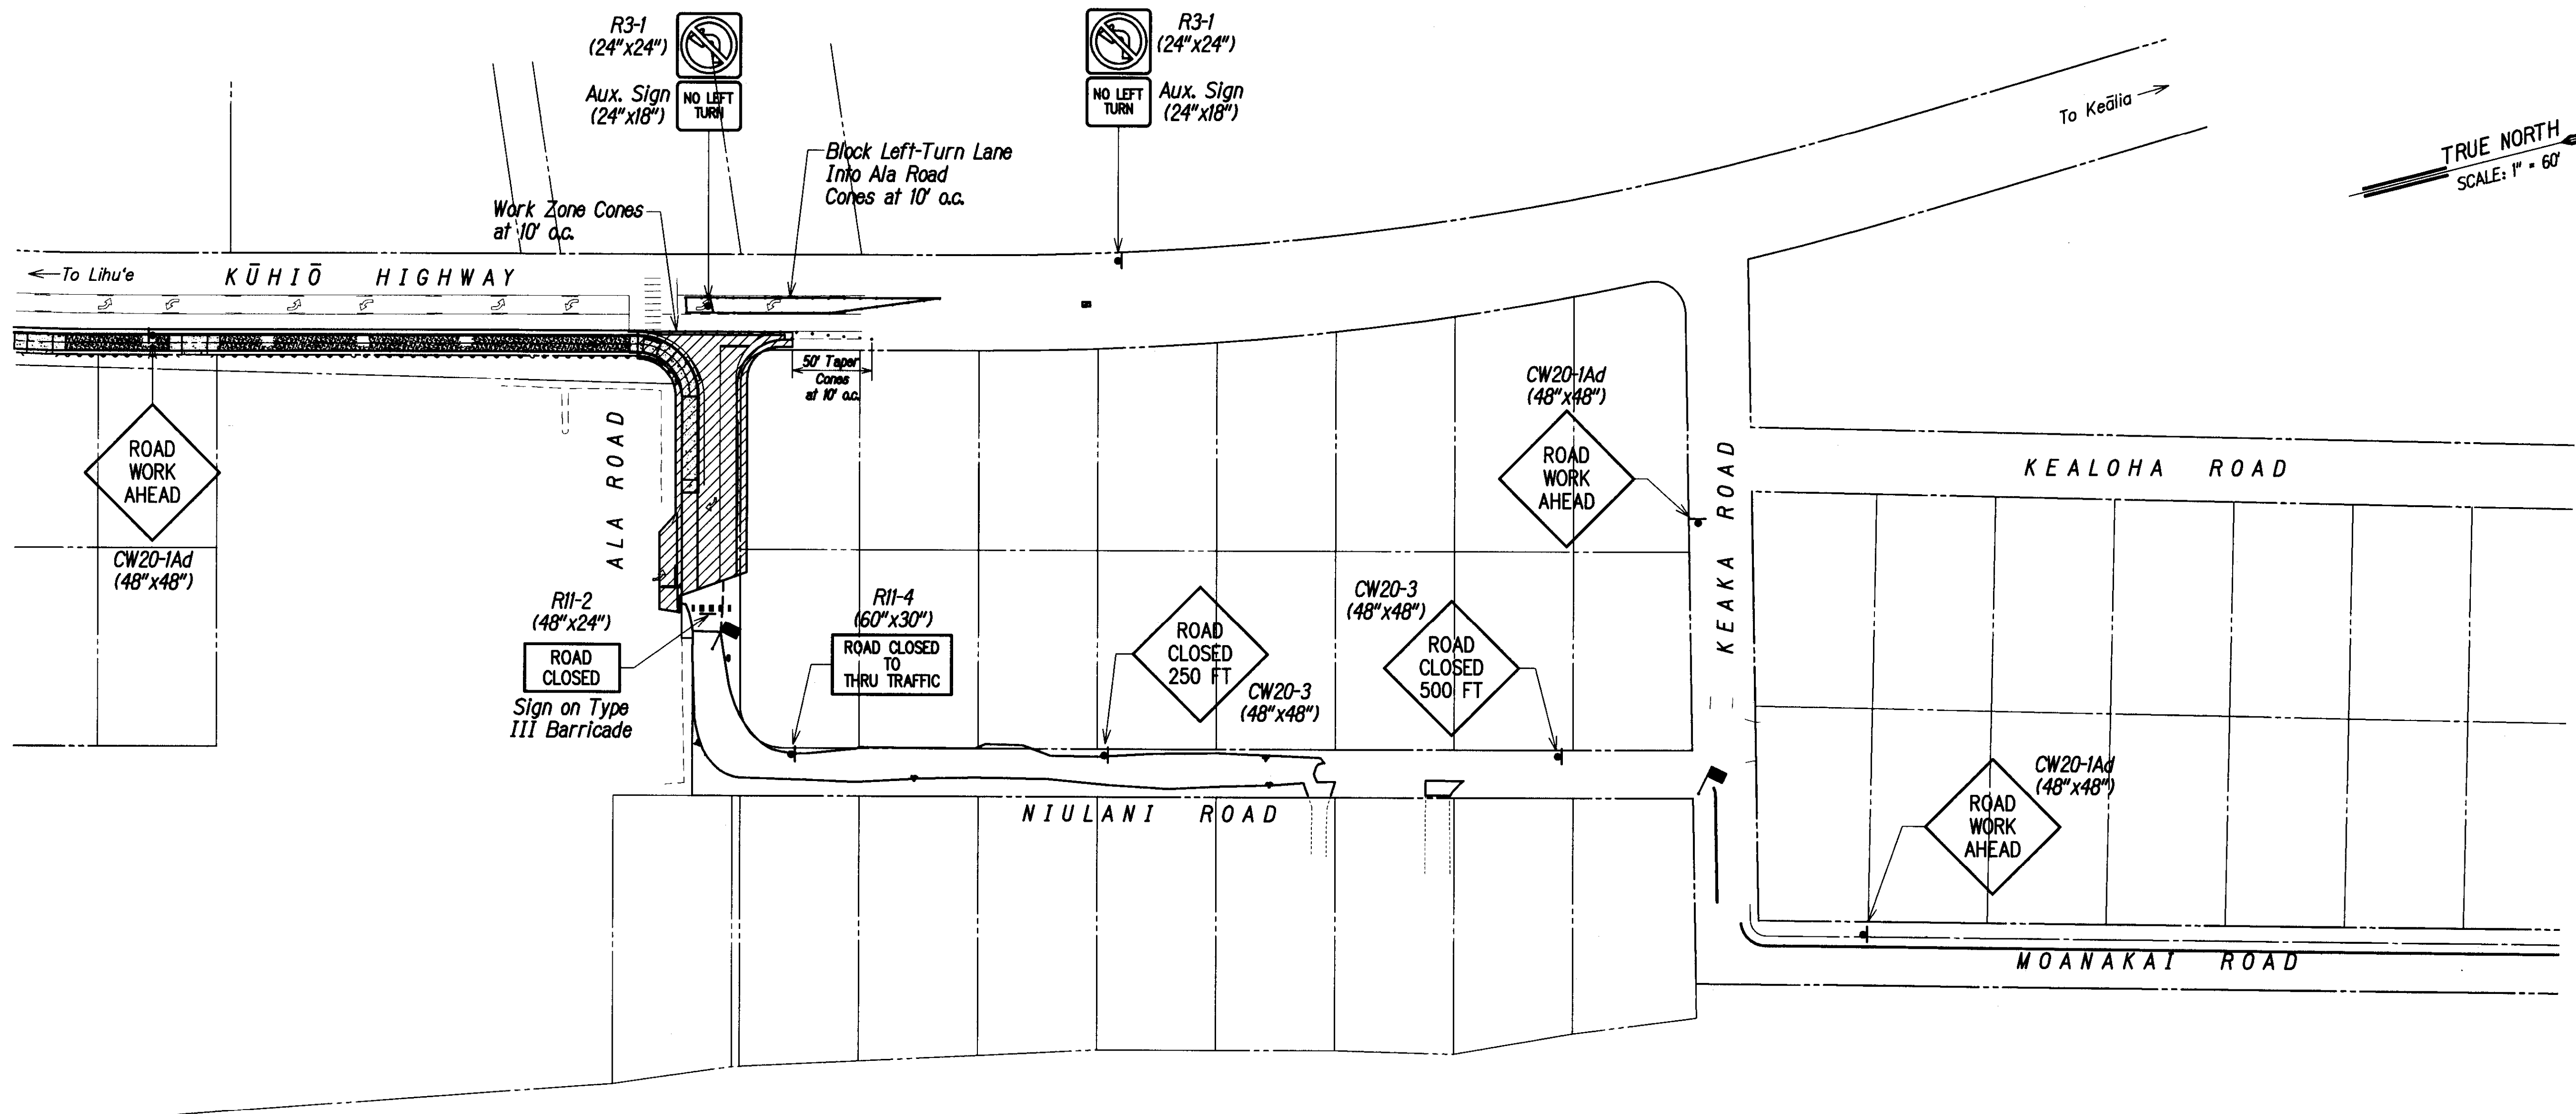

LEGEND:

- Work Zones with Cones at 10' o.c.
- Cones or Channelizing Device
- Travel Lane near Work Zone
- Construction Sign
- Flagman or Police Officer
- High Level Warning Device (Flag Tree)
- Arrow Panel

CONSTRUCTION PHASE - 4
SCALE: 1" = 60'

APPROVED:

COUNTY ENGINEER
(FOR WORK WITHIN COUNTY RIGHT OF WAY)


12-21-11
DATE

THIS WORK WAS PREPARED BY
ME OR UNDER MY SUPERVISION.
SIGNATURE
EXPIRATION DATE OF THE LICENSE 4-30-12

COUNTY OF KAUAI DEPARTMENT OF PUBLIC WORKS LYDGATE PARK TO KAPA'A BIKE/ PEDESTRIAN PATH PHASE B KAPA'A, KAUAI, HAWAII				
CONSTRUCTION TRAFFIC CONTROL PLAN - PHASE 4 FEDERAL-AID PROJECT NO. STP-0700(61) DATE: NOVEMBER 2011				
DRAWN BY: NGA	F.B.	C.B.	SHEET	
TRACED BY: RMA			C12.5	
CHECKED BY:			OF SHEETS	

"AS-BUILT"

FED. ROAD DIST. NO.	STATE	FED. AID PROJ. NO.	FISCAL YEAR	SHEET NO.	TOTAL SHEETS
HAWAII	HAW.	STP-0700(61)	2011	94	143

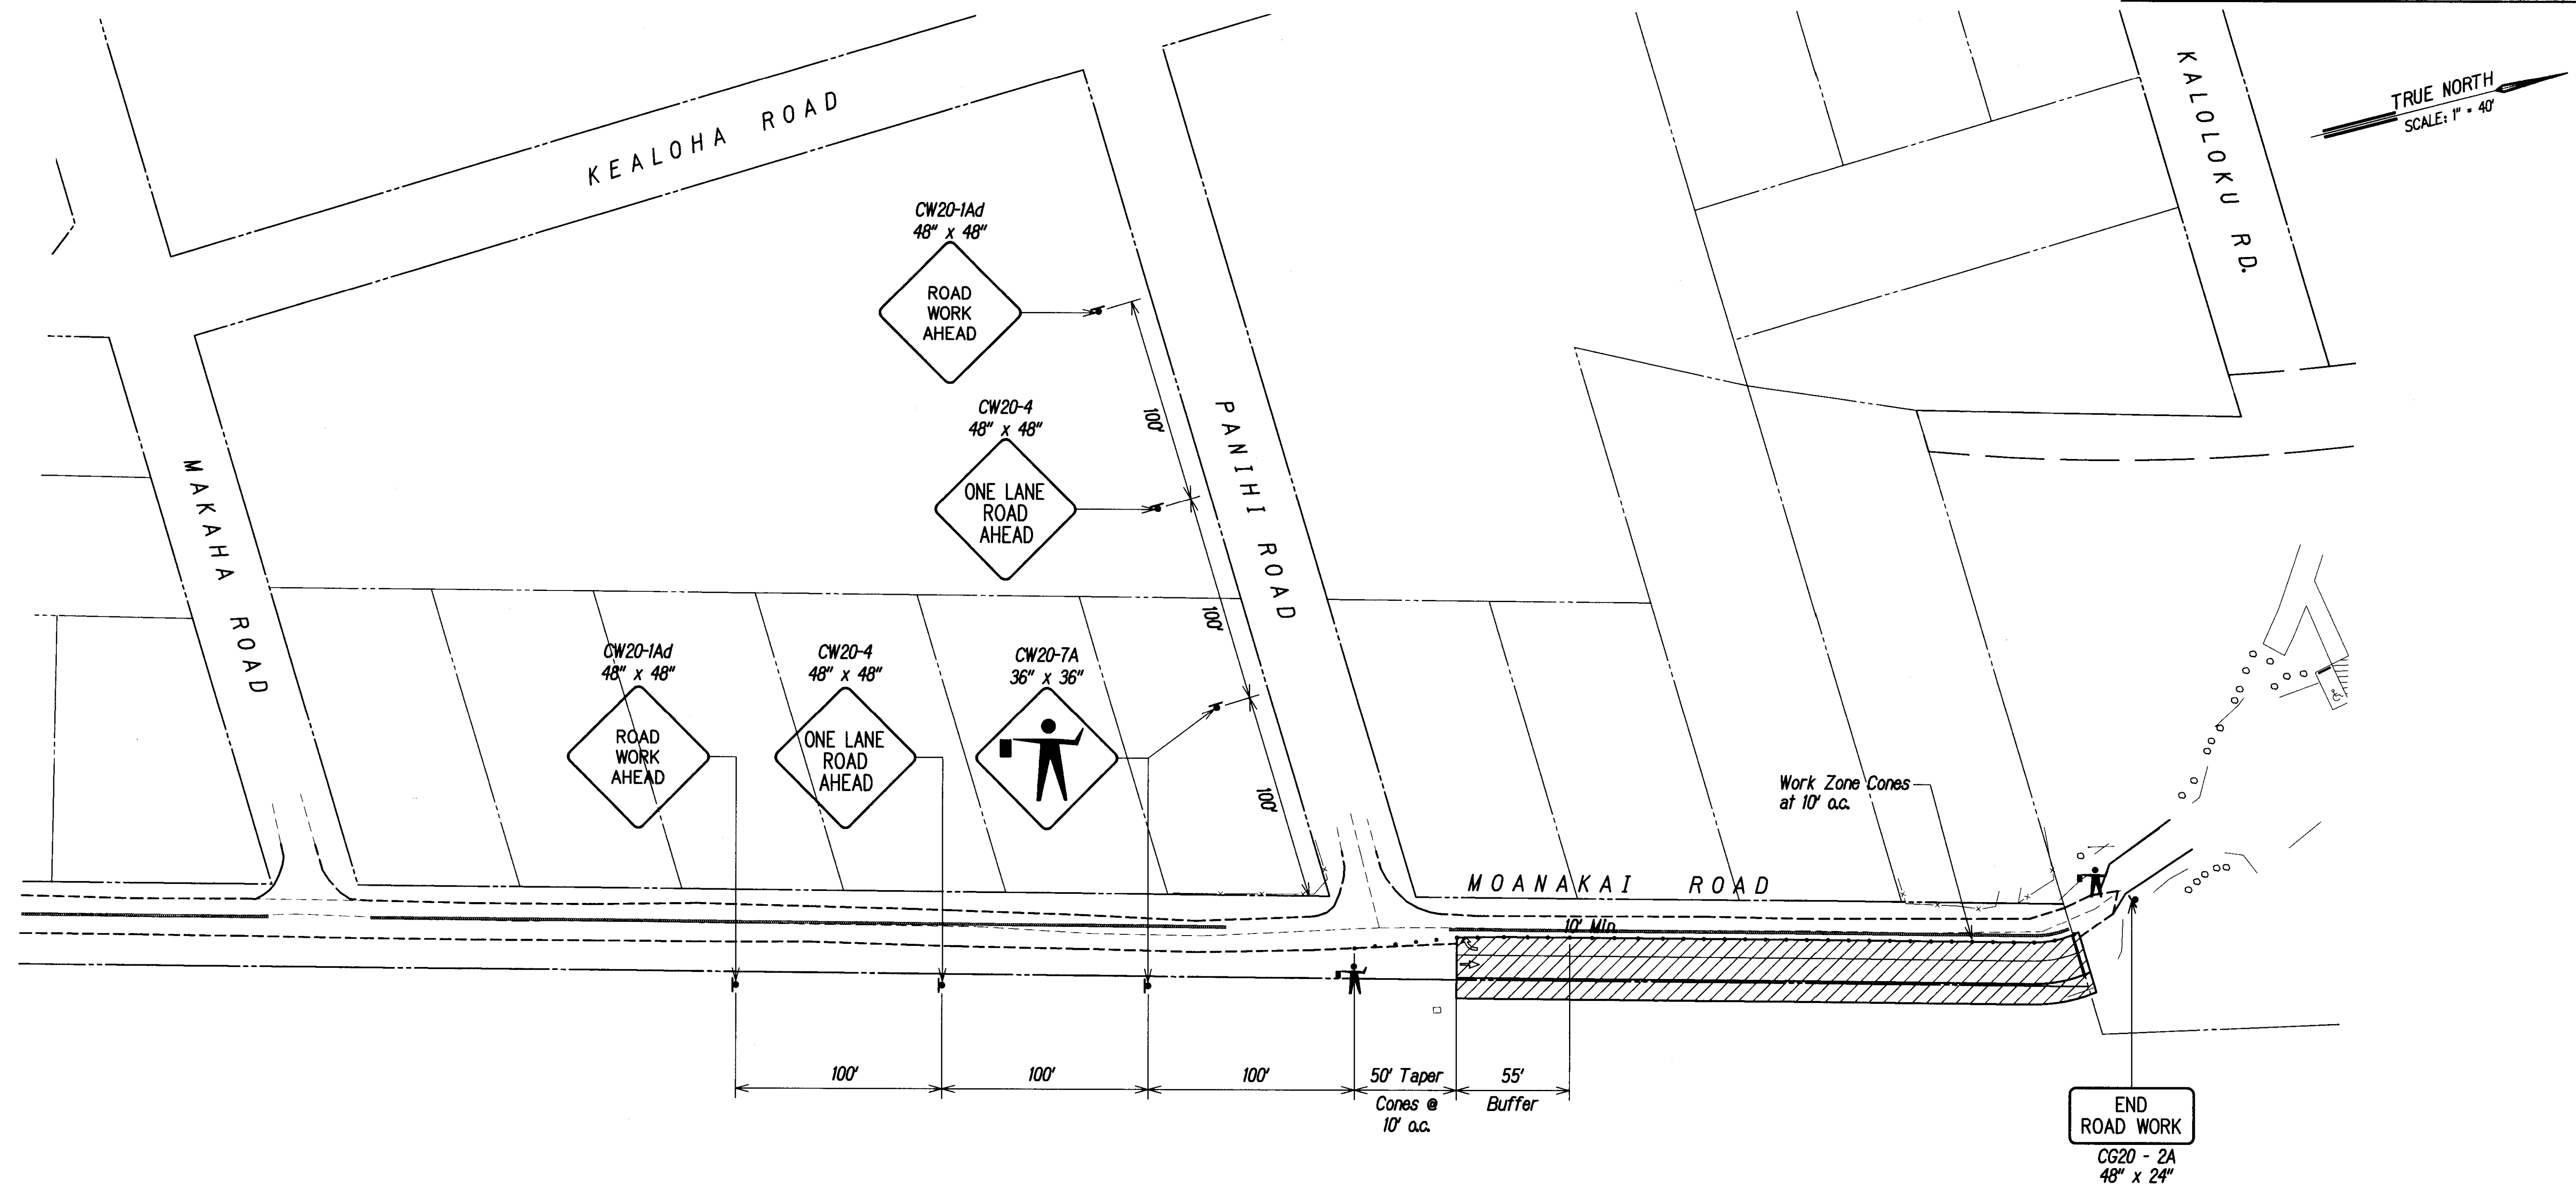

LEGEND:


- Work Zones with Cones at 10' o.c.
- Cones or Channelizing Device
- Travel Lane near Work Zone
- Construction Sign
- Flagman or Police Officer
- High Level Warning Device (Flag Tree)
- Arrow Panel

CONSTRUCTION PHASE - 5
SCALE: 1" = 40'

APPROVED:

COUNTY ENGINEER
(FOR WORK WITHIN COUNTY RIGHT OF WAY)

12-21-11
DATE

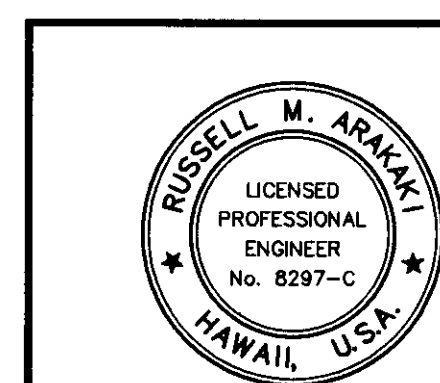

THIS WORK WAS PREPARED BY ME OR UNDER MY SUPERVISION.



SIGNATURE
EXPIRATION DATE OF THE LICENSE 4-30-12

COUNTY OF KAUAI DEPARTMENT OF PUBLIC WORKS				
LYDGE PARK TO KAPA'A BIKE/ PEDESTRIAN PATH PHASE B KAPA'A, KAUAI, HAWAII				
CONSTRUCTION TRAFFIC CONTROL PLAN - PHASE 5				
FEDERAL-AID PROJECT NO. STP-0700(61) DATE: NOVEMBER 2011				
DRAWN BY: NGA	F.B.	C.B.	SHEET	
TRACED BY: RMA			C12.6	
CHECKED BY:			OF SHEETS	

"AS-BUILT"

FED. ROAD DIST. NO.	STATE	FED. AID PROJ. NO.	FISCAL YEAR	SHEET NO.	TOTAL SHEETS
HAWAII	HAW.	STP-0700(61)	2011	95	143

TRUE NORTH
SCALE: 1" = 40'

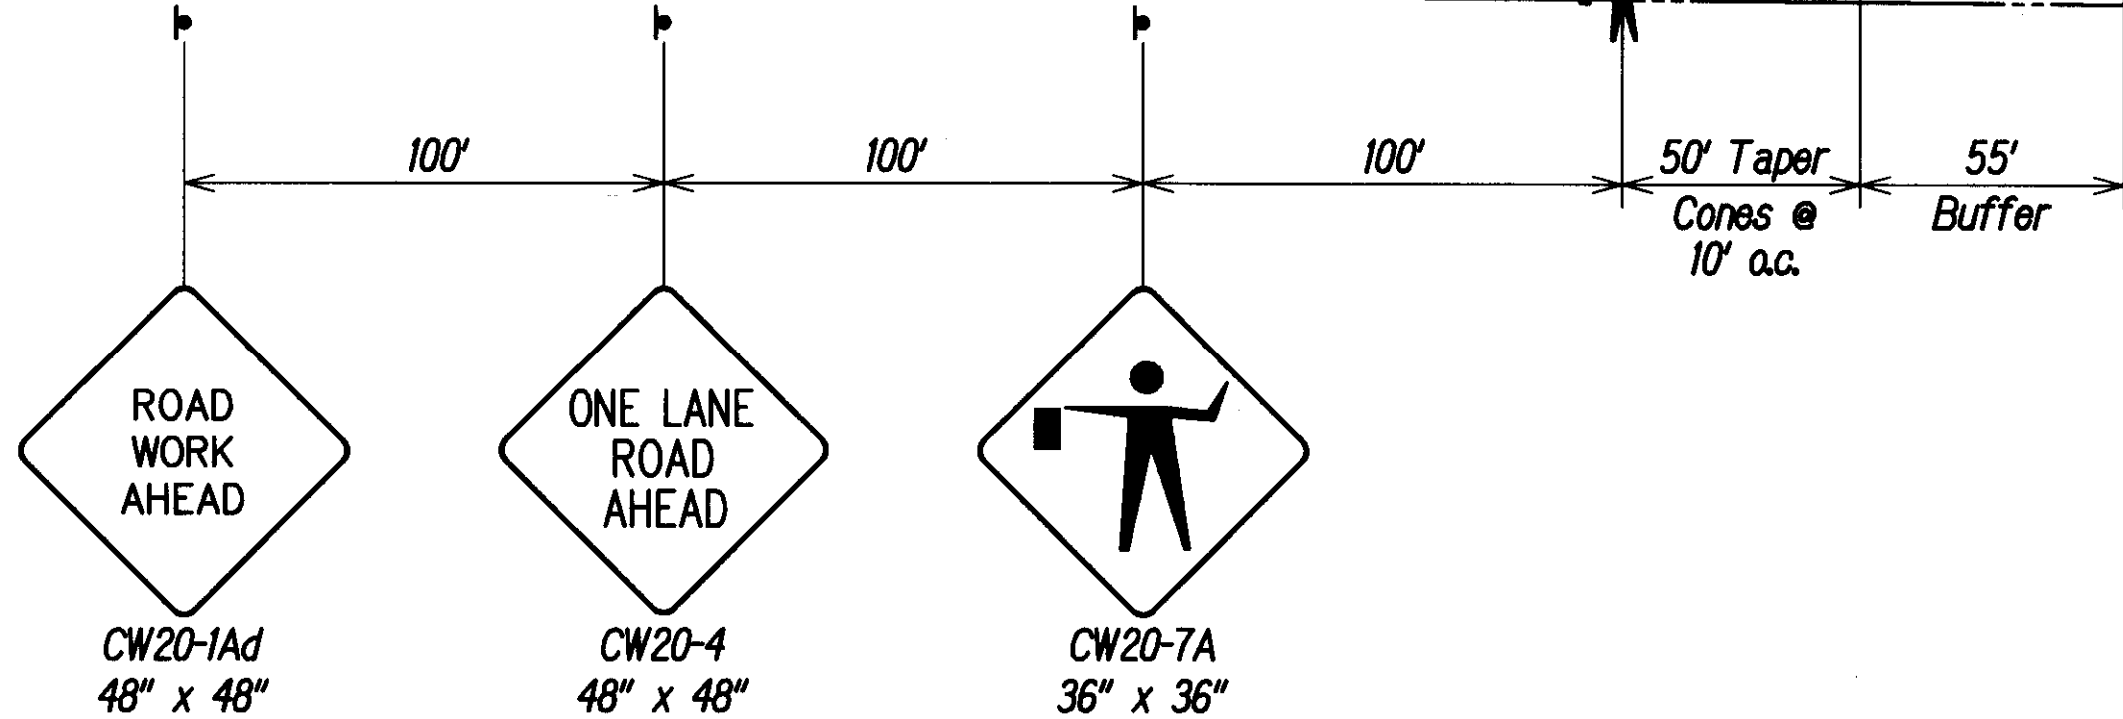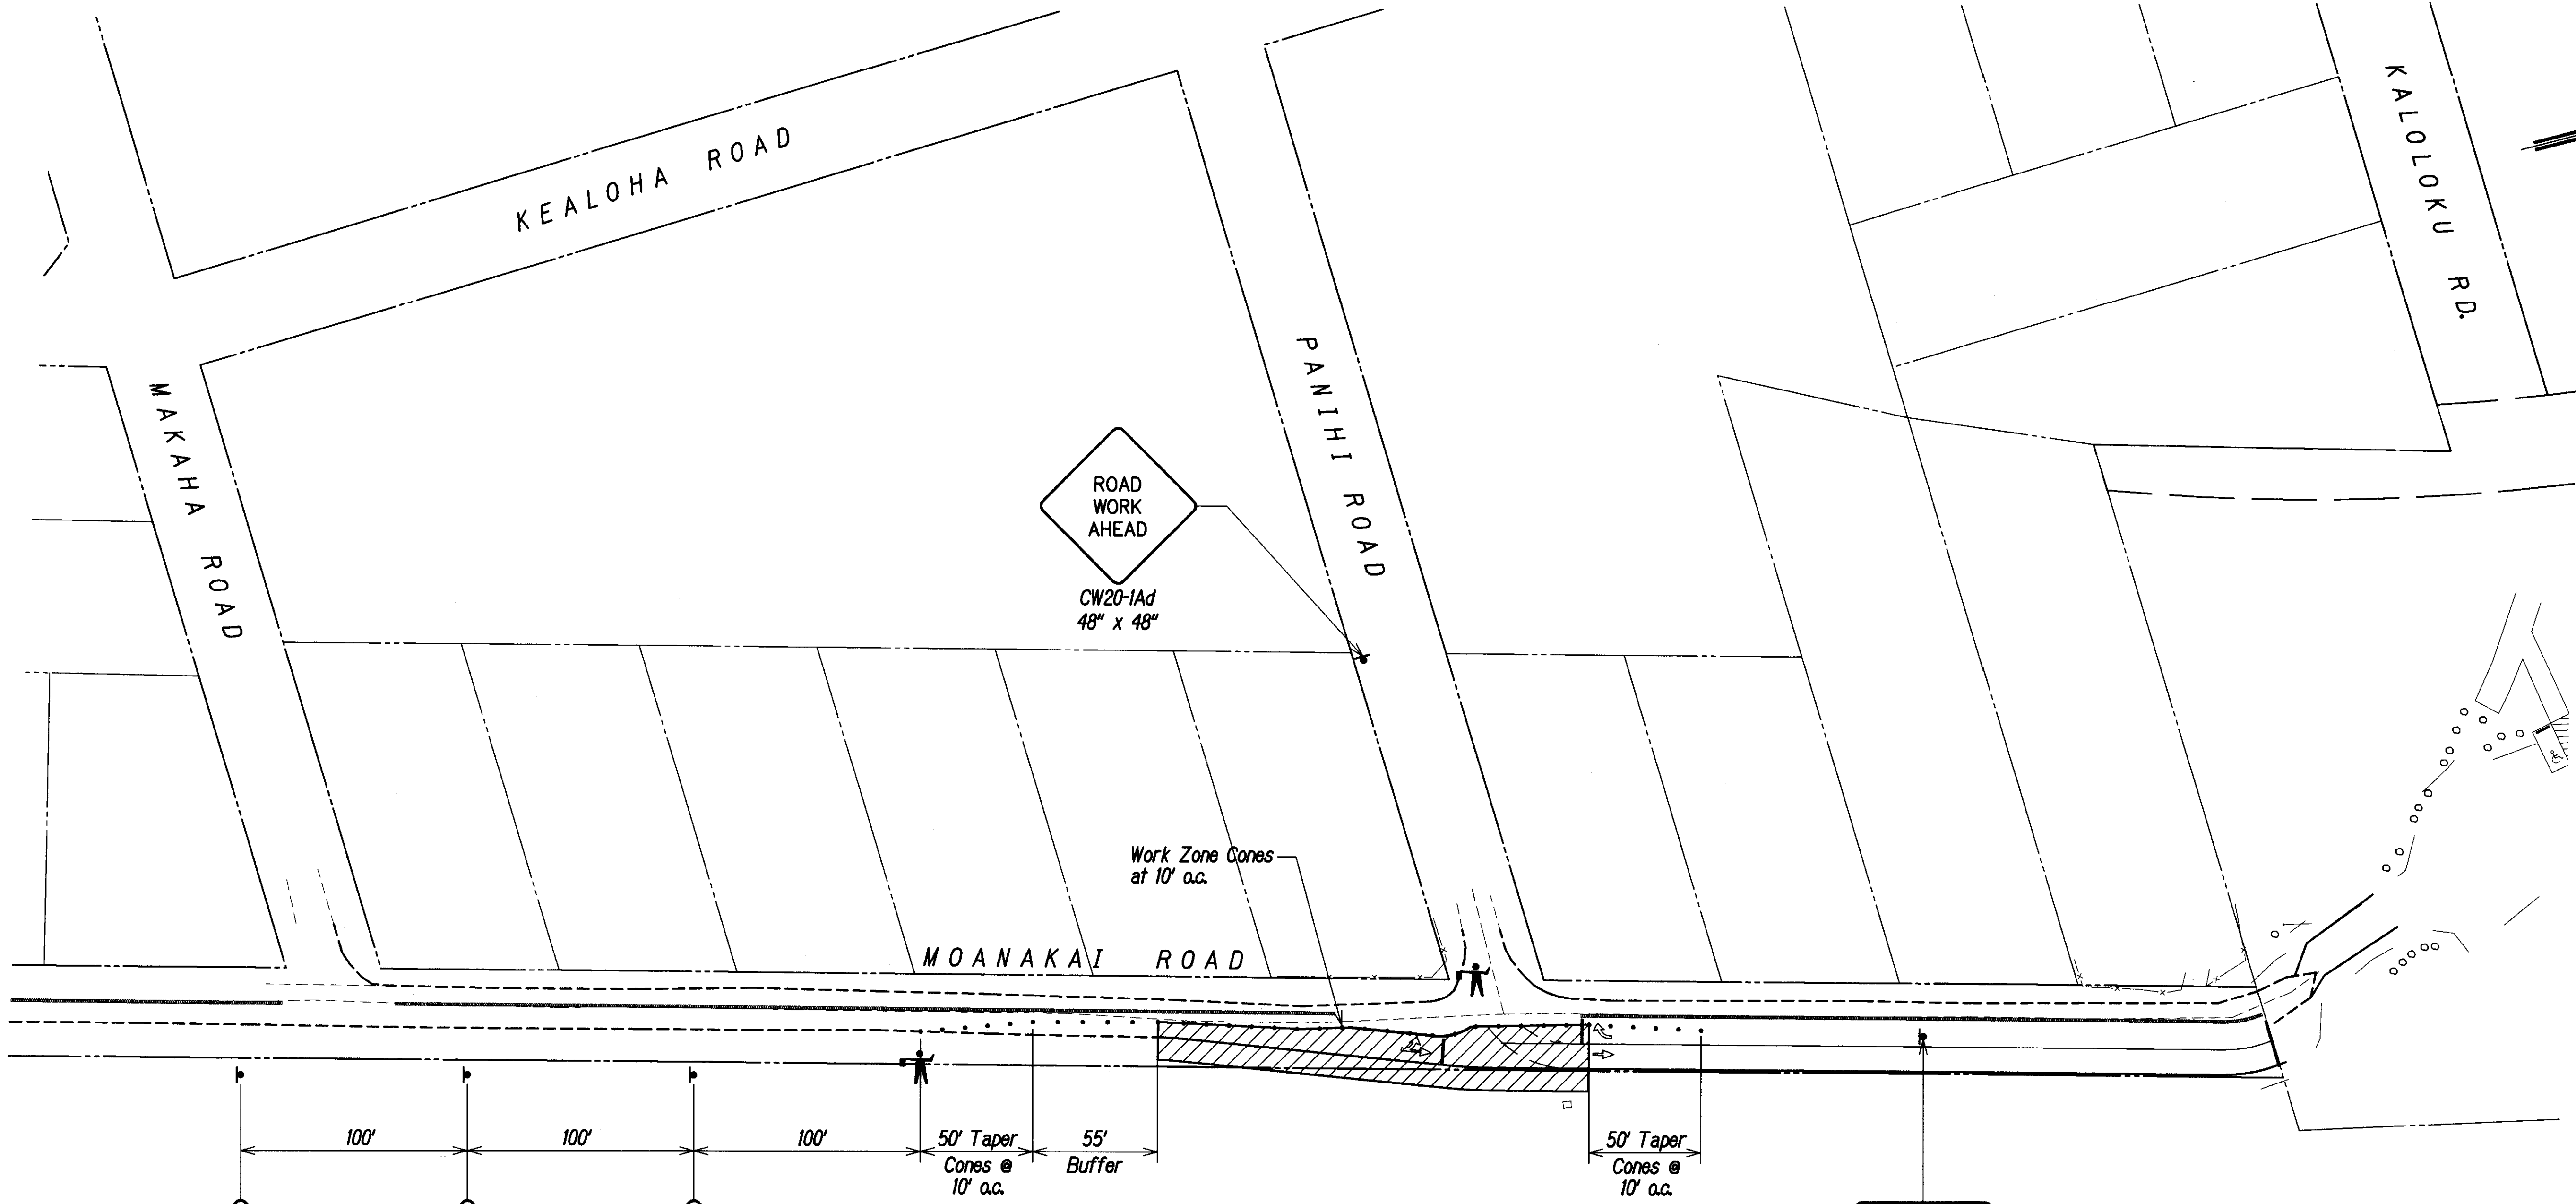

- LEGEND:**
- Work Zones with Cones at 10' o.c.
 - Cones or Channelizing Device
 - Travel Lane near Work Zone
 - Construction Sign
 - Flagman or Police Officer
 - High Level Warning Device (Flag Tree)
 - Arrow Panel

END
ROAD WORK
CG20 - 2A
48" x 24"

CONSTRUCTION PHASE - 6
SCALE: 1" = 40'


APPROVED:
COUNTY ENGINEER
(FOR WORK WITHIN COUNTY RIGHT OF WAY)
DATE: 12-21-11

THIS WORK WAS PREPARED BY ME OR UNDER MY SUPERVISION.
SIGNATURE:
EXPIRATION DATE OF THE LICENSE: 4-30-12

COUNTY OF KAUAI DEPARTMENT OF PUBLIC WORKS LYDGATE PARK TO KAPA'A BIKE/ PEDESTRIAN PATH PHASE B KAPA'A, KAUAI, HAWAII				
CONSTRUCTION TRAFFIC CONTROL PLAN - PHASE 6 FEDERAL-AID PROJECT NO. STP-0700(61) DATE: NOVEMBER 2011				
DRAWN BY:	NGA	F.B.	C.B.	SHEET
TRACED BY:				
CHECKED BY:	RMA			
				C12.7 OF SHEETS

"AS-BUILT"

FED. ROAD DIST. NO.	STATE	FED. AID PROJ. NO.	FISCAL YEAR	SHEET NO.	TOTAL SHEETS
HAWAII	HAW.	STP-0700(61)	2011	96	143

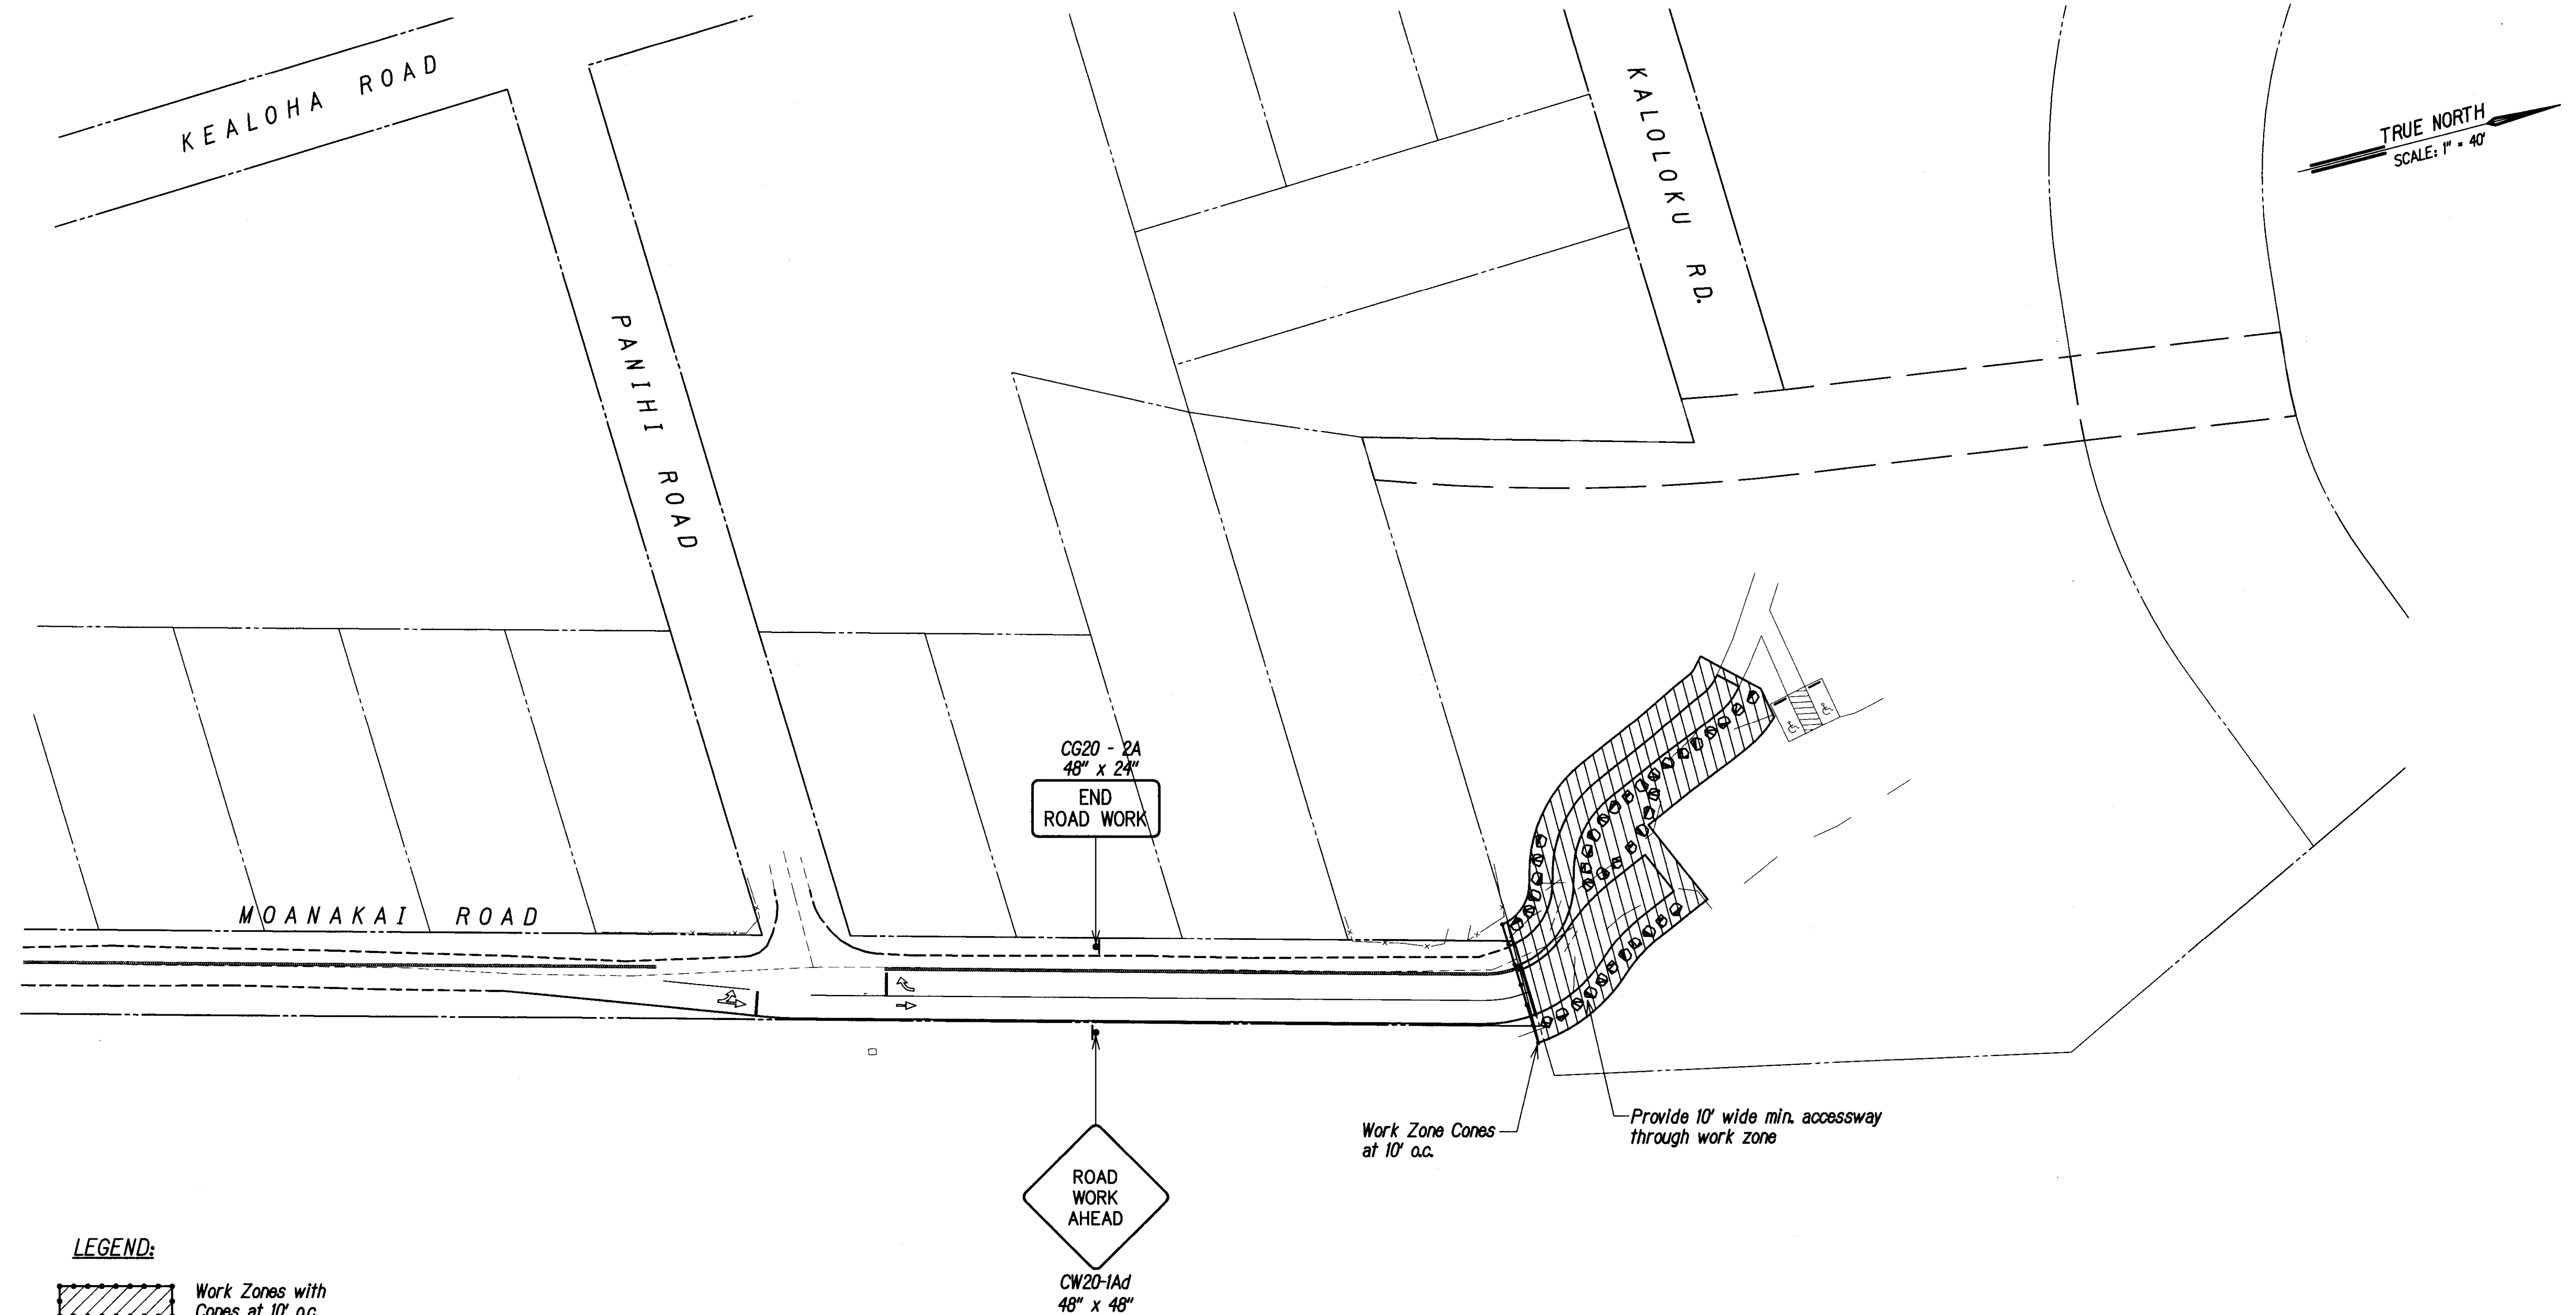


LEGEND:

- Work Zones with Cones at 10' o.c.
- Cones or Channelizing Device
- Travel Lane near Work Zone
- Construction Sign
- Flagman or Police Officer
- High Level Warning Device (Flag Tree)
- Arrow Panel

CONSTRUCTION PHASE - 7
SCALE: 1" = 40'

APPROVED:

COUNTY ENGINEER
(FOR WORK WITHIN COUNTY RIGHT OF WAY)
DATE: 12-21-11

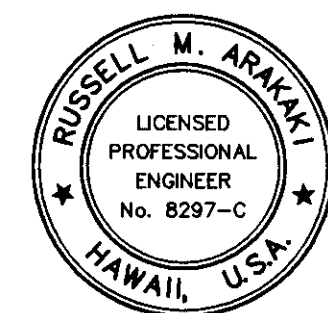


THIS WORK WAS PREPARED BY
ME OR UNDER MY SUPERVISION.

SIGNATURE
EXPIRATION DATE OF THE LICENSE: 4-30-12

COUNTY OF KAUAI DEPARTMENT OF PUBLIC WORKS LYDGATE PARK TO KAPA'A BIKE/ PEDESTRIAN PATH PHASE B KAPA'A, KAUAI, HAWAII				
CONSTRUCTION TRAFFIC CONTROL PLAN - PHASE 7 FEDERAL-AID PROJECT NO. STP-0700(61) DATE: NOVEMBER 2011				
DRAWN BY: NGA	F.B.	C.B.	SHEET	
TRACED BY:			C12.8	
CHECKED BY: RMA			OF SHEETS	


"AS-BUILT"

FED. ROAD DIST. NO.	STATE	FED. AID PROJ. NO.	FISCAL YEAR	SHEET NO.	TOTAL SHEETS
HAWAII	HAW.	STP-0700(61)	2011	97	143

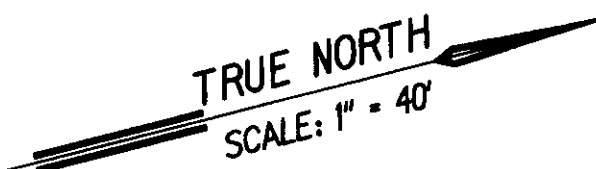

LEGEND:

- Work Zones with Cones at 10' o.c.
- Cones or Channelizing Device
- Travel Lane near Work Zone
- Construction Sign
- Flagman or Police Officer
- High Level Warning Device (Flag Tree)
- Arrow Panel

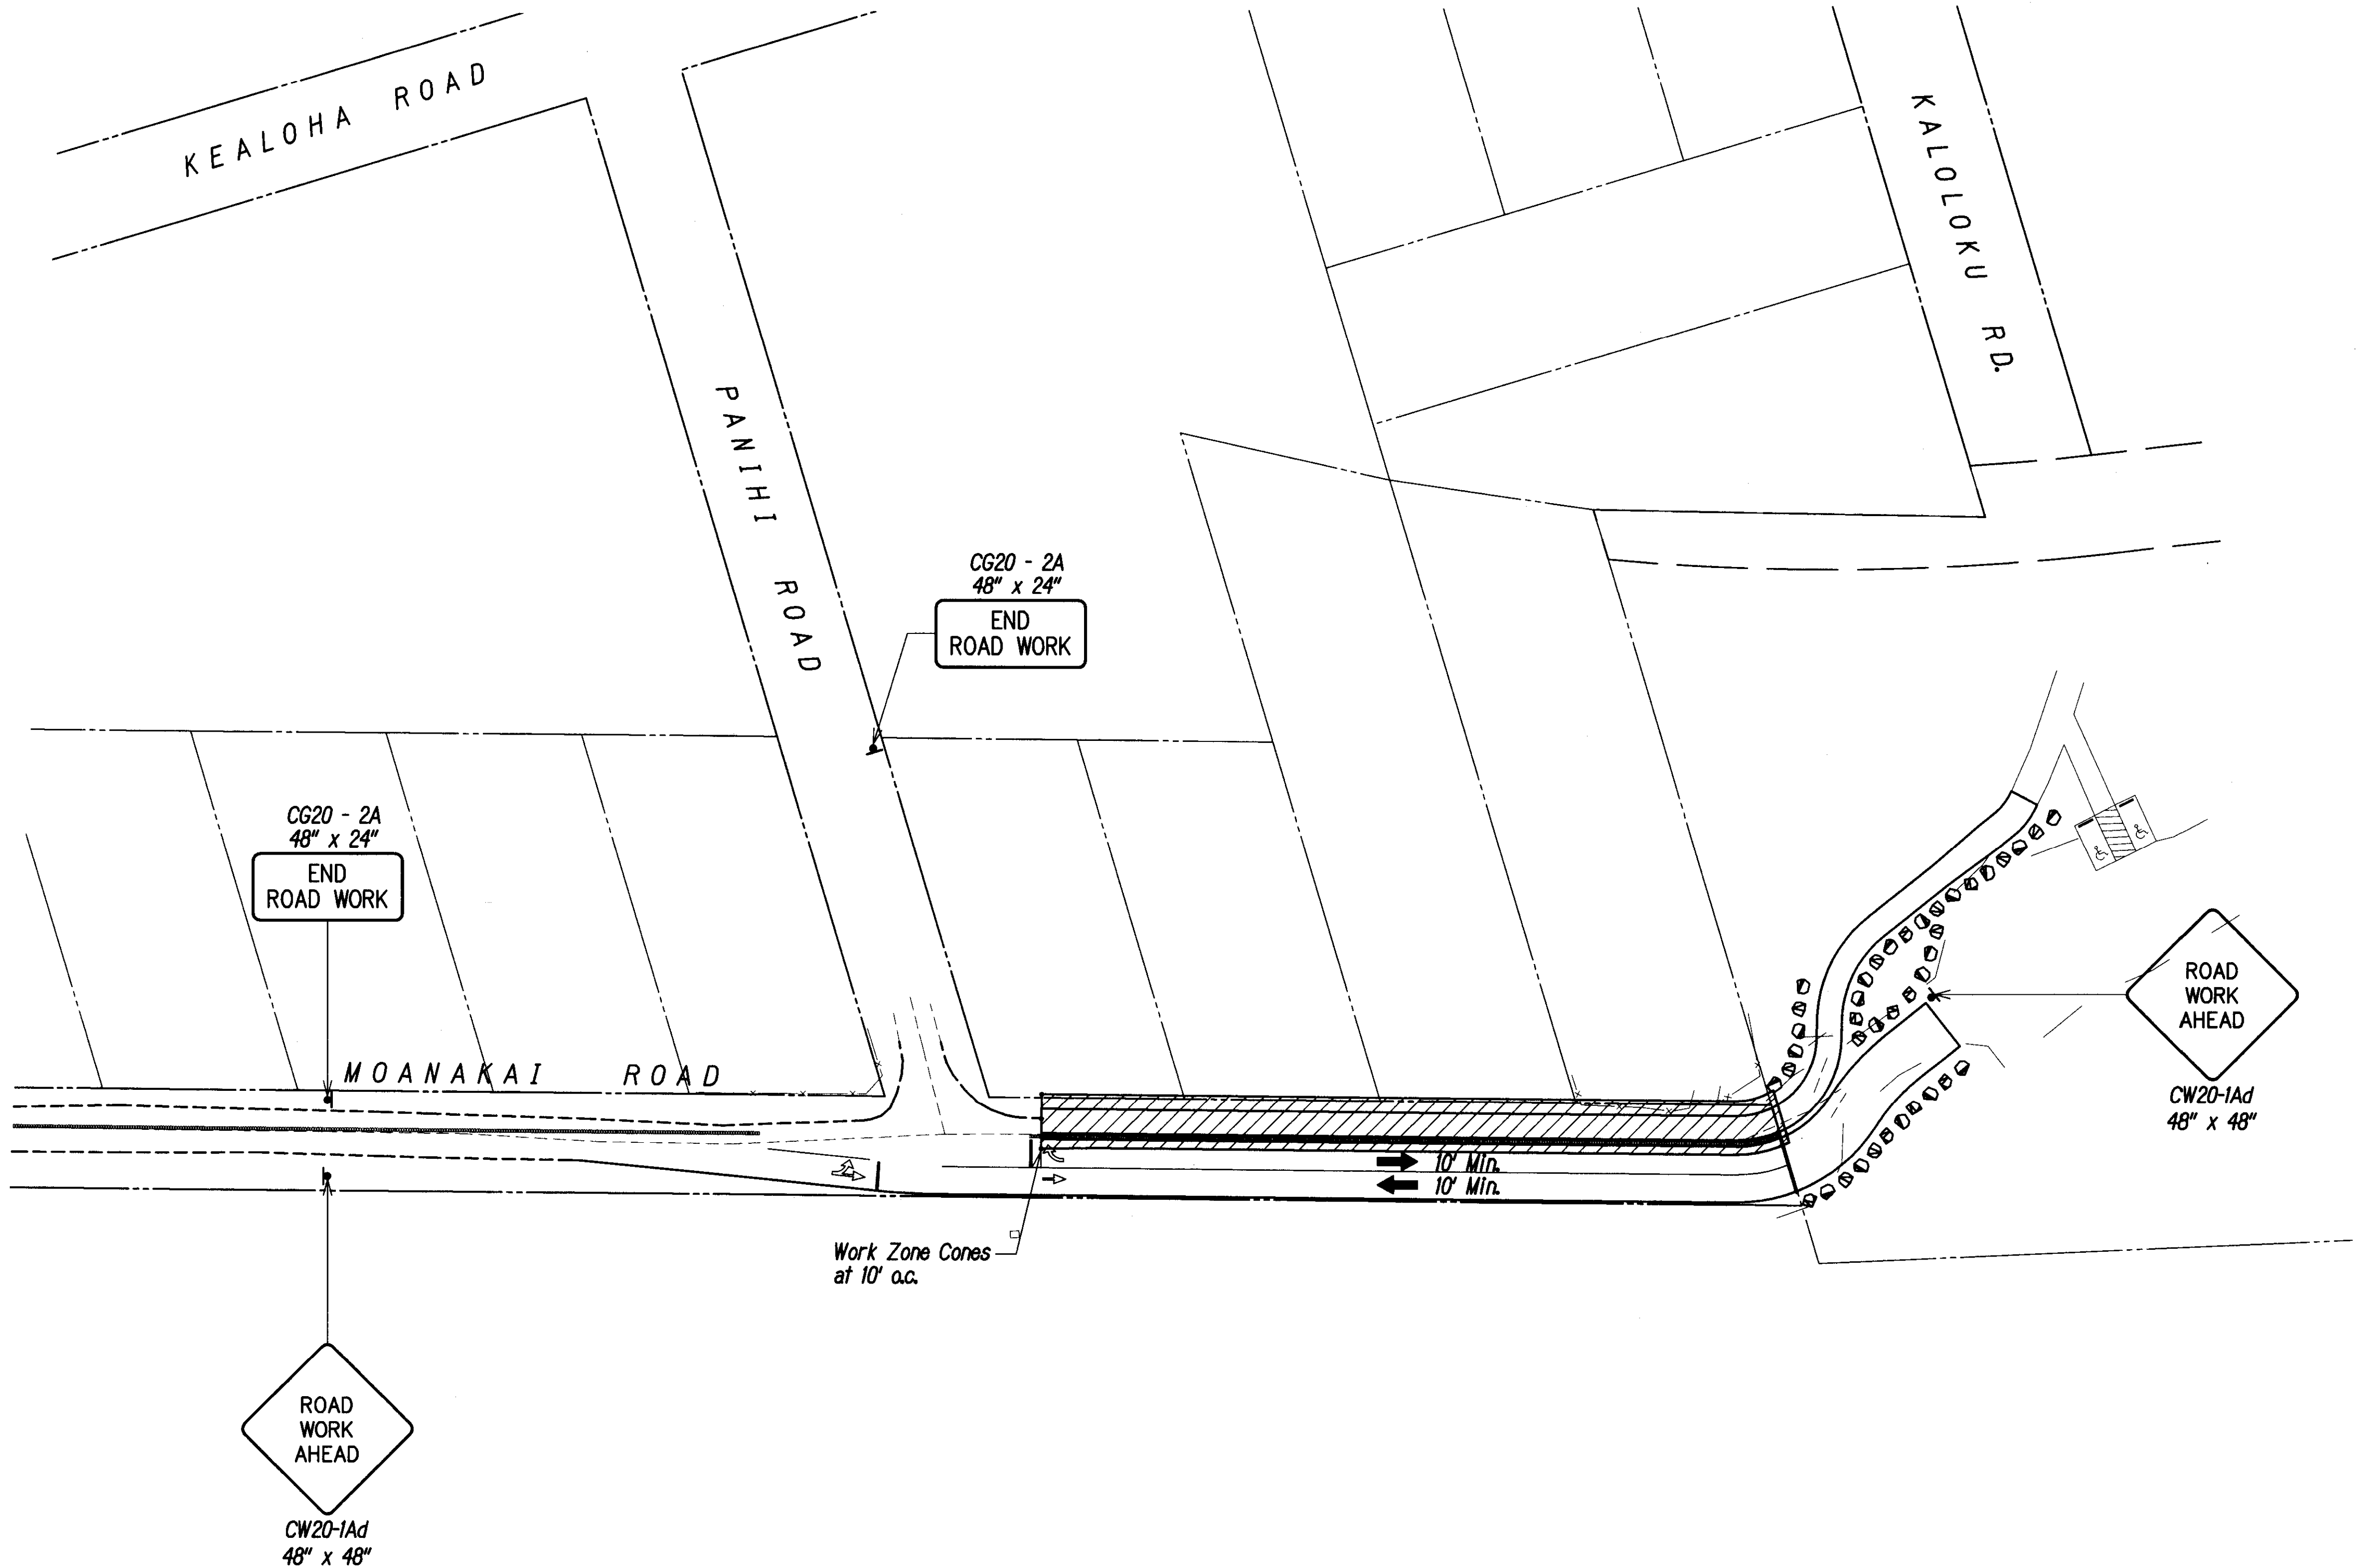

CONSTRUCTION PHASE - 8
SCALE: 1" = 40'

APPROVED:

COUNTY ENGINEER
(FOR WORK WITHIN COUNTY RIGHT OF WAY)
DATE: 12-21-11

THIS WORK WAS PREPARED BY ME OR UNDER MY SUPERVISION.


SIGNATURE
EXPIRATION DATE OF THE LICENSE: 4-30-12

COUNTY OF KAUAI
DEPARTMENT OF PUBLIC WORKS
LYDGATE PARK TO KAPA'A BIKE/
PEDESTRIAN PATH PHASE B
KAPA'A, KAUAI, HAWAII

**CONSTRUCTION TRAFFIC
CONTROL PLAN - PHASE 8**
FEDERAL-AID PROJECT NO. STP-0700(61)
DATE: NOVEMBER 2011


DRAWN BY: NGA	F.B.	C.B.	SHEET
TRACED BY: RMA			C12.9
CHECKED BY:			OF SHEETS

FED. ROAD DIST. NO.	STATE	FED. AID PROJ. NO.	FISCAL YEAR	SHEET NO.	TOTAL SHEETS
HAWAII	HAW.	STP-0700(61)	2011	98	143

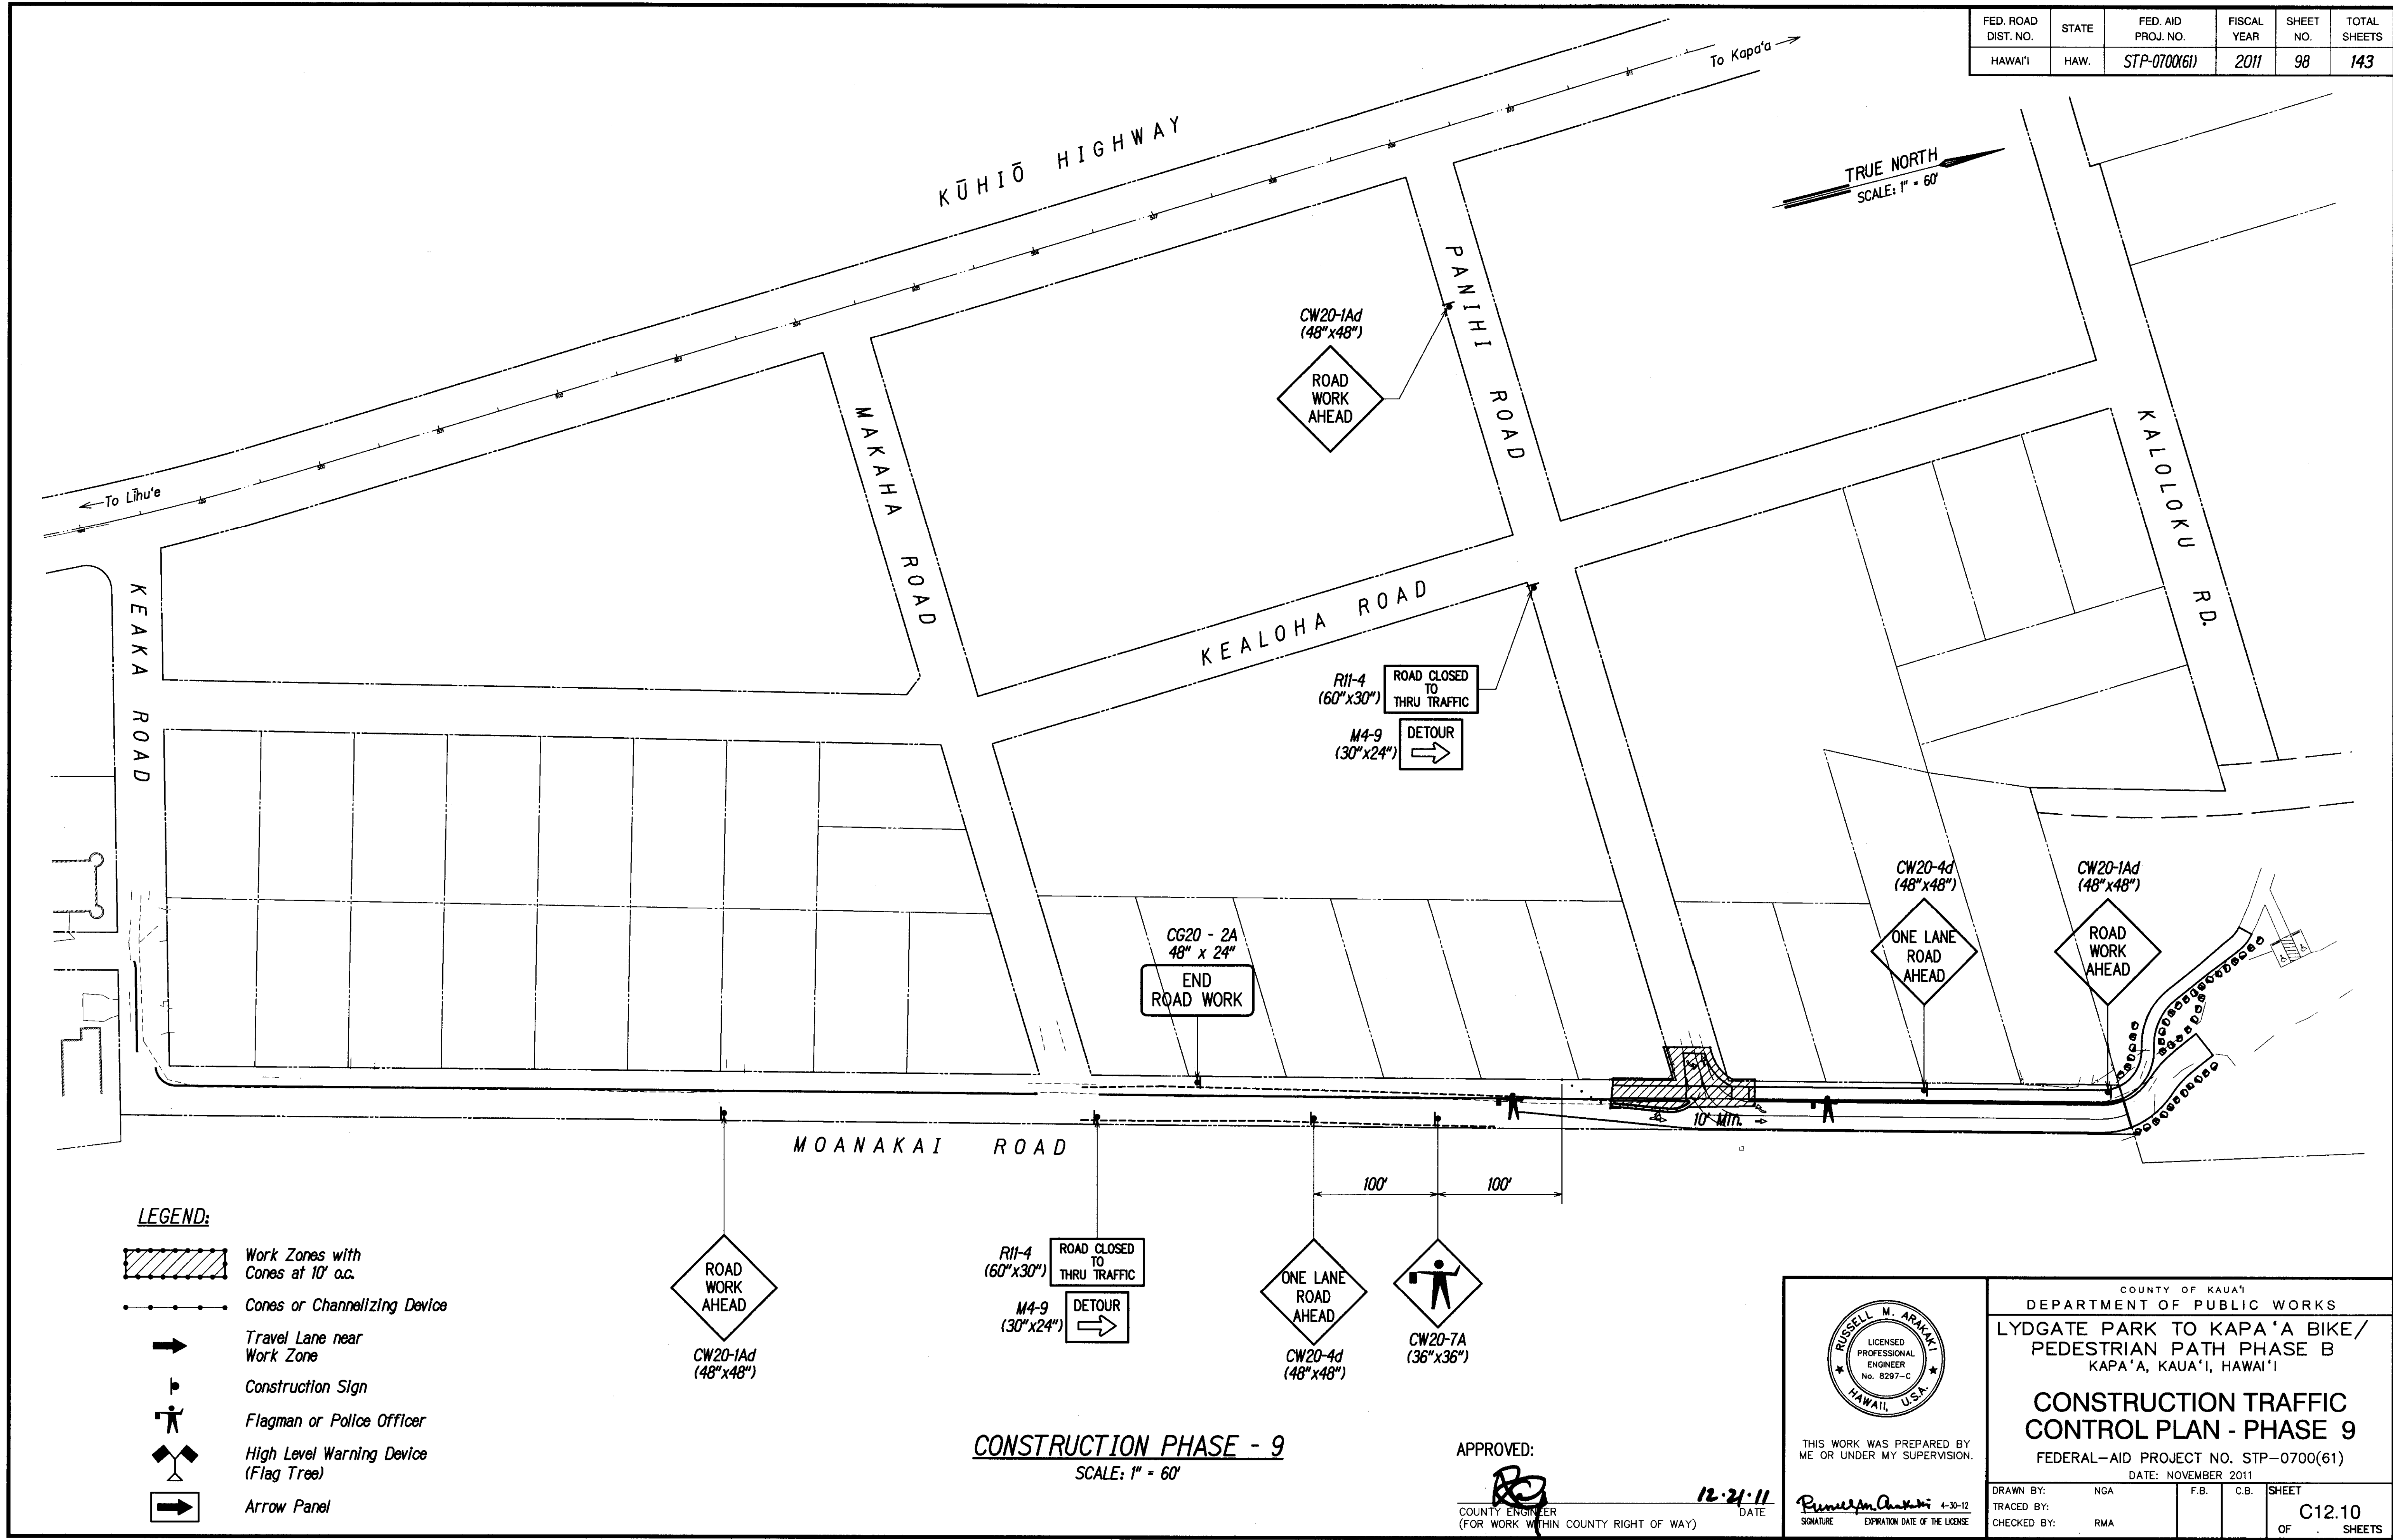

"AS-BUILT"

FED. ROAD DIST. NO.	STATE	FED. AID PROJ. NO.	FISCAL YEAR	SHEET NO.	TOTAL SHEETS
HAWAII	HAW.	STP-0700(61)	2011	99	143

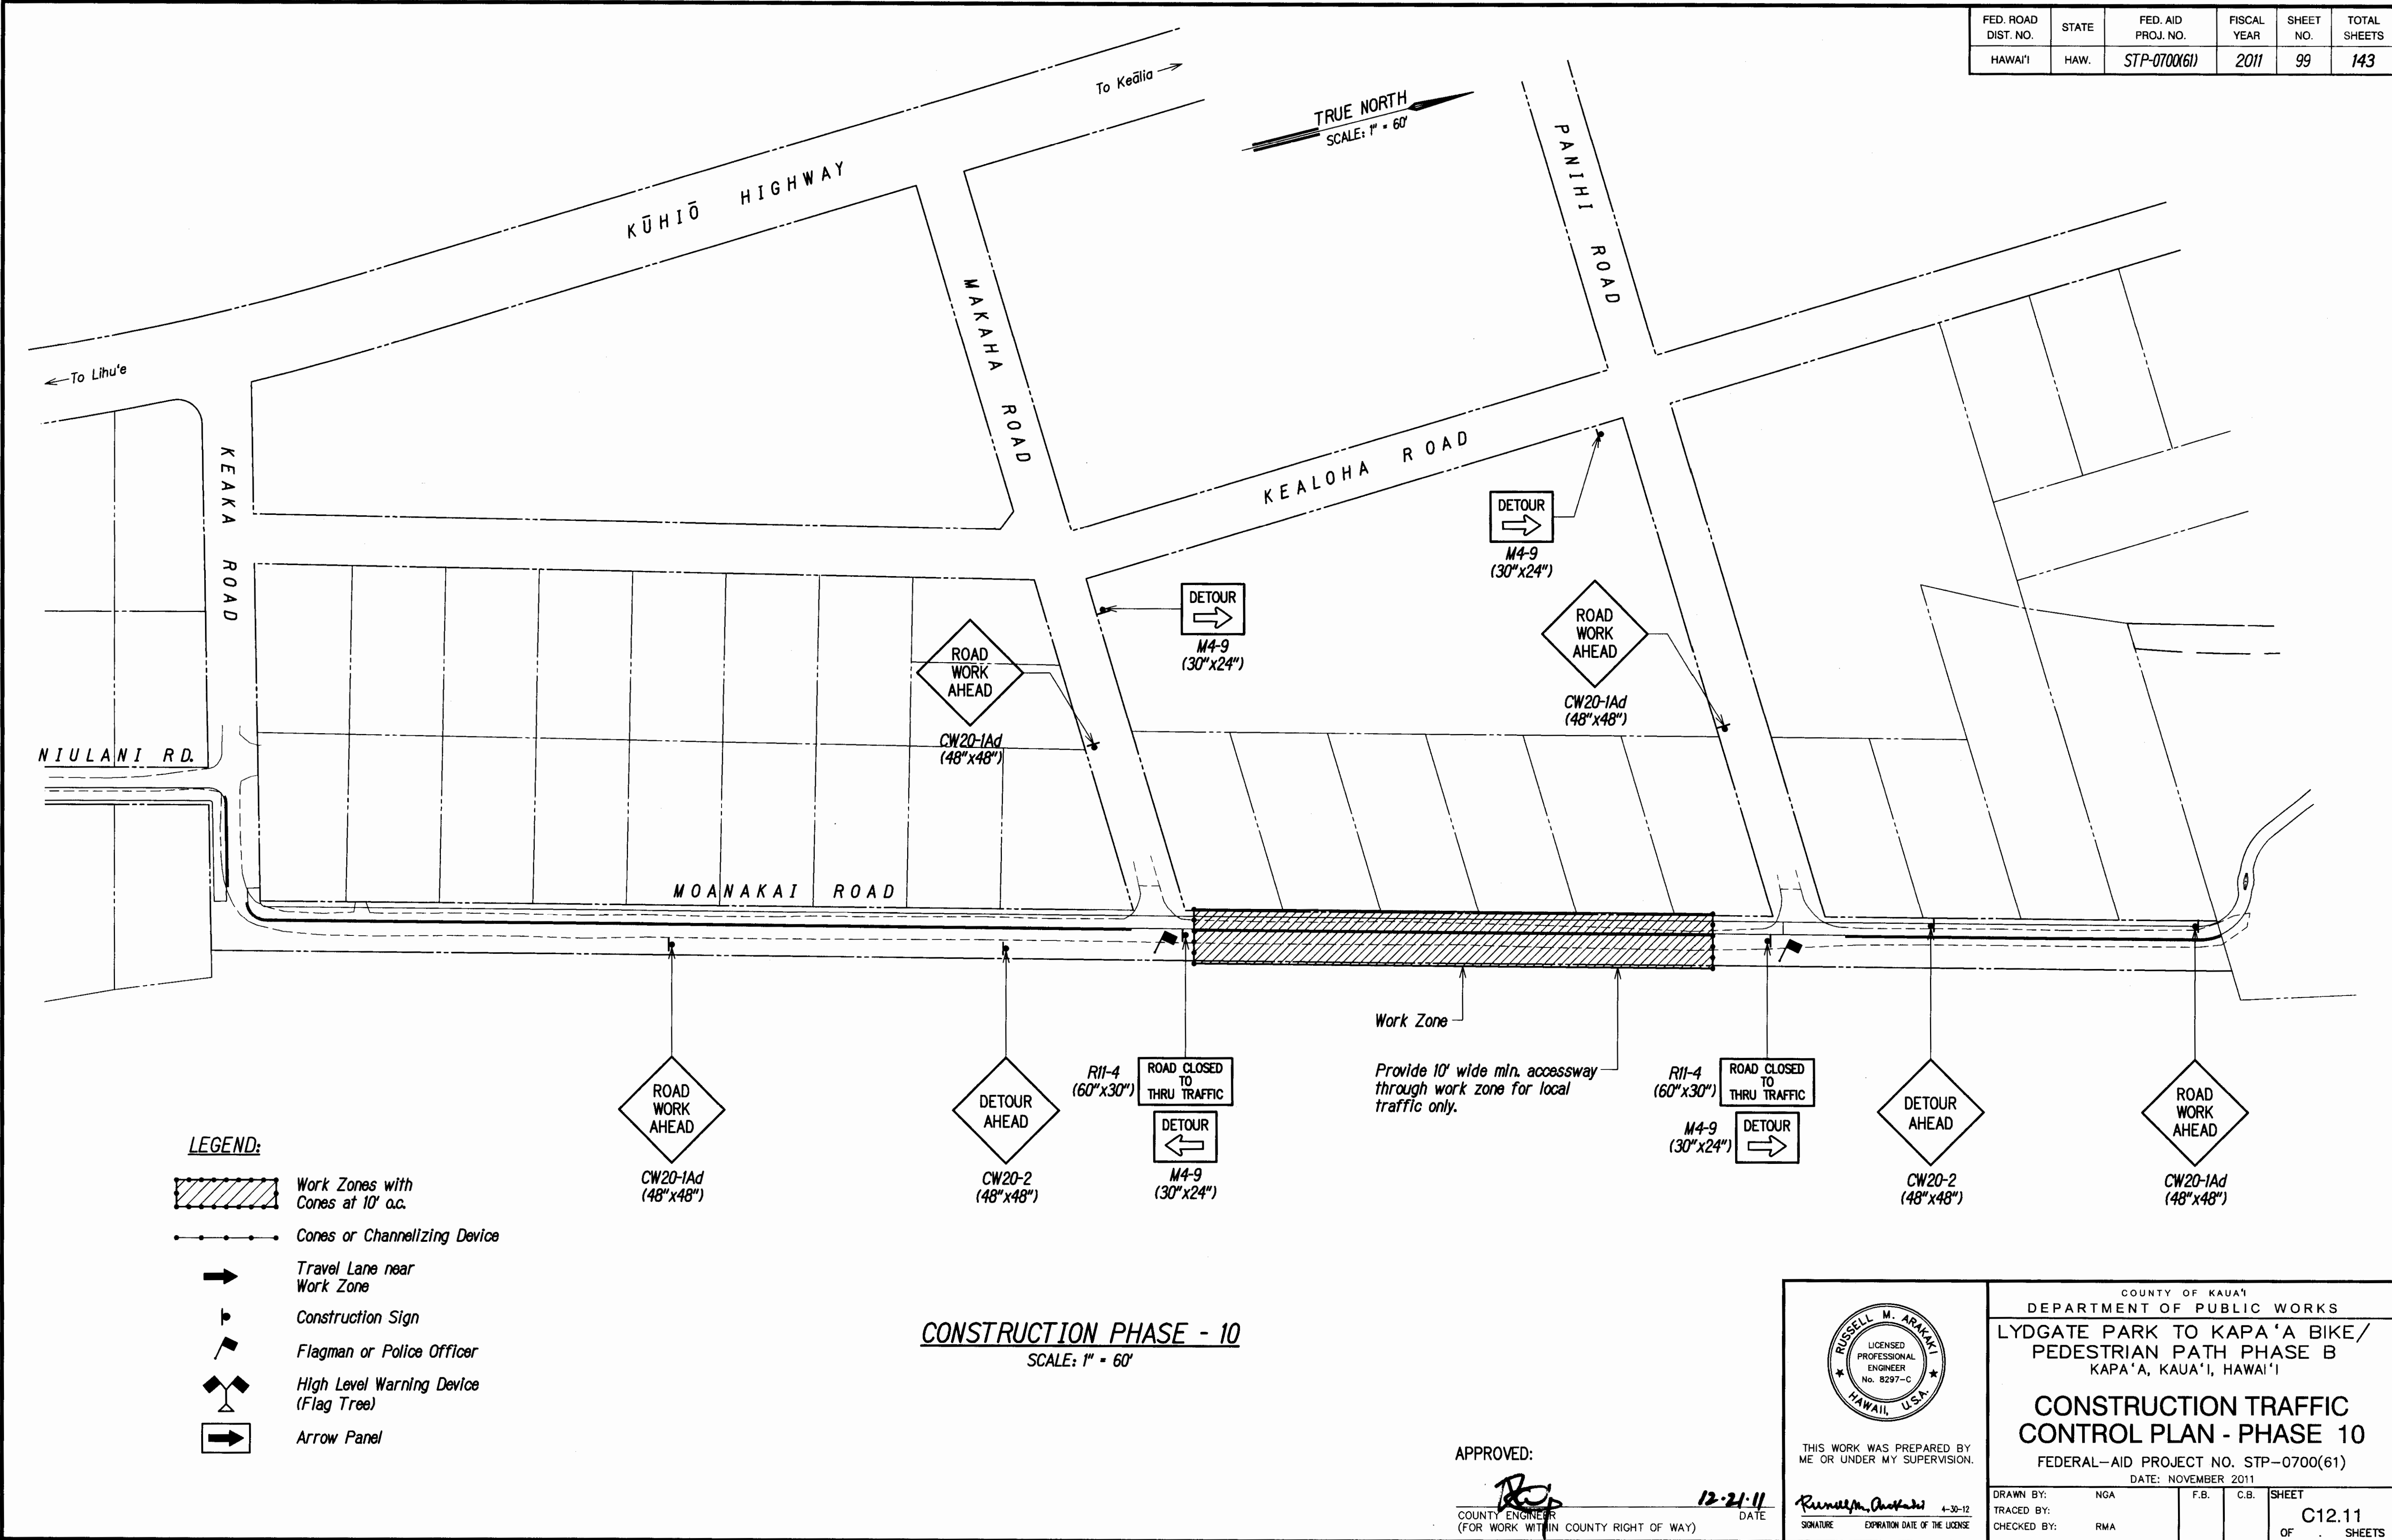

- LEGEND:**
- Work Zones with Cones at 10' a.c.
 - Cones or Channelizing Device
 - Travel Lane near Work Zone
 - Construction Sign
 - Flagman or Police Officer
 - High Level Warning Device (Flag Tree)
 - Arrow Panel

CONSTRUCTION PHASE - 10
SCALE: 1" = 60'

APPROVED:
COUNTY ENGINEER (FOR WORK WITHIN COUNTY RIGHT OF WAY) DATE: 12-21-11

RUSSELL M. ARAKI
LICENSED PROFESSIONAL ENGINEER
No. 8297-C
HAWAII, U.S.A.

THIS WORK WAS PREPARED BY ME OR UNDER MY SUPERVISION.

4-30-12
SIGNATURE EXPIRATION DATE OF THE LICENSE

COUNTY OF KAUAI
DEPARTMENT OF PUBLIC WORKS



LYDGATE PARK TO KAPA'A BIKE/
PEDESTRIAN PATH PHASE B
KAPA'A, KAUAI, HAWAII

**CONSTRUCTION TRAFFIC
CONTROL PLAN - PHASE 10**

FEDERAL-AID PROJECT NO. STP-0700(61)
DATE: NOVEMBER 2011

DRAWN BY:	NGA	F.B.	C.B.	SHEET
TRACED BY:				C12.11
CHECKED BY:	RMA			OF SHEETS

FED. ROAD DIST. NO.	STATE	FED. AID PROJ. NO.	FISCAL YEAR	SHEET NO.	TOTAL SHEETS
HAWAII	HAW.	STP-0700(61)	2011	100	143

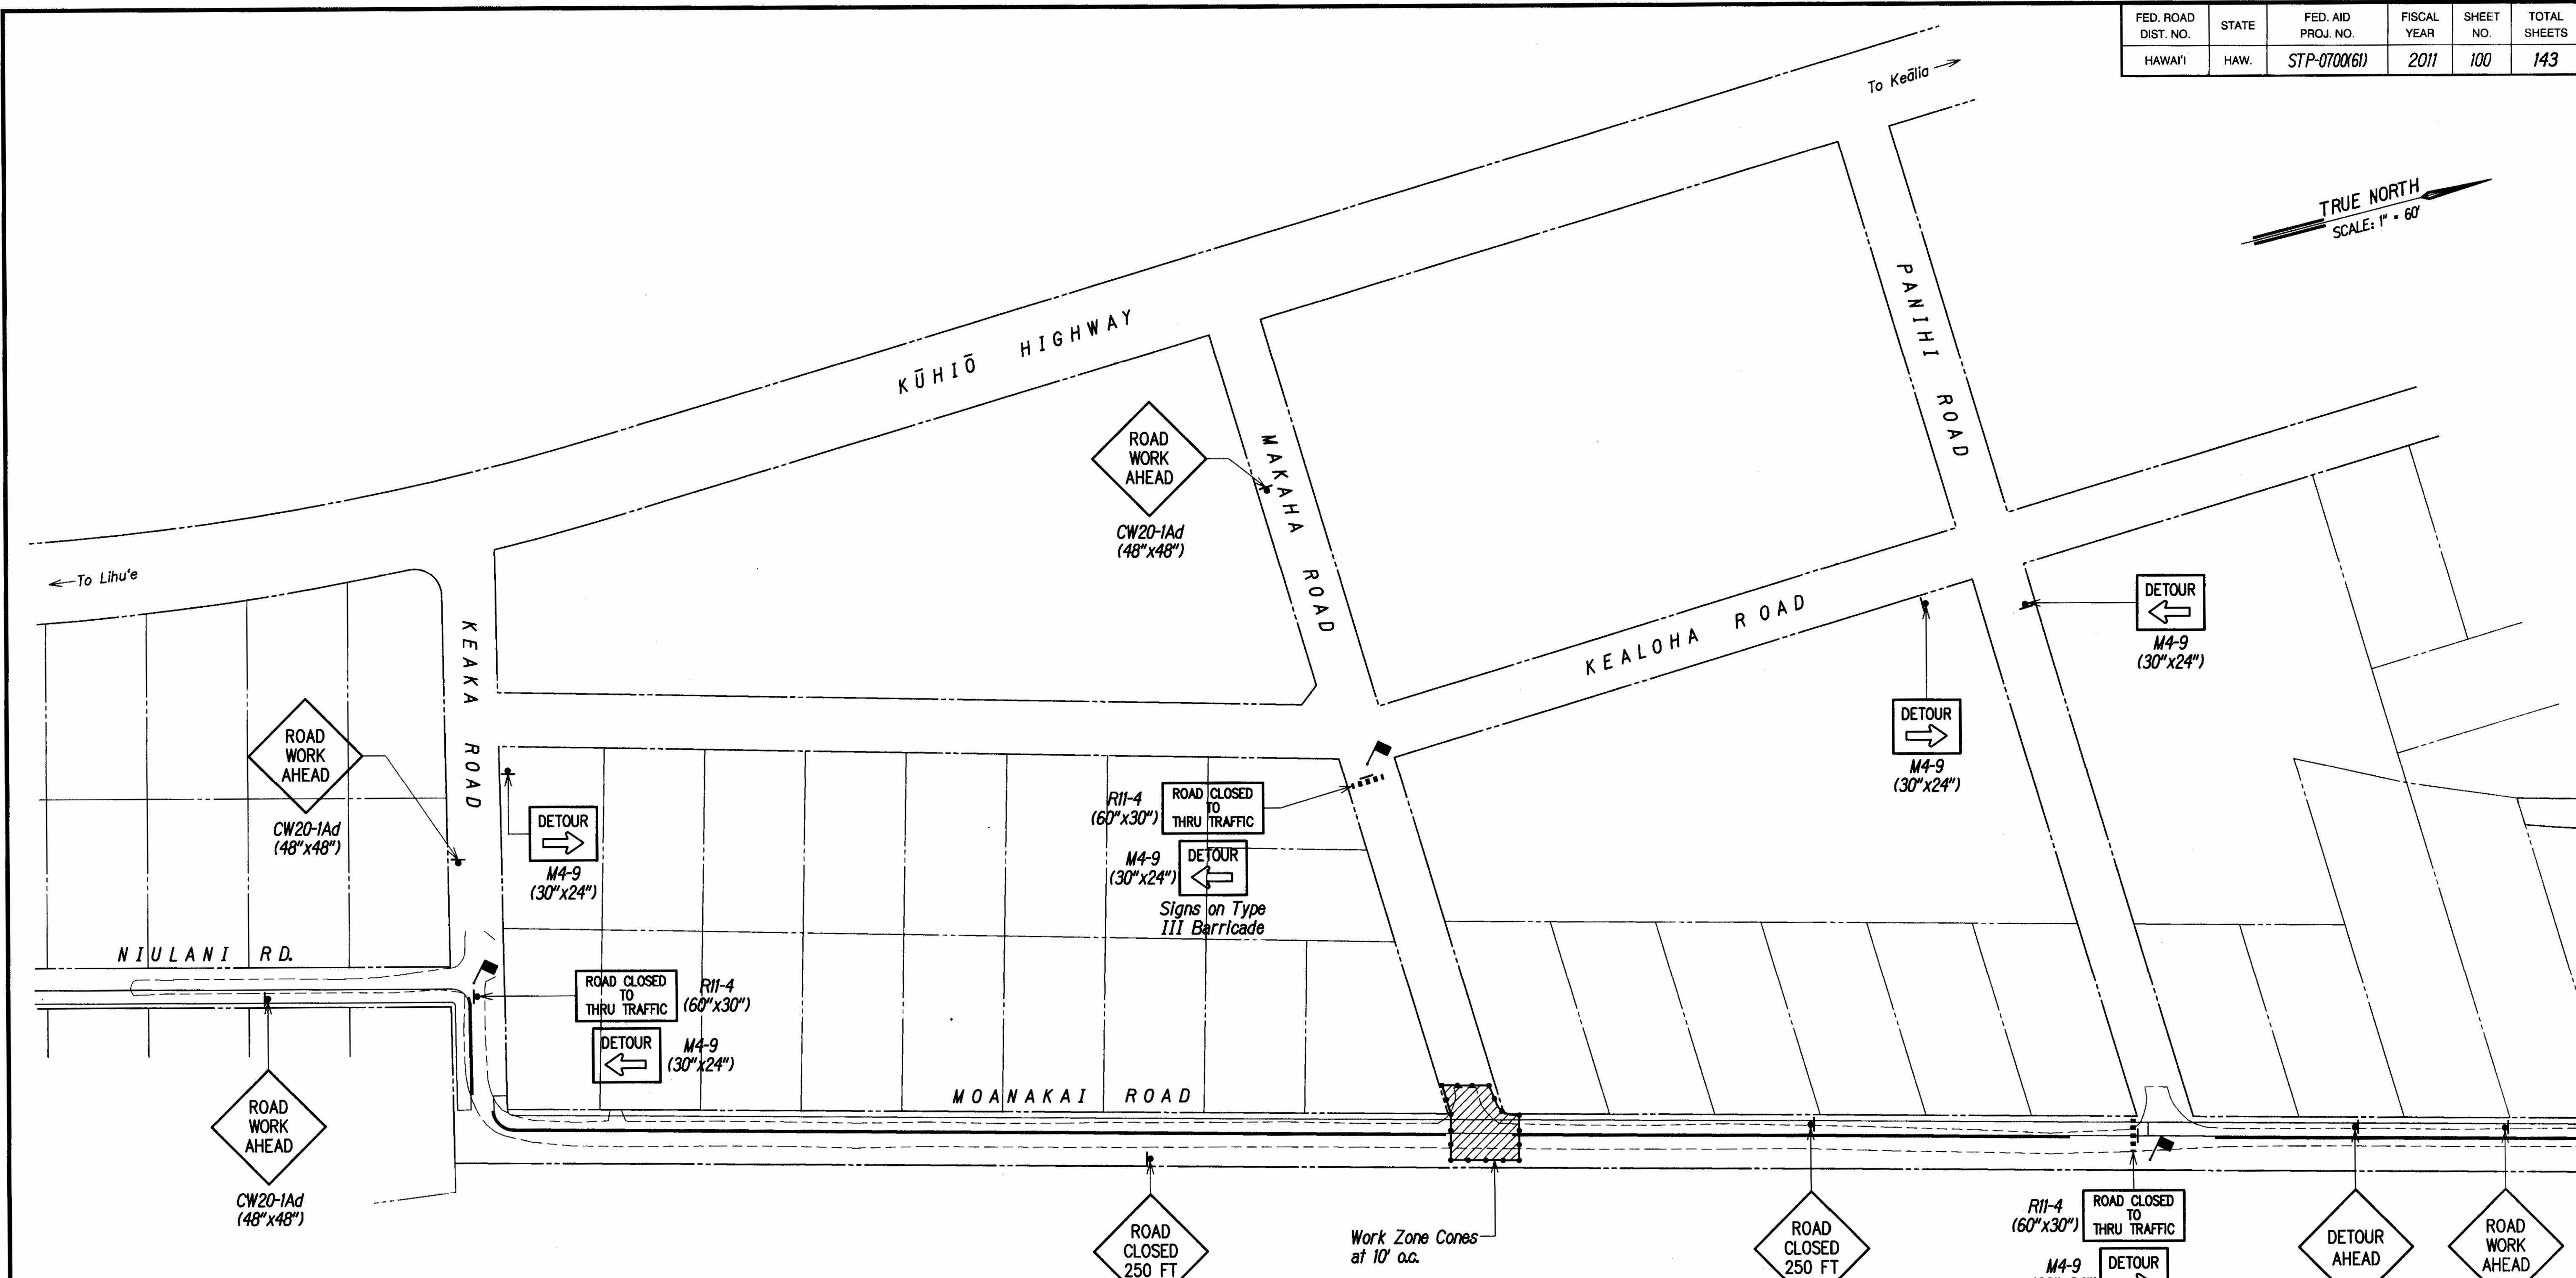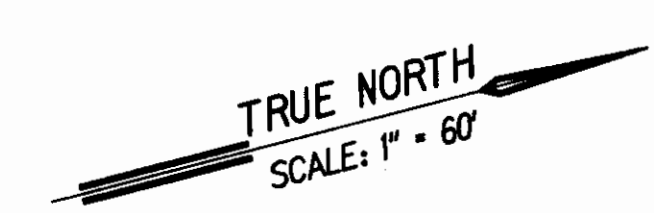

LEGEND:

- Work Zones with Cones at 10' o.c.
- Cones or Channelizing Device
- Travel Lane near Work Zone
- Construction Sign
- Flagman or Police Officer
- High Level Warning Device (Flag Tree)
- Arrow Panel

CONSTRUCTION PHASE - 11
SCALE: 1" = 60'

APPROVED:

COUNTY ENGINEER
(FOR WORK WITHIN COUNTY RIGHT OF WAY)

12-21-11
DATE

THIS WORK WAS PREPARED BY ME OR UNDER MY SUPERVISION.
SIGNATURE: EXPIRATION DATE OF THE LICENSE: 4-30-12

COUNTY OF KAUAI
DEPARTMENT OF PUBLIC WORKS

LYDGATE PARK TO KAPA'A BIKE/
PEDESTRIAN PATH PHASE B
KAPA'A, KAUAI, HAWAII



**CONSTRUCTION TRAFFIC
CONTROL PLAN - PHASE 11**

FEDERAL-AID PROJECT NO. STP-0700(61)
DATE: NOVEMBER 2011

DRAWN BY: NGA	F.B.	C.B.	SHEET
TRACED BY: RMA			C12.12
CHECKED BY:			OF SHEETS

"AS-BUILT"

FED. ROAD DIST. NO.	STATE	FED. AID PROJ. NO.	FISCAL YEAR	SHEET NO.	TOTAL SHEETS
HAWAII	HAW.	STP-0700(61)	2011	101	143

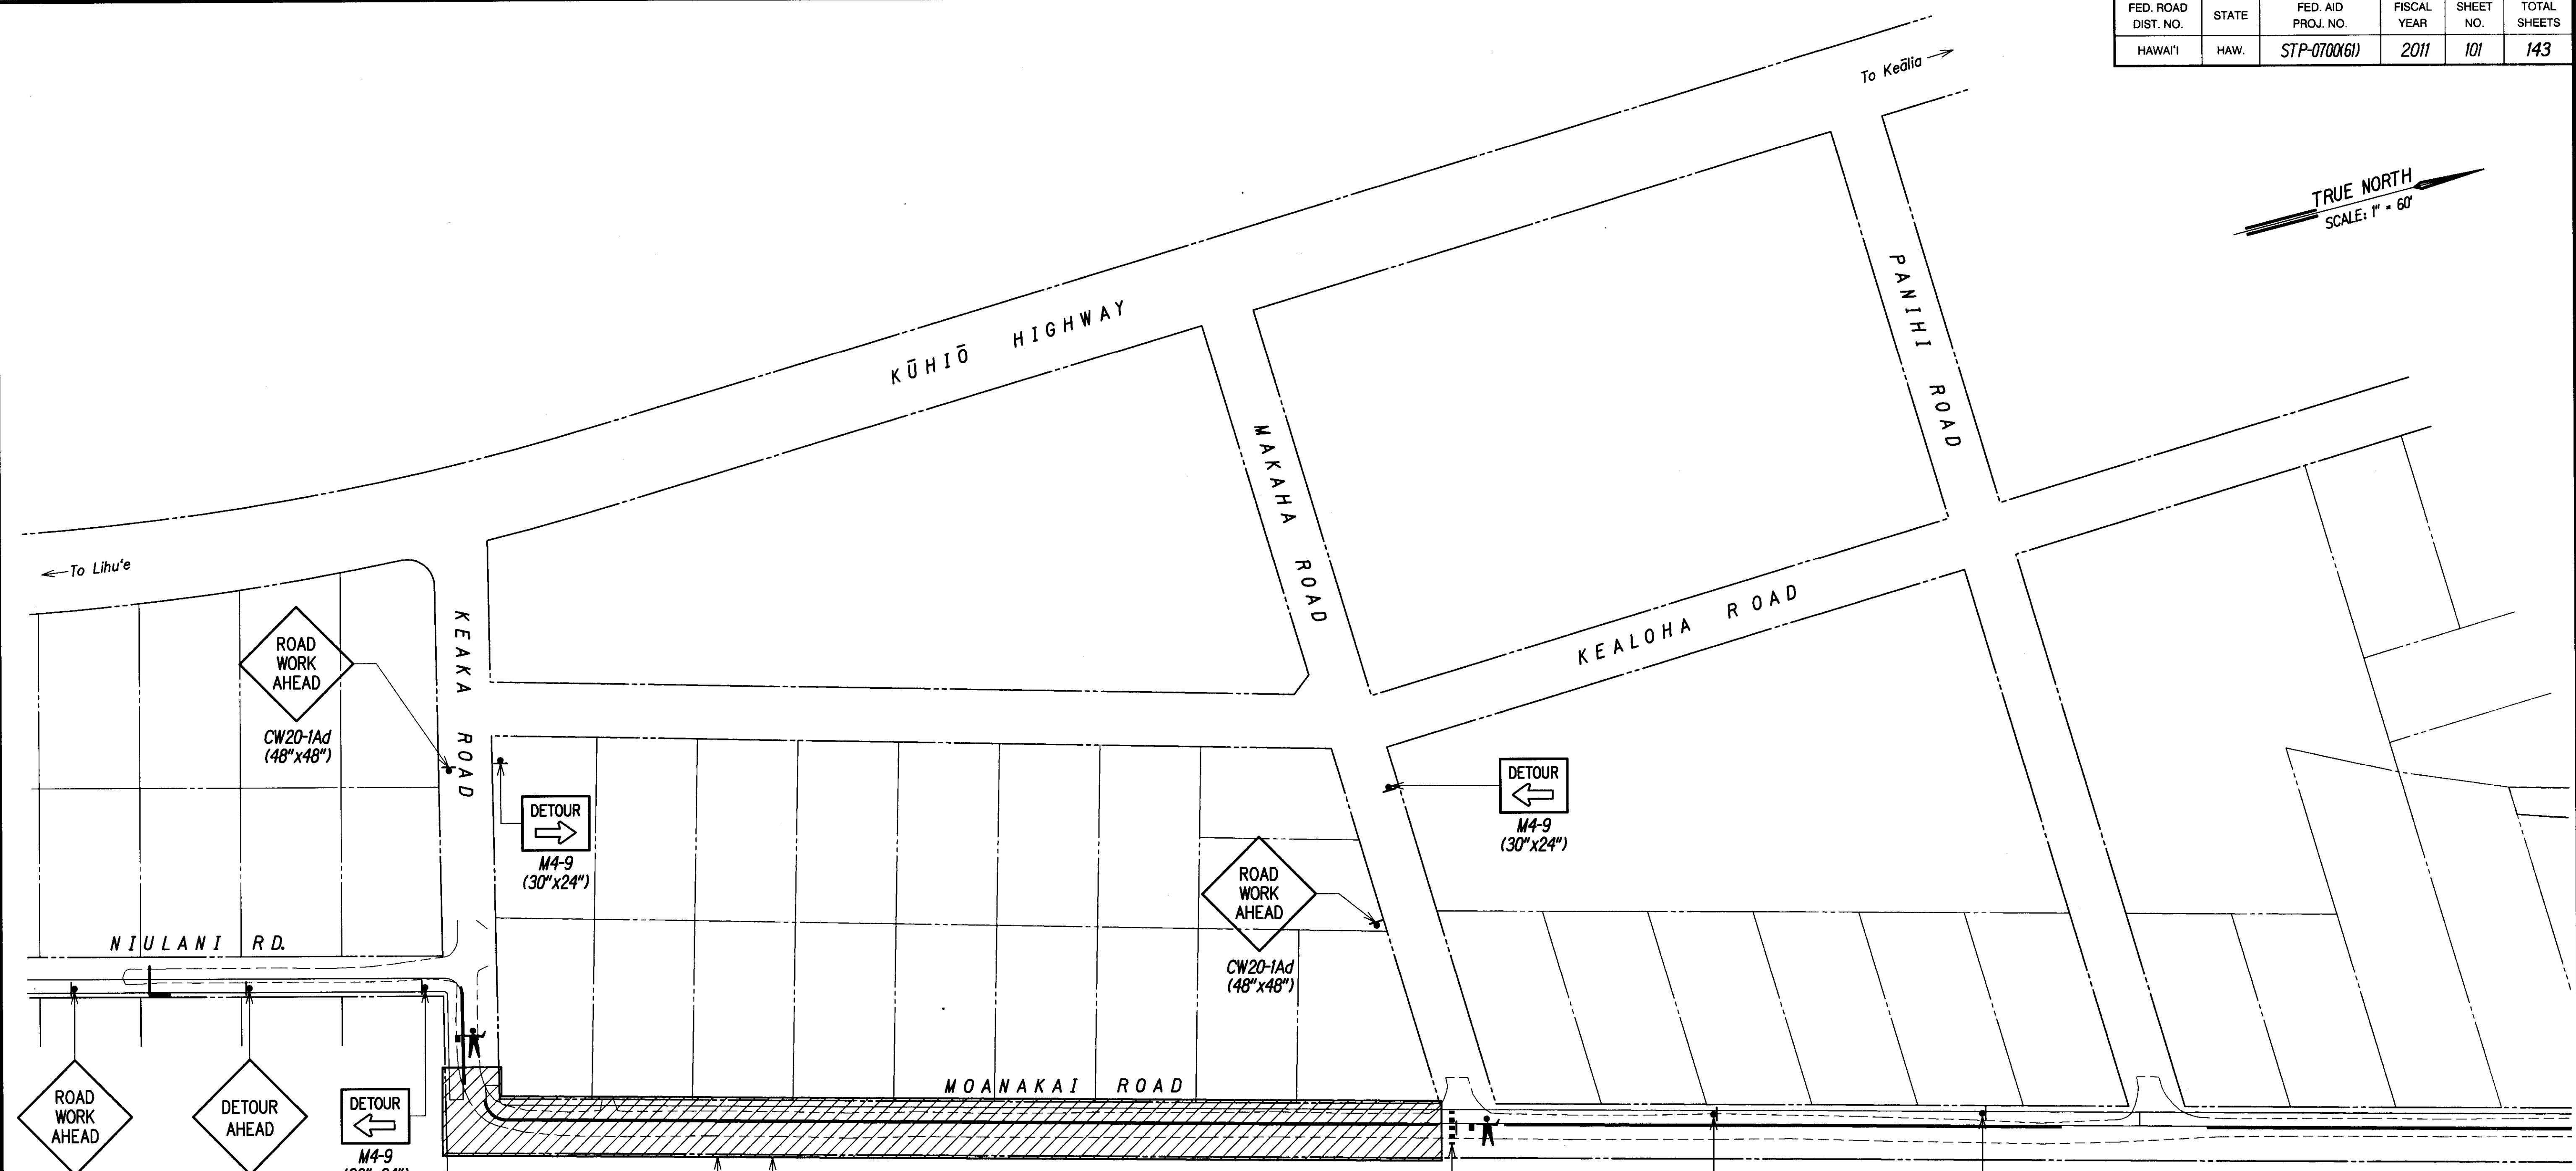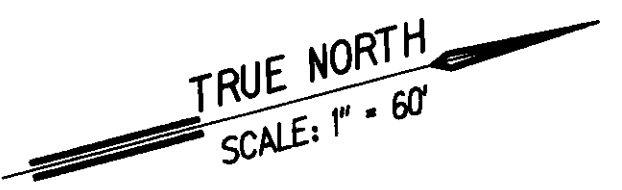

Work Zone
Provide 10' wide min. accessway through work zone for local traffic only.

LEGEND:

- Work Zones with Cones at 10' o.c.
- Cones or Channelizing Device
- Travel Lane near Work Zone
- Construction Sign
- Flagman or Police Officer
- High Level Warning Device (Flag Tree)
- Arrow Panel

CONSTRUCTION PHASE - 12
SCALE: 1" = 60'

APPROVED:

COUNTY ENGINEER
(FOR WORK WITHIN COUNTY RIGHT OF WAY)
DATE: 12-21-11

THIS WORK WAS PREPARED BY ME OR UNDER MY SUPERVISION.
SIGNATURE: EXPIRATION DATE OF THE LICENSE: 4-30-12


COUNTY OF KAUAI
DEPARTMENT OF PUBLIC WORKS
LYDGATE PARK TO KAPA'A BIKE/
PEDESTRIAN PATH PHASE B
KAPA'A, KAUAI, HAWAII

**CONSTRUCTION TRAFFIC
CONTROL PLAN - PHASE 12**
FEDERAL-AID PROJECT NO. STP-0700(61)
DATE: NOVEMBER 2011

DRAWN BY:	NGA	F.B.	C.B.	SHEET
TRACED BY:				C12.13
CHECKED BY:	RMA			OF SHEETS

"AS-BUILT"

FED. ROAD DIST. NO.	STATE	FED. AID PROJ. NO.	FISCAL YEAR	SHEET NO.	TOTAL SHEETS
HAWAII	HAW.	STP-0700(61)	2011	102	143

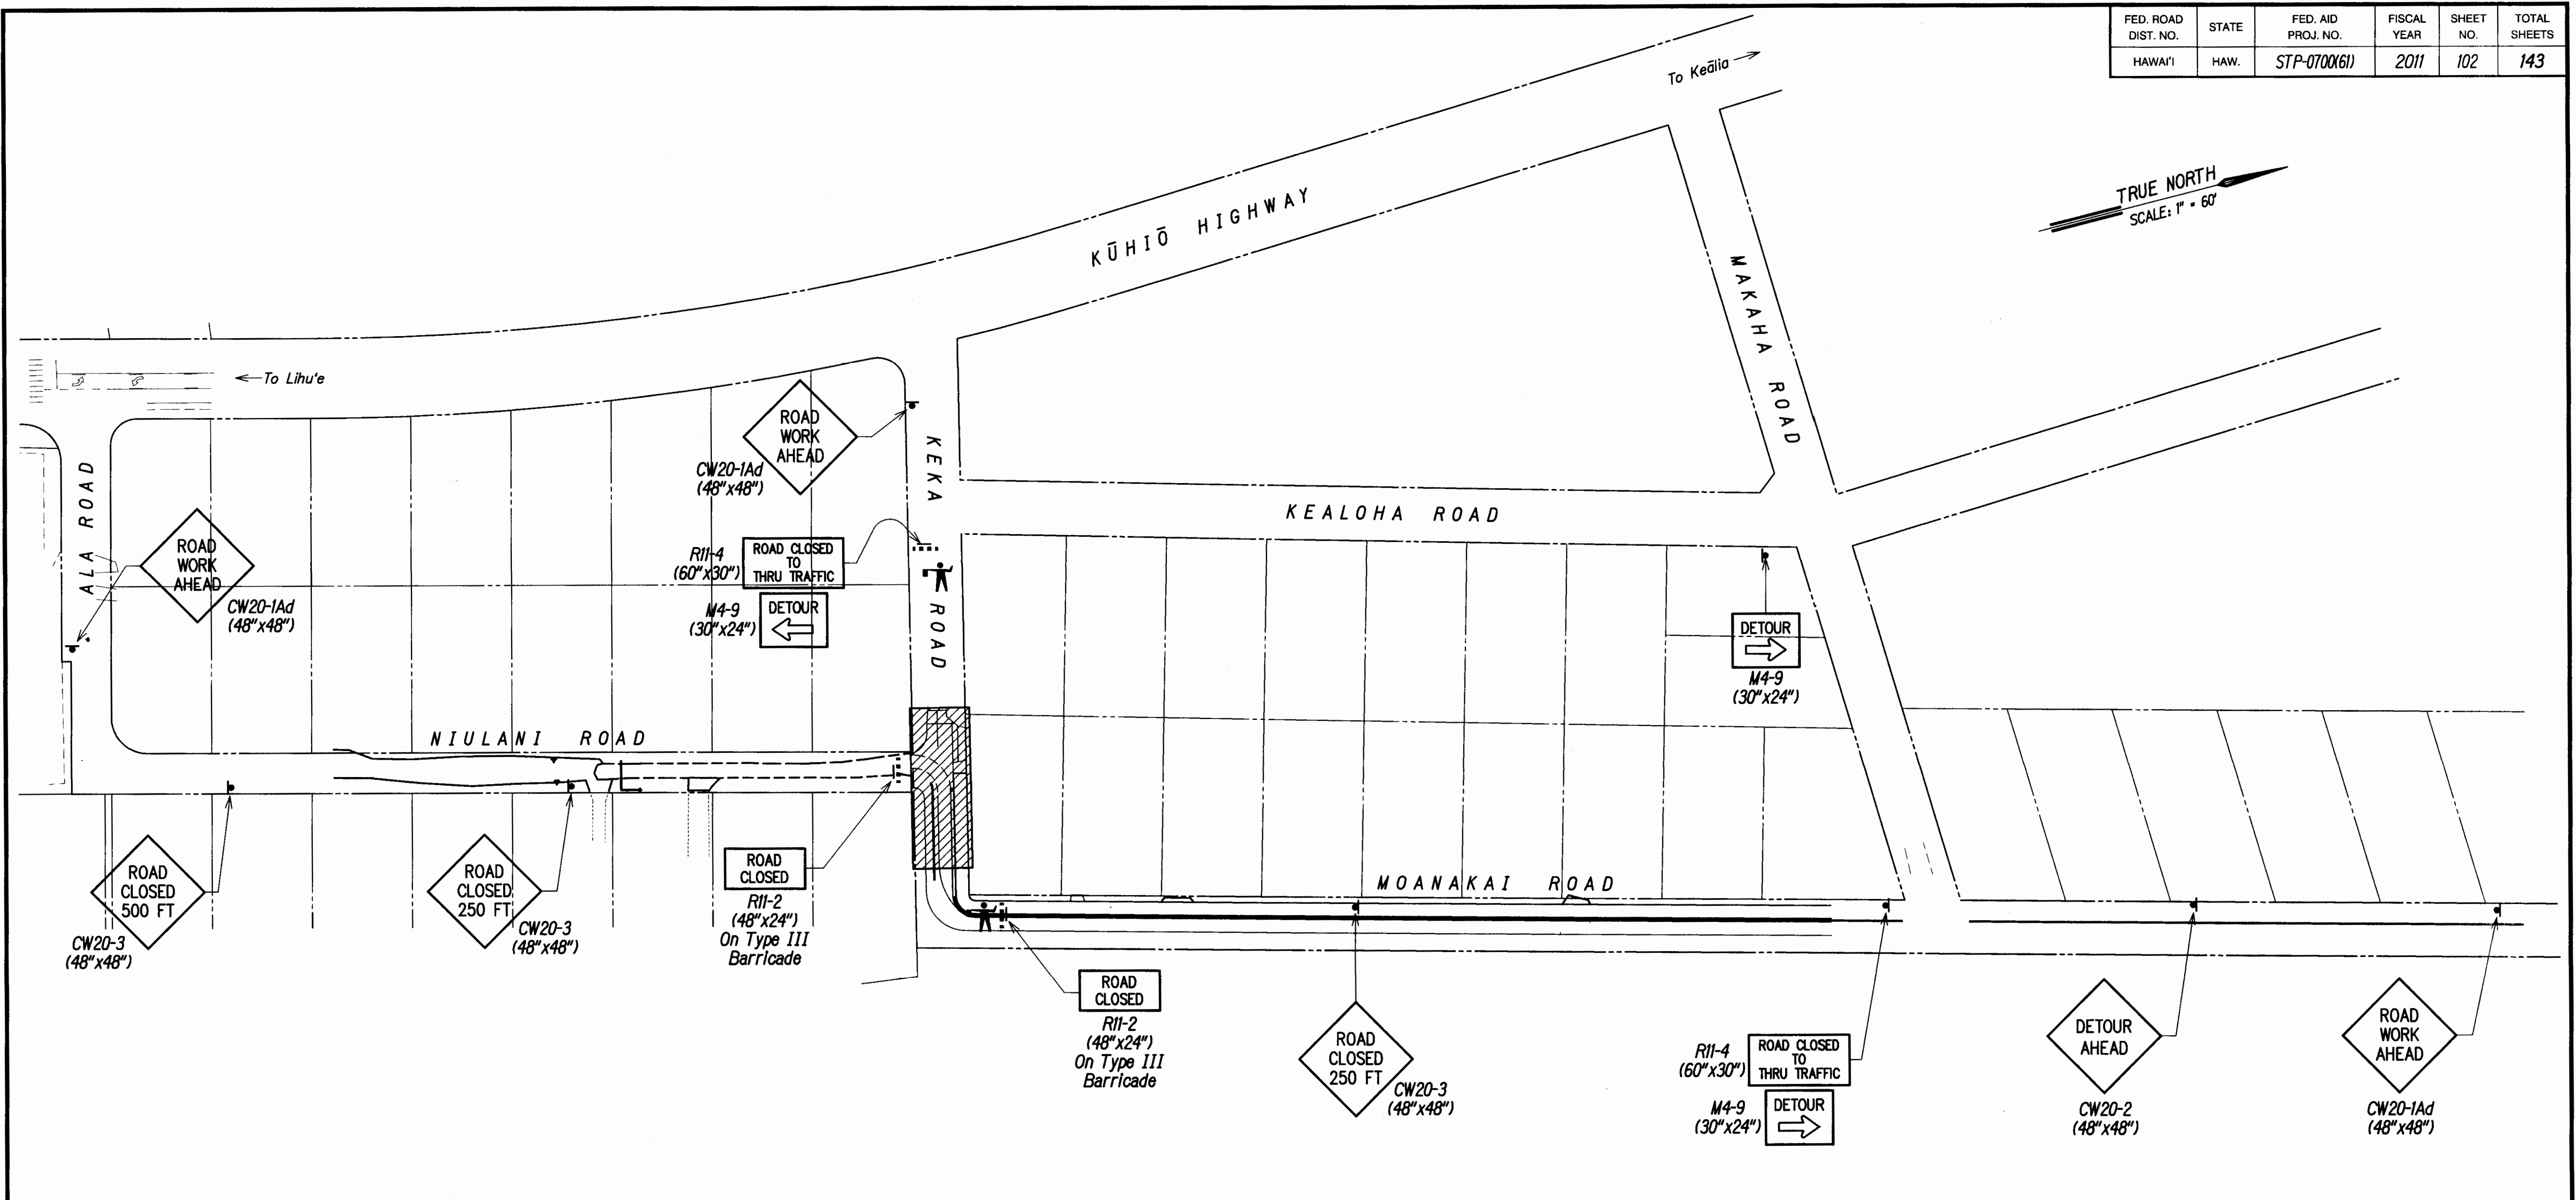

CONSTRUCTION PHASE - 13
SCALE: 1" = 60'

LEGEND:

- Work Zones with Cones at 10' o.c.
- Cones or Channellizing Device
- Travel Lane near Work Zone
- Construction Sign
- Flagman or Police Officer
- High Level Warning Device (Flag Tree)
- Arrow Panel

APPROVED:

[Signature]
COUNTY ENGINEER
(FOR WORK WITHIN COUNTY RIGHT OF WAY)
DATE: 12-21-11

THIS WORK WAS PREPARED BY ME OR UNDER MY SUPERVISION.

[Signature]
SIGNATURE
EXPIRATION DATE OF THE LICENSE: 4-30-12

COUNTY OF KAUAI
DEPARTMENT OF PUBLIC WORKS

LYDGATE PARK TO KAPA'A BIKE/
PEDESTRIAN PATH PHASE B
KAPA'A, KAUAI, HAWAII


CONSTRUCTION TRAFFIC
CONTROL PLAN - PHASE 13

FEDERAL-AID PROJECT NO. STP-0700(61)
DATE: NOVEMBER 2011

DRAWN BY: NGA	F.B.	C.B.	SHEET
TRACED BY: RMA			C12.14
CHECKED BY:			OF SHEETS

"AS-BUILT"

FED. ROAD DIST. NO.	STATE	FED. AID PROJ. NO.	FISCAL YEAR	SHEET NO.	TOTAL SHEETS
HAWAII	HAW.	STP-0700(61)	2011	103	143

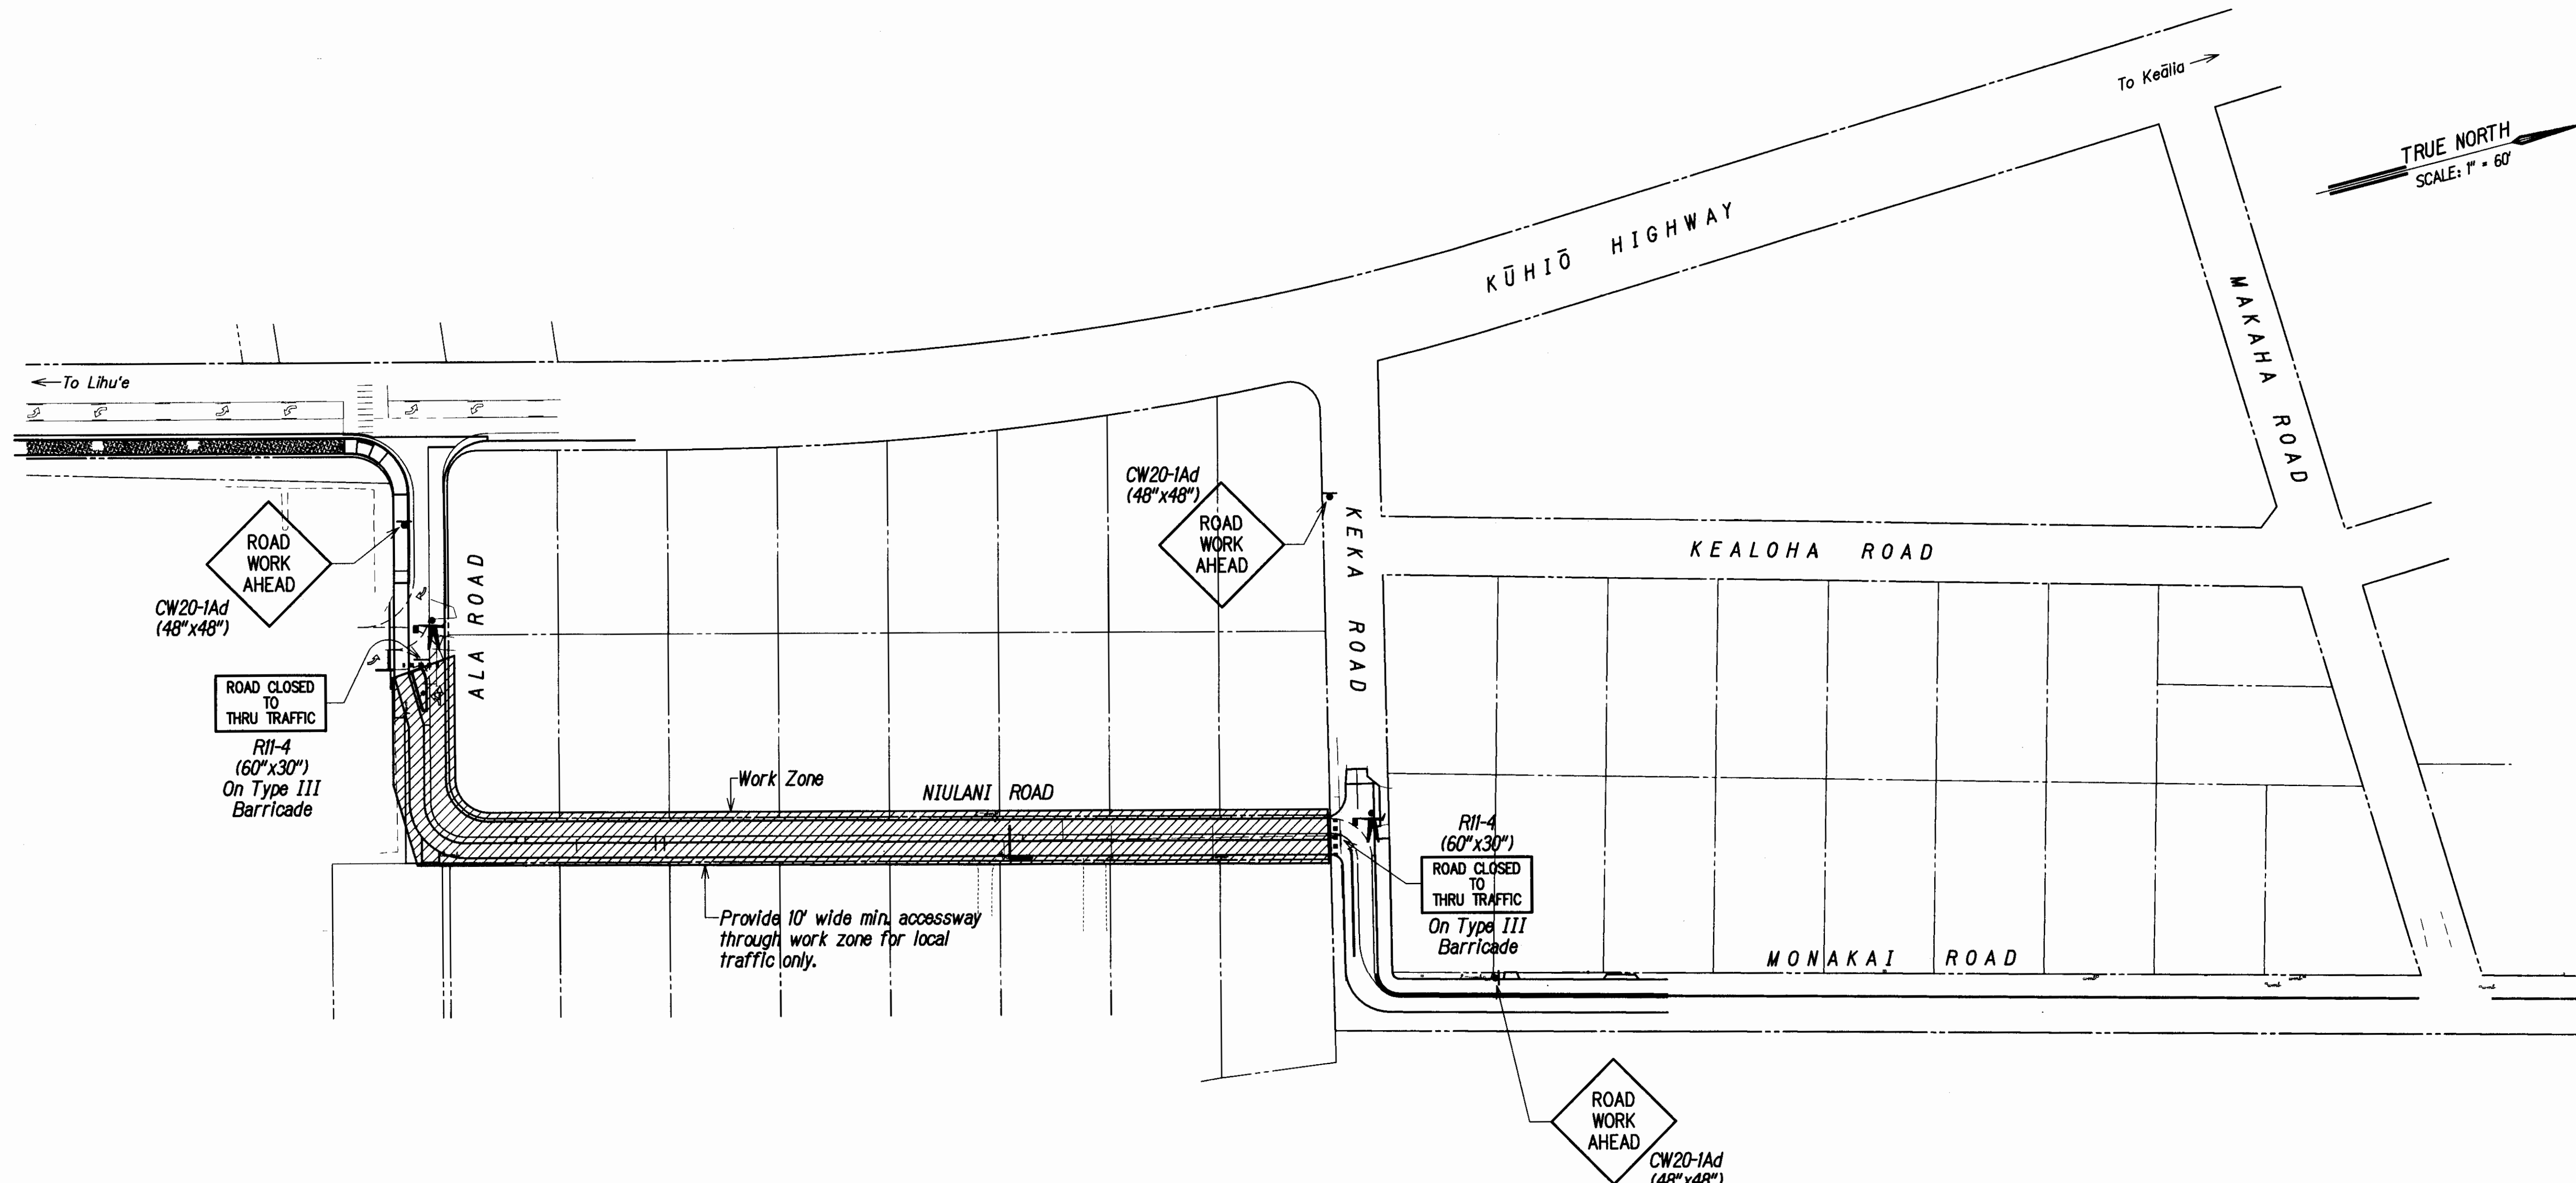

LEGEND:

- Work Zones with Cones at 10' o.c.
- Cones or Channelizing Device
- Travel Lane near Work Zone
- Construction Sign
- Flagman or Police Officer
- High Level Warning Device (Flag Tree)
- Arrow Panel

CONSTRUCTION PHASE - 14
SCALE: 1" = 60'

APPROVED:
COUNTY ENGINEER (FOR WORK WITHIN COUNTY RIGHT OF WAY) DATE 12-21-11

THIS WORK WAS PREPARED BY ME OR UNDER MY SUPERVISION.

SIGNATURE EXPIRATION DATE OF THE LICENSE 4-30-12

COUNTY OF KAUAI
DEPARTMENT OF PUBLIC WORKS
LYDGATE PARK TO KAPA'A BIKE/
PEDESTRIAN PATH PHASE B
KAPA'A, KAUAI, HAWAII

**CONSTRUCTION TRAFFIC
CONTROL PLAN - PHASE 14**
FEDERAL-AID PROJECT NO. STP-0700(61)
DATE: NOVEMBER 2011

DRAWN BY: NGA	F.B.	C.B.	SHEET
TRACED BY: RMA			C12.15
CHECKED BY:			OF SHEETS