


FED. ROAD DIST. NO.	STATE	FED. AID PROJ. NO.	FISCAL YEAR	SHEET NO.	TOTAL SHEETS
HAWAII	HAW.	STP-0700(61)	2011	132	143

20 30

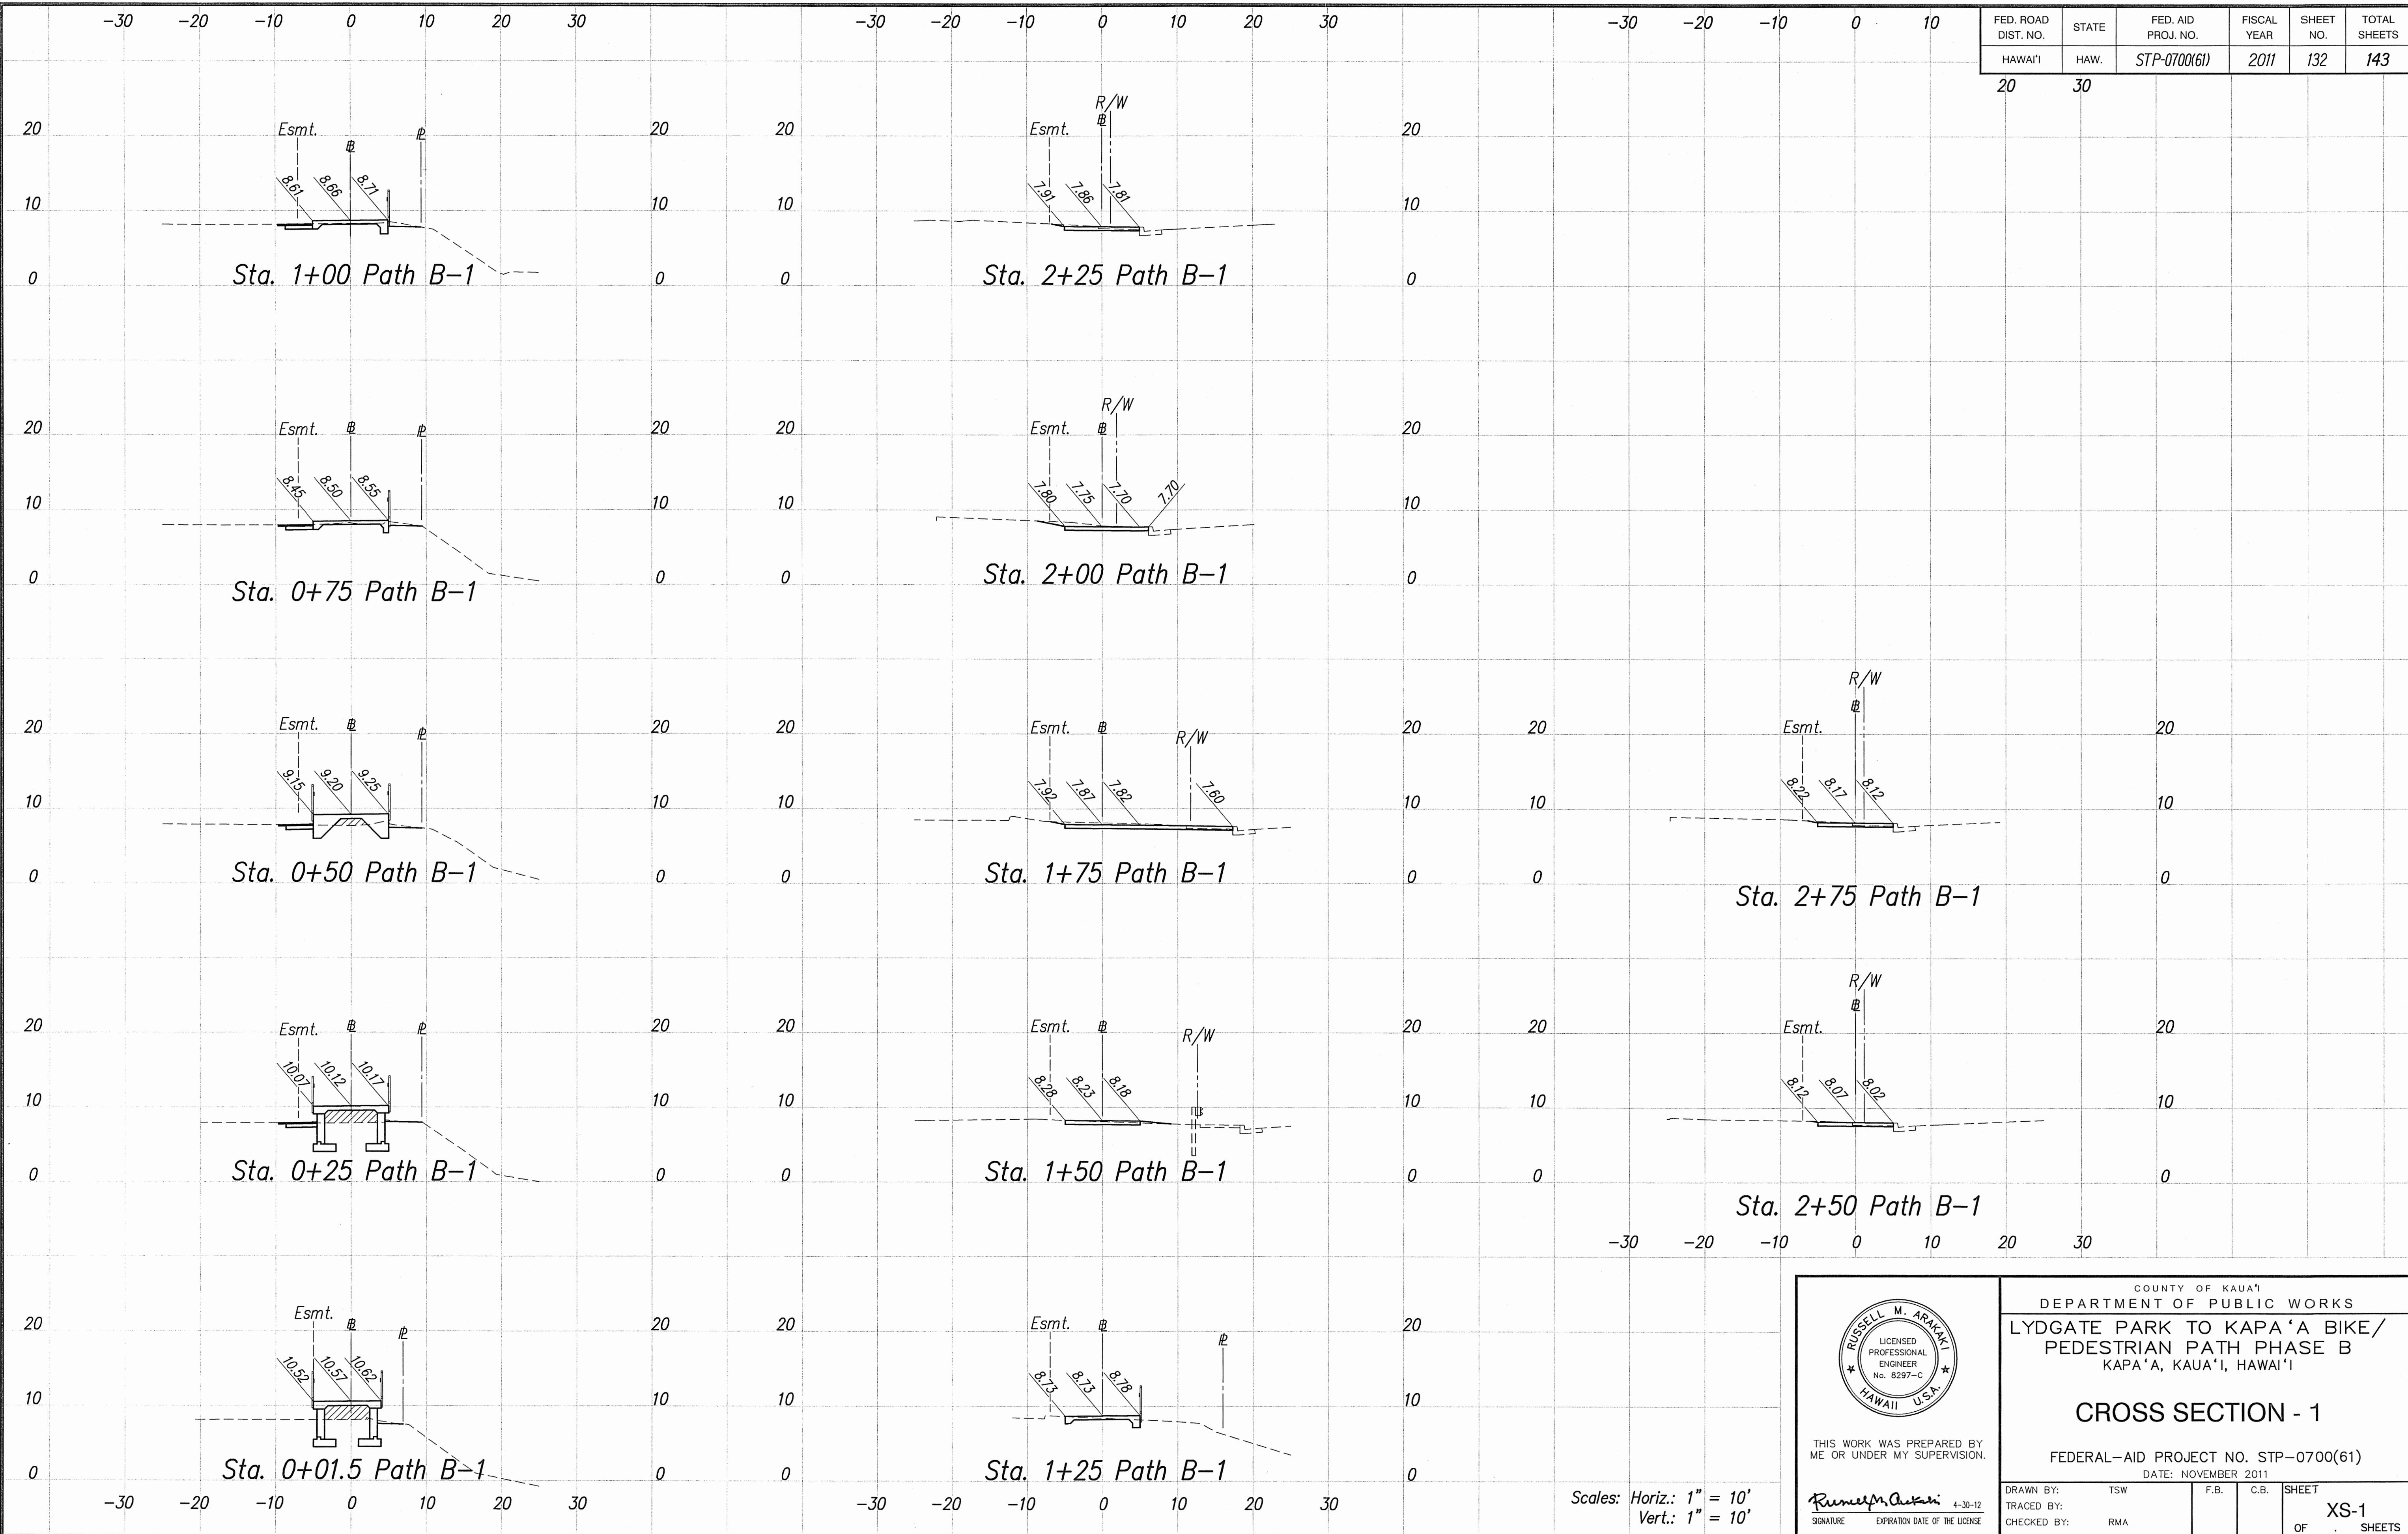

Scales: Horiz.: 1" = 10'
Vert.: 1" = 10'

THIS WORK WAS PREPARED BY ME OR UNDER MY SUPERVISION.

Russell M. Araki
SIGNATURE
4-30-12
EXPIRATION DATE OF THE LICENSE

COUNTY OF KAUAI
DEPARTMENT OF PUBLIC WORKS
LYDGATE PARK TO KAPA'A BIKE/
PEDESTRIAN PATH PHASE B
KAPA'A, KAUAI, HAWAII







CROSS SECTION - 1

FEDERAL-AID PROJECT NO. STP-0700(61)
DATE: NOVEMBER 2011

DRAWN BY: TSW	F.B.	C.B.	SHEET
TRACED BY:			XS-1
CHECKED BY: RMA			OF SHEETS

20	30				
		20			
		10			
2		0			
		20			
		10			
2		0			
		20			
		10			
2		0			
		20			
		10			
2		0			
20	30				

COUNTY OF KAUAI DEPARTMENT OF PUBLIC WORKS LYDGATE PARK TO KAPA'A BIKE/ PEDESTRIAN PATH PHASE B KAPA'A, KAUAI, HAWAII CROSS SECTION - 2 FEDERAL-AID PROJECT NO. STP-0700(61) DATE: NOVEMBER 2011	DRAWN BY:	TSW	F.B.	C.B.	SHEET
	TRACED BY:				XS-2
	CHECKED BY:	RMA			
					OF
					SHEETS

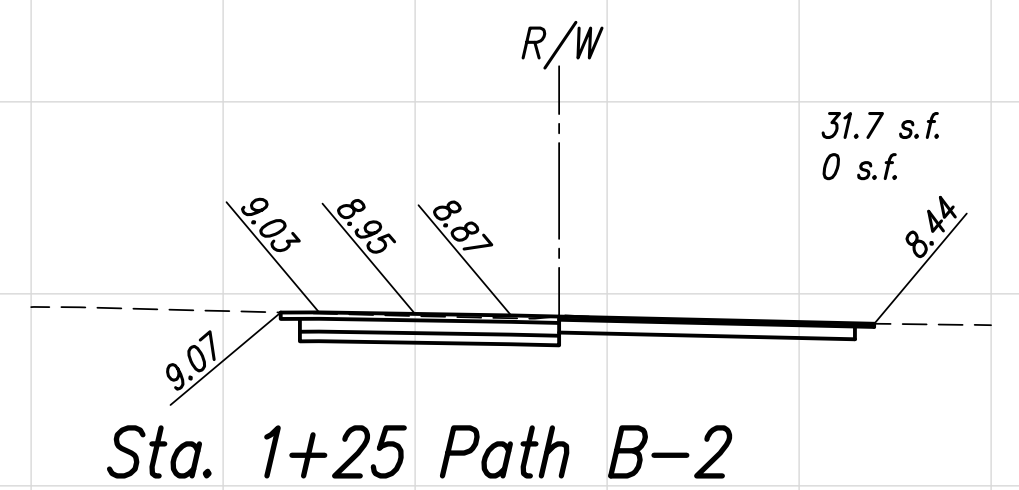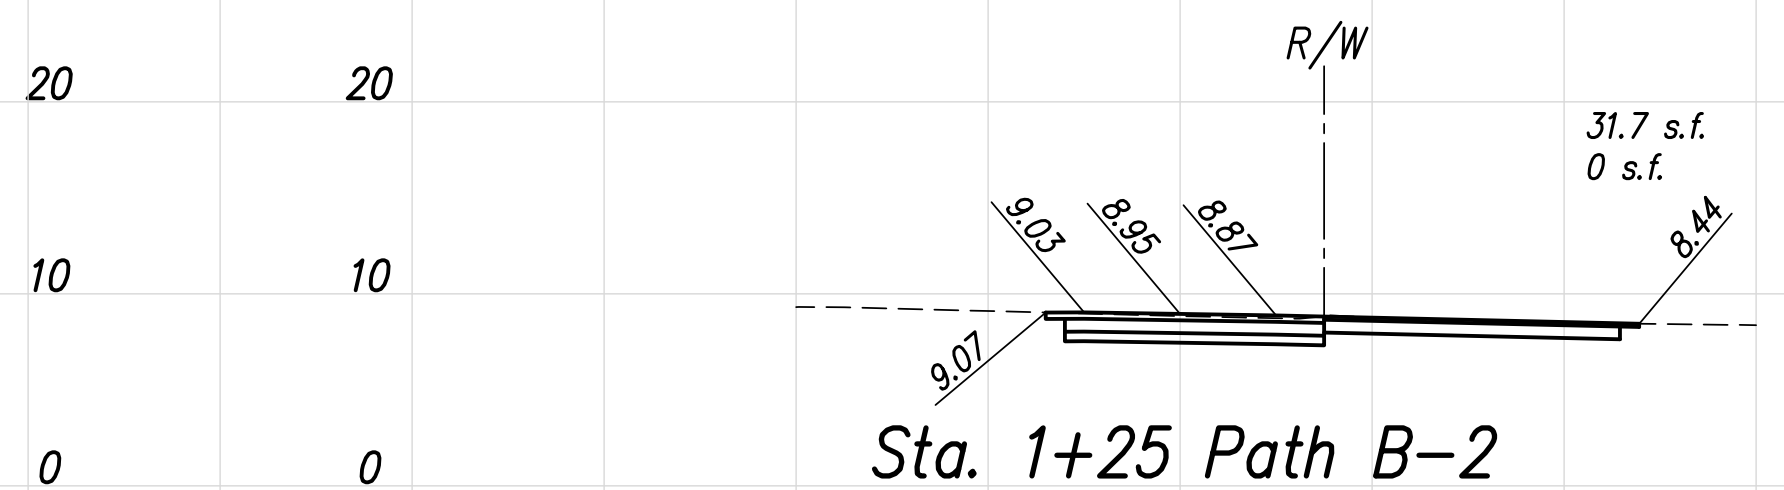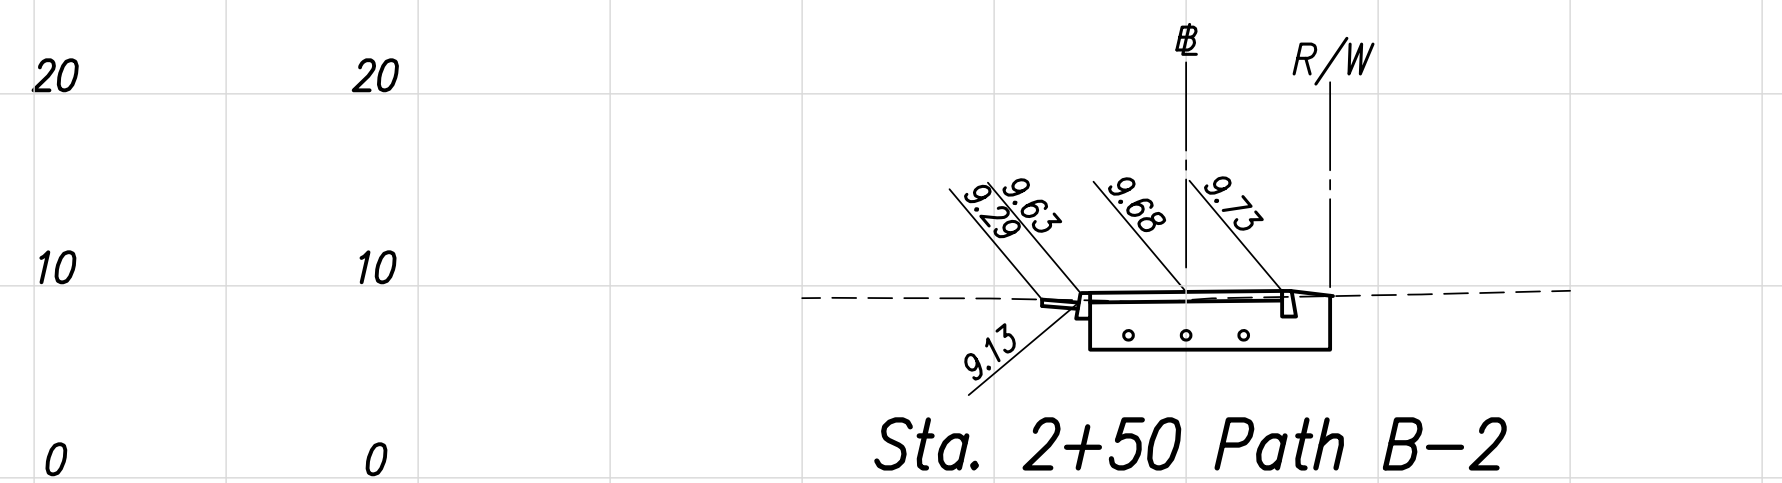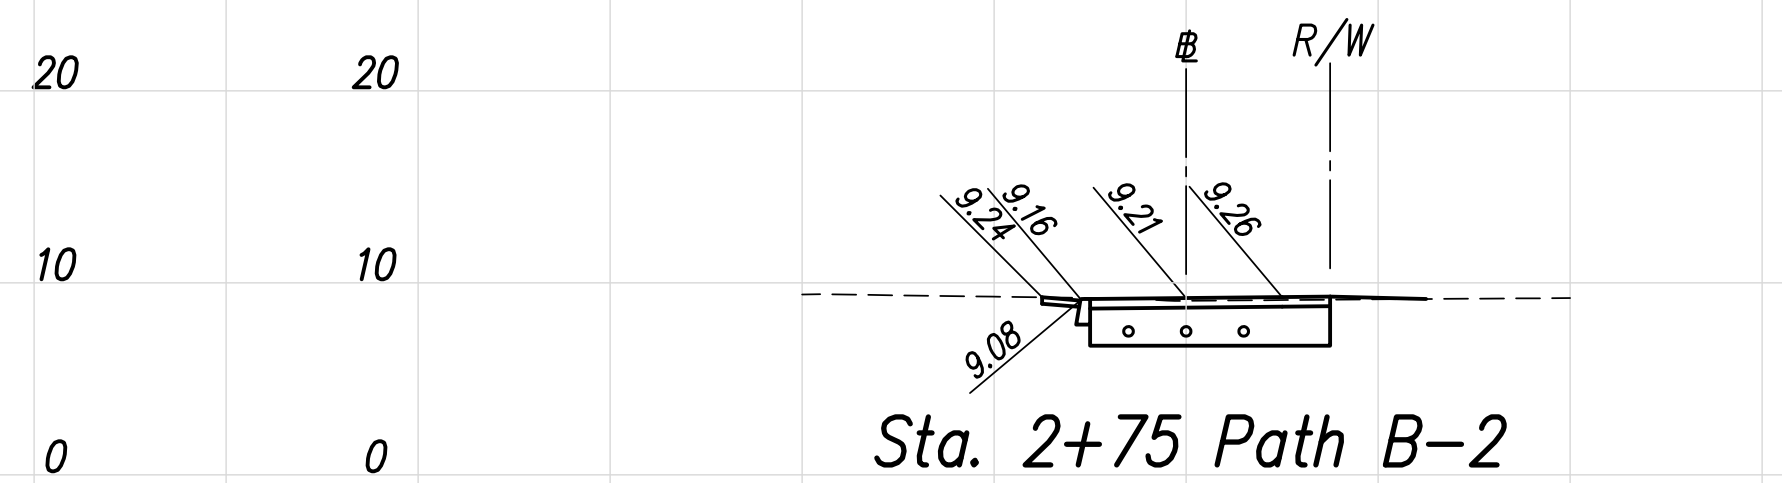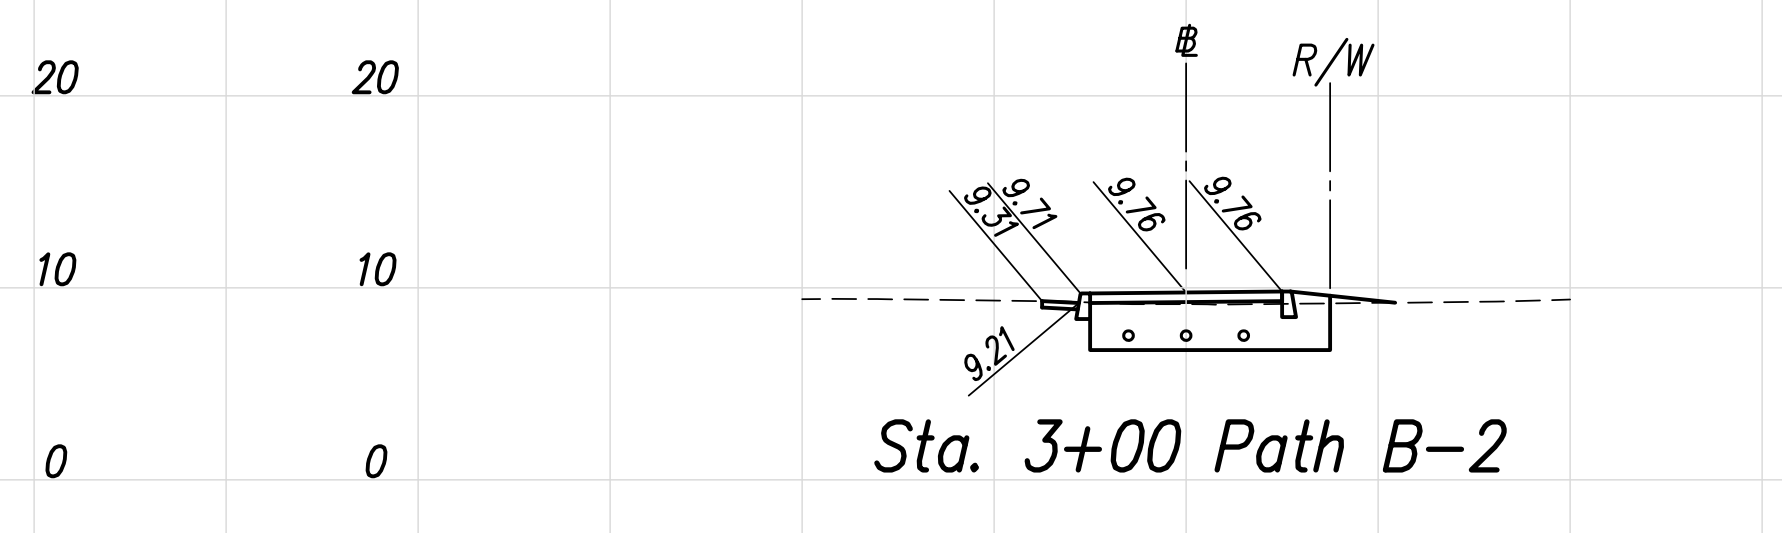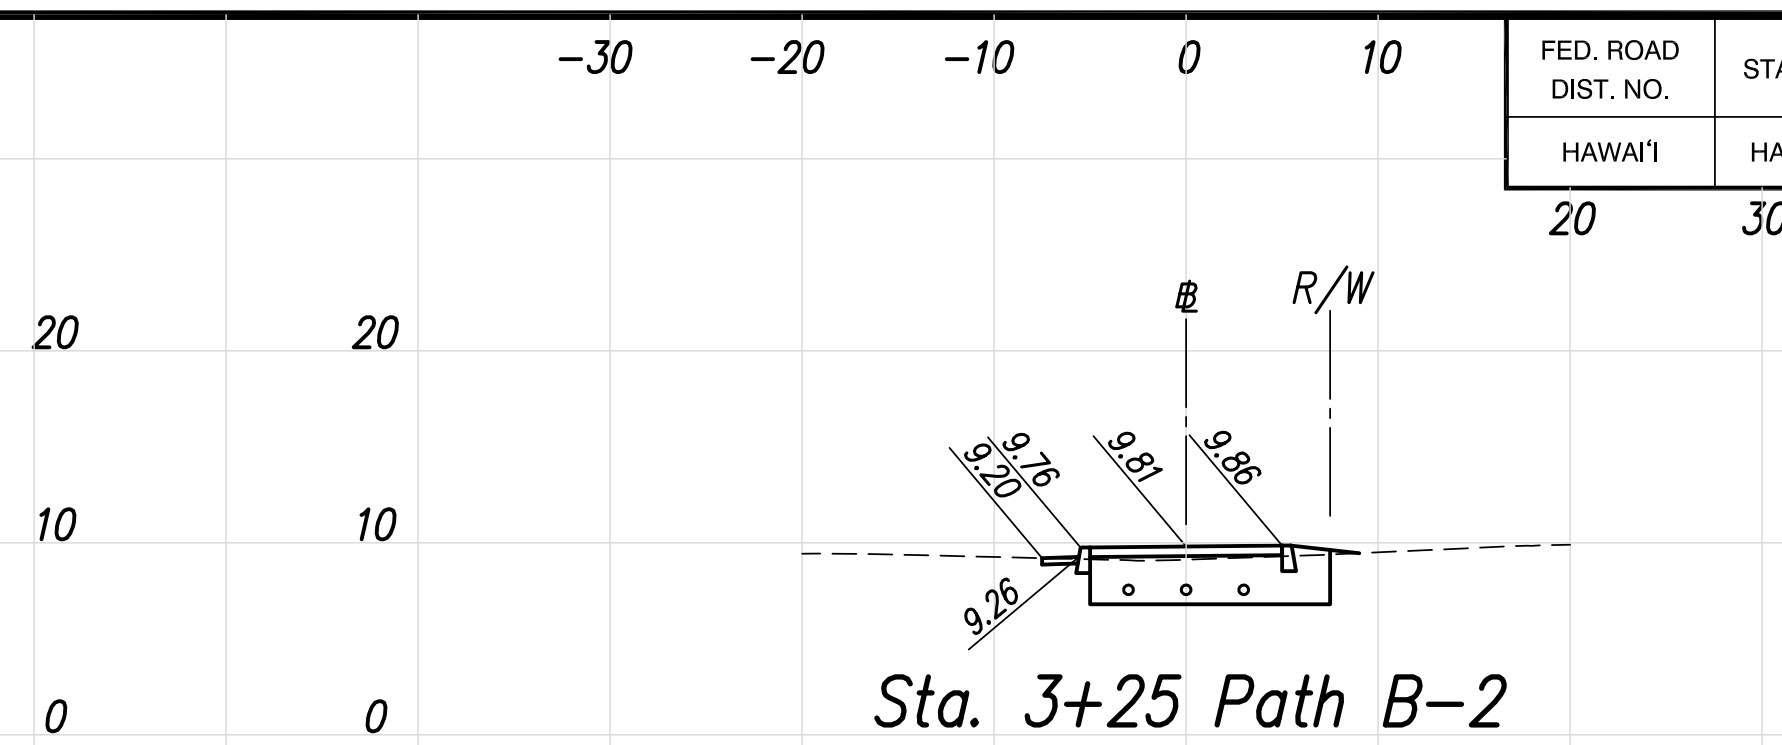

<u>LEGEND FOR</u>	
<u>AS-BUILT POSTINGS</u>	
	Squiggly line for as-built deletion
100.00	Double line for as-built deletion
Roadway	Text for as-built posting



THIS WORK WAS PREPARED BY
ME OR UNDER MY SUPERVISION.

Russell M. Arakaki 30-14

SIGNATURE EXPIRATION DATE OF THE LICENSE

COUNTY OF KAUAI			
DEPARTMENT OF PUBLIC WORKS			
LYDGATE PARK TO KAPA'A BIKE/ PEDESTRIAN PATH PHASE B KAPA'A, KAUAI, HAWAII			
CROSS SECTION - 2			
FEDERAL-AID PROJECT NO. STP-0700(61)			
DATE: NOVEMBER 2011			
DRAWN BY: TSW	F.B.	C.B.	SHEET
TRACED BY:			XS-2
CHECKED BY: RMA			
		OF	SHEETS

20	30
----	----



Runell M. Ouchakov 4-30-12
SIGNATURE EXPIRATION DATE OF THE LICENSE


DRAWN BY: TSW	F.B.	C.B.	SHEET
TRACED BY:			XS-3
CHECKED BY: RMA			OF SHEETS

20	30				
		20			
		10			
3		0			
		20			
		10			
3		0			
		20			
		10			
3		0			
		20			
		10			
3		0			
20	30				



2/26/13	 Revised Grades
DATE	REVISION

COUNTY OF KAUAI DEPARTMENT OF PUBLIC WORKS			
LYDGATE PARK TO KAPA'A BIKE/ PEDESTRIAN PATH PHASE B KAPA'A, KAUAI, HAWAII			
CROSS SECTION - 4			
FEDERAL-AID PROJECT NO. STP-0700(61) DATE: NOVEMBER 2011			
DRAWN BY: TRACED BY: CHECKED BY:	TSW RMA	F.B. 	C.B.

SHEET OF SHEETS	XS-4
-----------------------	------

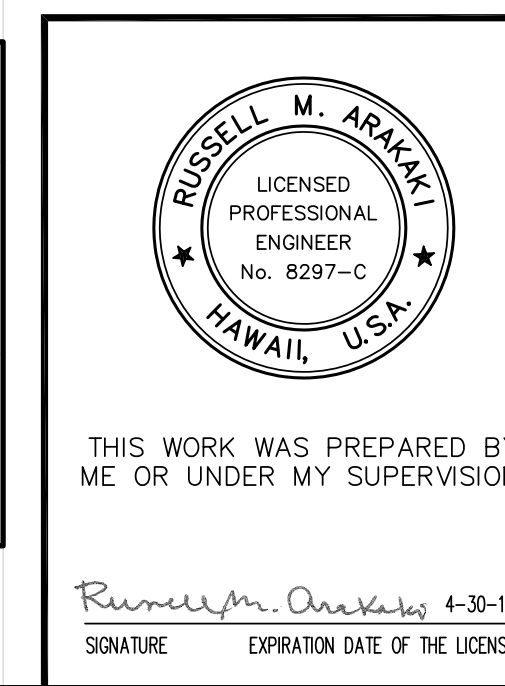

C.O. 135

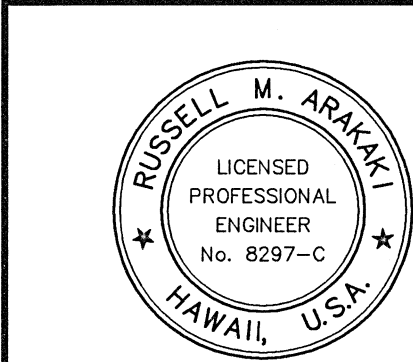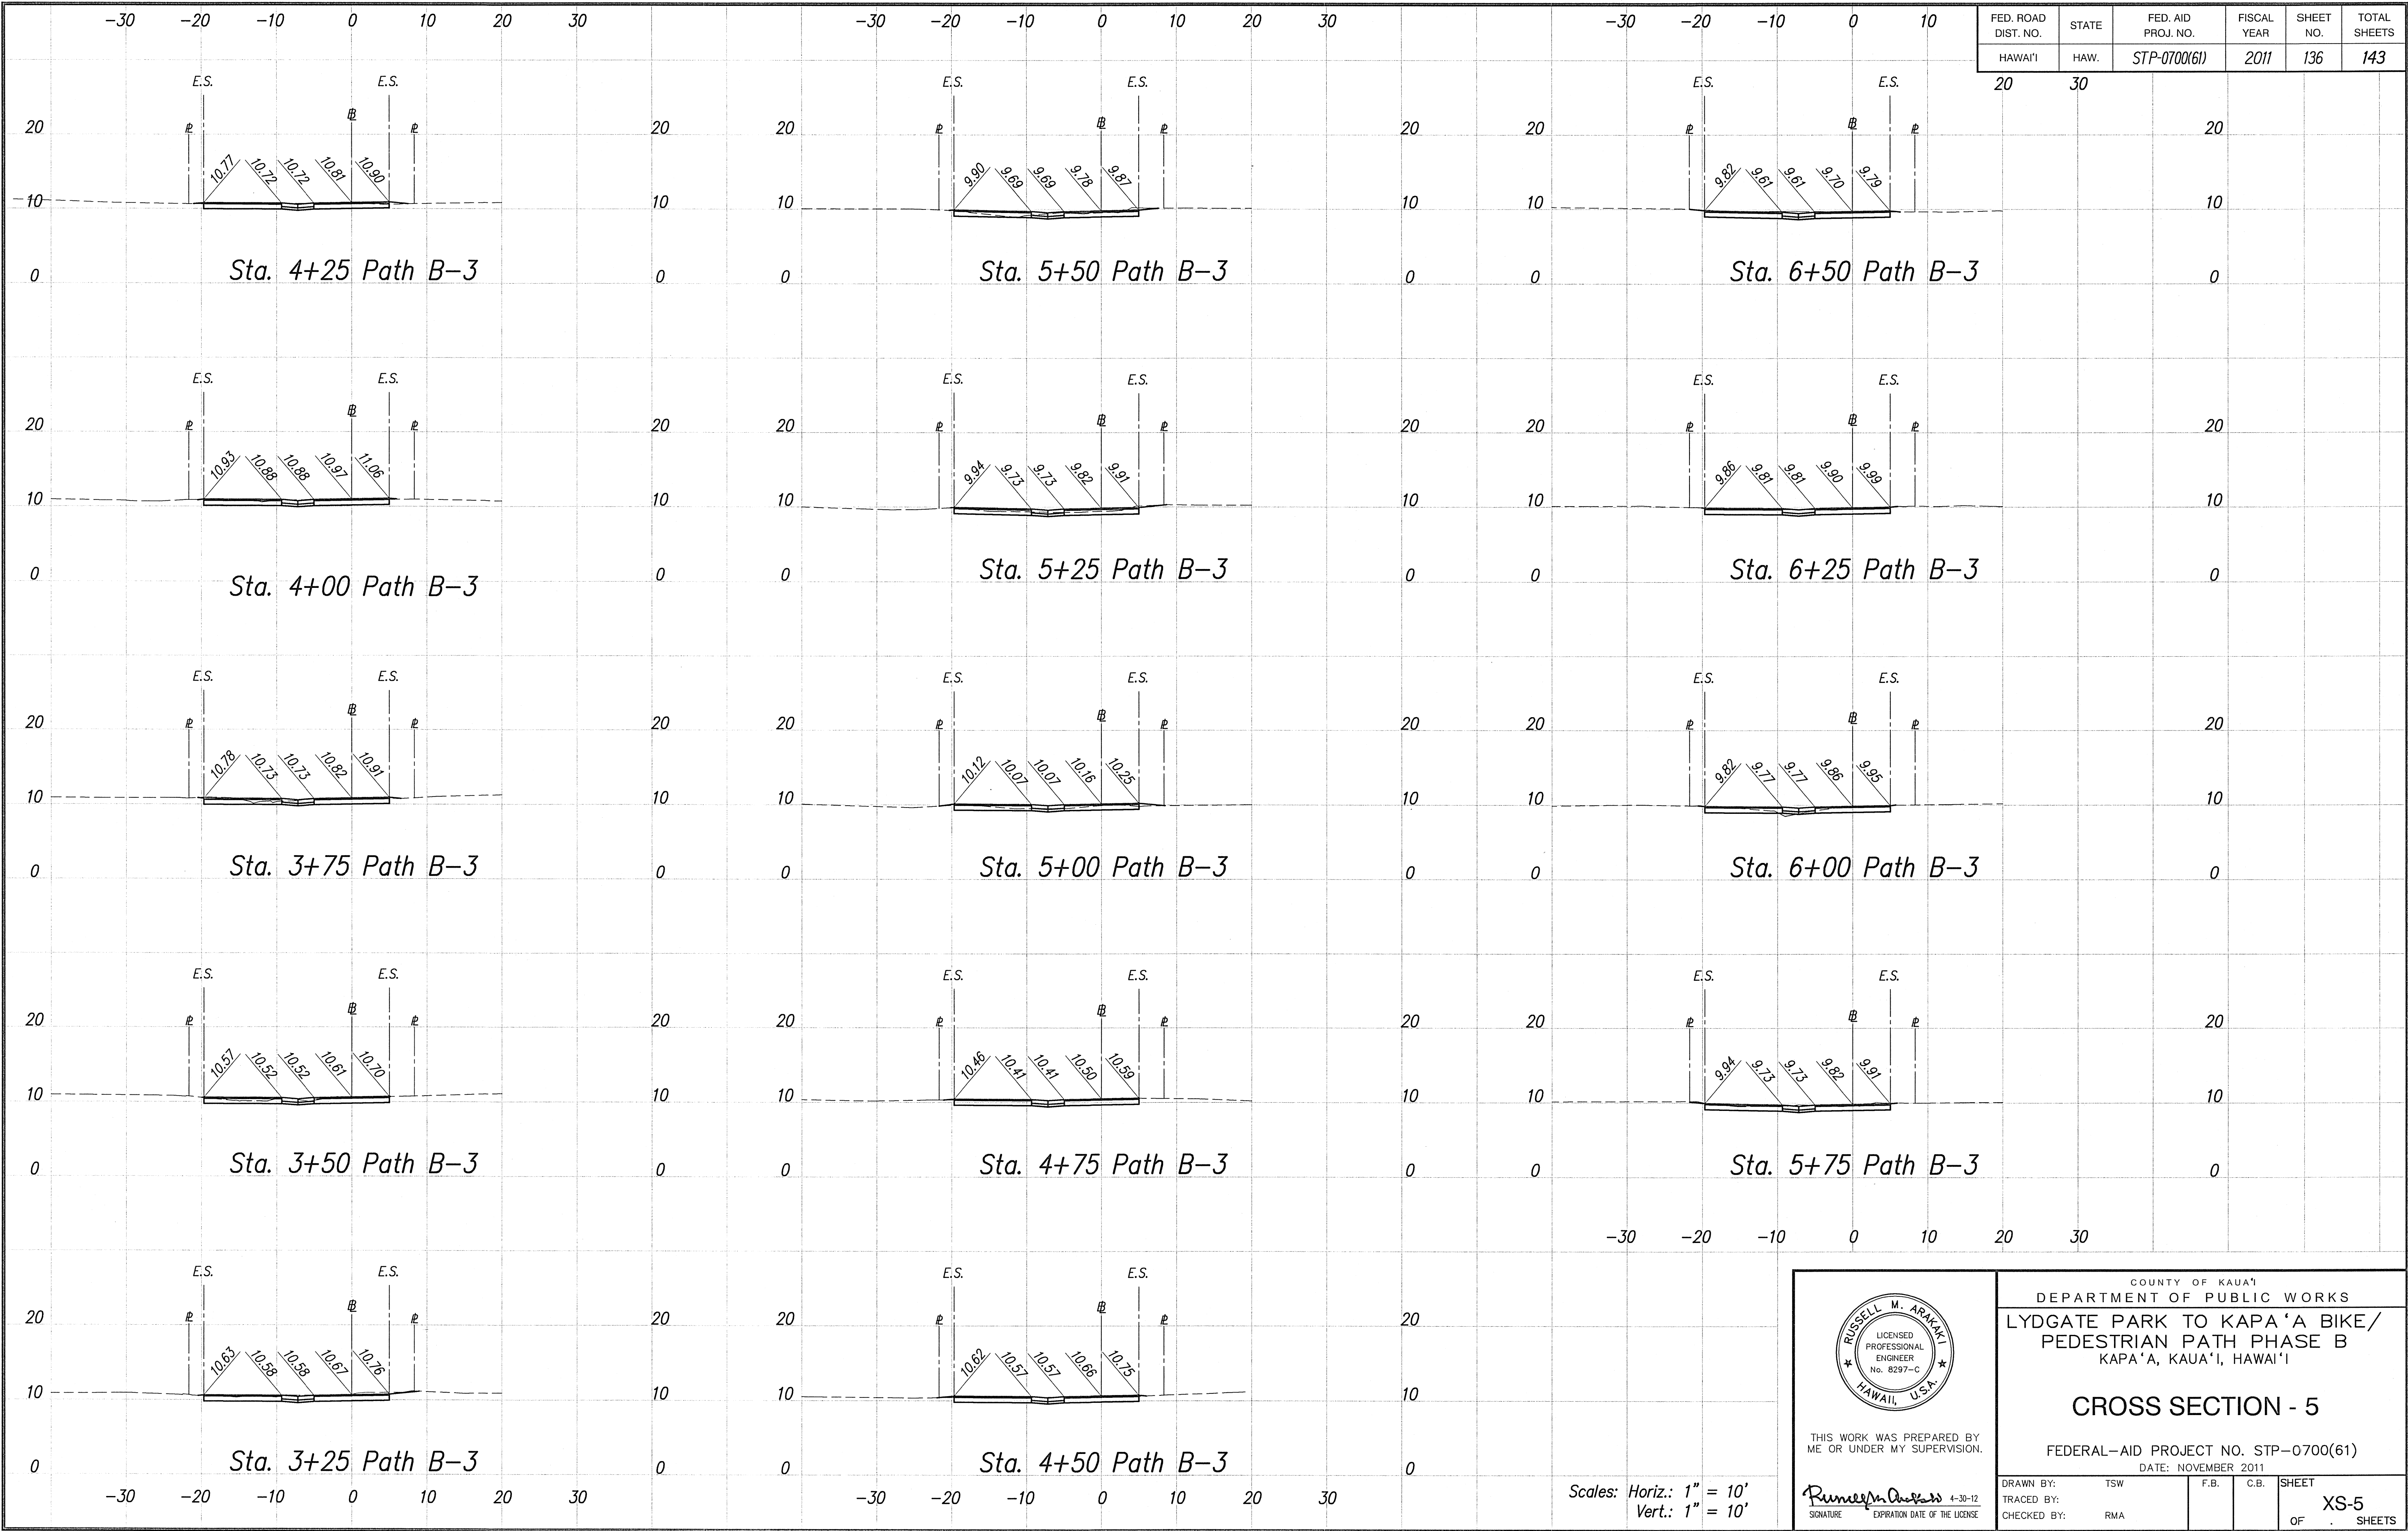












THIS WORK WAS PREPARED BY ME OR UNDER MY SUPERVISION.

Russell M. Araki
SIGNATURE
4-30-12
EXPIRATION DATE OF THE LICENSE

COUNTY OF KAUAI DEPARTMENT OF PUBLIC WORKS			
LYDGATE PARK TO KAPA'A BIKE/ PEDESTRIAN PATH PHASE B KAPA'A, KAUAI, HAWAII			
CROSS SECTION - 5			
FEDERAL-AID PROJECT NO. STP-0700(61) DATE: NOVEMBER 2011			
DRAWN BY:	TSW	F.B.	C.B.
TRACED BY:			
CHECKED BY:	RMA		
OF		XS-5 SHEETS	

"AS-BUILT"

FED. ROAD DIST. NO.	STATE	FED. AID PROJ. NO.	FISCAL YEAR	SHEET NO.	TOTAL SHEETS
HAWAII	HAW.	STP-0700(61)	2011	137	143

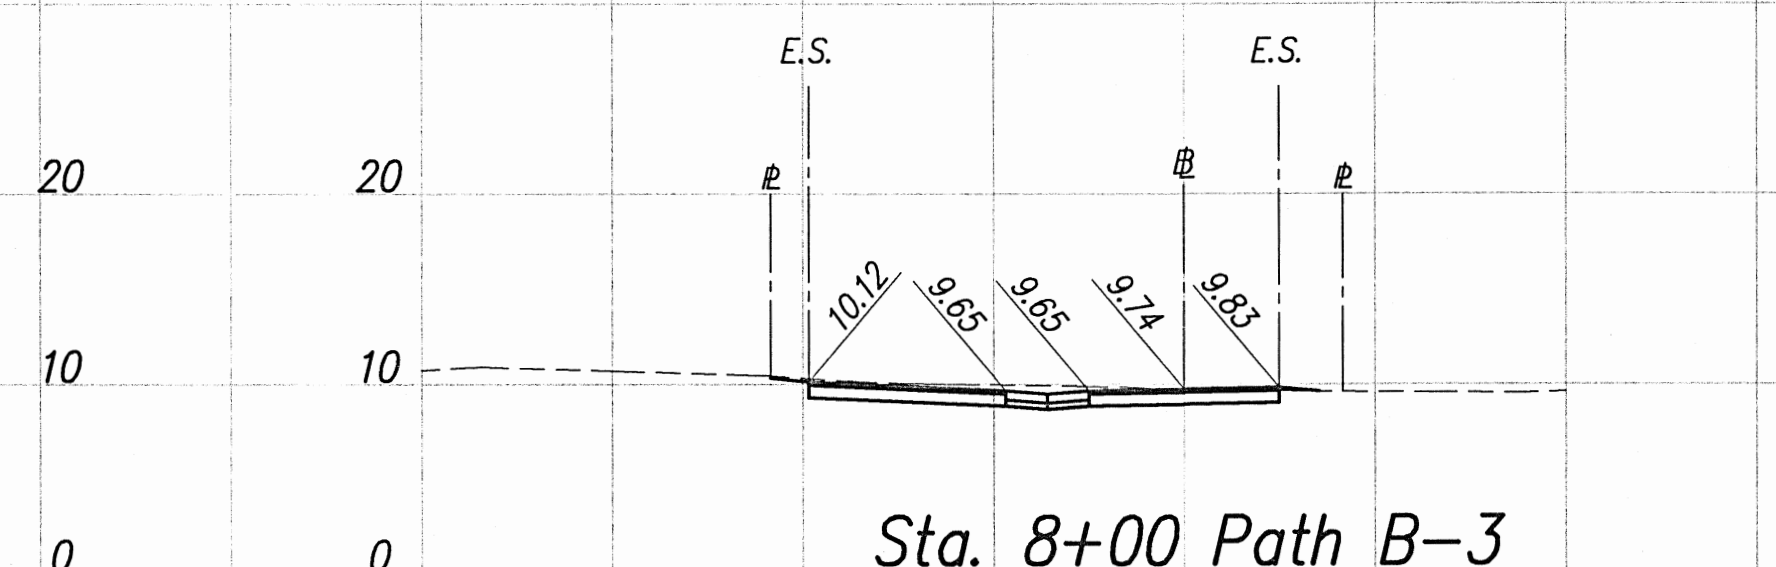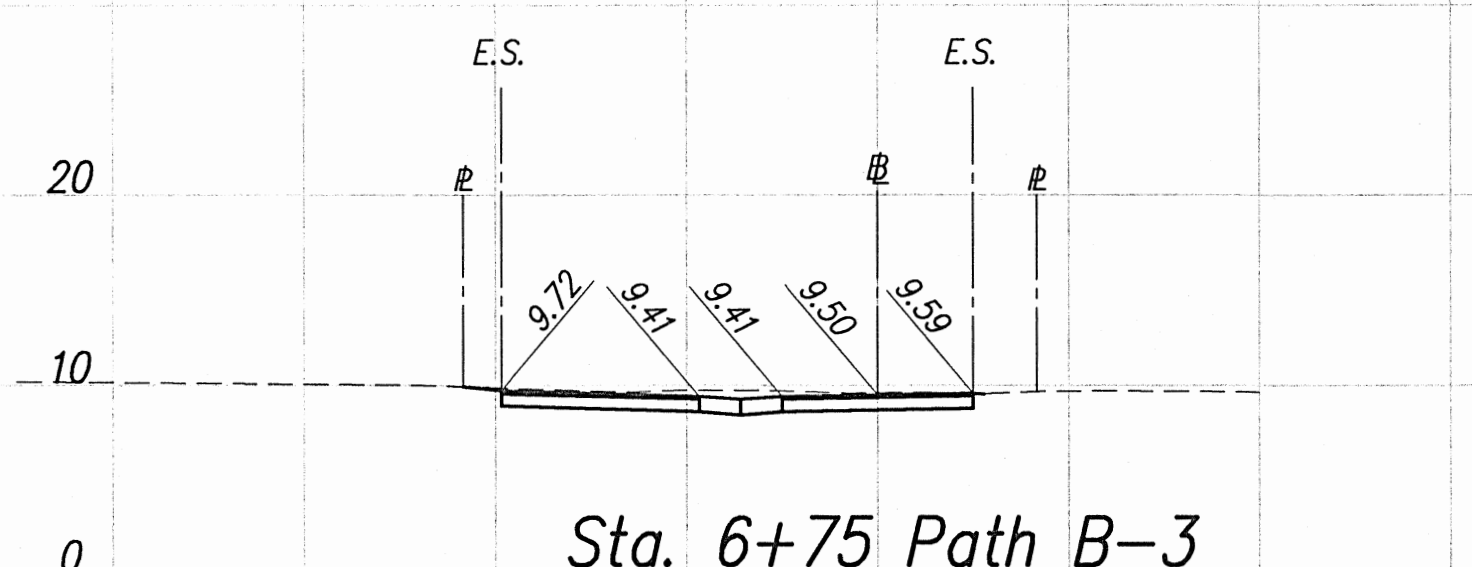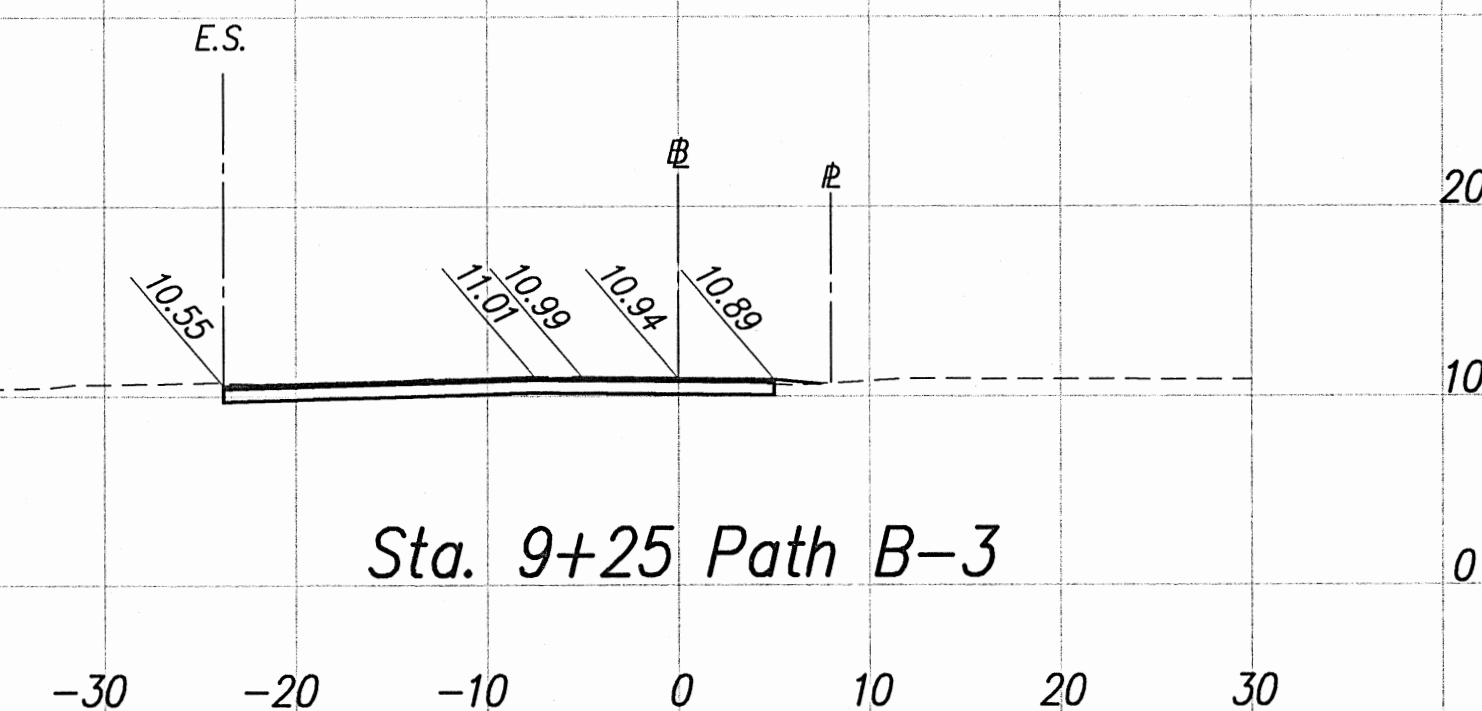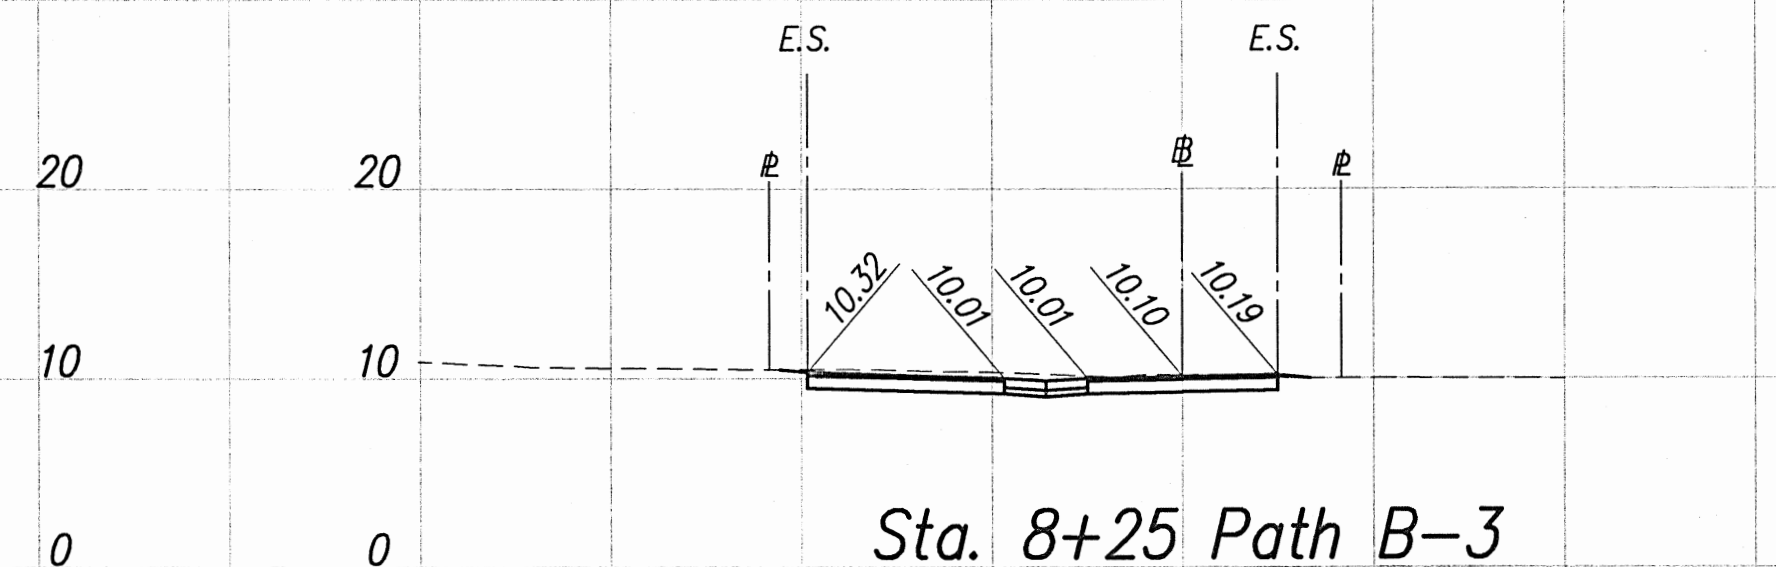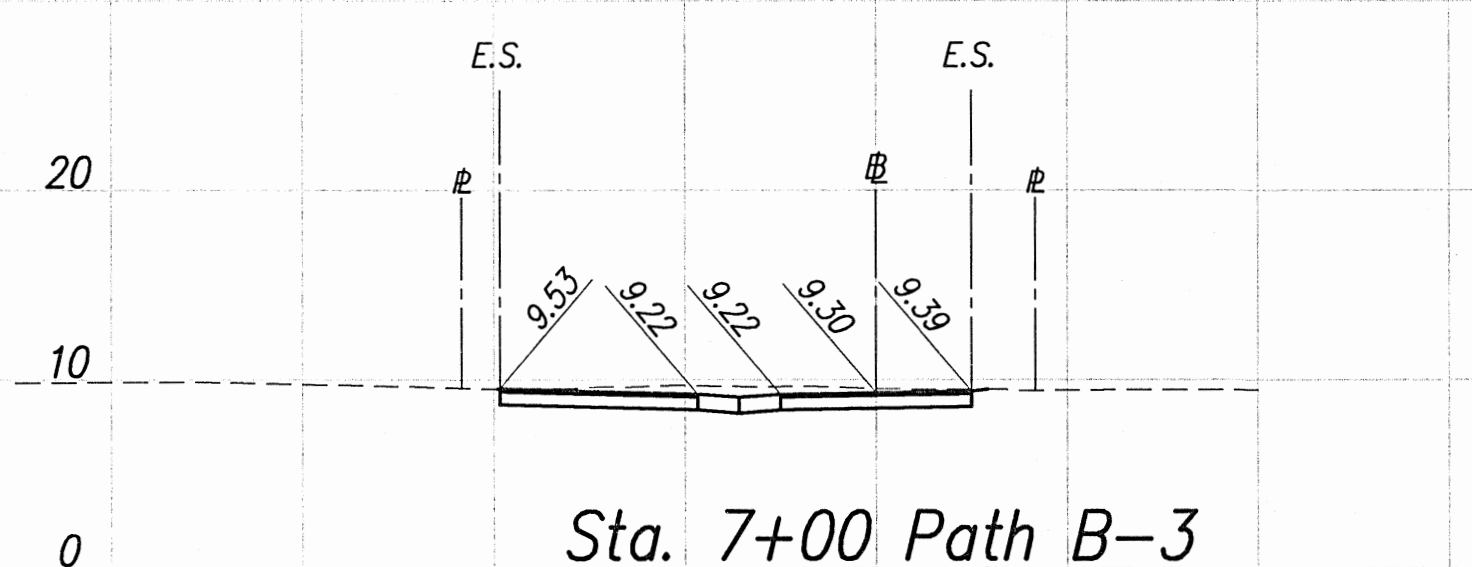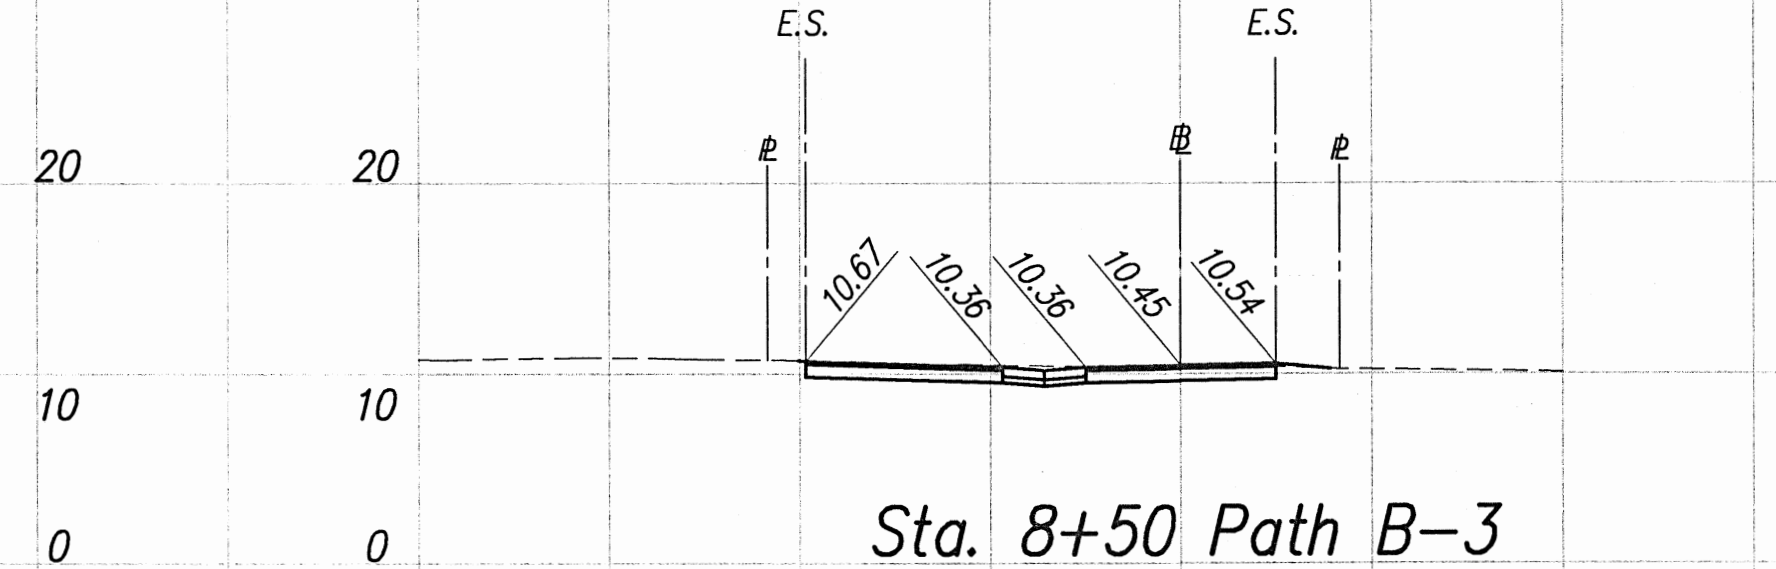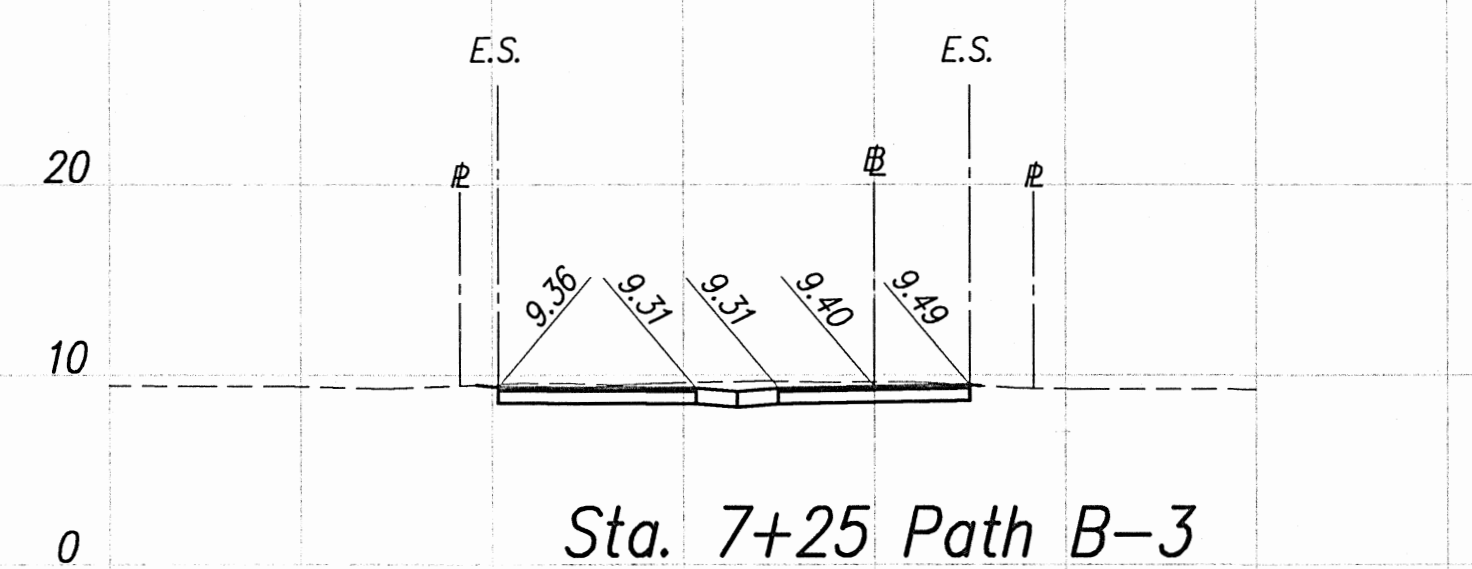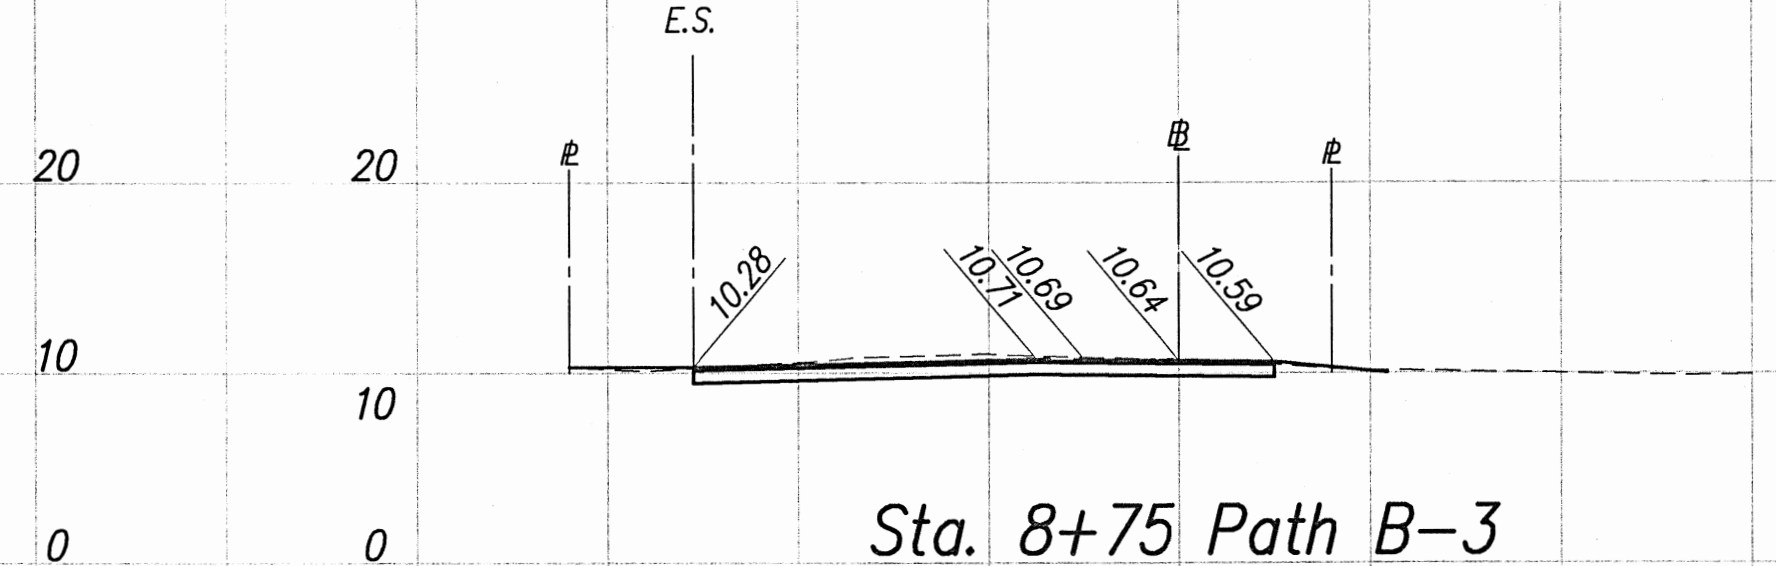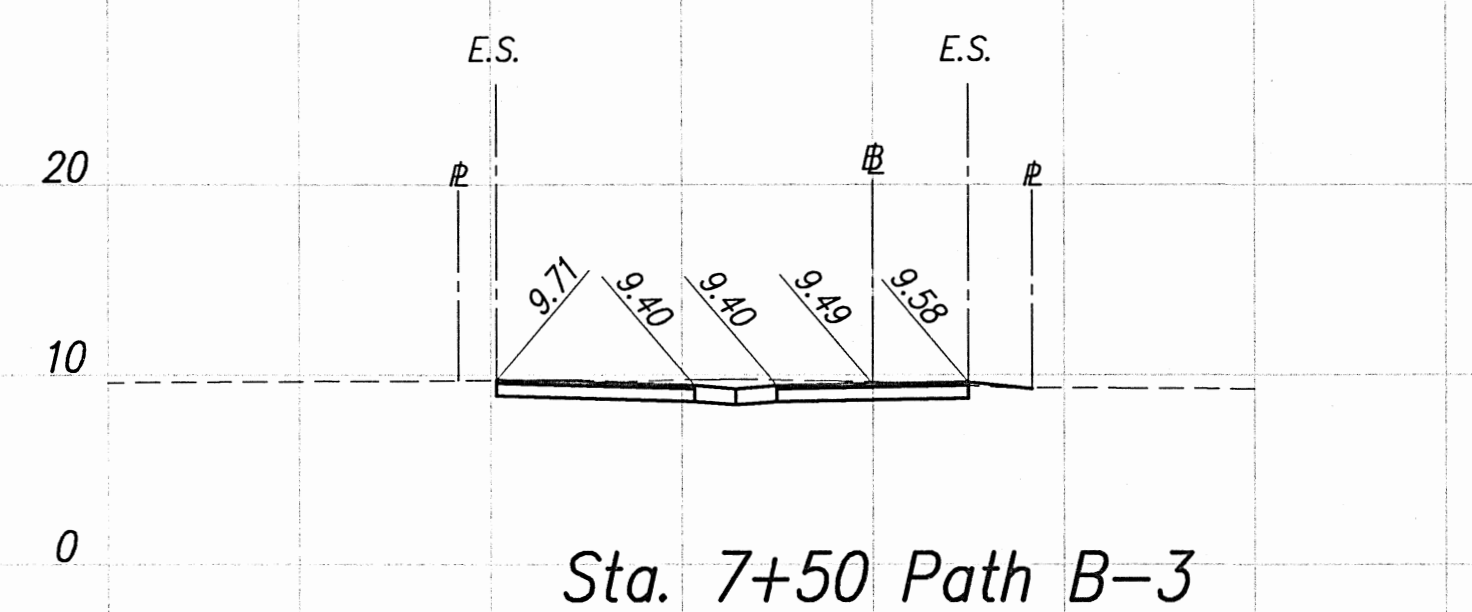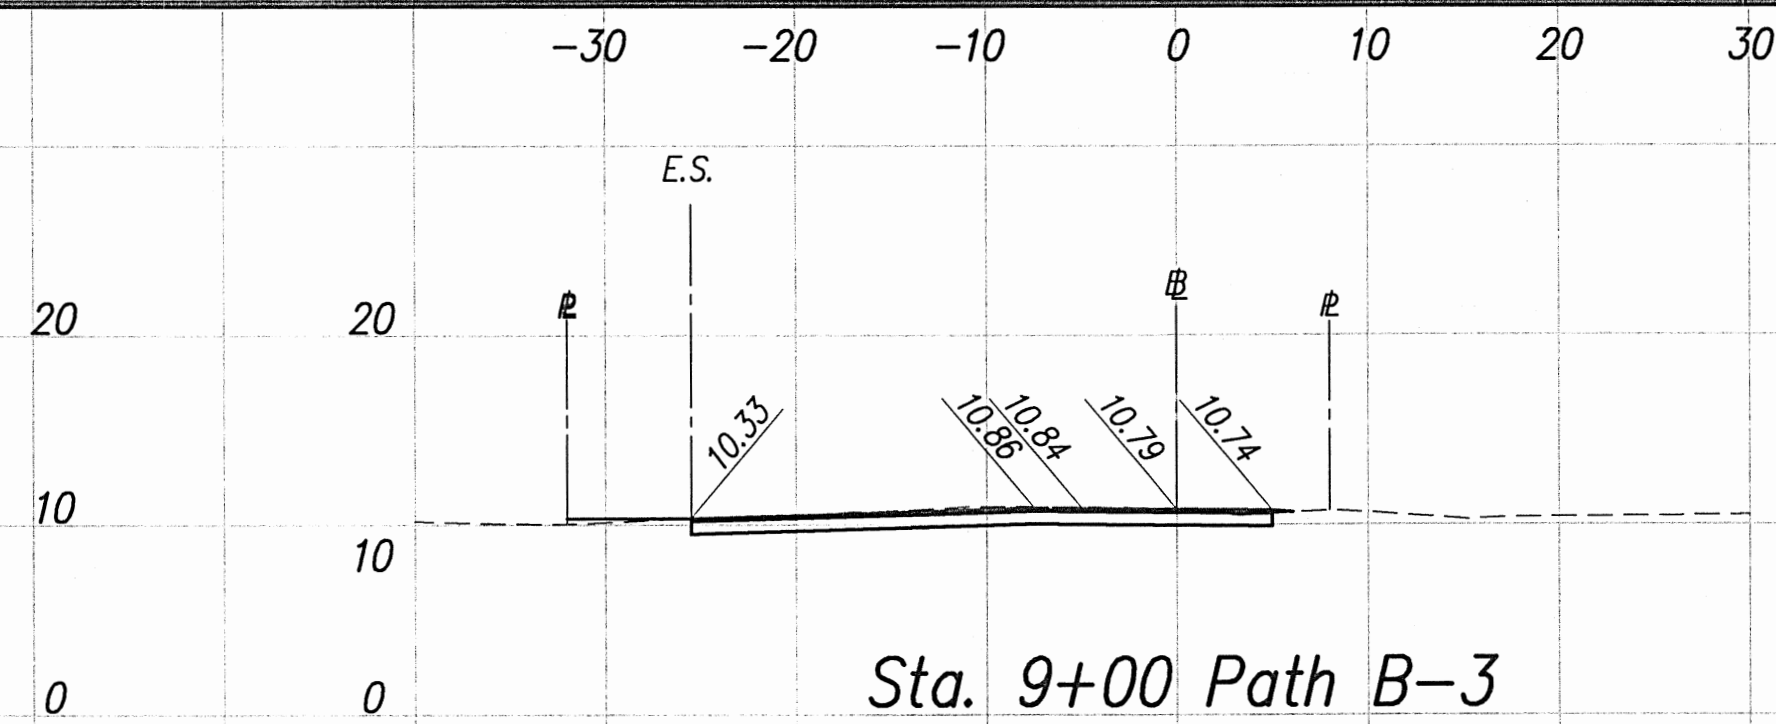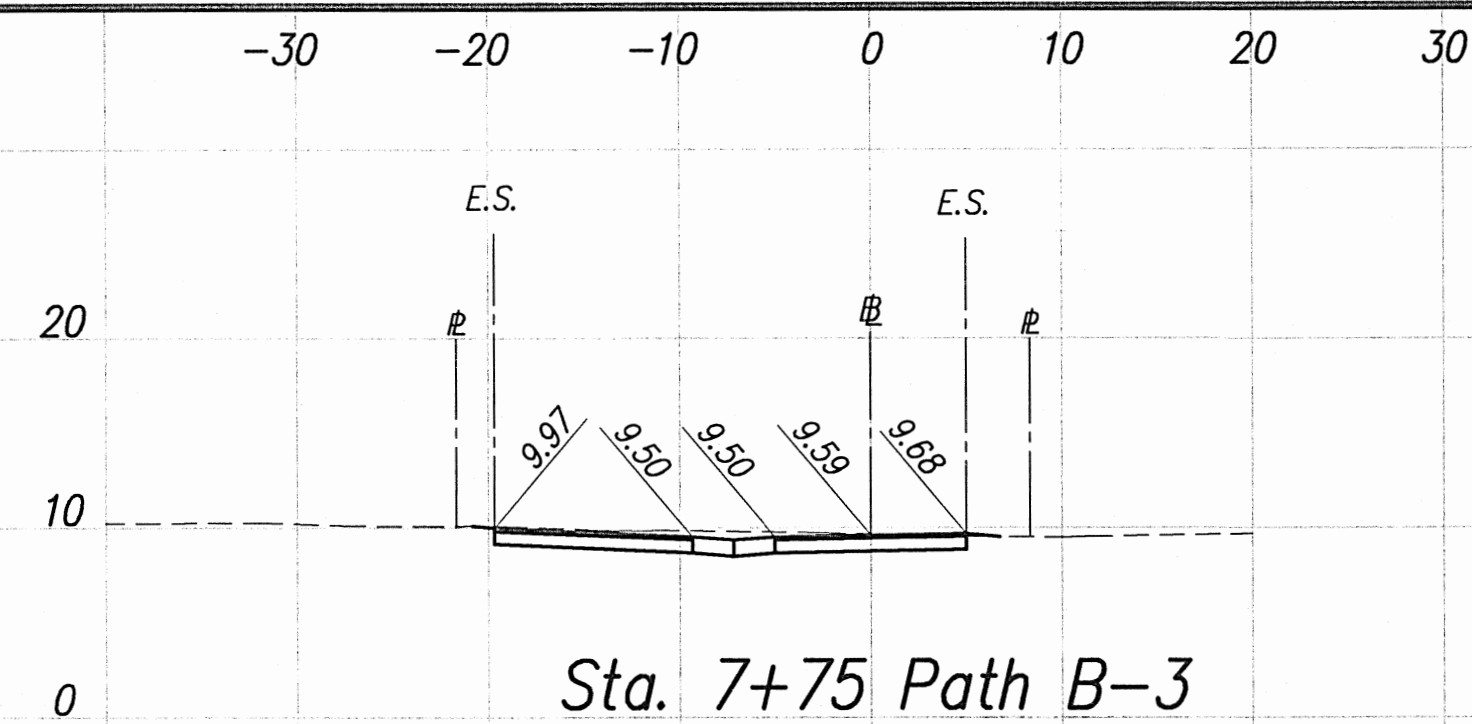

Scales: Horiz.: 1" = 10'
Vert.: 1" = 10'

 THIS WORK WAS PREPARED BY ME OR UNDER MY SUPERVISION. <i>Russell M. Arakaki</i> SIGNATURE 4-30-12 EXPIRATION DATE OF THE LICENSE	COUNTY OF KAUAI DEPARTMENT OF PUBLIC WORKS LYDGATE PARK TO KAPA'A BIKE/ PEDESTRIAN PATH PHASE B KAPA'A, KAUAI, HAWAII			
	CROSS SECTION - 6			
	FEDERAL-AID PROJECT NO. STP-0700(61) DATE: NOVEMBER 2011			
	DRAWN BY: TRACED BY: CHECKED BY:	TSW RMA	F.B.	C.B.

"AS-BUILT"






137

20	30	20			
2.17		10			
4		0			
		20			
2.25		10			
4		0			
		20			
2.34		10			
4		0			
		20			
2.59		10			
4		0			
20	30				

DRAWN BY: TRACED BY: CHECKED BY:	TSW	F.B.	C.B.	SHEET
	RMA			XS-8
				OF
				SHEETS


COUNTY OF KAUAI
 DEPARTMENT OF PUBLIC WORKS
 LYDGATE PARK TO KAPA'A BIKE/
 PEDESTRIAN PATH PHASE B
 KAPA'A, KAUAI, HAWAII

CROSS SECTION - 8
 FEDERAL-AID PROJECT NO. STP-0700(61)
 DATE: NOVEMBER 2011

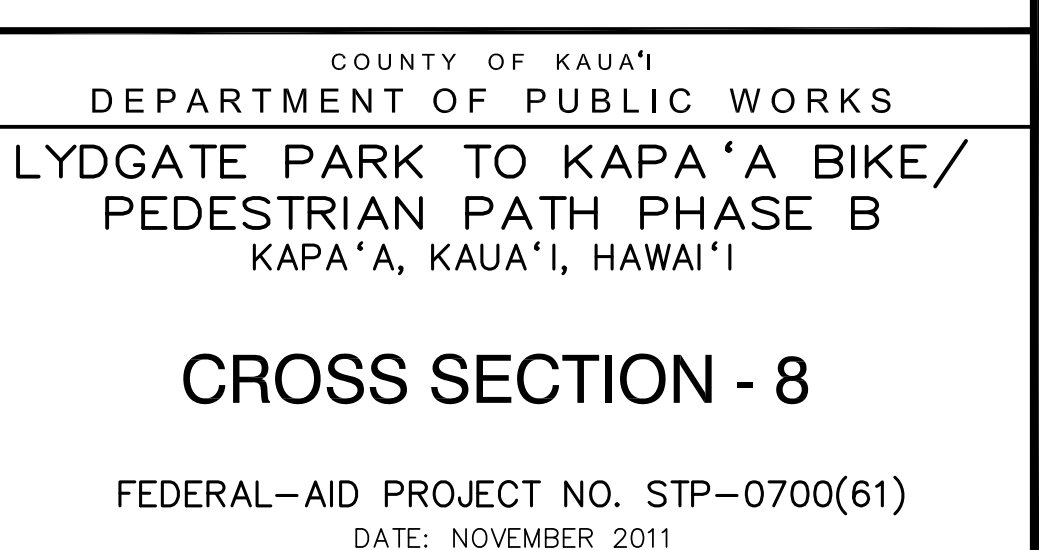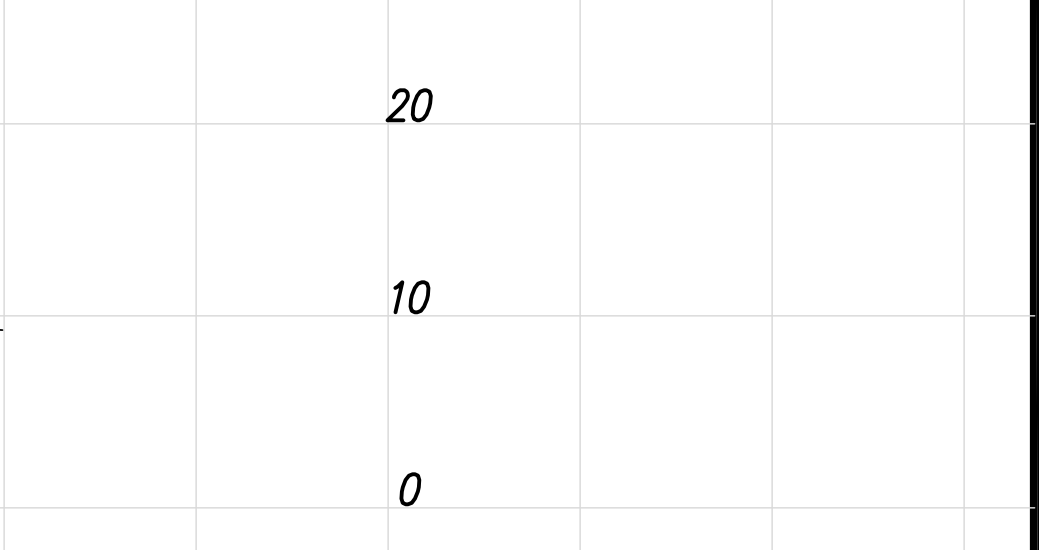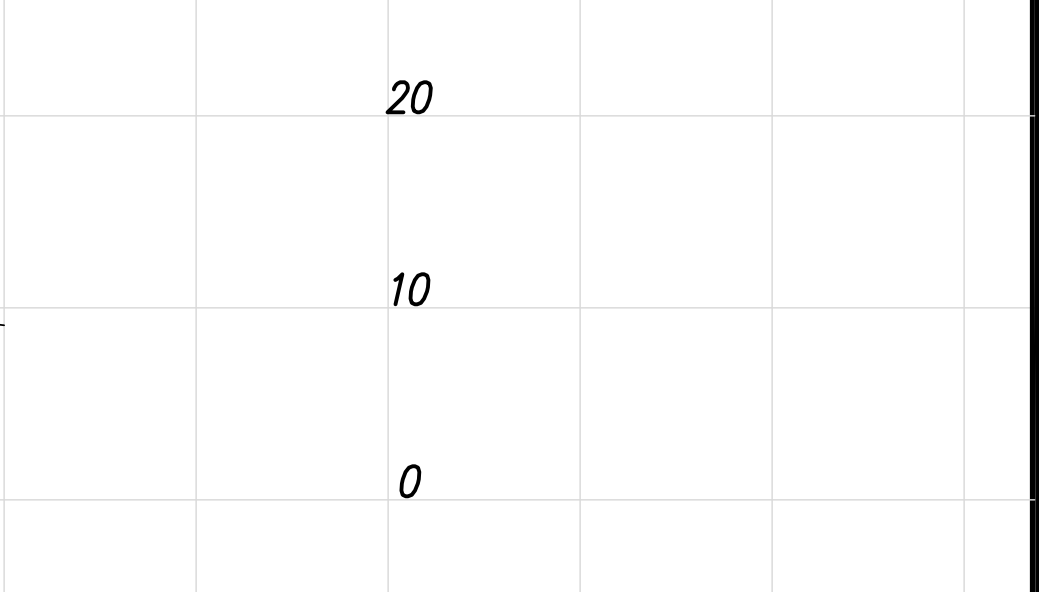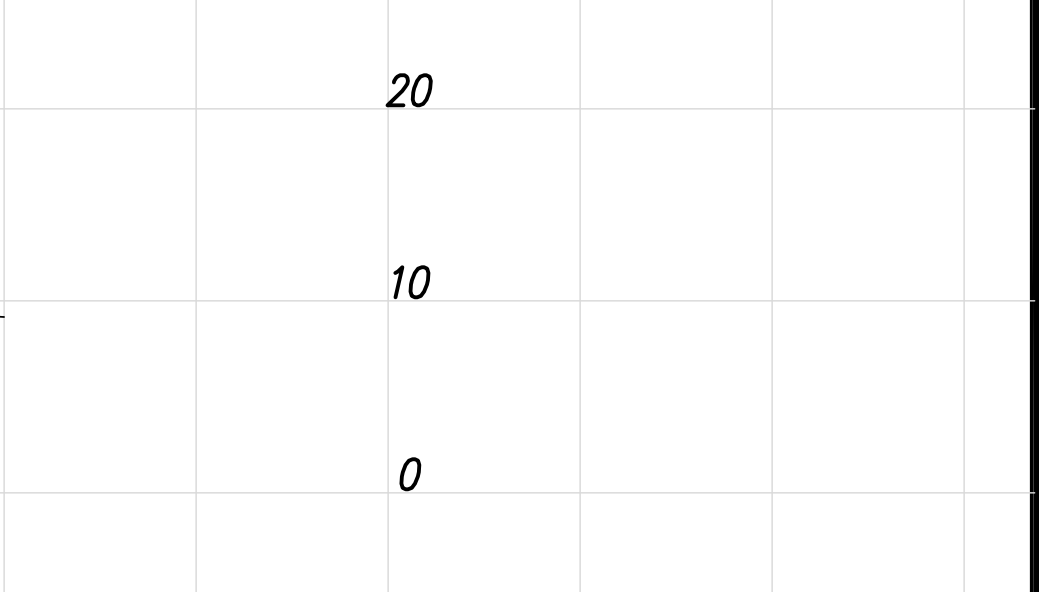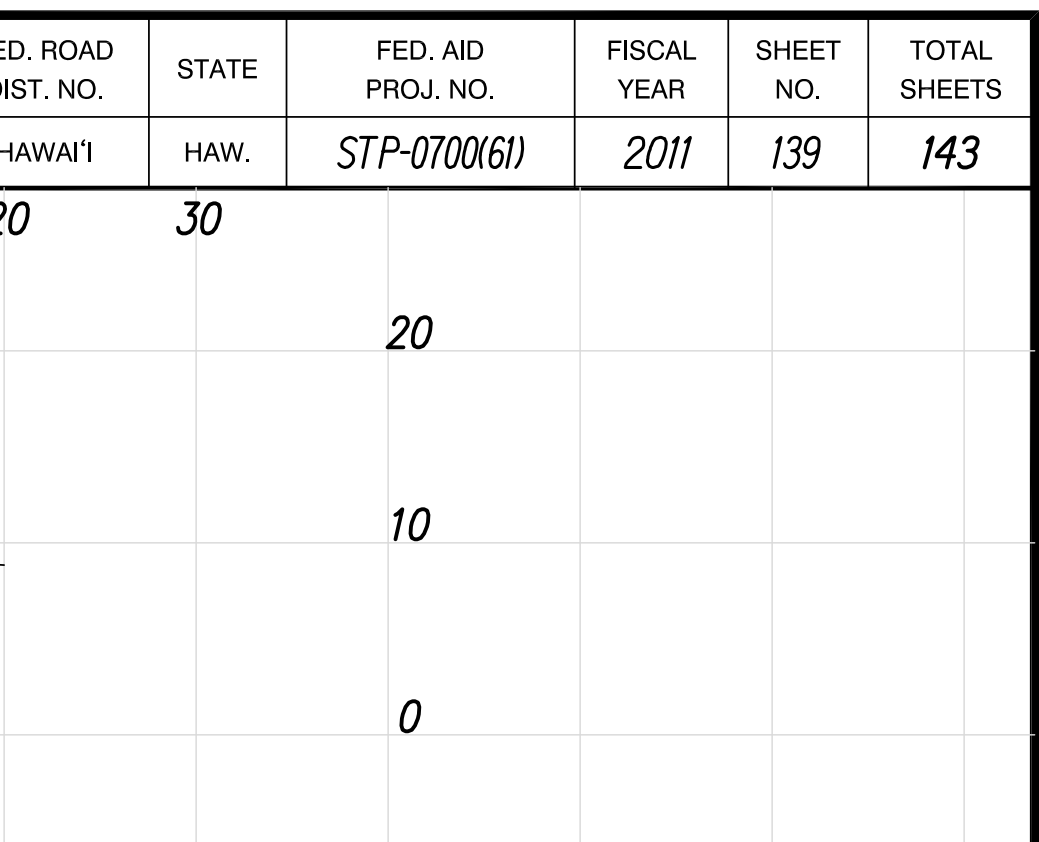

"AS-BUILT"

FED. ROAD DIST. NO.	STATE	FED. AID PROJ. NO.	FISCAL YEAR	SHEET NO.	TOTAL SHEETS
HAWAII	HAW.	STP-0700(61)	2011	141	143

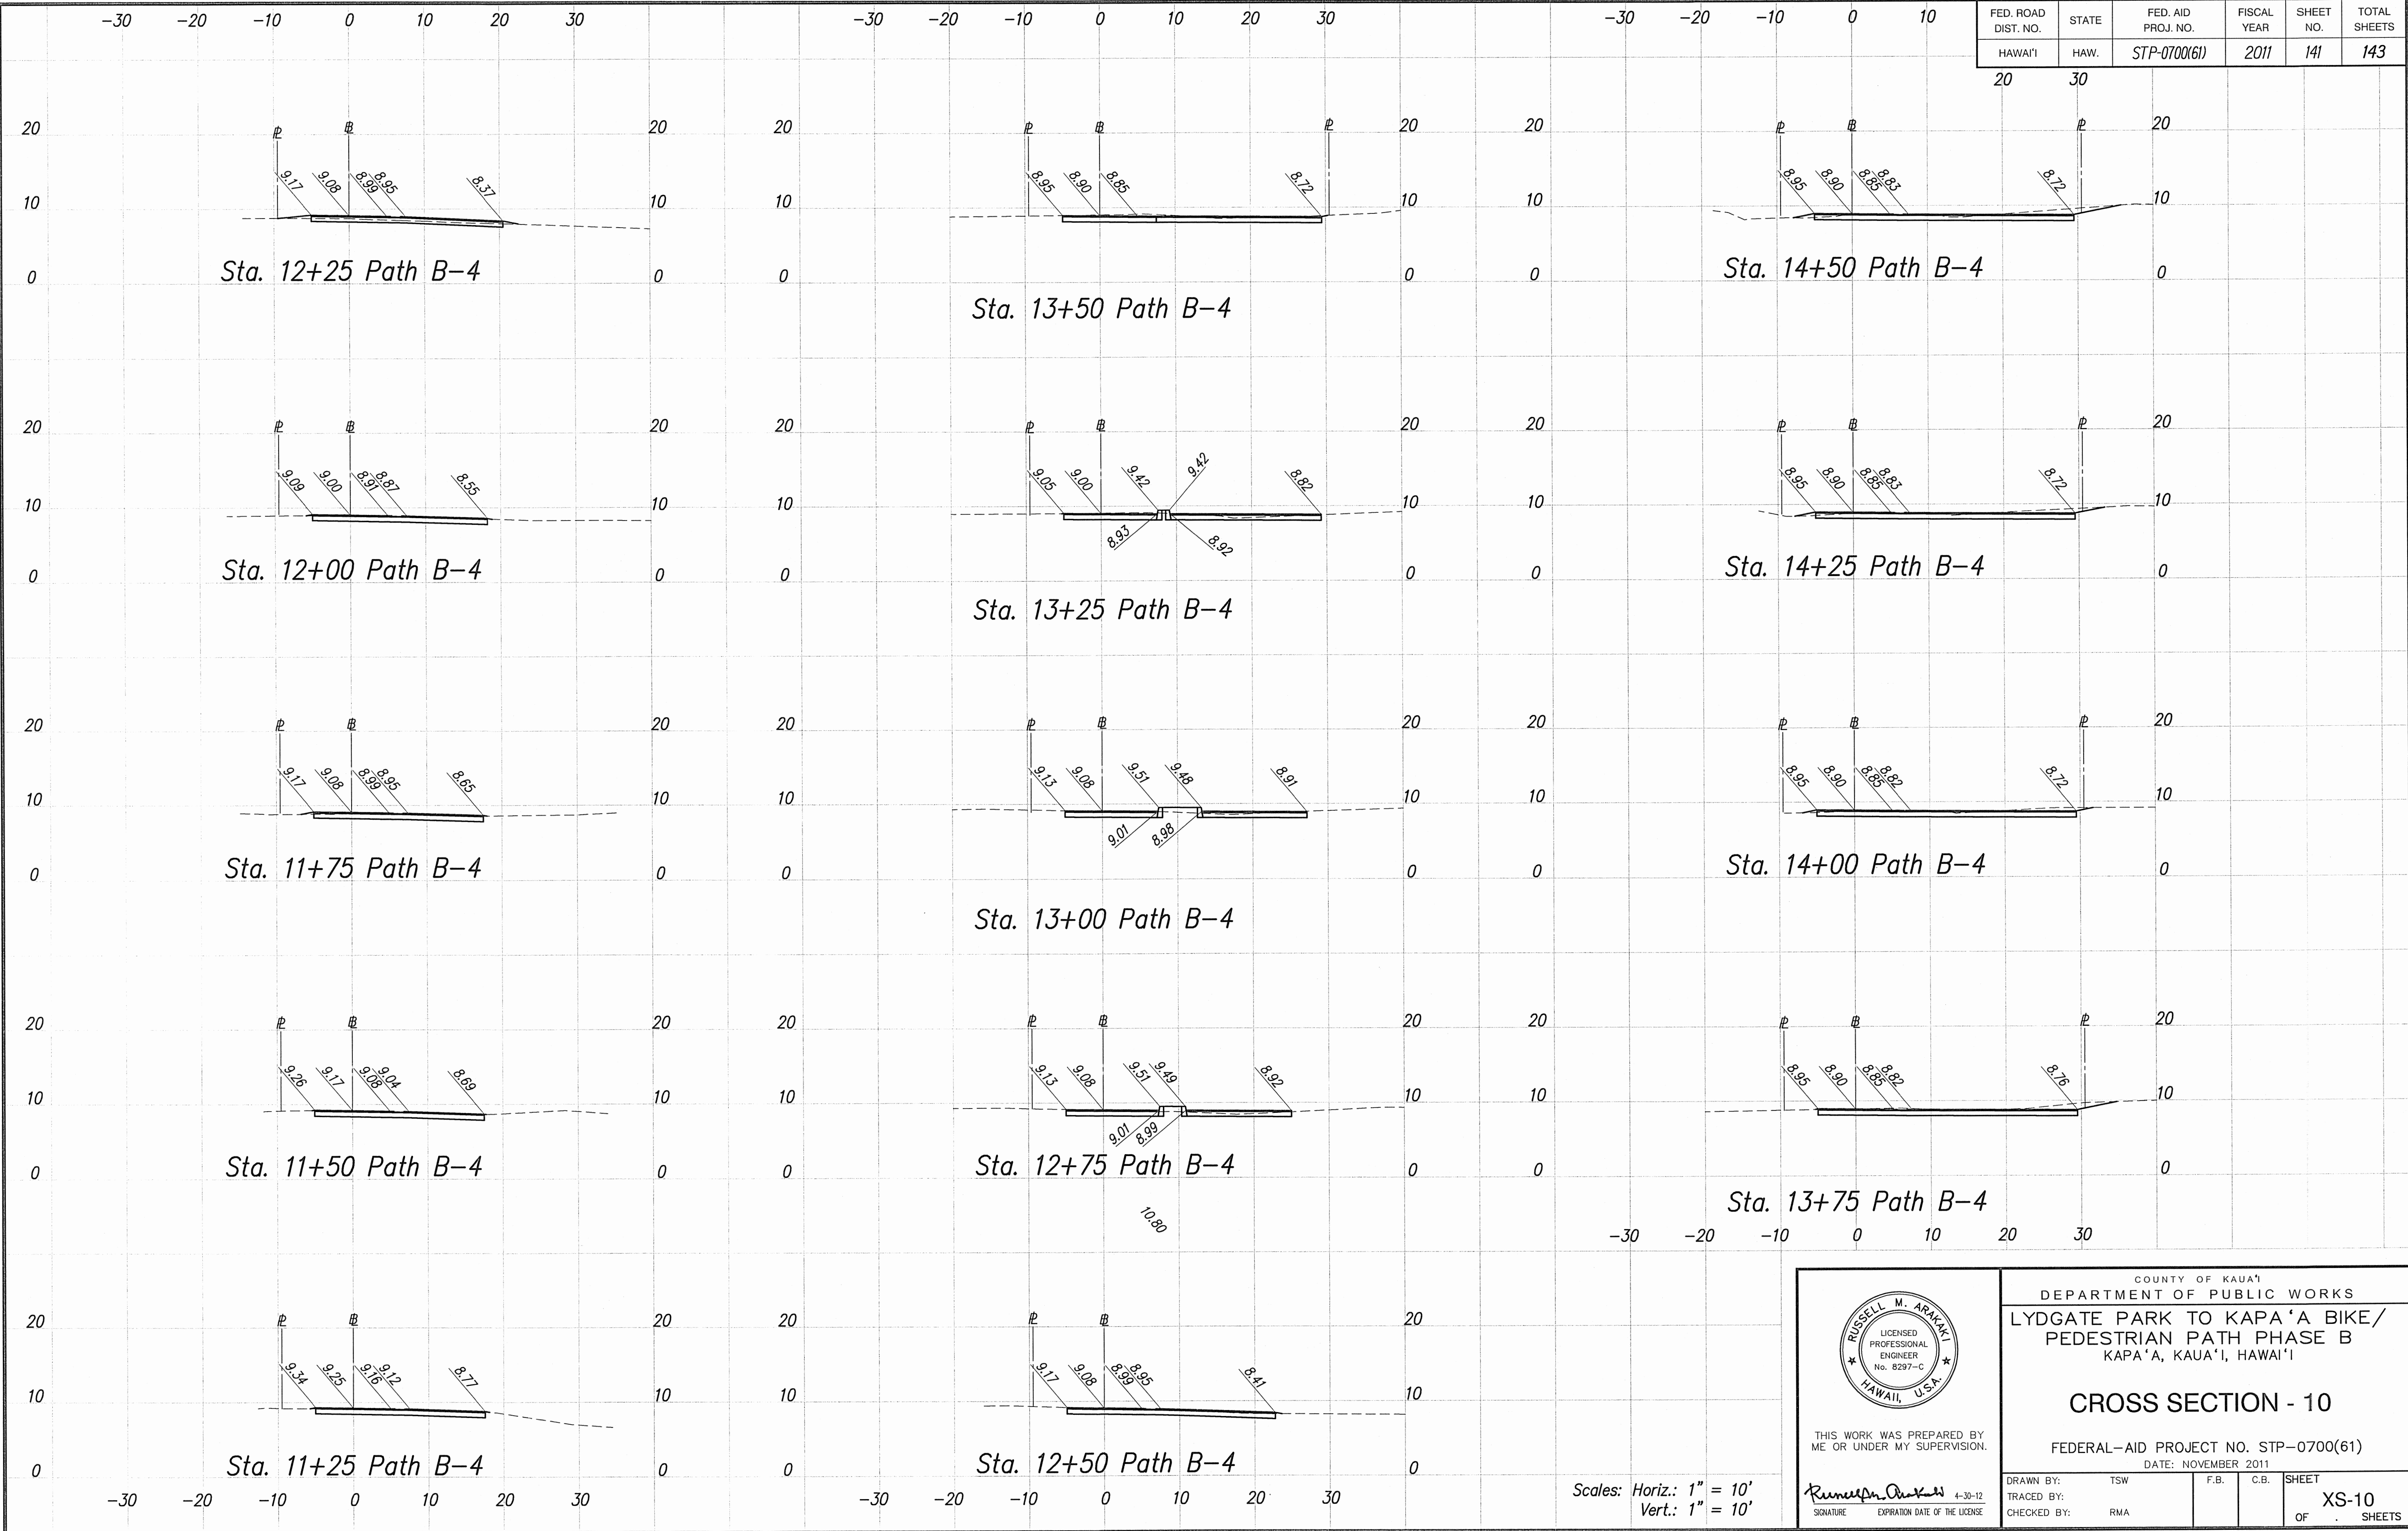

Scales: Horiz.: 1" = 10'
Vert.: 1" = 10'

RUSSELL M. ARAKAKI
LICENSED PROFESSIONAL ENGINEER
No. 8297-C
HAWAII, U.S.A.

THIS WORK WAS PREPARED BY ME OR UNDER MY SUPERVISION.

Russell M. Arakaki
SIGNATURE

4-30-12
EXPIRATION DATE OF THE LICENSE

COUNTY OF KAUAI
DEPARTMENT OF PUBLIC WORKS
LYDGATE PARK TO KAPA'A BIKE/
PEDESTRIAN PATH PHASE B
KAPA'A, KAUAI, HAWAII



CROSS SECTION - 10

FEDERAL-AID PROJECT NO. STP-0700(61)
DATE: NOVEMBER 2011

DRAWN BY:	TSW	F.B.	C.B.	SHEET
TRACED BY:				XS-10
CHECKED BY:	RMA			OF SHEETS

"AS-BUILT"

FED. ROAD DIST. NO.	STATE	FED. AID PROJ. NO.	FISCAL YEAR	SHEET NO.	TOTAL SHEETS
HAWAII	HAW.	STP-0700(61)	2011	142	143

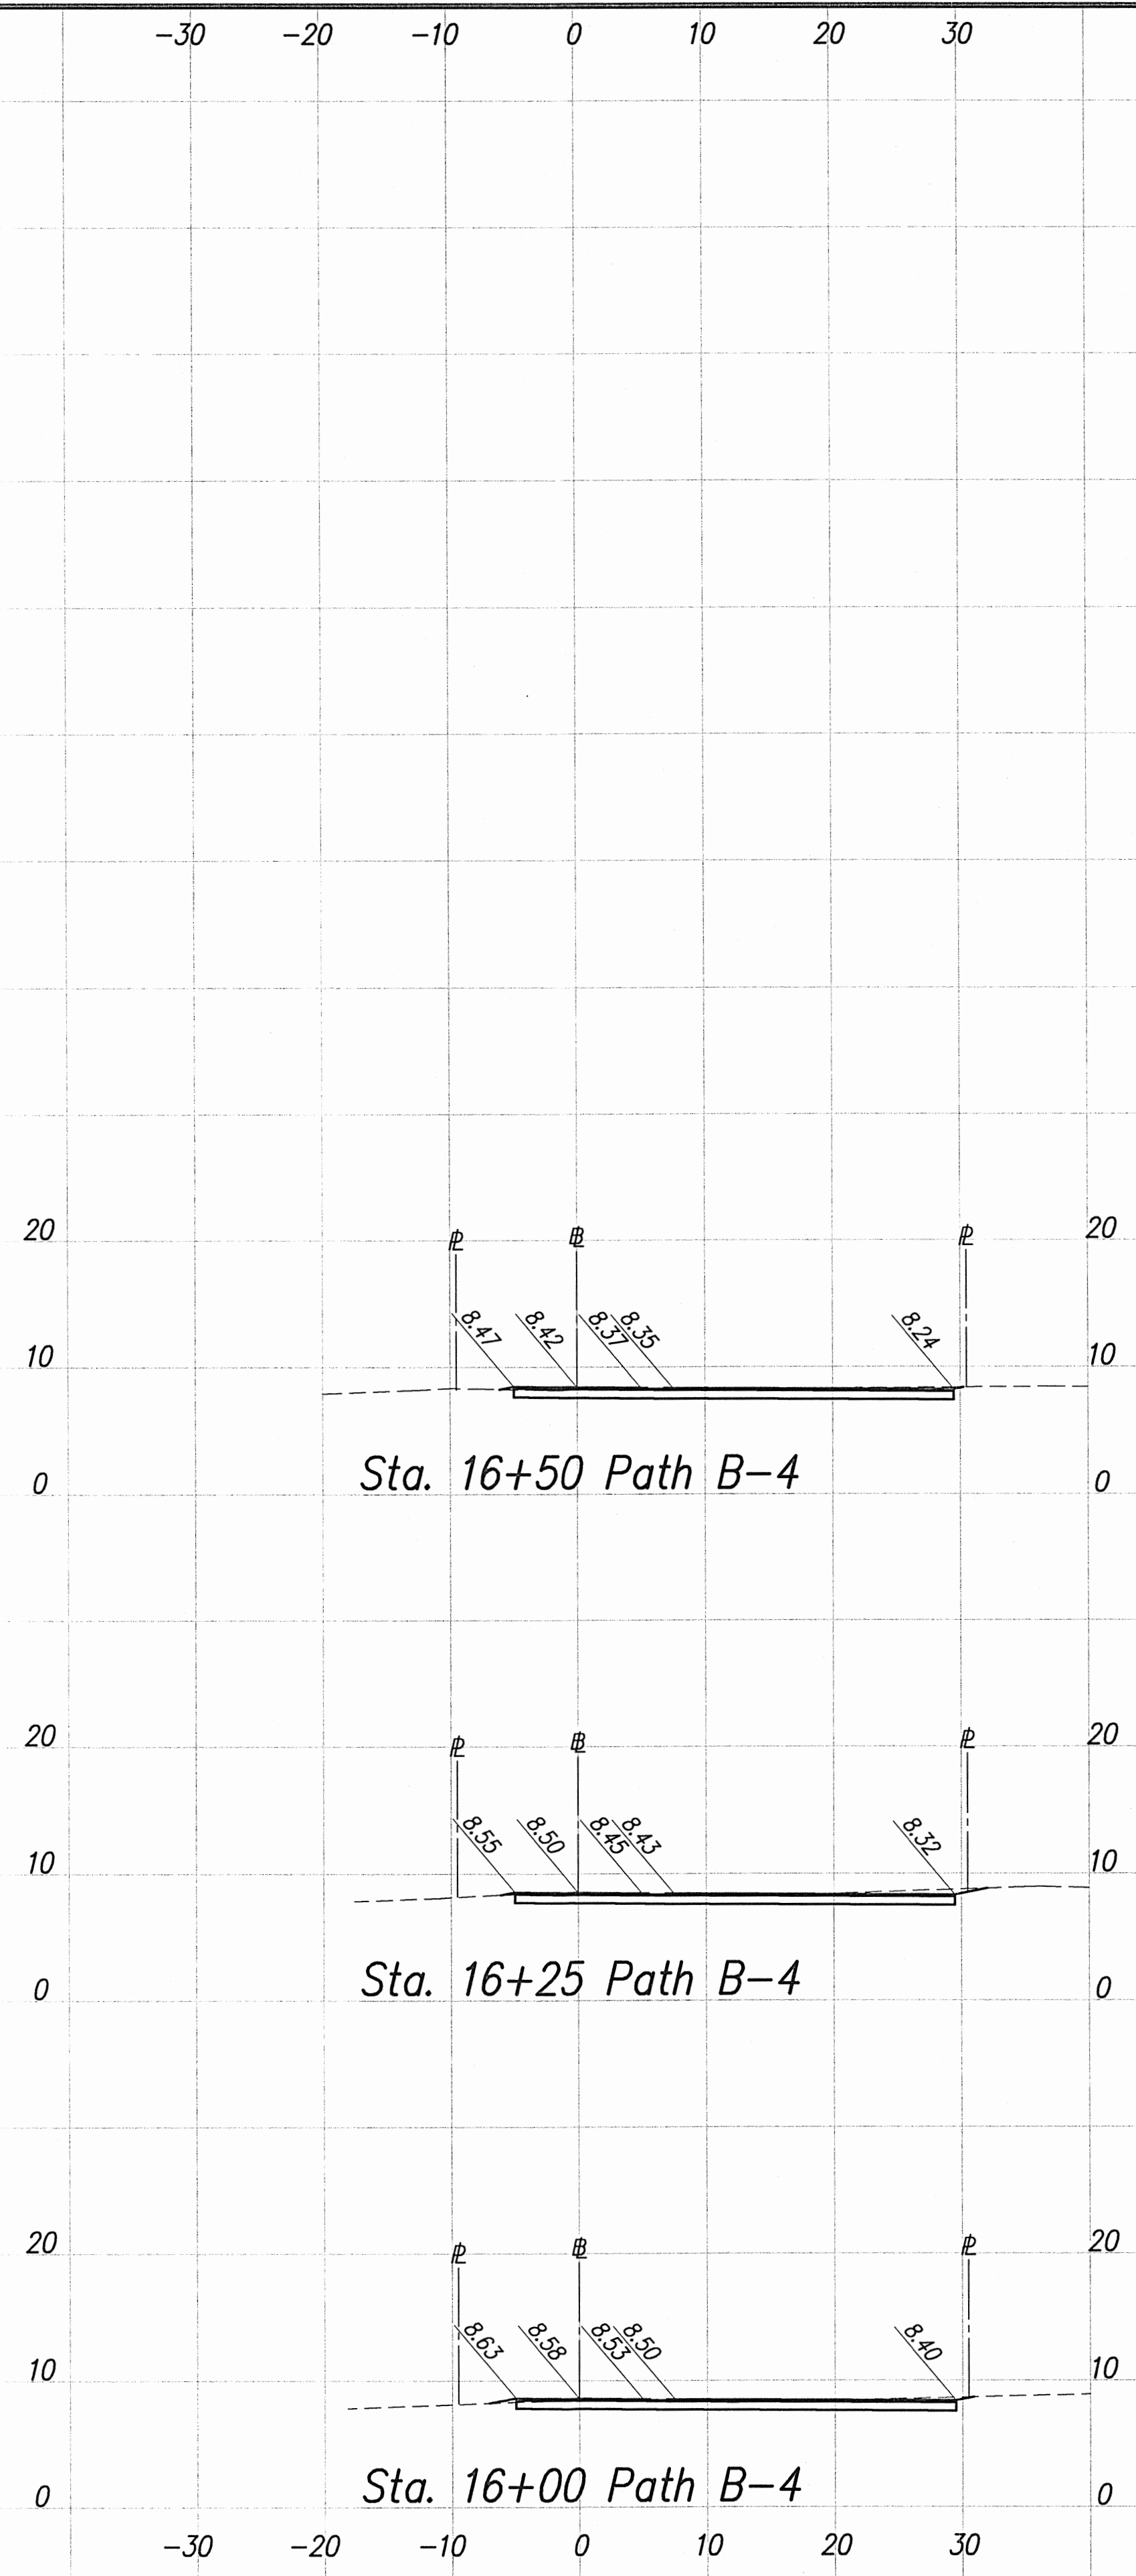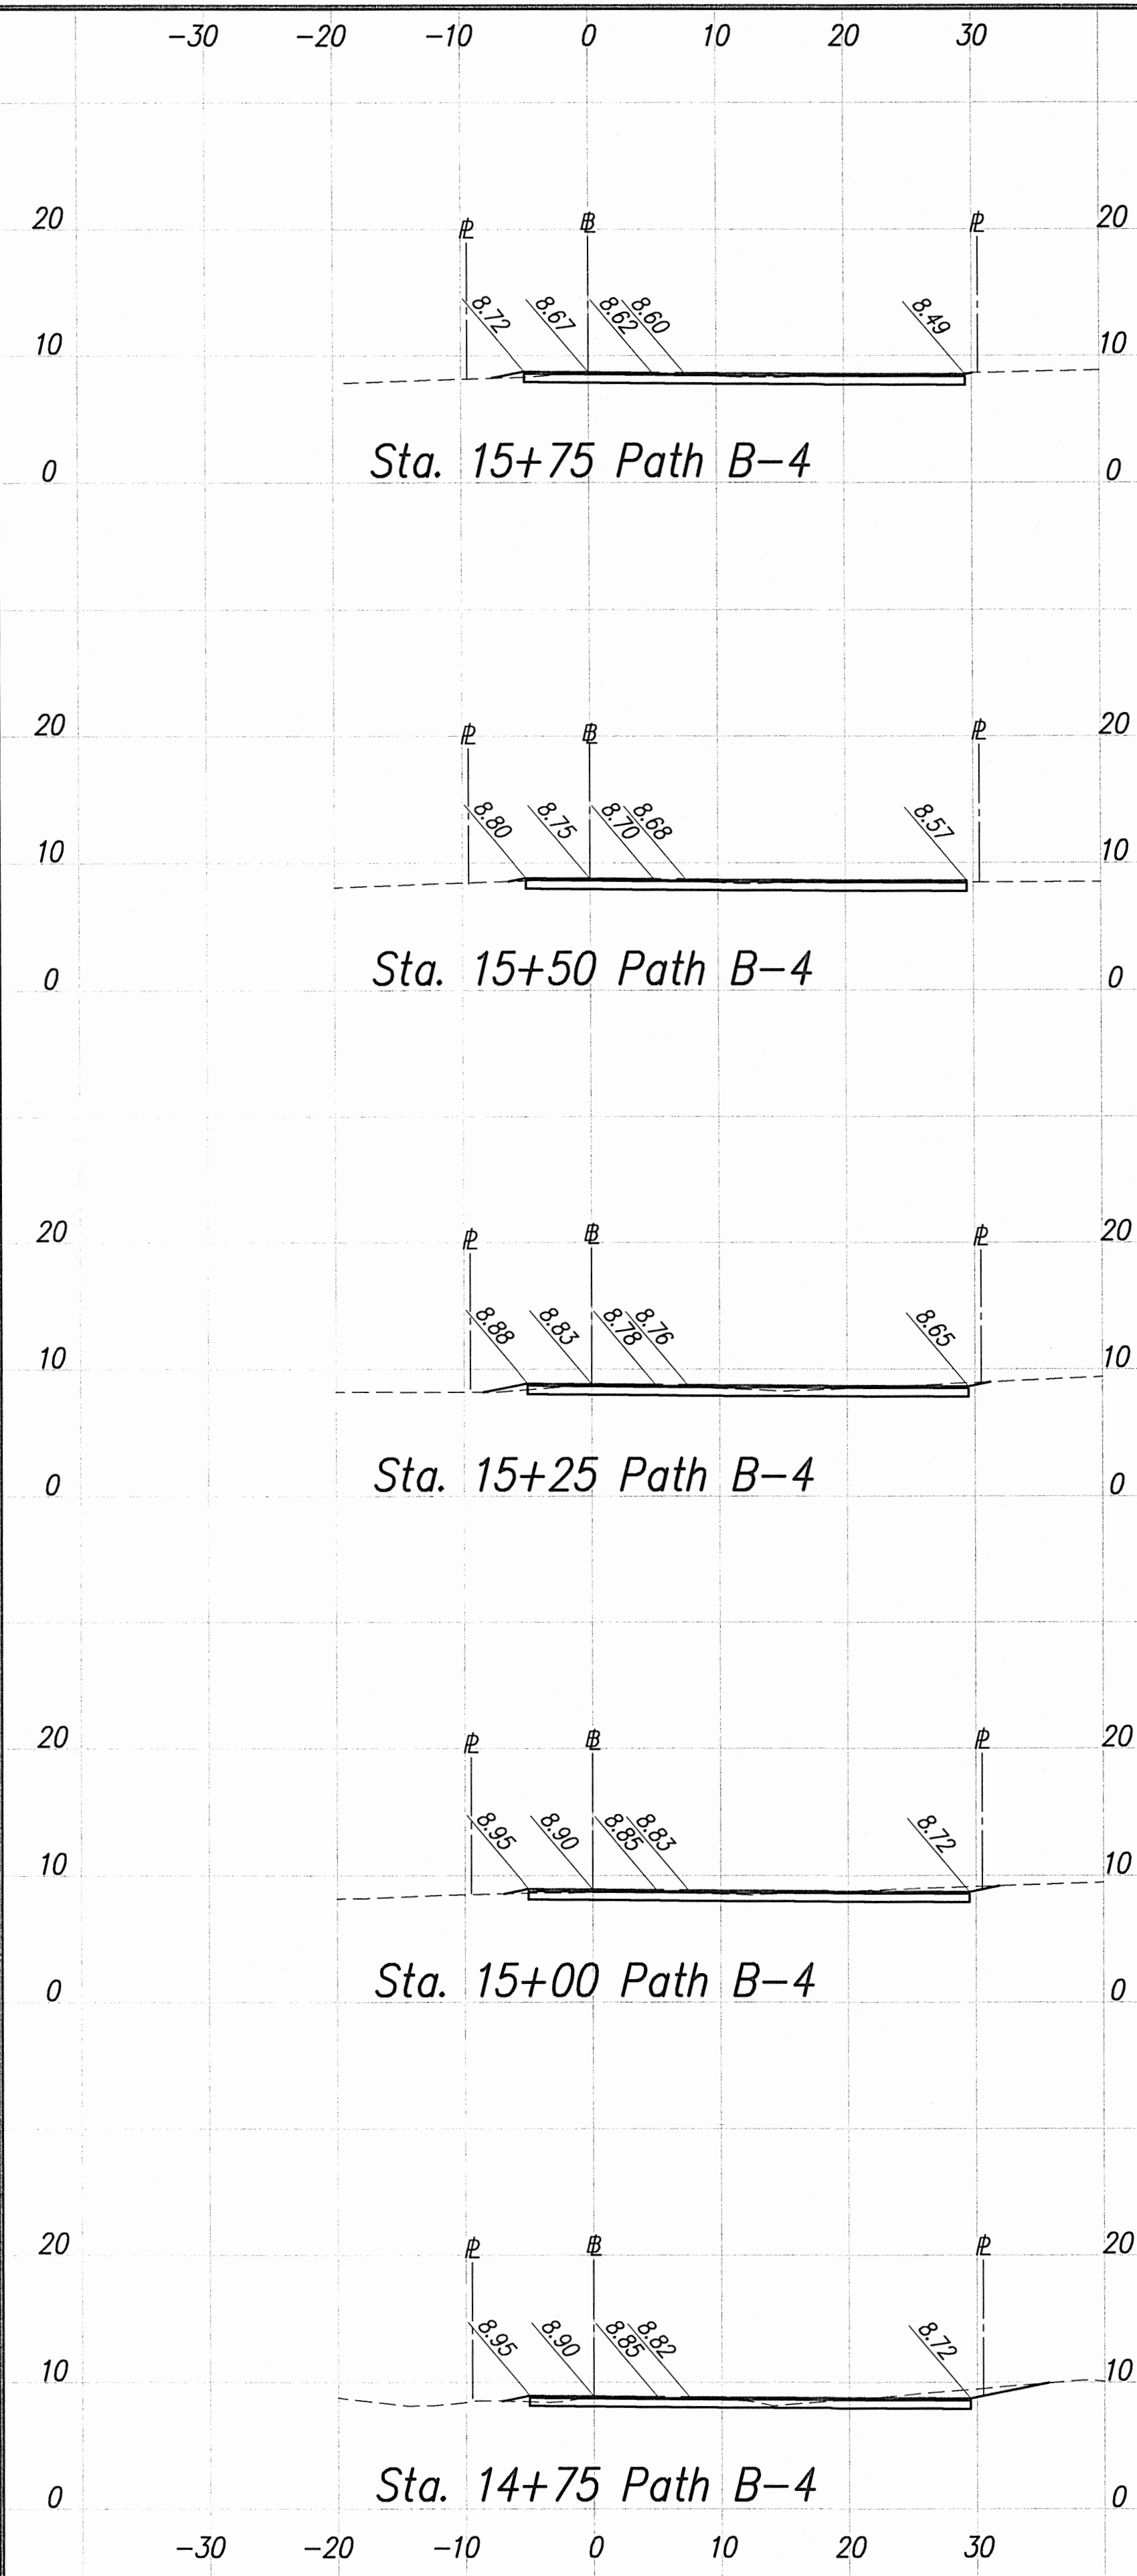

Scales: Horiz.: 1" = 10'
Vert.: 1" = 10'

THIS WORK WAS PREPARED BY
ME OR UNDER MY SUPERVISION.

Russell M. Araki
SIGNATURE 4-30-12
EXPIRATION DATE OF THE LICENSE


COUNTY OF KAUAI
DEPARTMENT OF PUBLIC WORKS
LYDGATE PARK TO KAPA'A BIKE/
PEDESTRIAN PATH PHASE B
KAPA'A, KAUAI, HAWAII

CROSS SECTION - 11

FEDERAL-AID PROJECT NO. STP-0700(61)
DATE: NOVEMBER 2011

DRAWN BY:	TSW	F.B.	C.B.	SHEET
TRACED BY:				XS-11
CHECKED BY:	RMA			OF SHEETS

FED. ROAD DIST. NO.	STATE	FED. AID PROJ. NO.	FISCAL YEAR	SHEET NO.	TOTAL SHEETS
HAWAII	HAW.	STP-0700(61)	2011	143	143

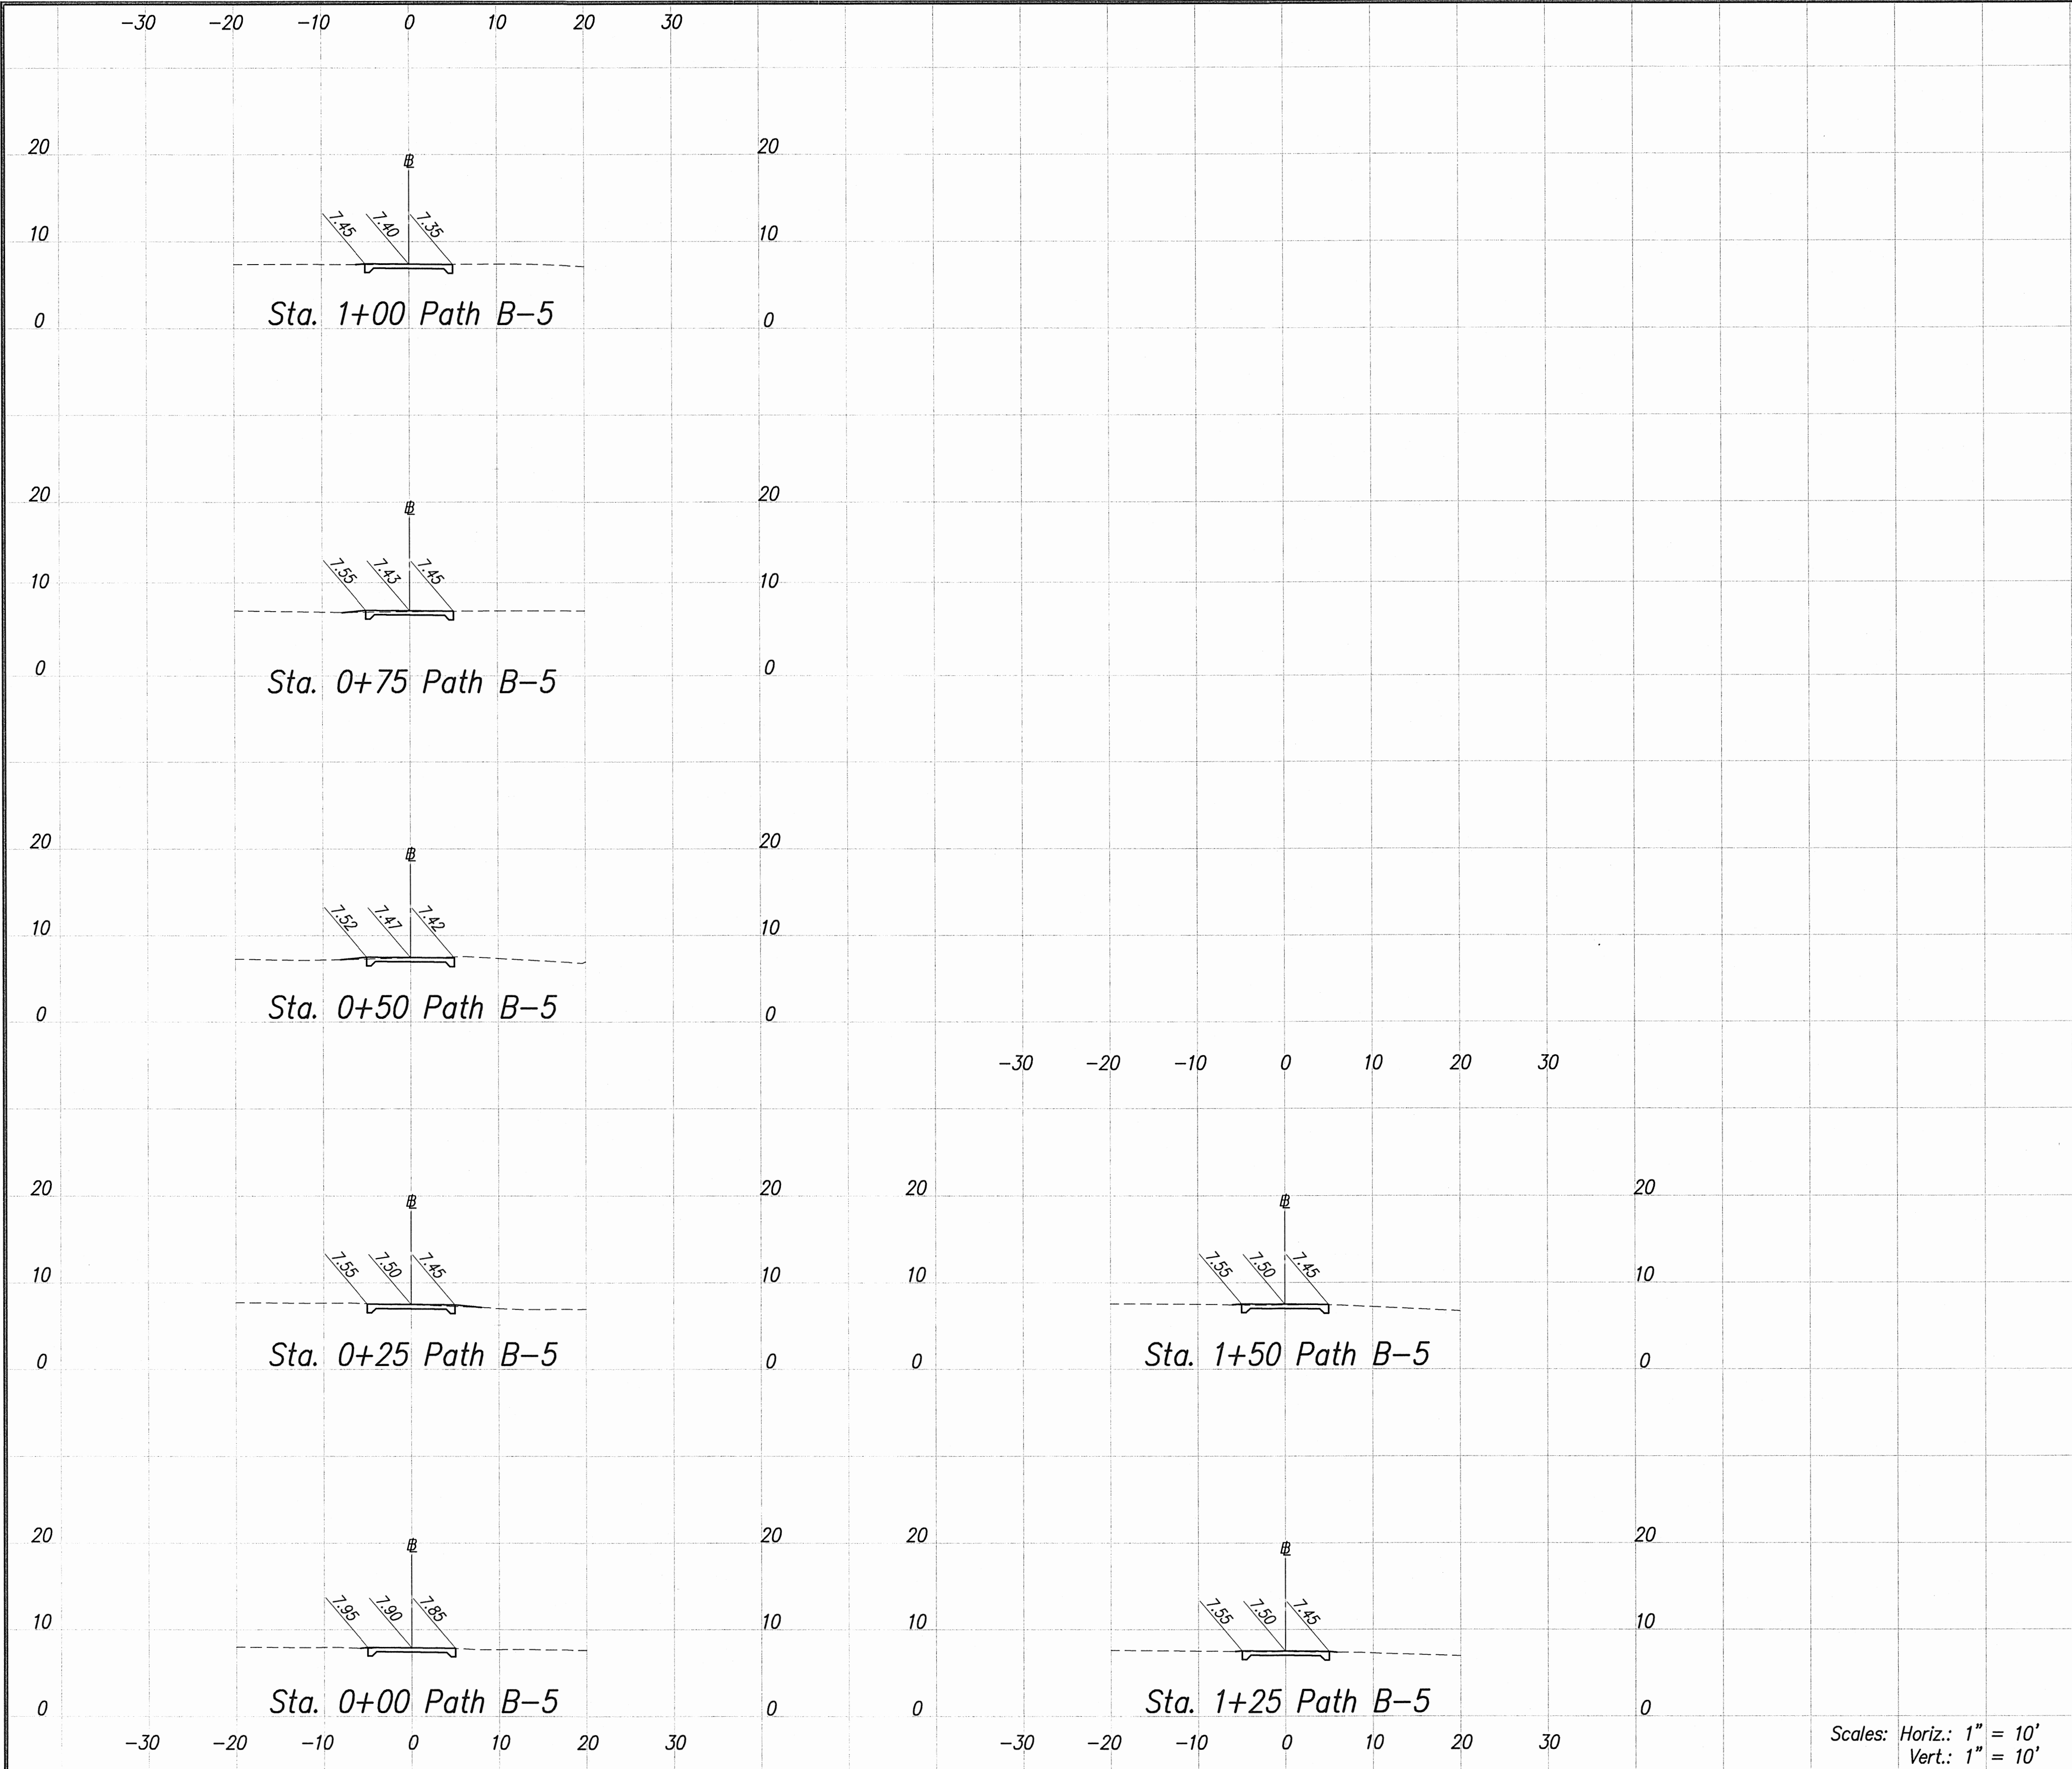

Scales: Horiz.: 1" = 10'
Vert.: 1" = 10'

THIS WORK WAS PREPARED BY ME OR UNDER MY SUPERVISION.

Russell M. Araki 4-30-12
SIGNATURE EXPIRATION DATE OF THE LICENSE

COUNTY OF KAUAI
DEPARTMENT OF PUBLIC WORKS
LYDGATE PARK TO KAPA'A BIKE/
PEDESTRIAN PATH PHASE B
KAPA'A, KAUAI, HAWAII

CROSS SECTION - 12

FEDERAL-AID PROJECT NO. STP-0700(61)
DATE: NOVEMBER 2011

DRAWN BY:	TSW	F.B.	C.B.	SHEET
TRACED BY:				XS-12
CHECKED BY:	RMA			OF SHEETS