
UNDEX TO DRAWINGS					
SHEET NO.	DESCRIPTION				
	THE SHEET				
	STANDARD PLANS SUMMARY				
·	CIMILINOTES				
£ 15	GENERAL PLAN				
16 - 19	TYPICAL SECTIONS				
20 - 26	ROADWAY AND BIKE PATH DETAILS				
27 - 35	EXISTING CONDITIONS				
36 44	PATH PLAN AND PROFILE				
45 54, 52S-1	ENLARGEMENT PLANS				
55	CURB RAMP DETAILS				
57	DRAINAGE PLAN, PROFILE AND DETAILS				
65 68	WATER LINE PLAN, PROFILE AND DETAILS				
69 - 78	UTILITY PLAN AND DETAILS				
79 – 88 , 825-1	STRIPING AND SIGNING PLAN AND DETAILS				
89 - 103	CONSTRUCTION PHASING PLANS				
104 - 108	LANDSCAPING PLANS				
109	BRIDGE ID SIGN				
110 - 125 S-1	STRUCTURAL PLANS				
126	CEOTECHNICAL PLANS				
132 143	CROSS SECTIONS				

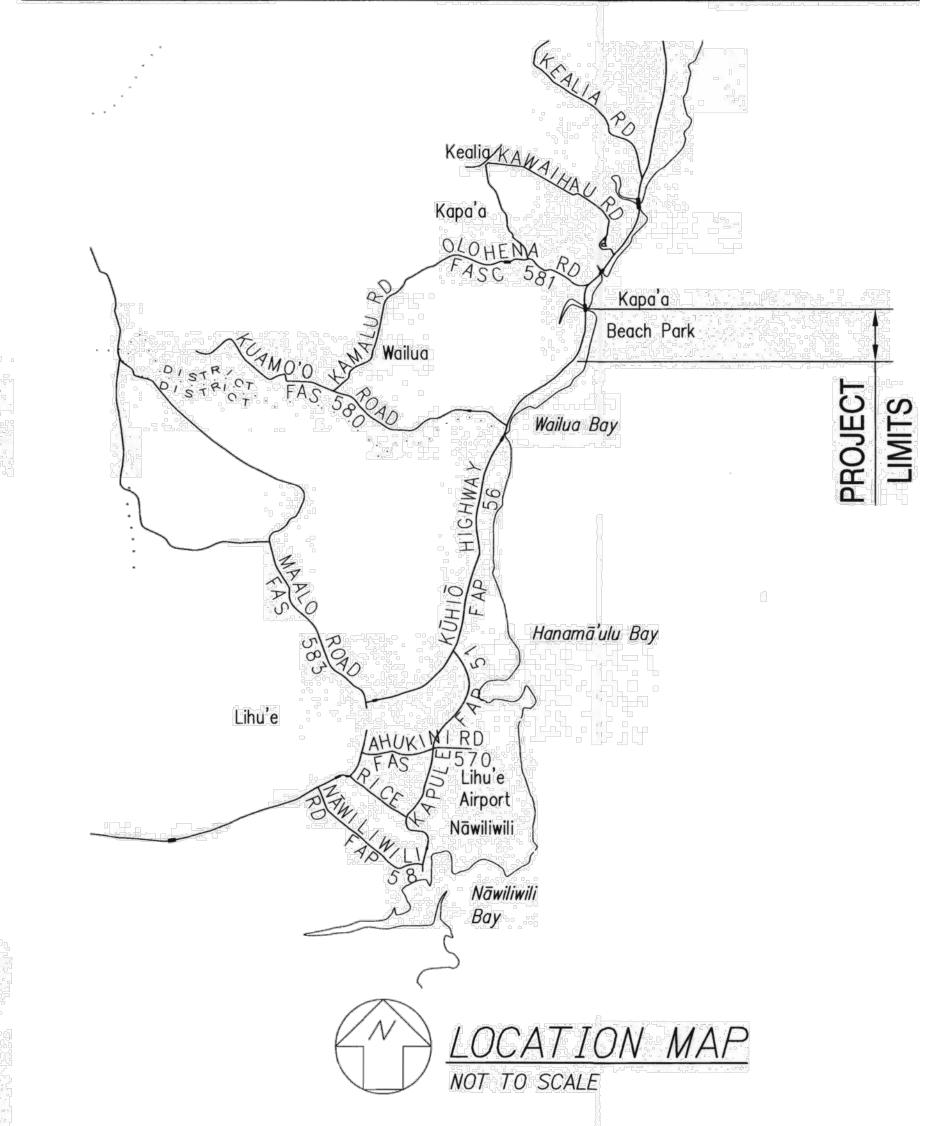

"AS-BUILT"
PLANSFORTHE


	FED ROAD DIST NO.	STATE	PROJ.NO.	FISCAL	SHEET	TOTAL	
.5 .% 	HAWAII	HAW.	STP-0700(61)	2011		143° -	1AS


LYDEATE PARK TO KAPAA BIKE TO PEDESTRIAN PATH PHASE B


DISTRICT OF KAWAIHAU, KAUA'I, HAWAI'I

FEDERAL-AID PROJECT NO. STP-0700(61)

Prepared for: County of Kaua'i

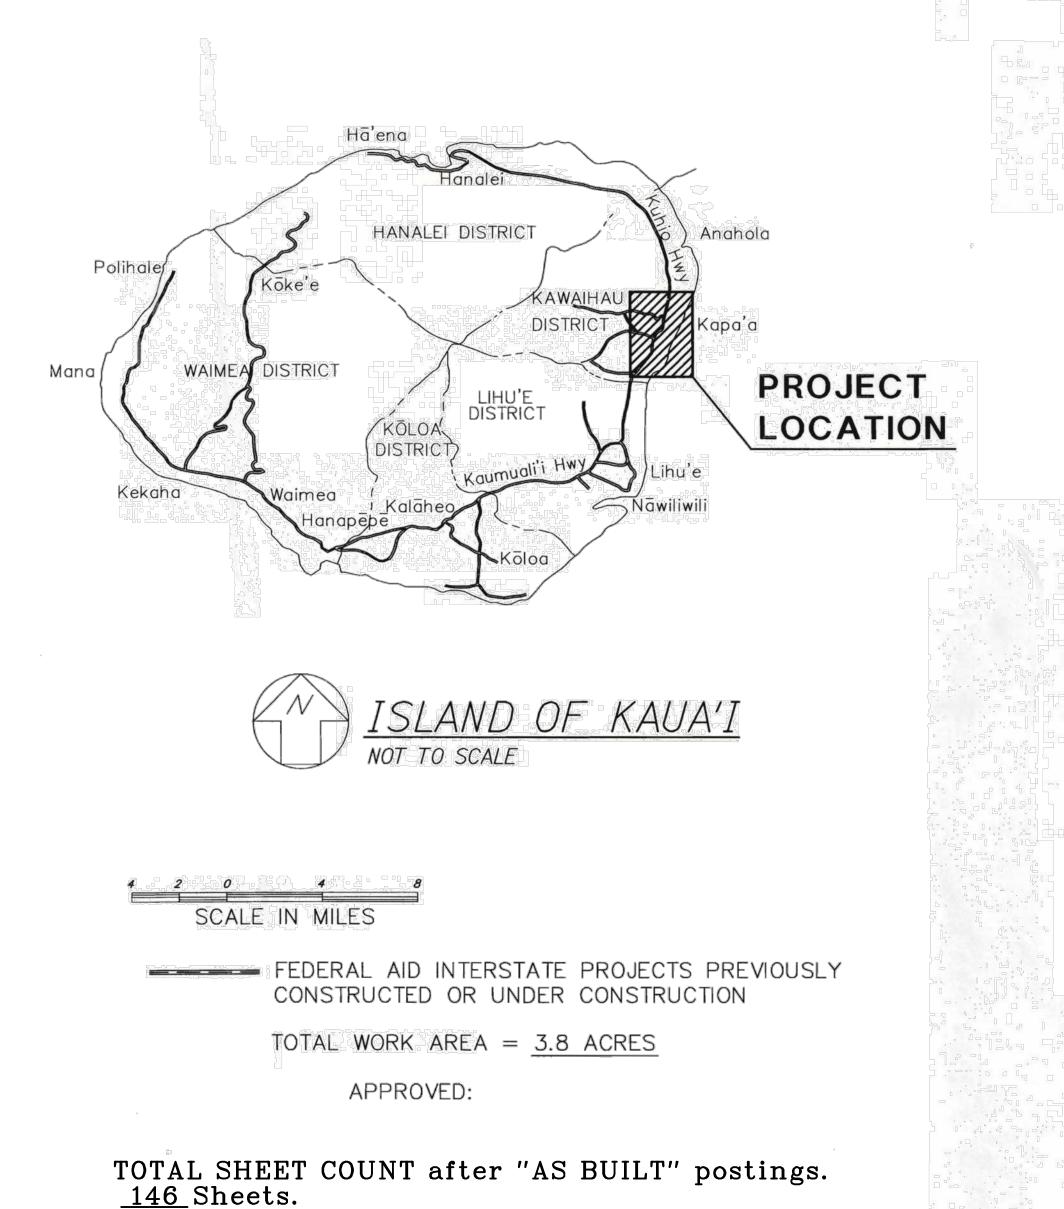

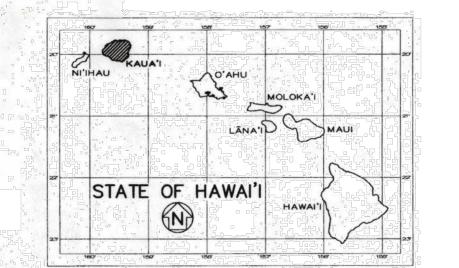

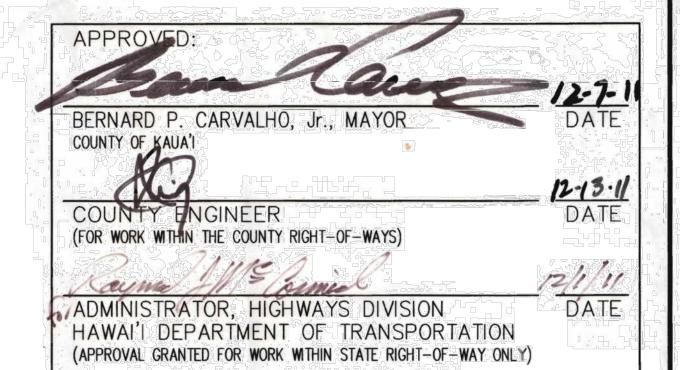

DEPARTMENT OF KAUAU O

TITLE SHEET

FEDERAL AID PROJECT NO. STP-0700(61)

DATE: NOVEMBER 2011

DRAWN BY:

F.B. C.B. SHEET

TRACED BY:

T-1. SHEETS