



FED. ROAD DIST. NO.	STATE	FED. AID PROJ. NO.	FISCAL YEAR	SHEET NO.	TOTAL SHEETS
HAWAII	HAW.	STP-0700(61)	2011	16	143


- Abbreviations:**
- ⊕ Baseline of Shared Use Path
 - R/W Right-of-Way
 - ⊕ Property Line
 - E.P. Edge of Pavement
 - L.G. Limits of Grading

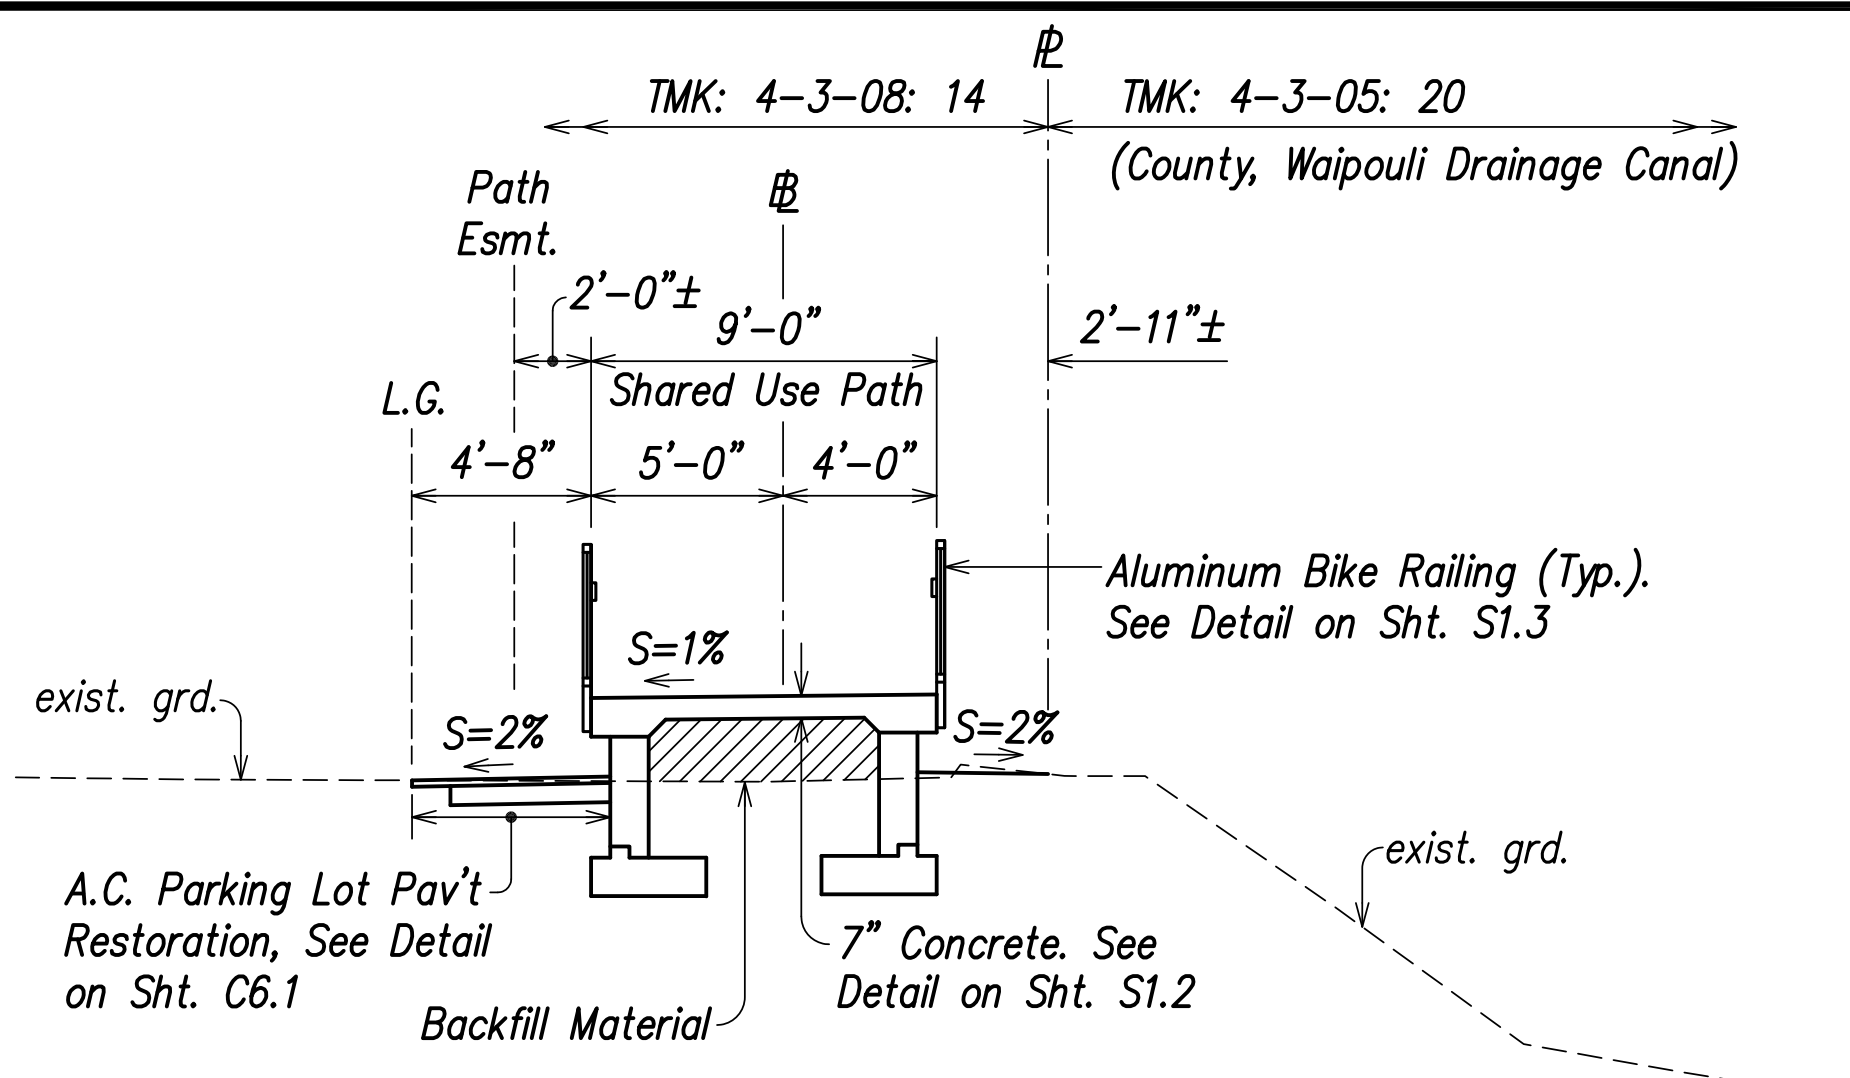


⊕ Sta. 0+01.5± to ⊕ Sta. 0+04.47 Path B-1
Scale: 1" = 5'-0"

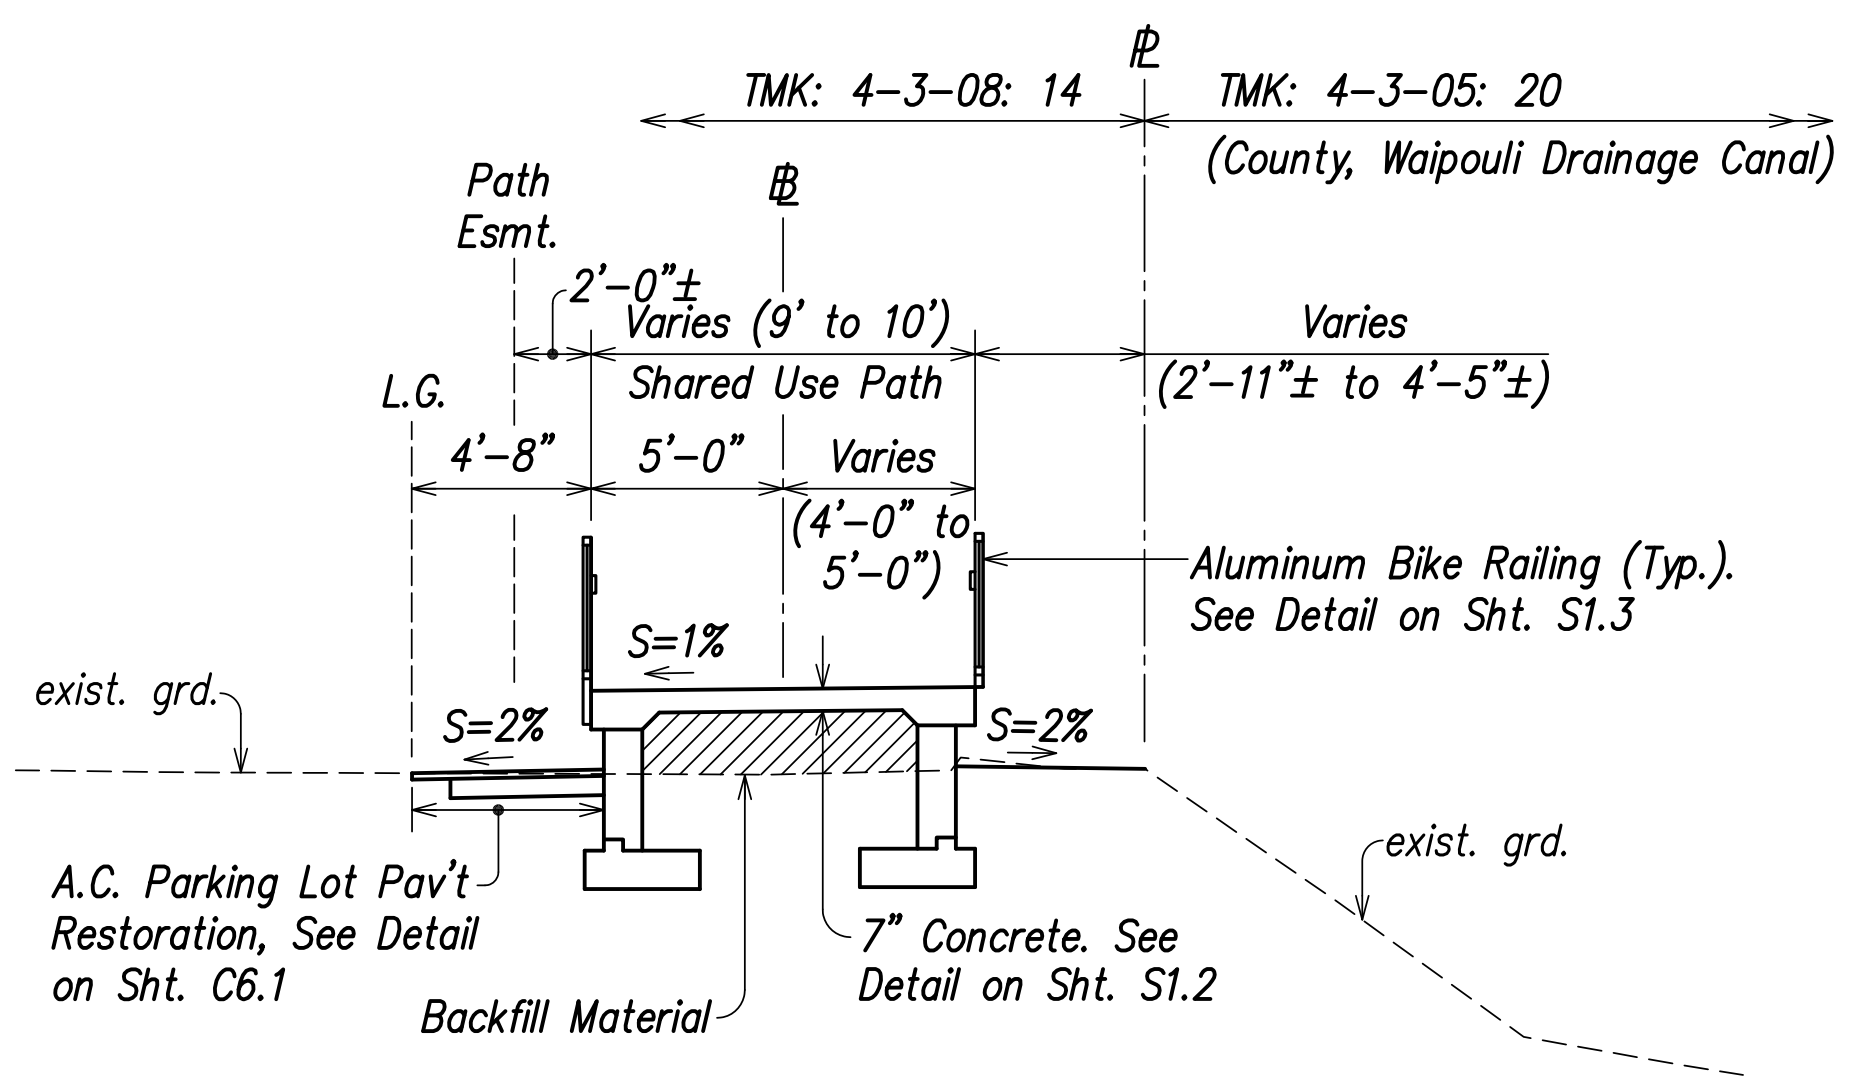


⊕ Sta. 0+04.47± to ⊕ Sta. 0+40 Path B-1
Scale: 1" = 5'-0"

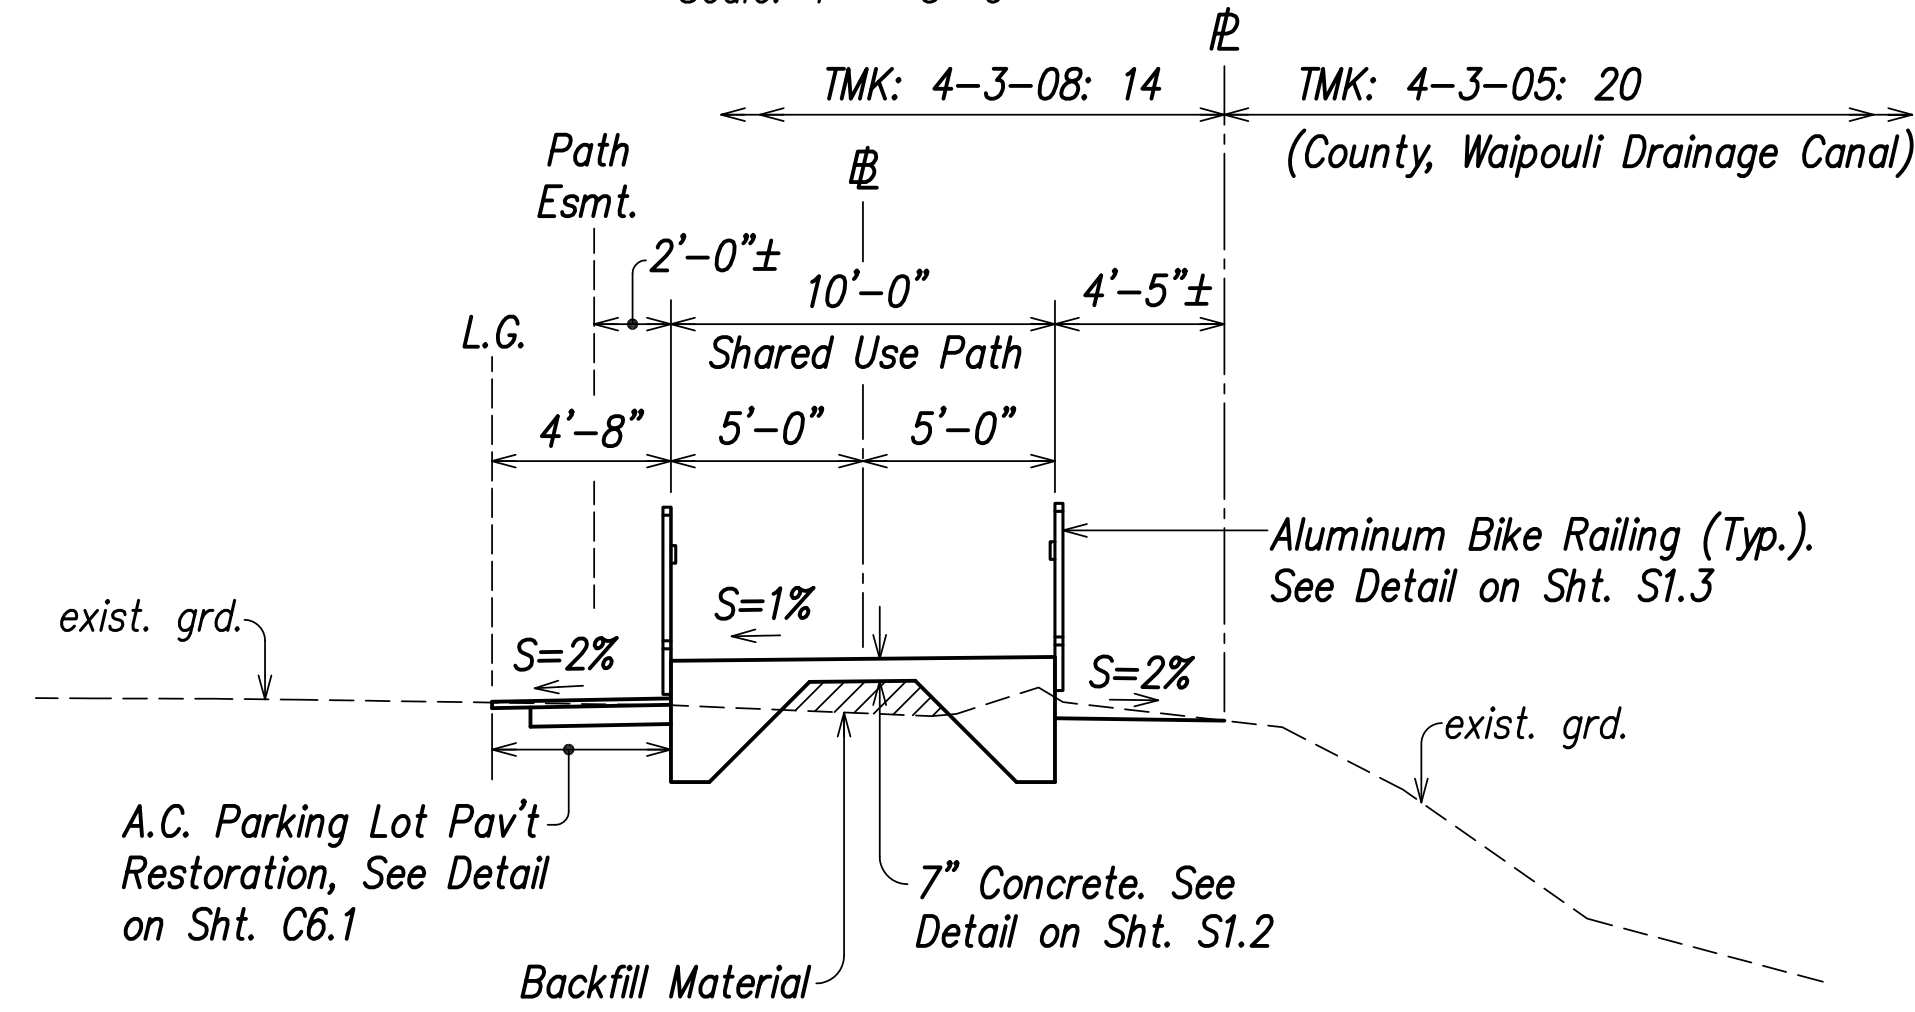


⊕ Sta. 0+40 to ⊕ Sta. 0+70 Path B-1
Scale: 1" = 5'-0"

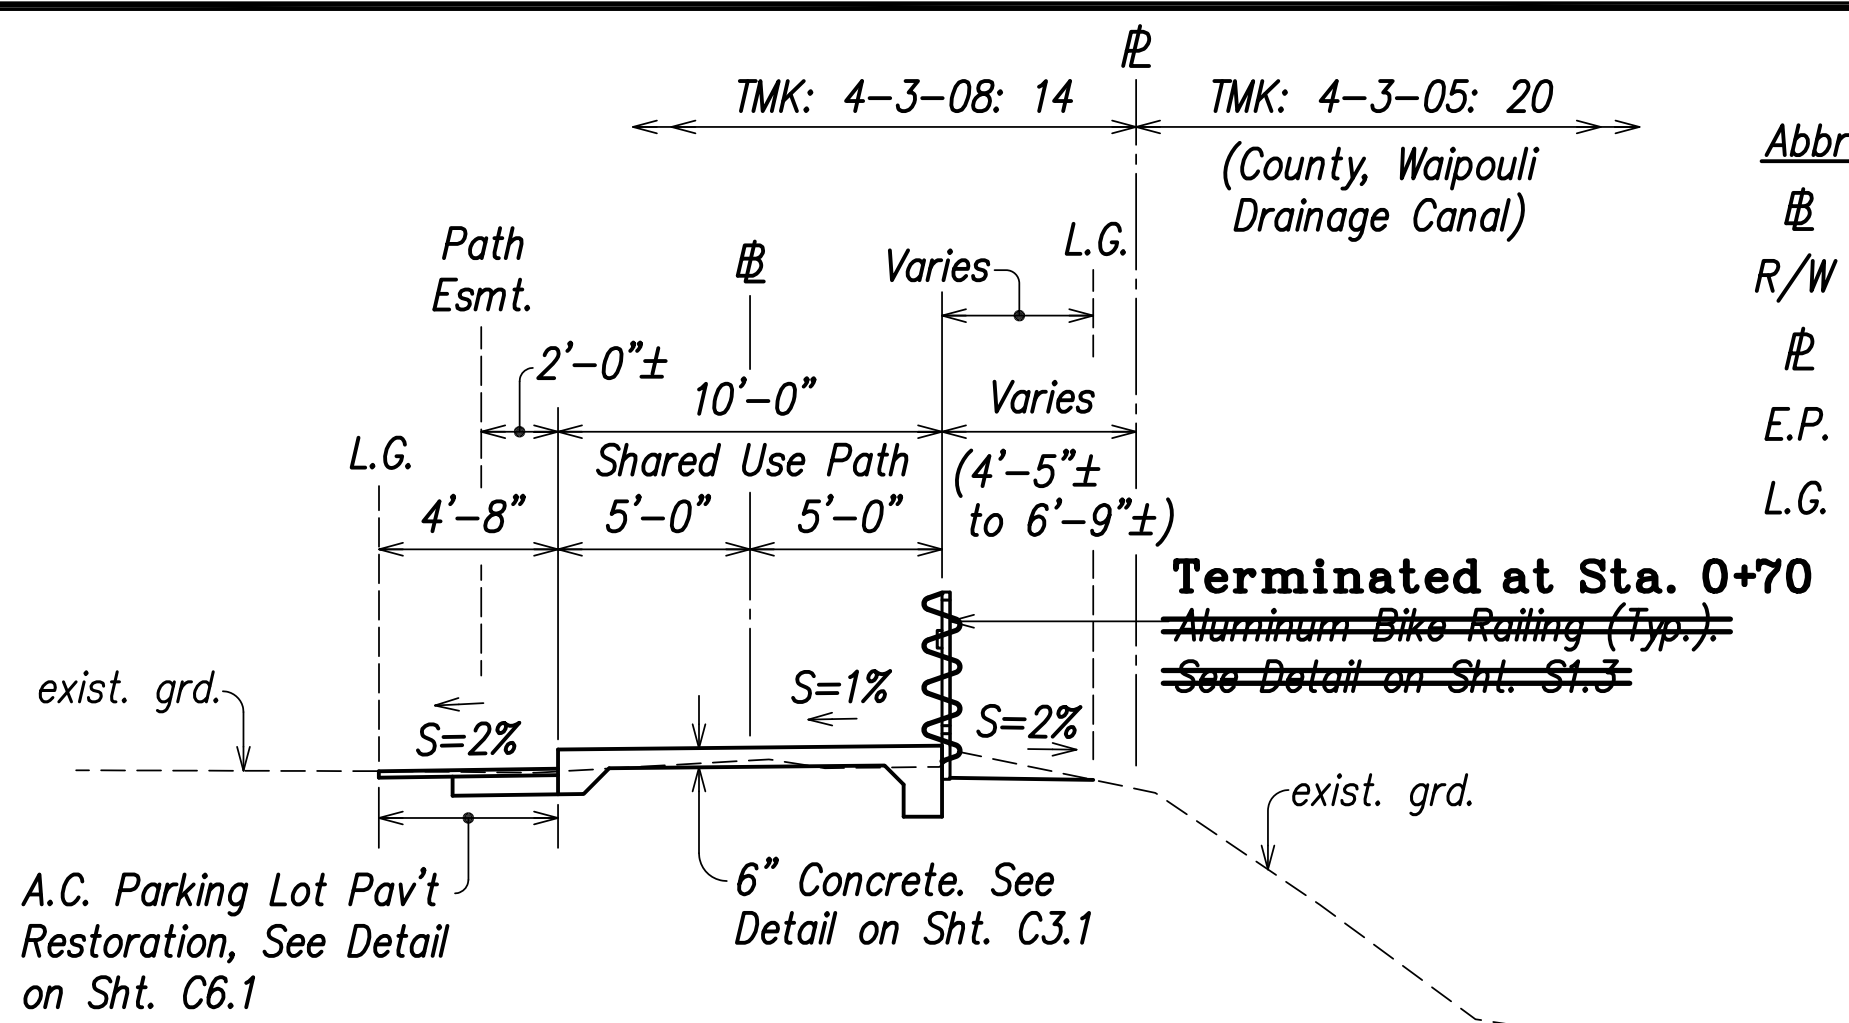


⊕ Sta. 0+70 to ⊕ Sta. 1+22 Path B-1
Scale: 1" = 5'-0"

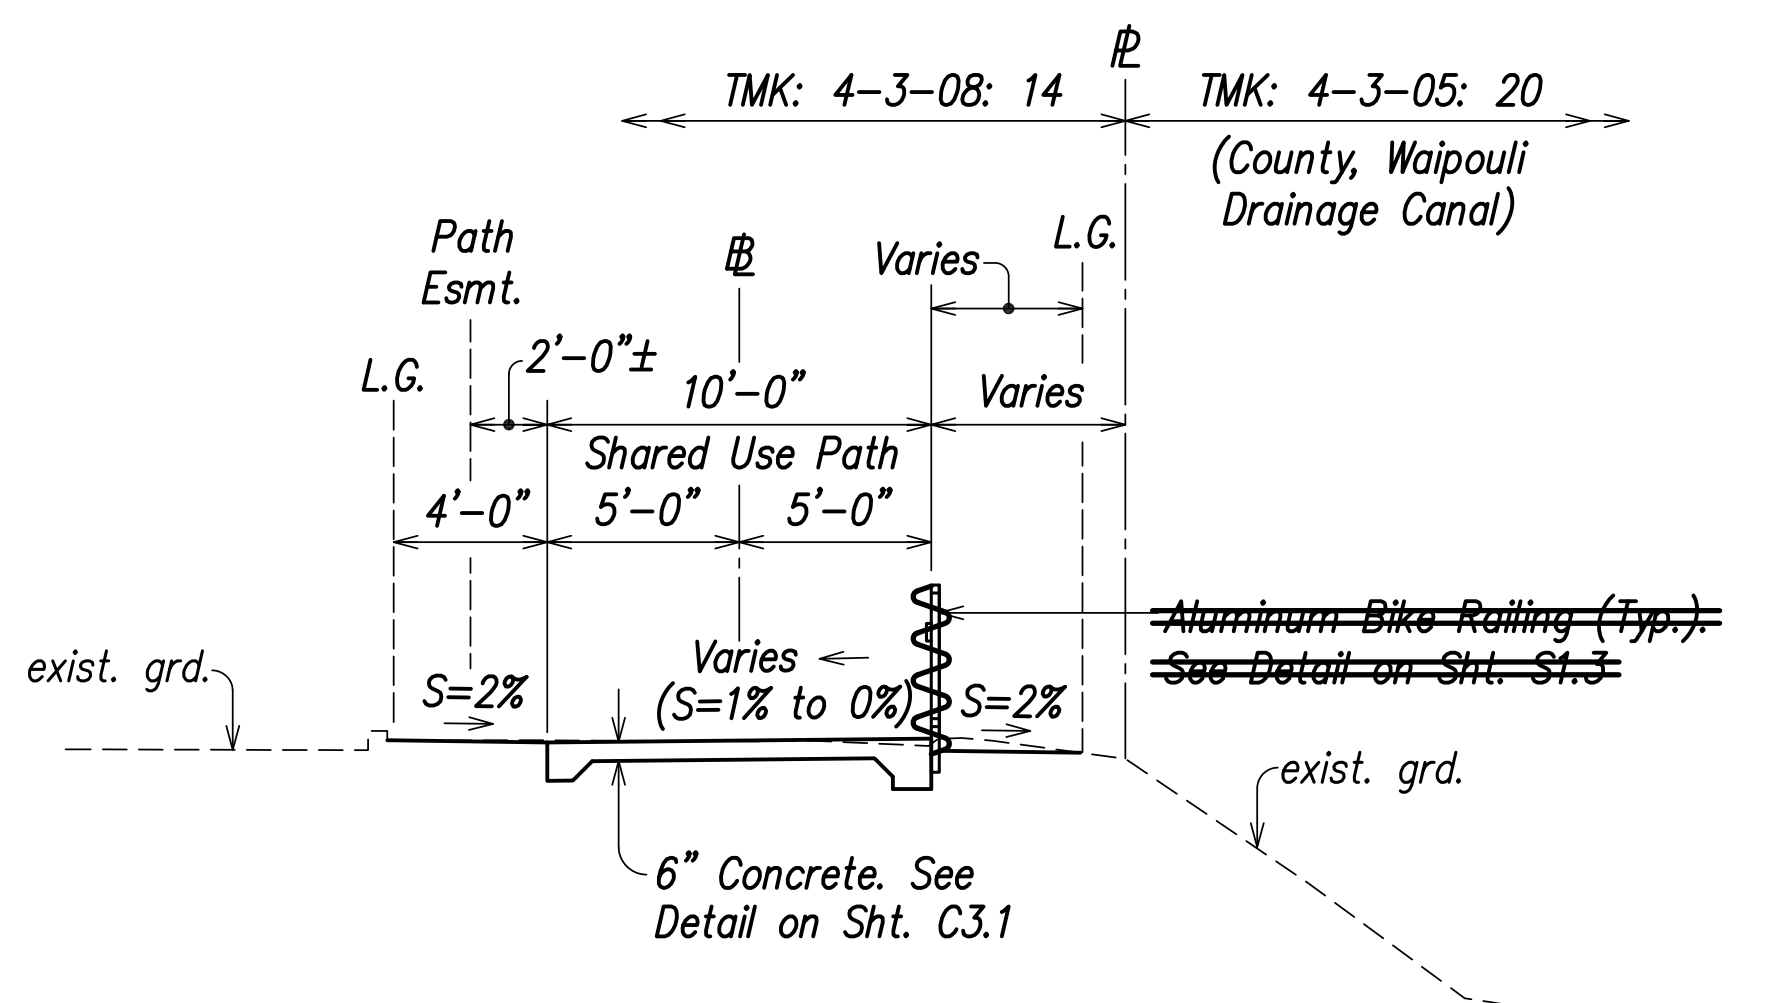


⊕ Sta. 1+22 to ⊕ Sta. 1+37 Path B-1
Scale: 1" = 5'-0"

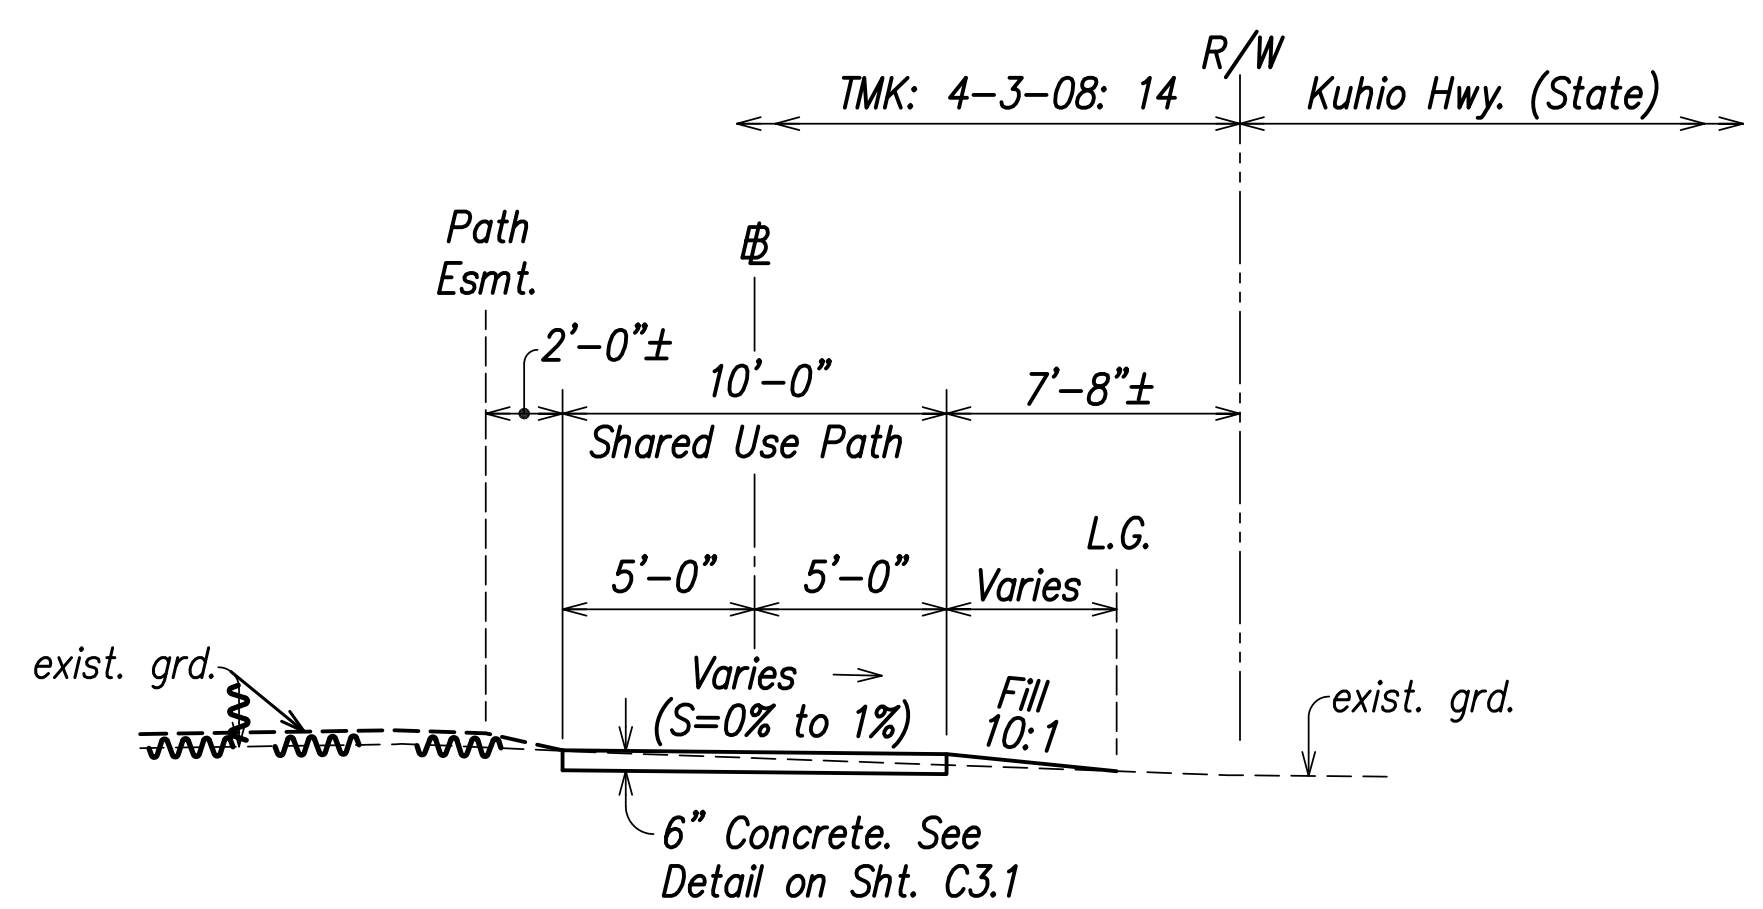

⊕ Sta. 1+37 to ⊕ Sta. 1+67.04 Path B-1
Scale: 1" = 5'-0"

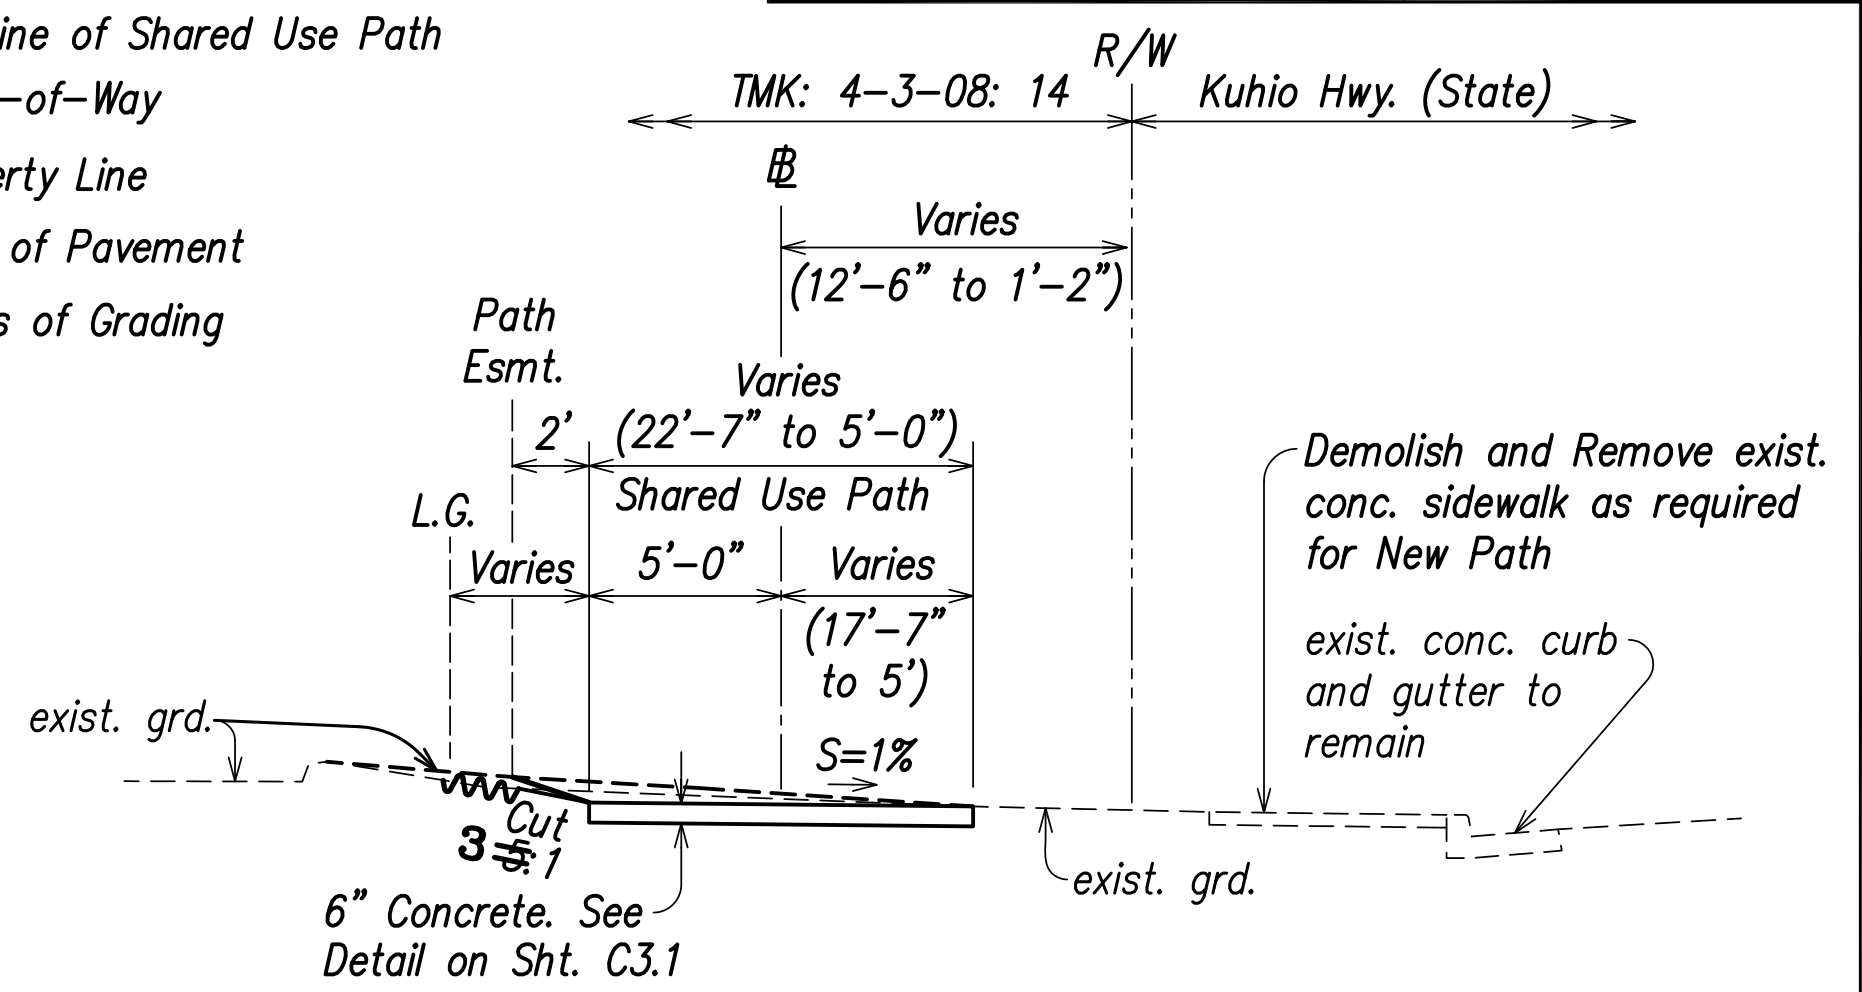

⊕ Sta. 1+67.03 to ⊕ Sta. 2+10.01 Path B-1
Scale: 1" = 5'-0"

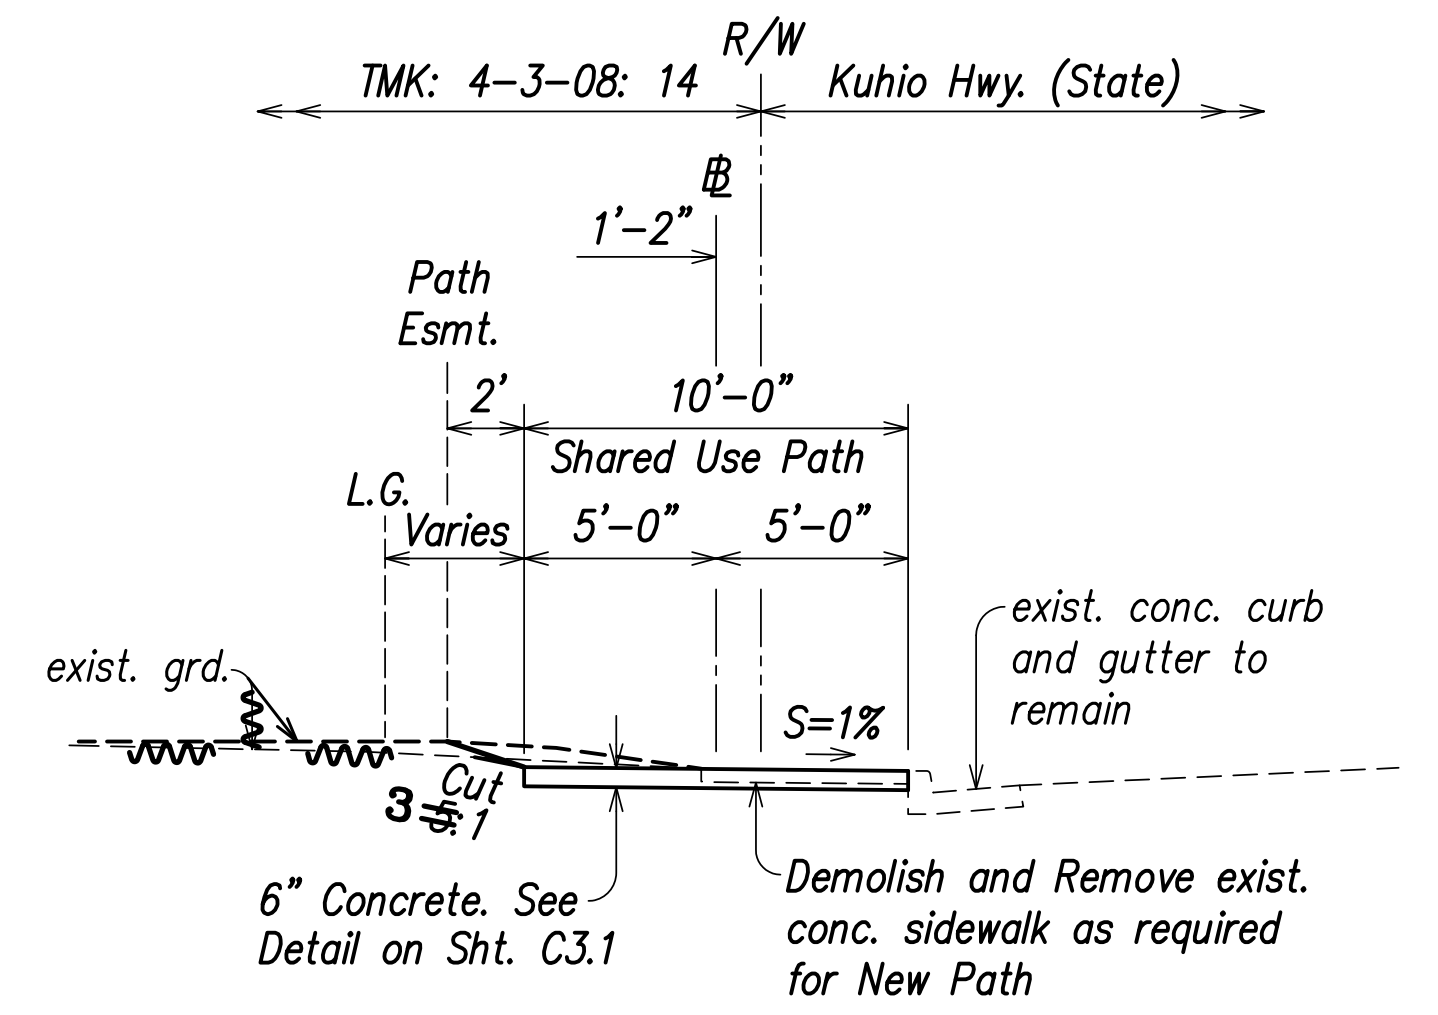

⊕ Sta. 2+10.01 to ⊕ Sta. 2+97.15 Path B-1
Scale: 1" = 5'-0"

LEGEND FOR AS-BUILT POSTINGS	
	Squiggly line for as-built deletion
	Double line for as-built deletion
Roadway	Text for as-built posting

THIS WORK WAS PREPARED BY ME OR UNDER MY SUPERVISION.

Russell M. Arakaki 4-30-14
SIGNATURE EXPIRATION DATE OF THE LICENSE

COUNTY OF KAUAI
DEPARTMENT OF PUBLIC WORKS

LYDGATE PARK TO KAPA'A BIKE/
PEDESTRIAN PATH PHASE B
KAPA'A, KAUAI, HAWAII

TYPICAL SECTIONS - 1


FEDERAL-AID PROJECT NO. STP-0700(61)
DATE: NOVEMBER 2011

DRAWN BY: NGA	F.B.	C.B.	SHEET
TRACED BY: RMA			C2.1
CHECKED BY:			OF SHEETS

Abbreviations:


⌘ Baseline of Shared Use Path
R/W Right-of-Way
⌘ Property Line
E.P. Edge of Pavement
L.G. Limits of Grading

FED. ROAD DIST. NO.	STATE	FED. AID PROJ. NO.	FISCAL YEAR	SHEET NO.	TOTAL SHEETS
HAWAII	HAW.	STP-0700(61)	2011	17	143

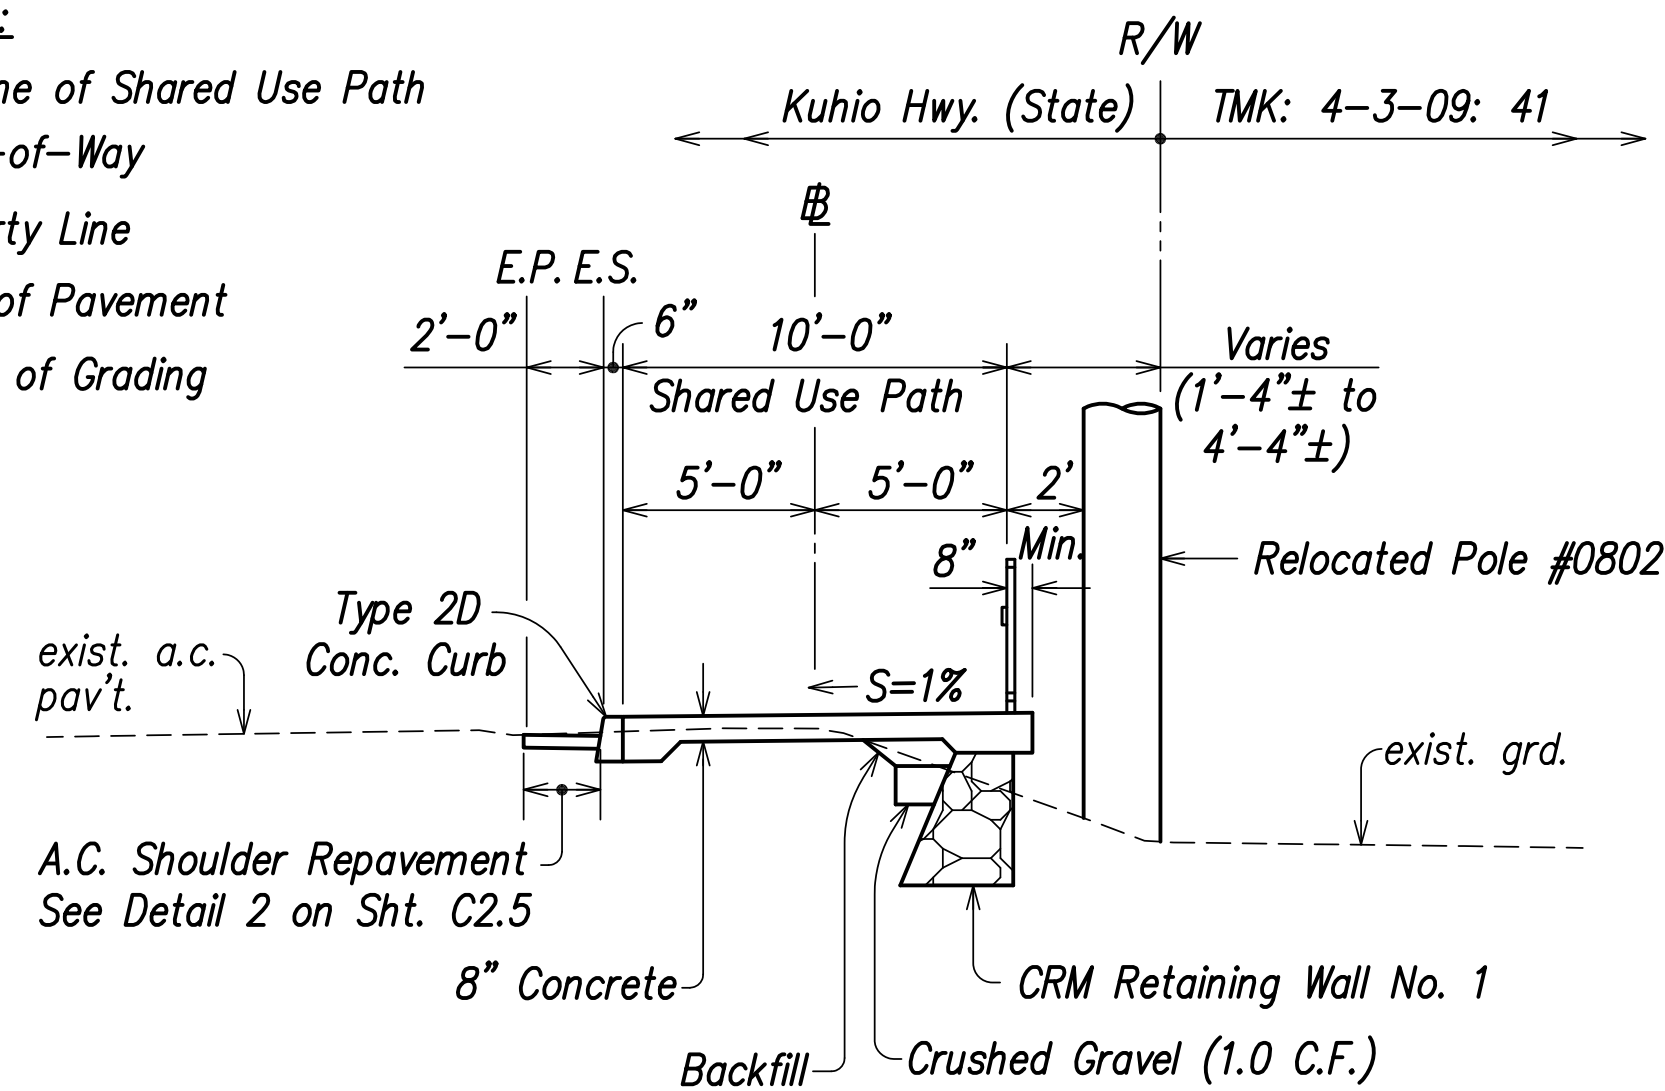


Sta. 0+00 to Sta. 0+79.15 Path B-2

Scale: 1" = 5'-0"

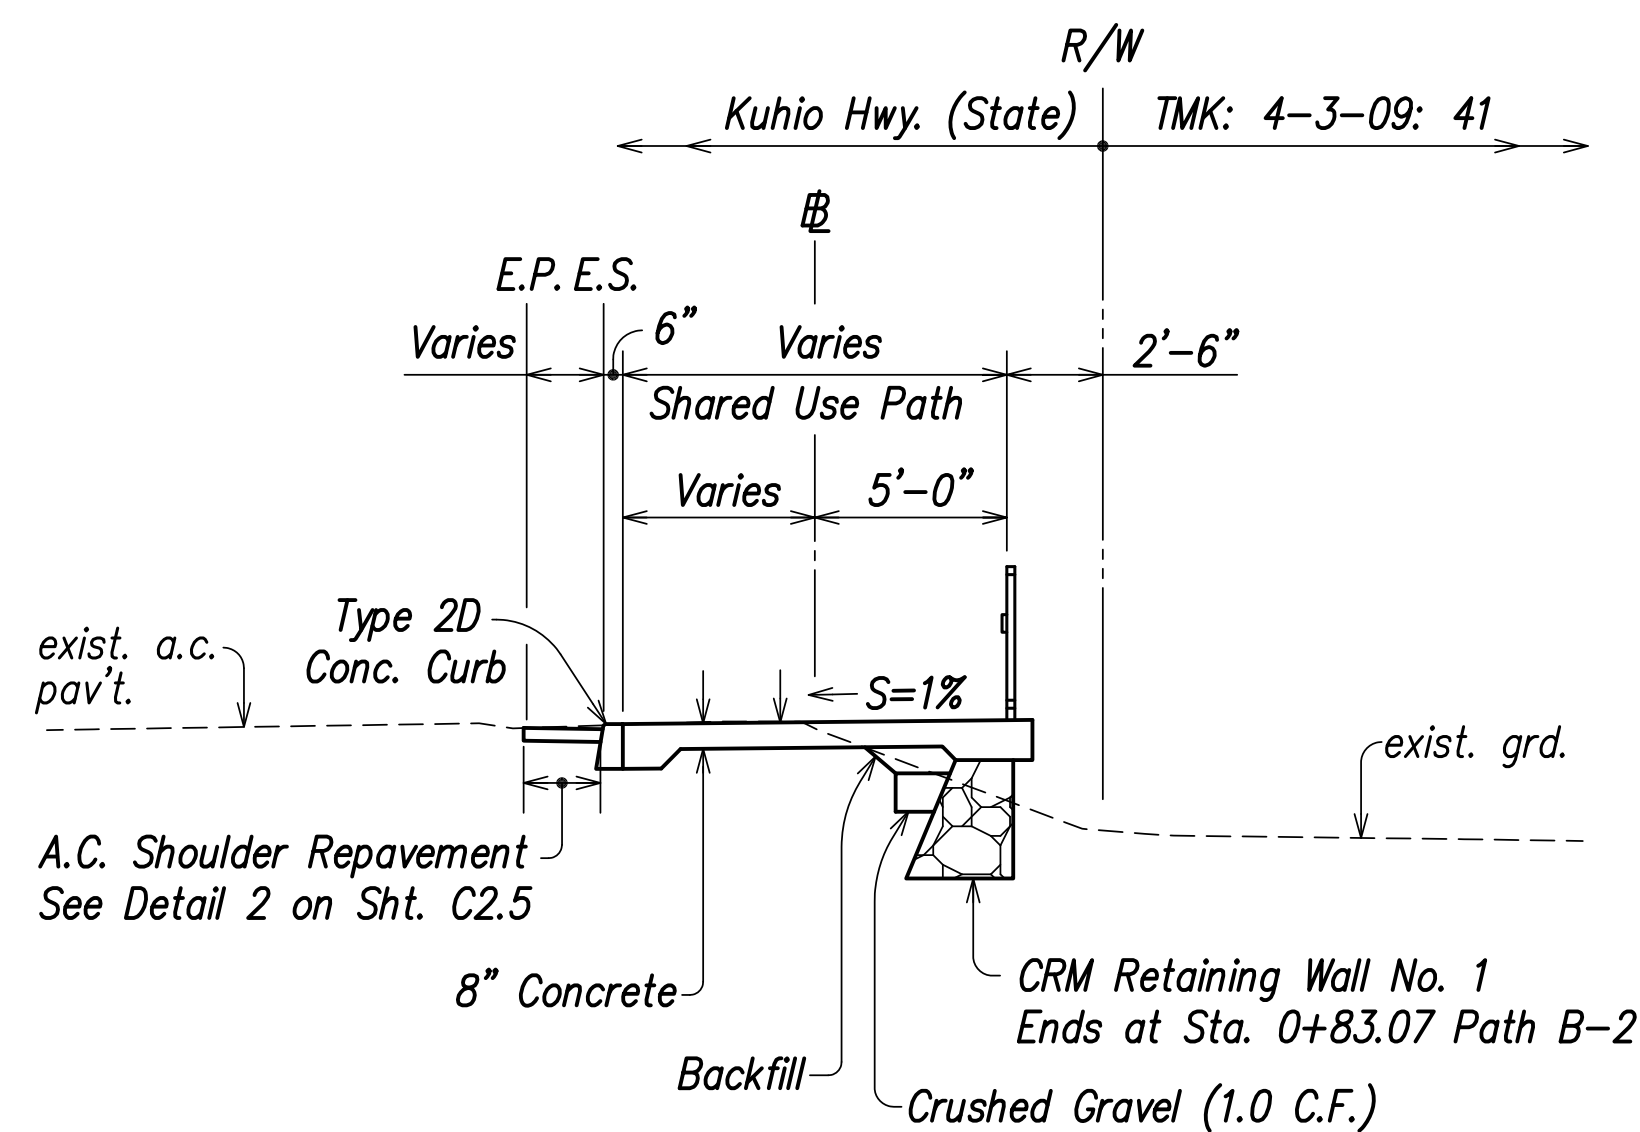


Sta. 0+79.15 to Sta. 0+83.07 Path B-2

Scale: 1" = 5'-0"

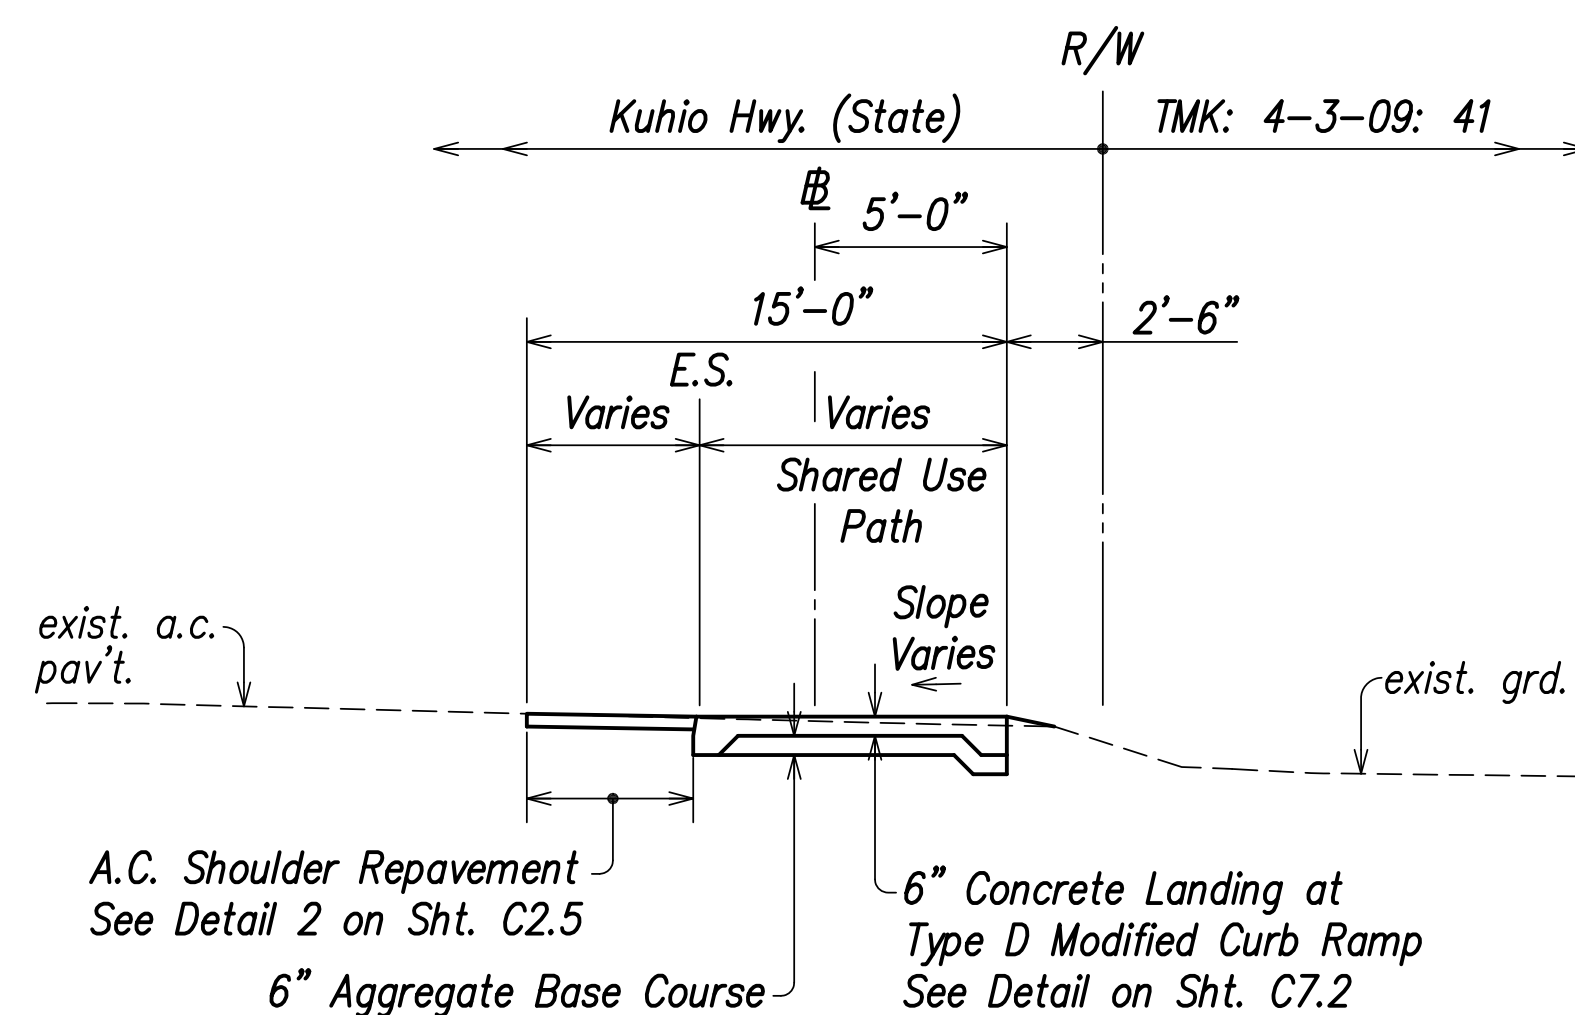


Sta. 0+83.07 to Sta. 0+97.71 Path B-2

Scale: 1" = 5'-0"

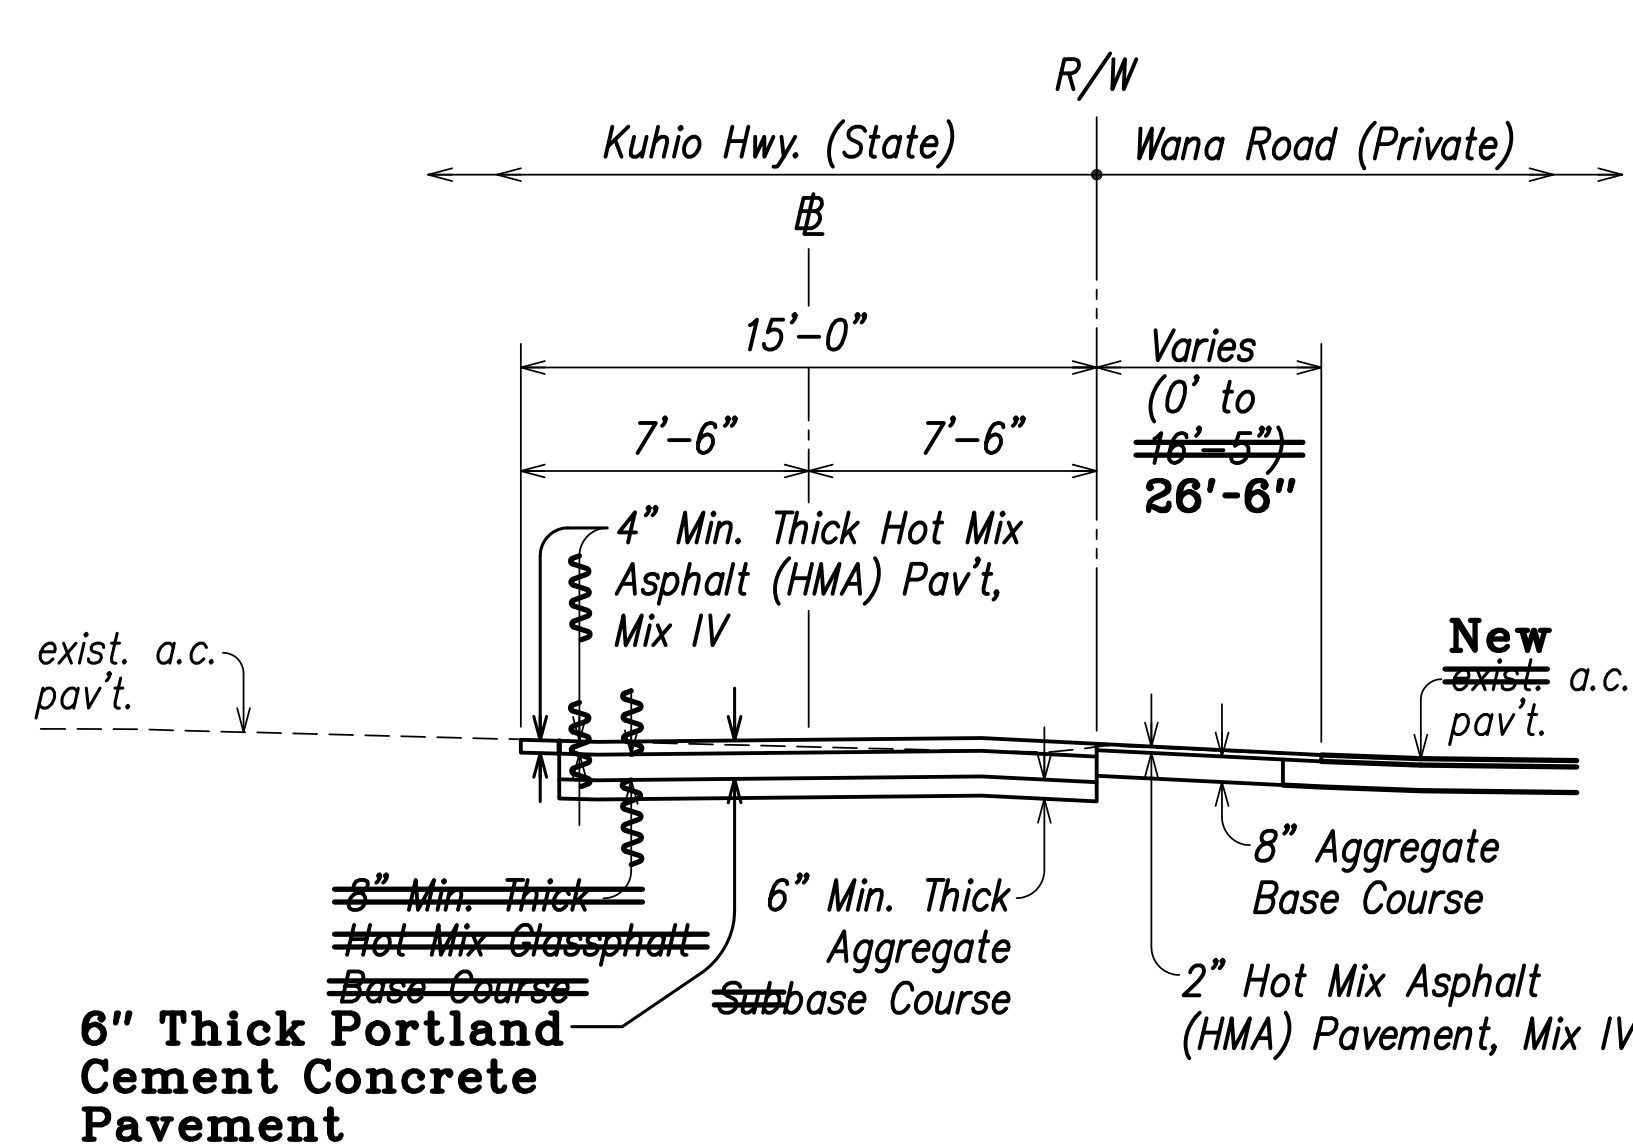


Sta. 0+97.71 to Sta. 1+31.20 Path B-2

Scale: 1" = 5'-0"

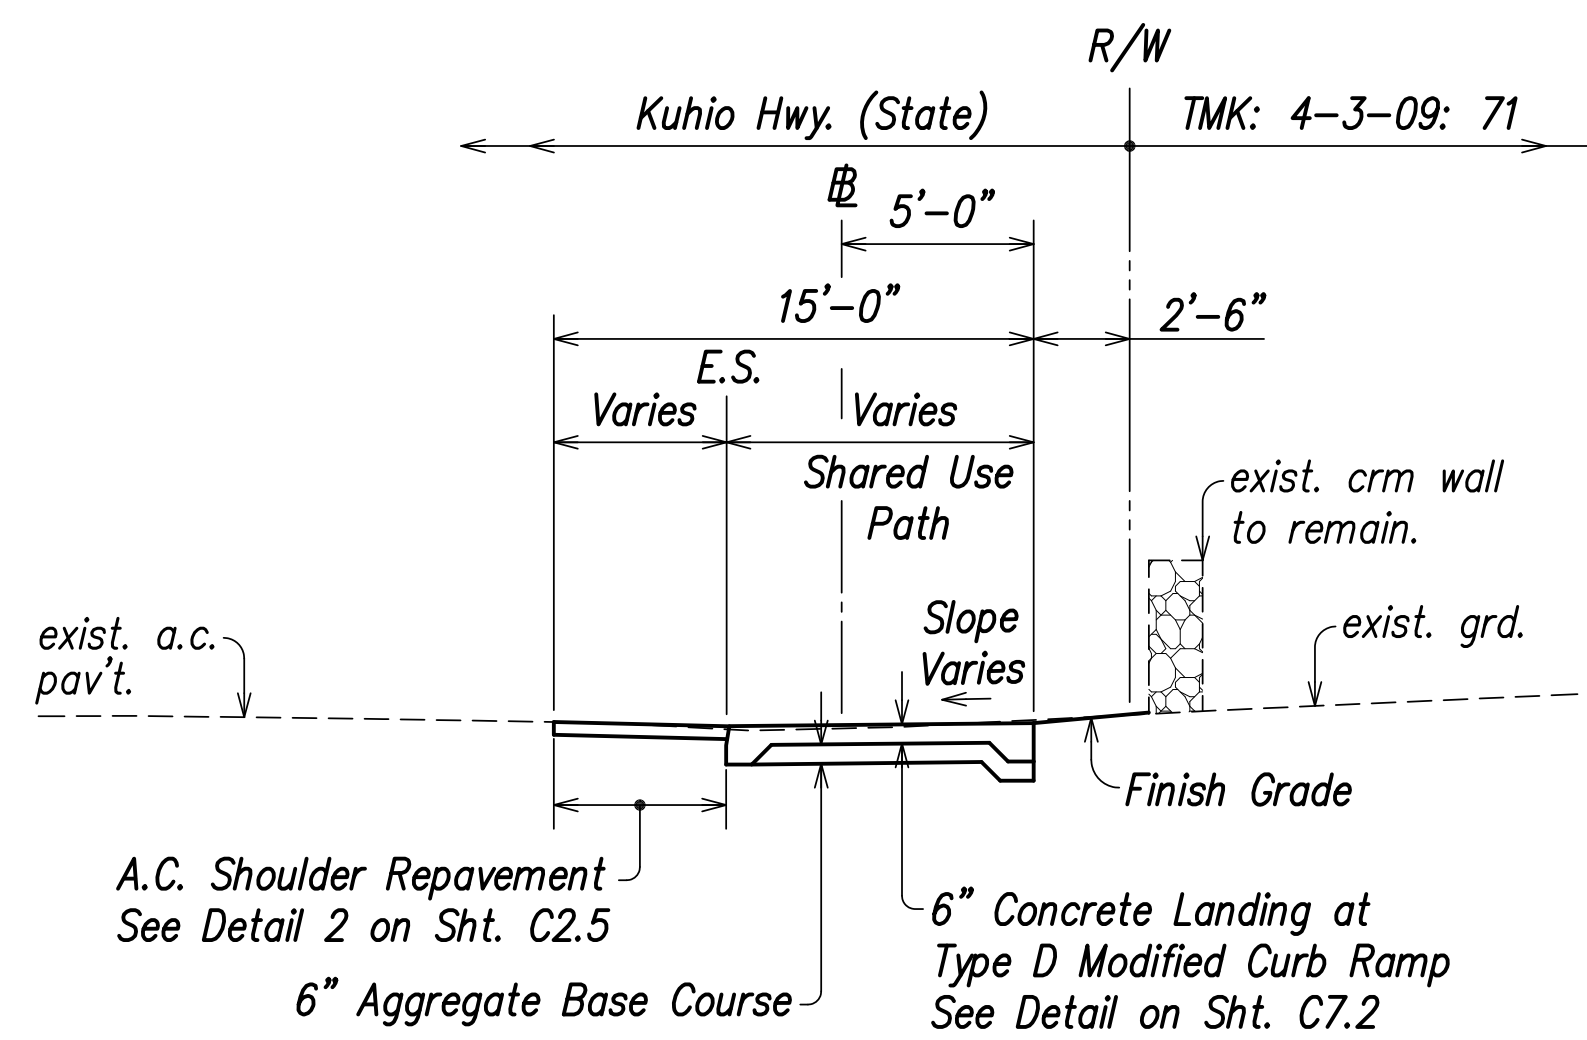


Sta. 1+31.20 to Sta. 1+45.95 Path B-2

Scale: 1" = 5'-0"

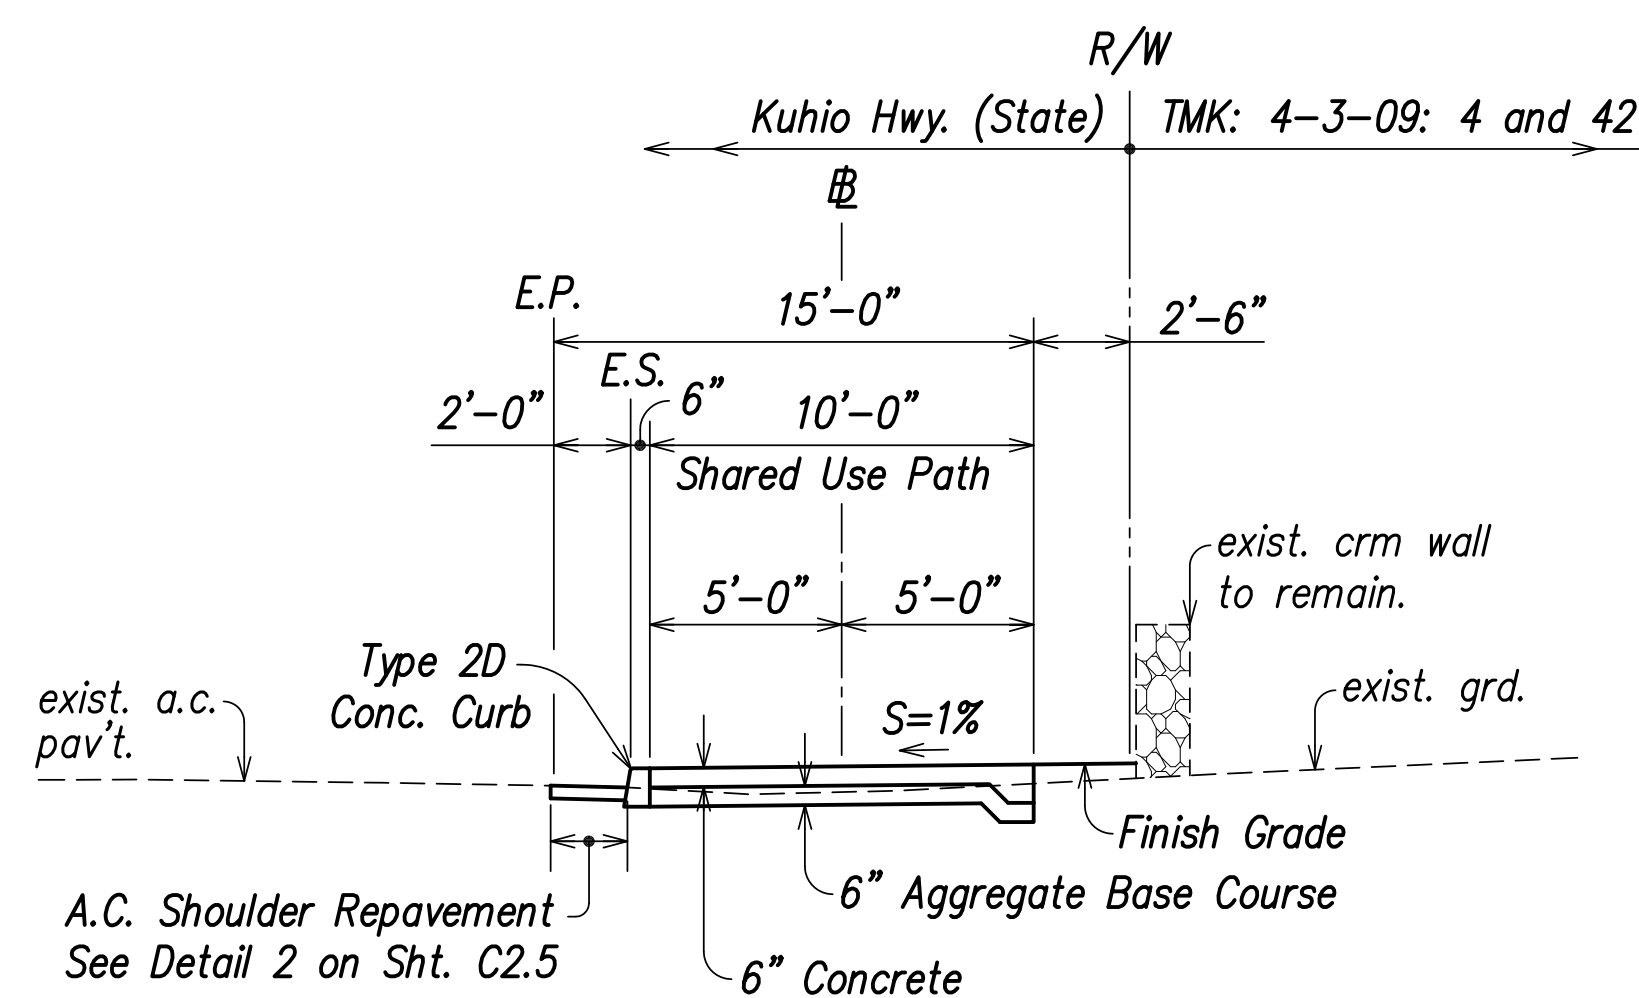


Sta. 1+45.95 to Sta. 1+56 Path B-2

Scale: 1" = 5'-0"

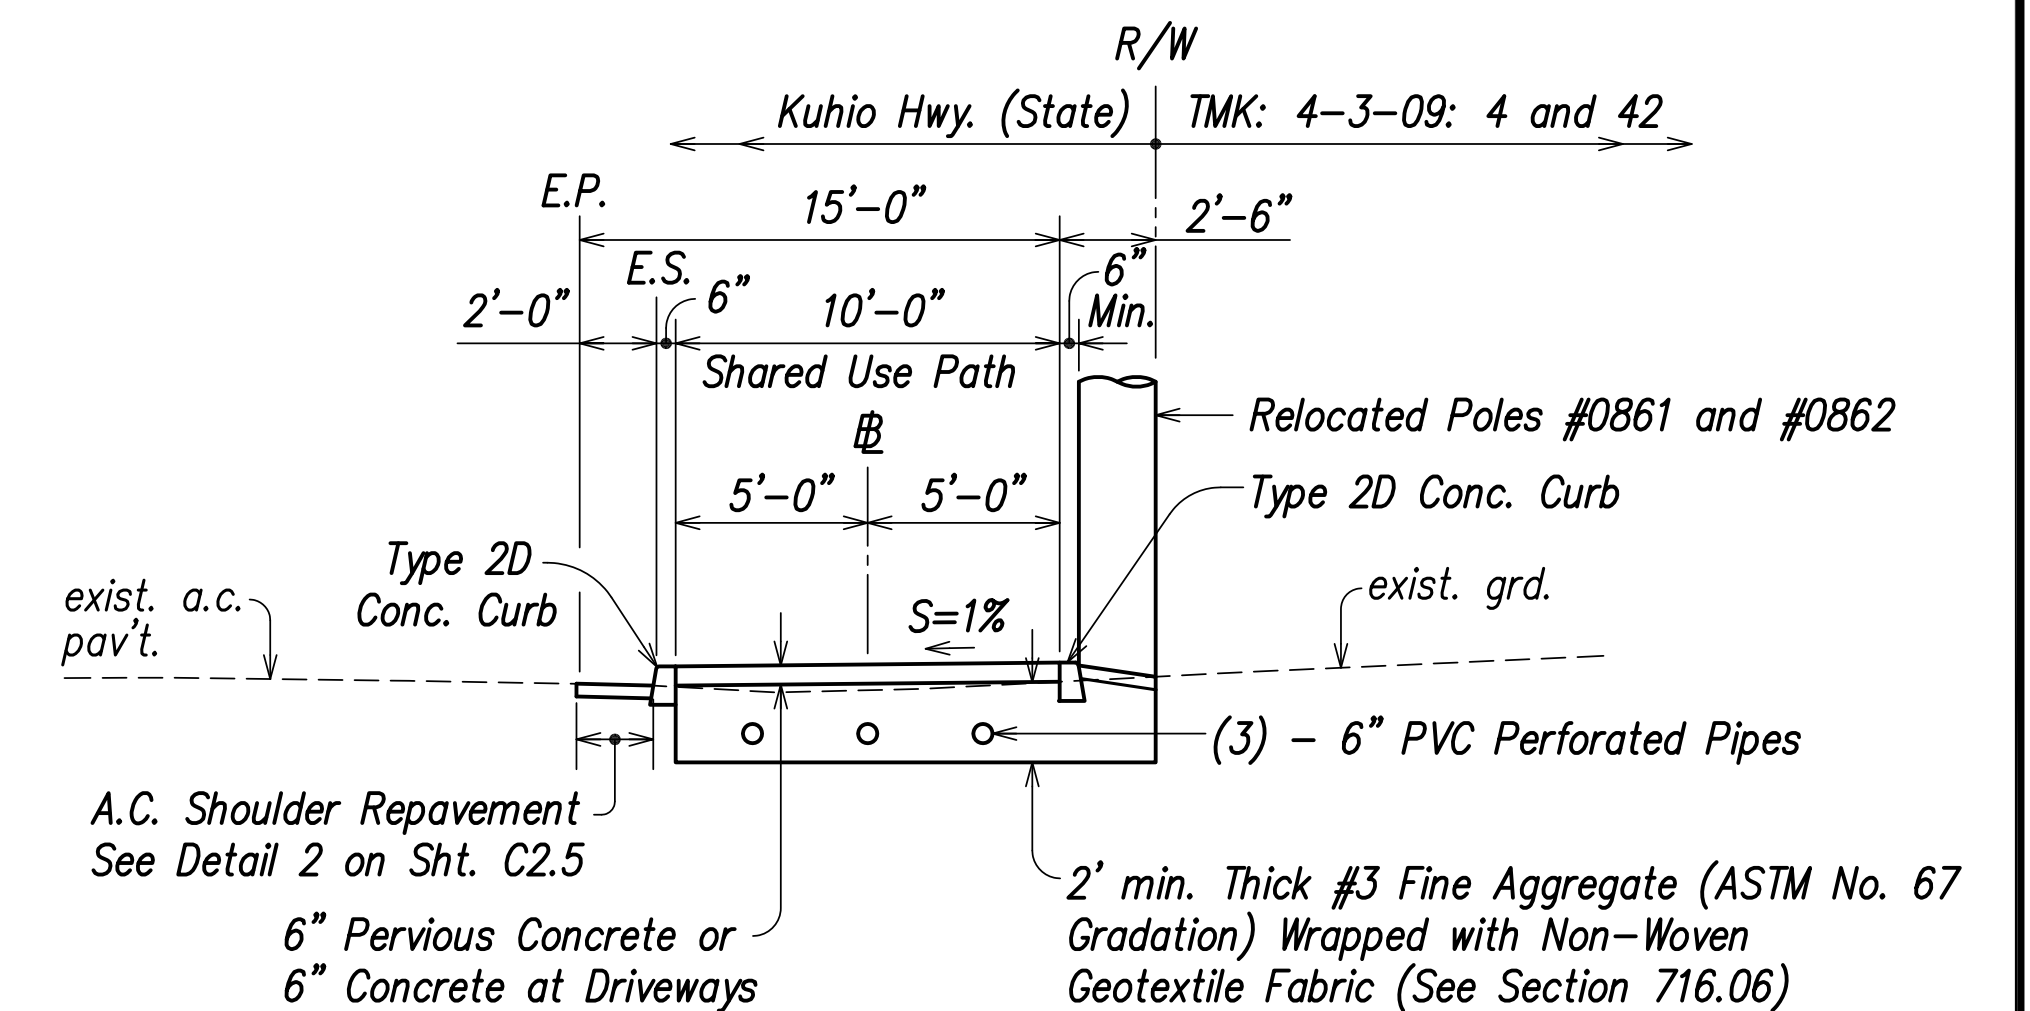

Sta. 1+56 to Sta. 6+53.22 Path B-2

Scale: 1" = 5'-0"

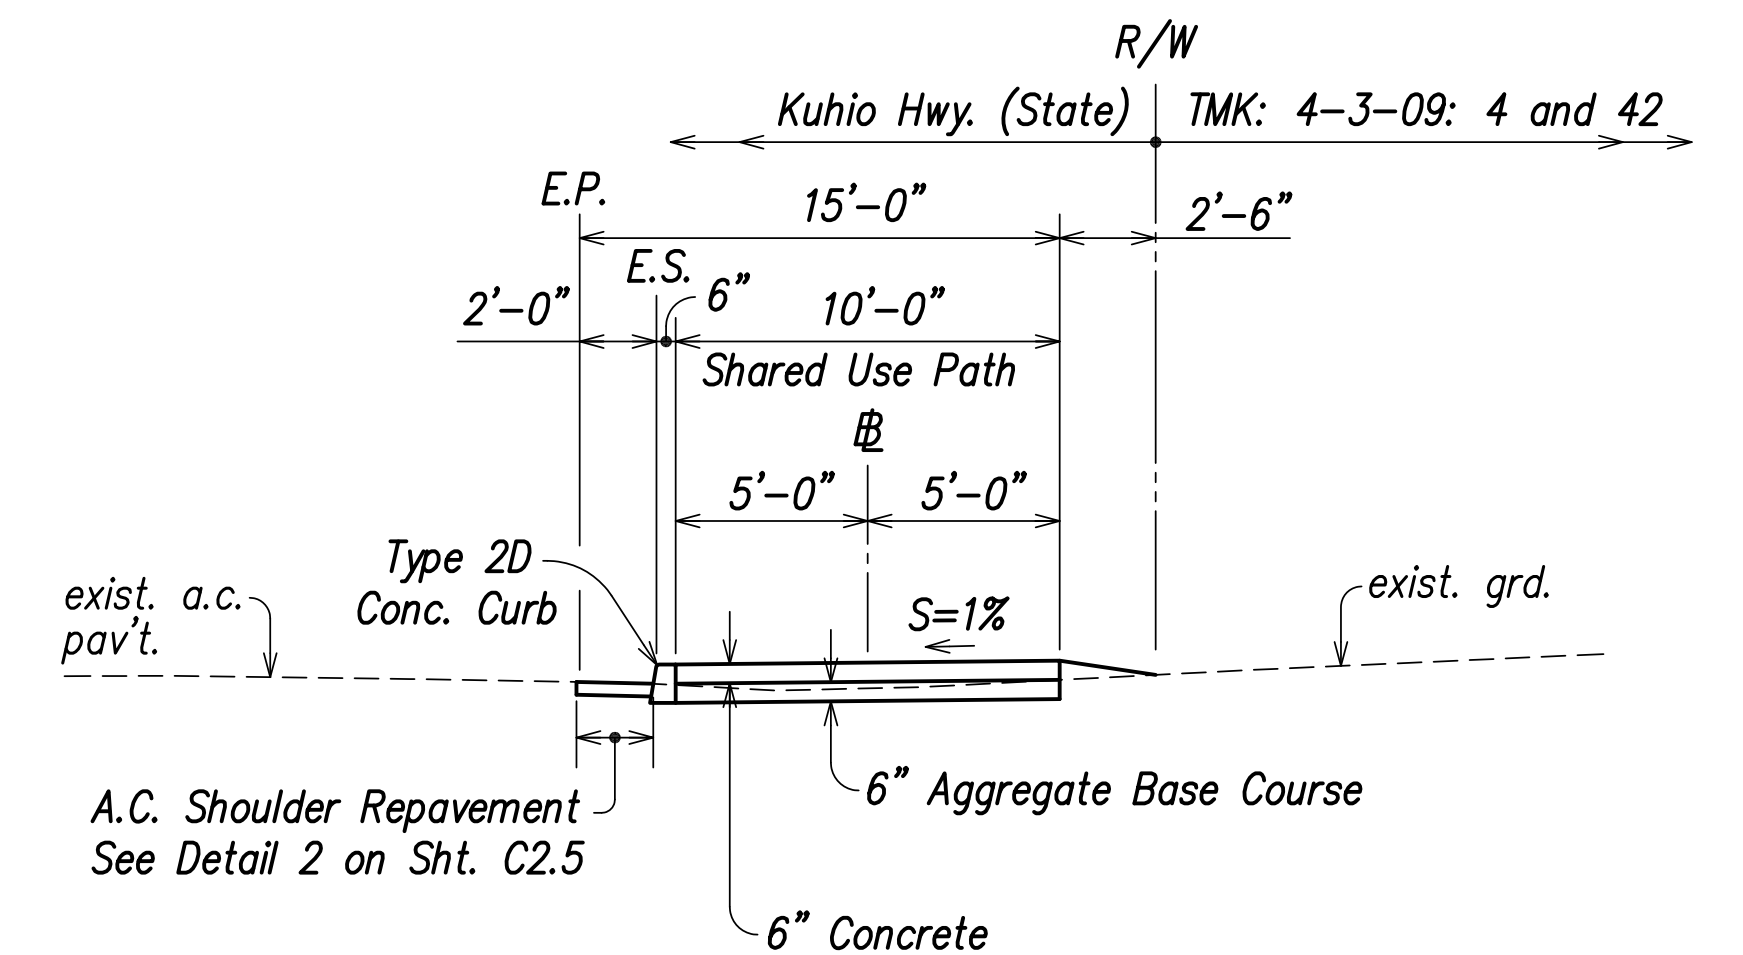

Sta. 6+53.22 to Sta. 7+10.05 Path B-2

Scale: 1" = 5'-0"

LEGEND FOR AS-BUILT POSTINGS	
	Squiggly line for as-built deletion
	Double line for as-built deletion
	Text for as-built posting

THIS WORK WAS PREPARED BY ME OR UNDER MY SUPERVISION.

Russell M. Araki 4-30-14
SIGNATURE EXPIRATION DATE OF THE LICENSE









COUNTY OF KAUAI
DEPARTMENT OF PUBLIC WORKS
LYDGATE PARK TO KAPA'A BIKE/
PEDESTRIAN PATH PHASE B
KAPA'A, KAUAI, HAWAII

TYPICAL SECTIONS - 2

FEDERAL-AID PROJECT NO. STP-0700(61)
DATE: NOVEMBER 2011

DRAWN BY: NGA	F.B.	C.B.	SHEET
TRACED BY: RMA			C2.2
CHECKED BY:			OF SHEETS

FED. ROAD DIST. NO.	STATE	FED. AID PROJ. NO.	FISCAL YEAR	SHEET NO.	TOTAL SHEETS
HAWAII	HAW.	STP-0700(61)	2011	18	143

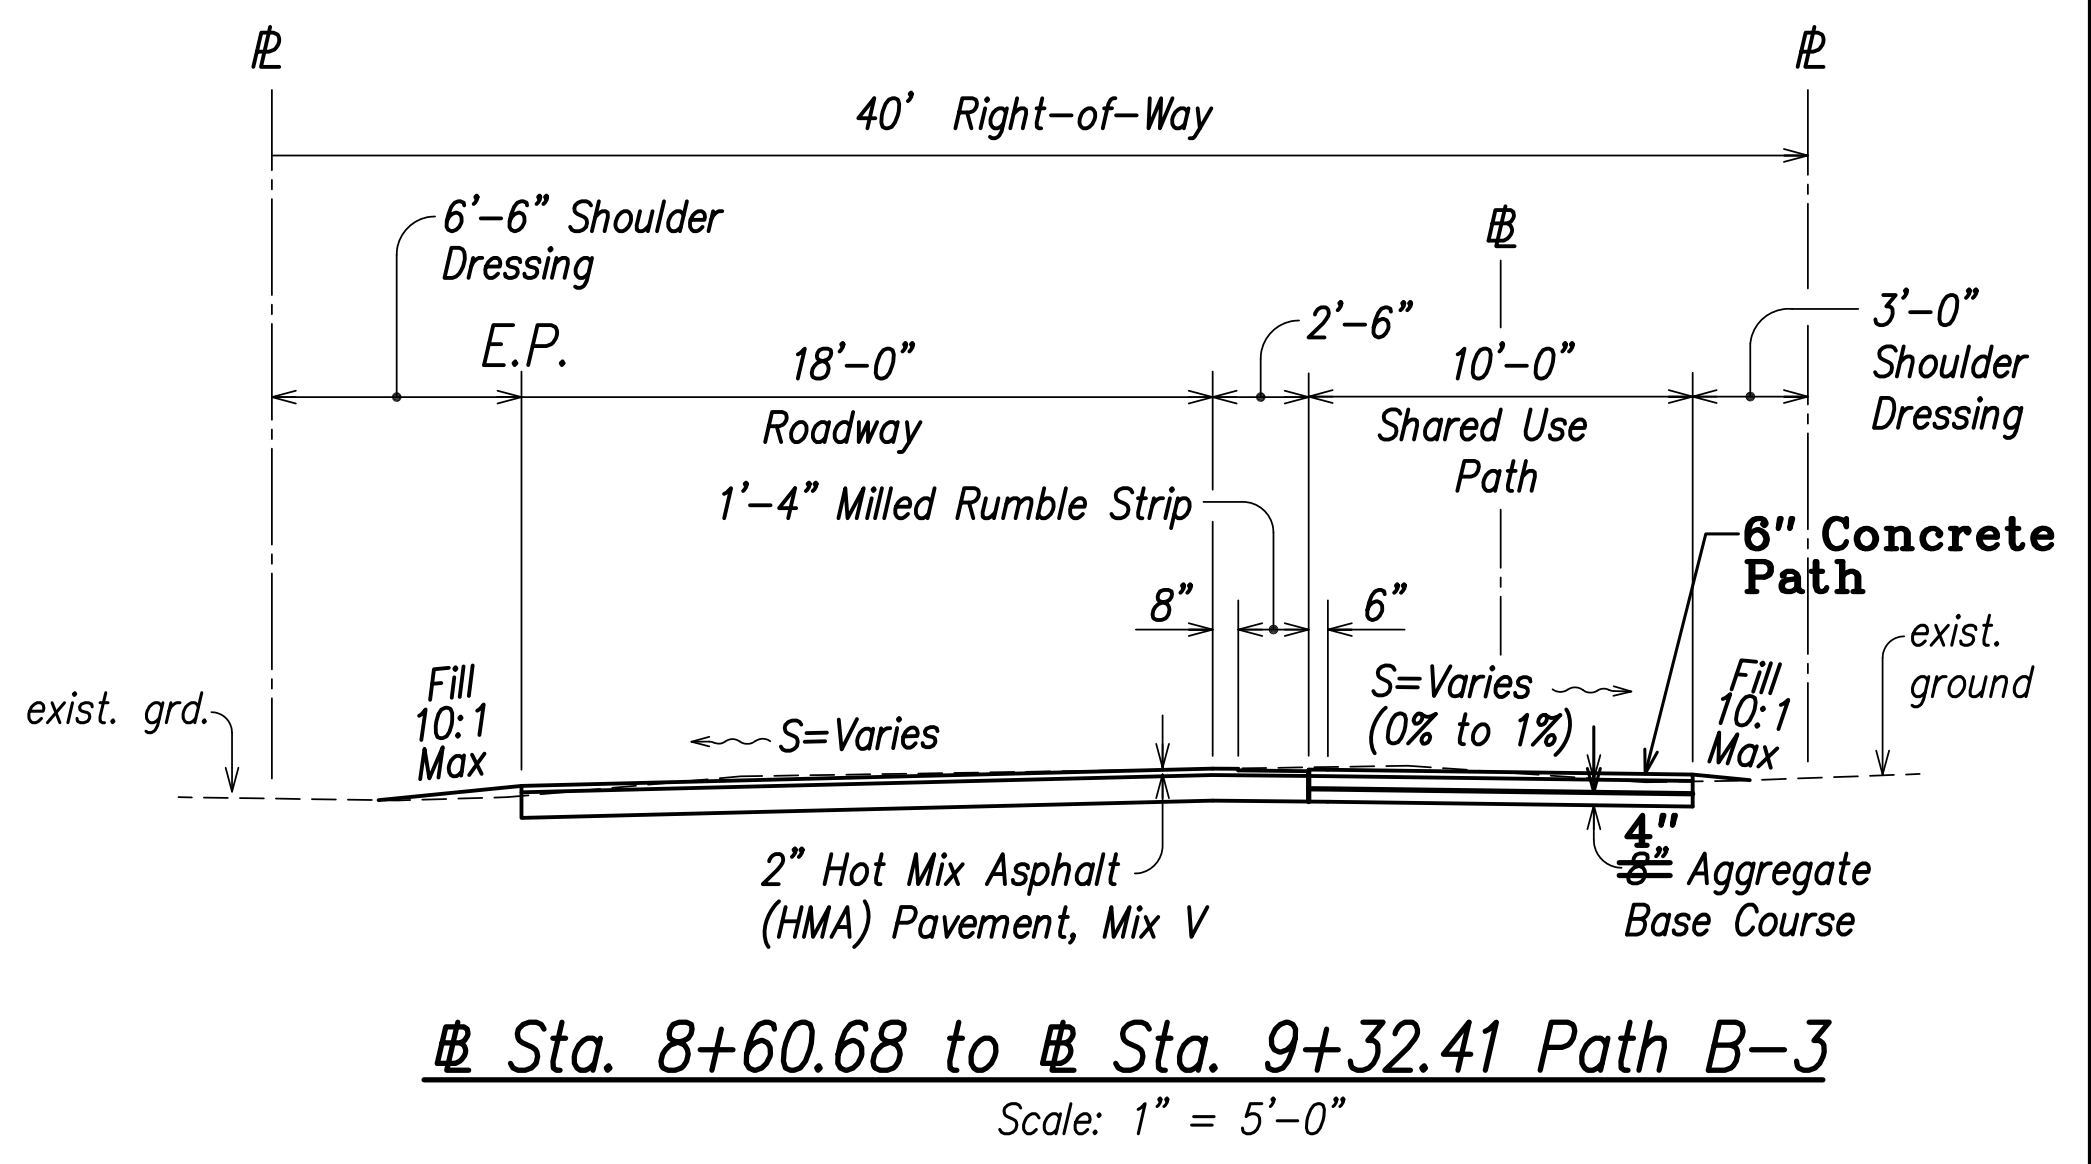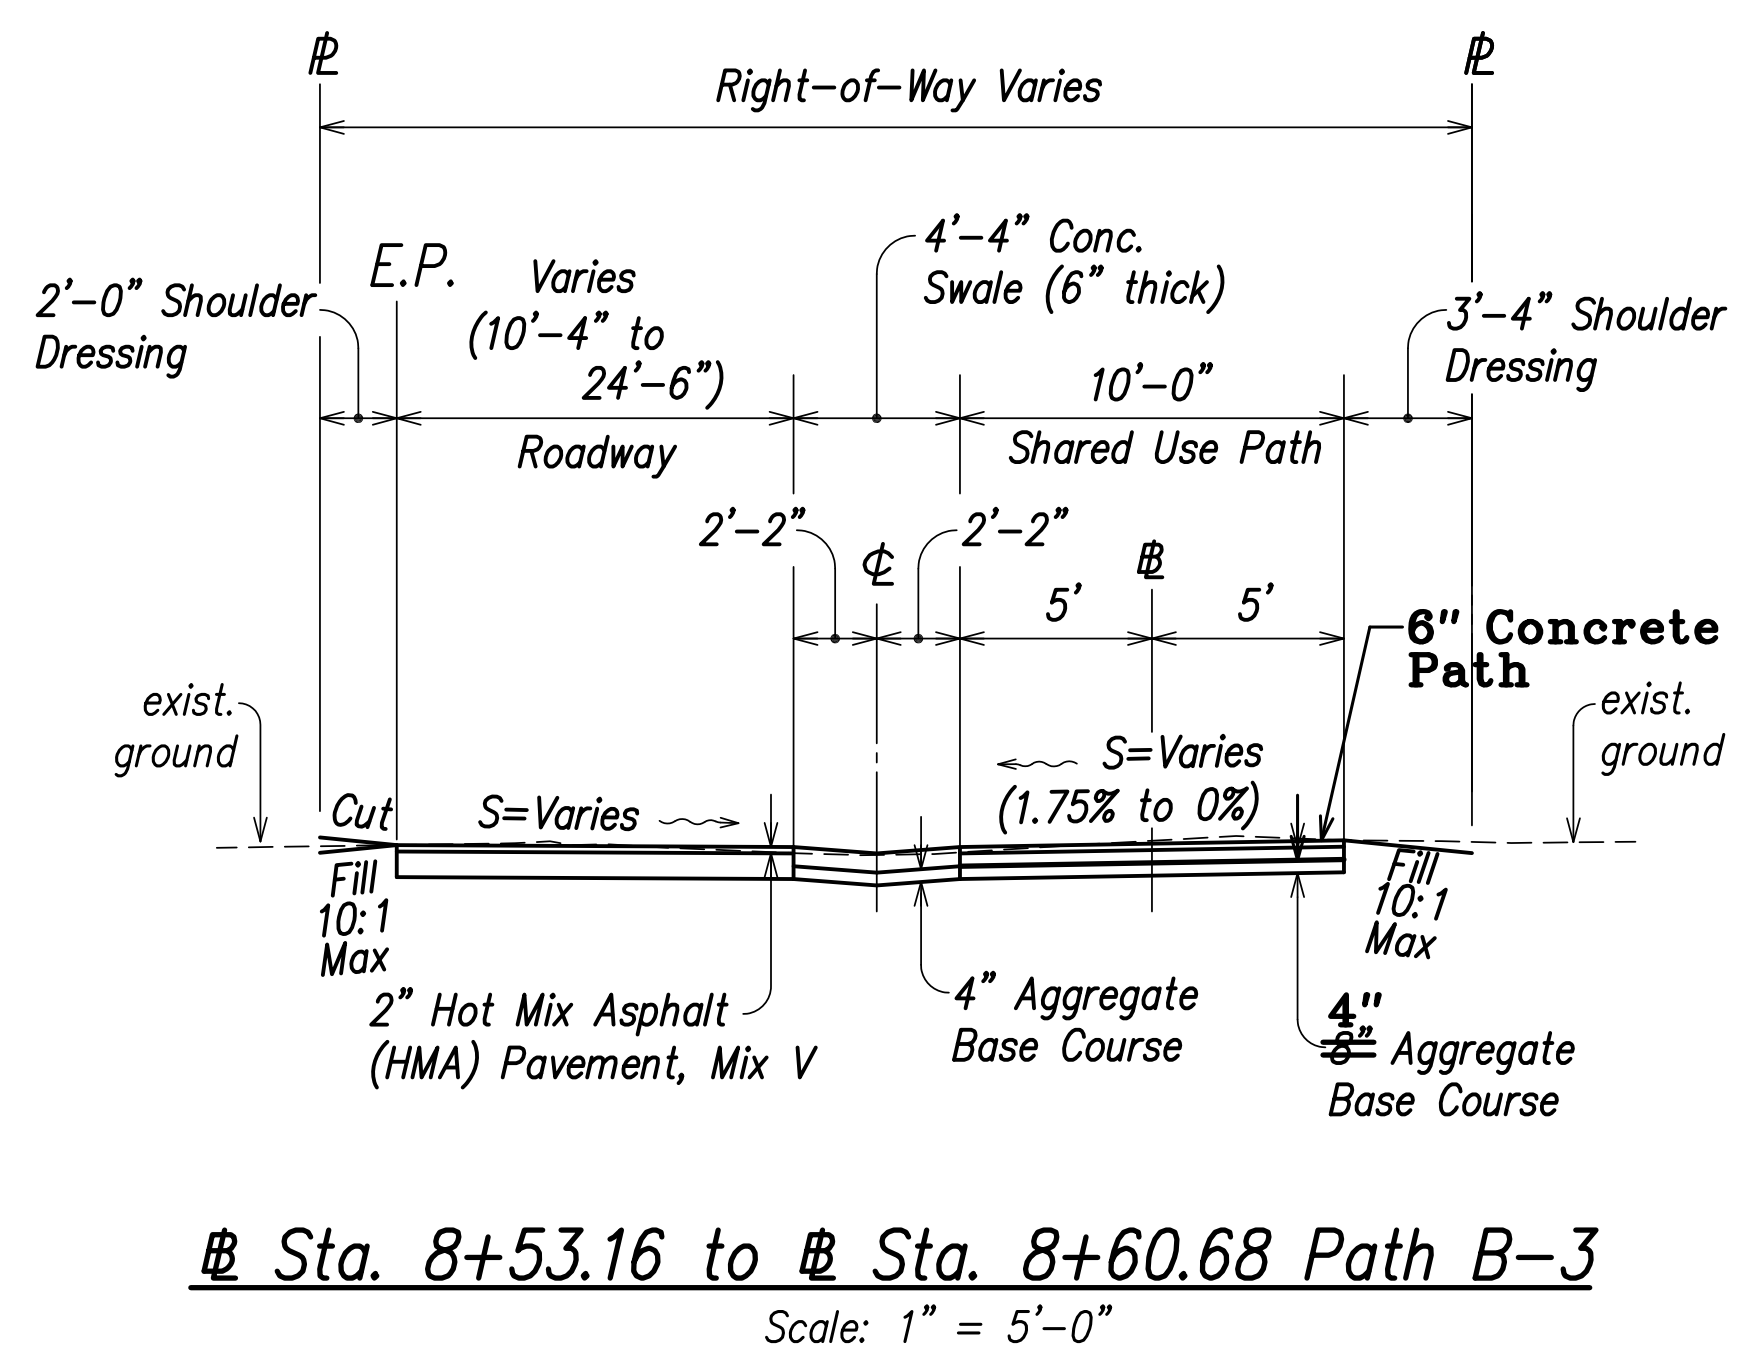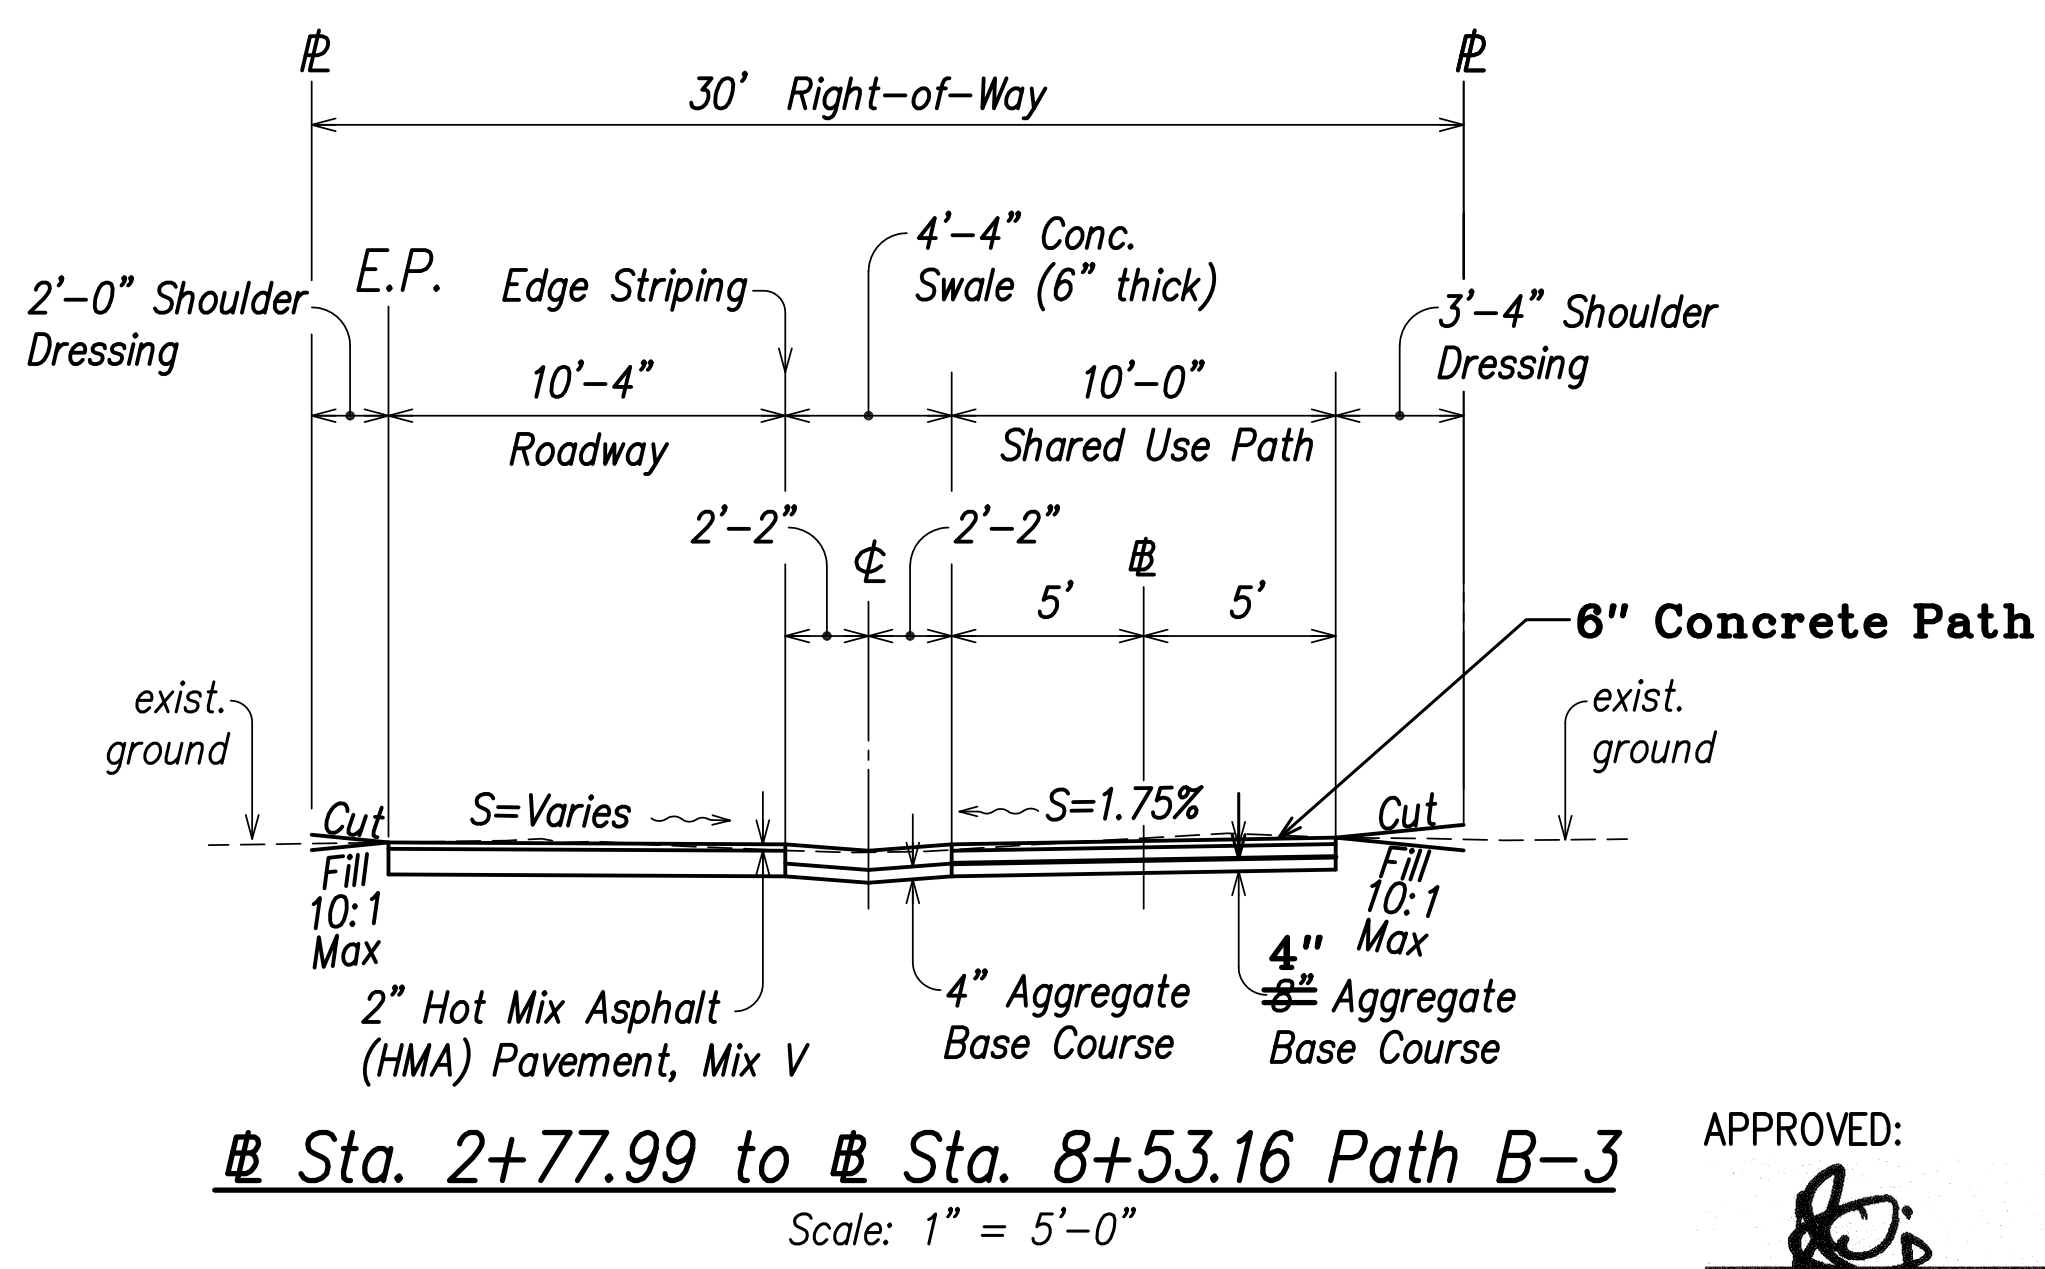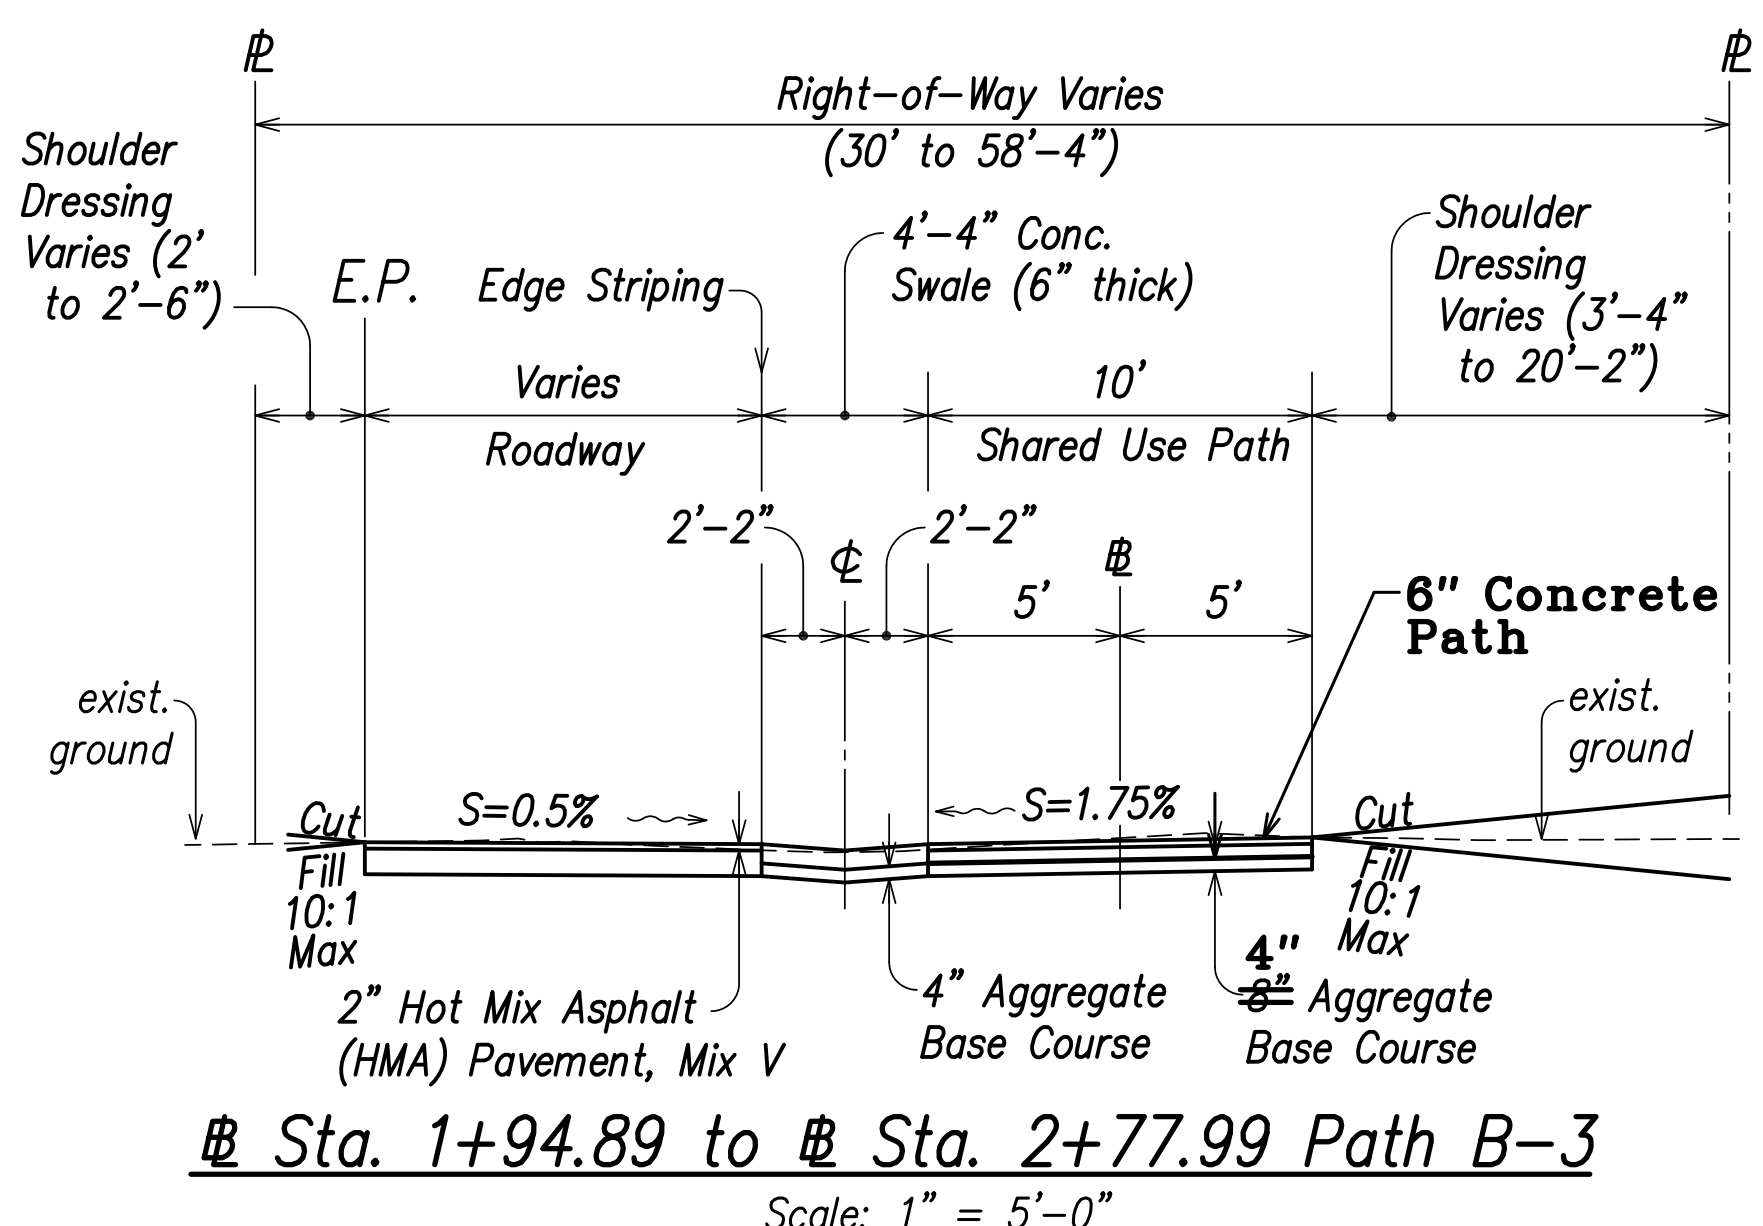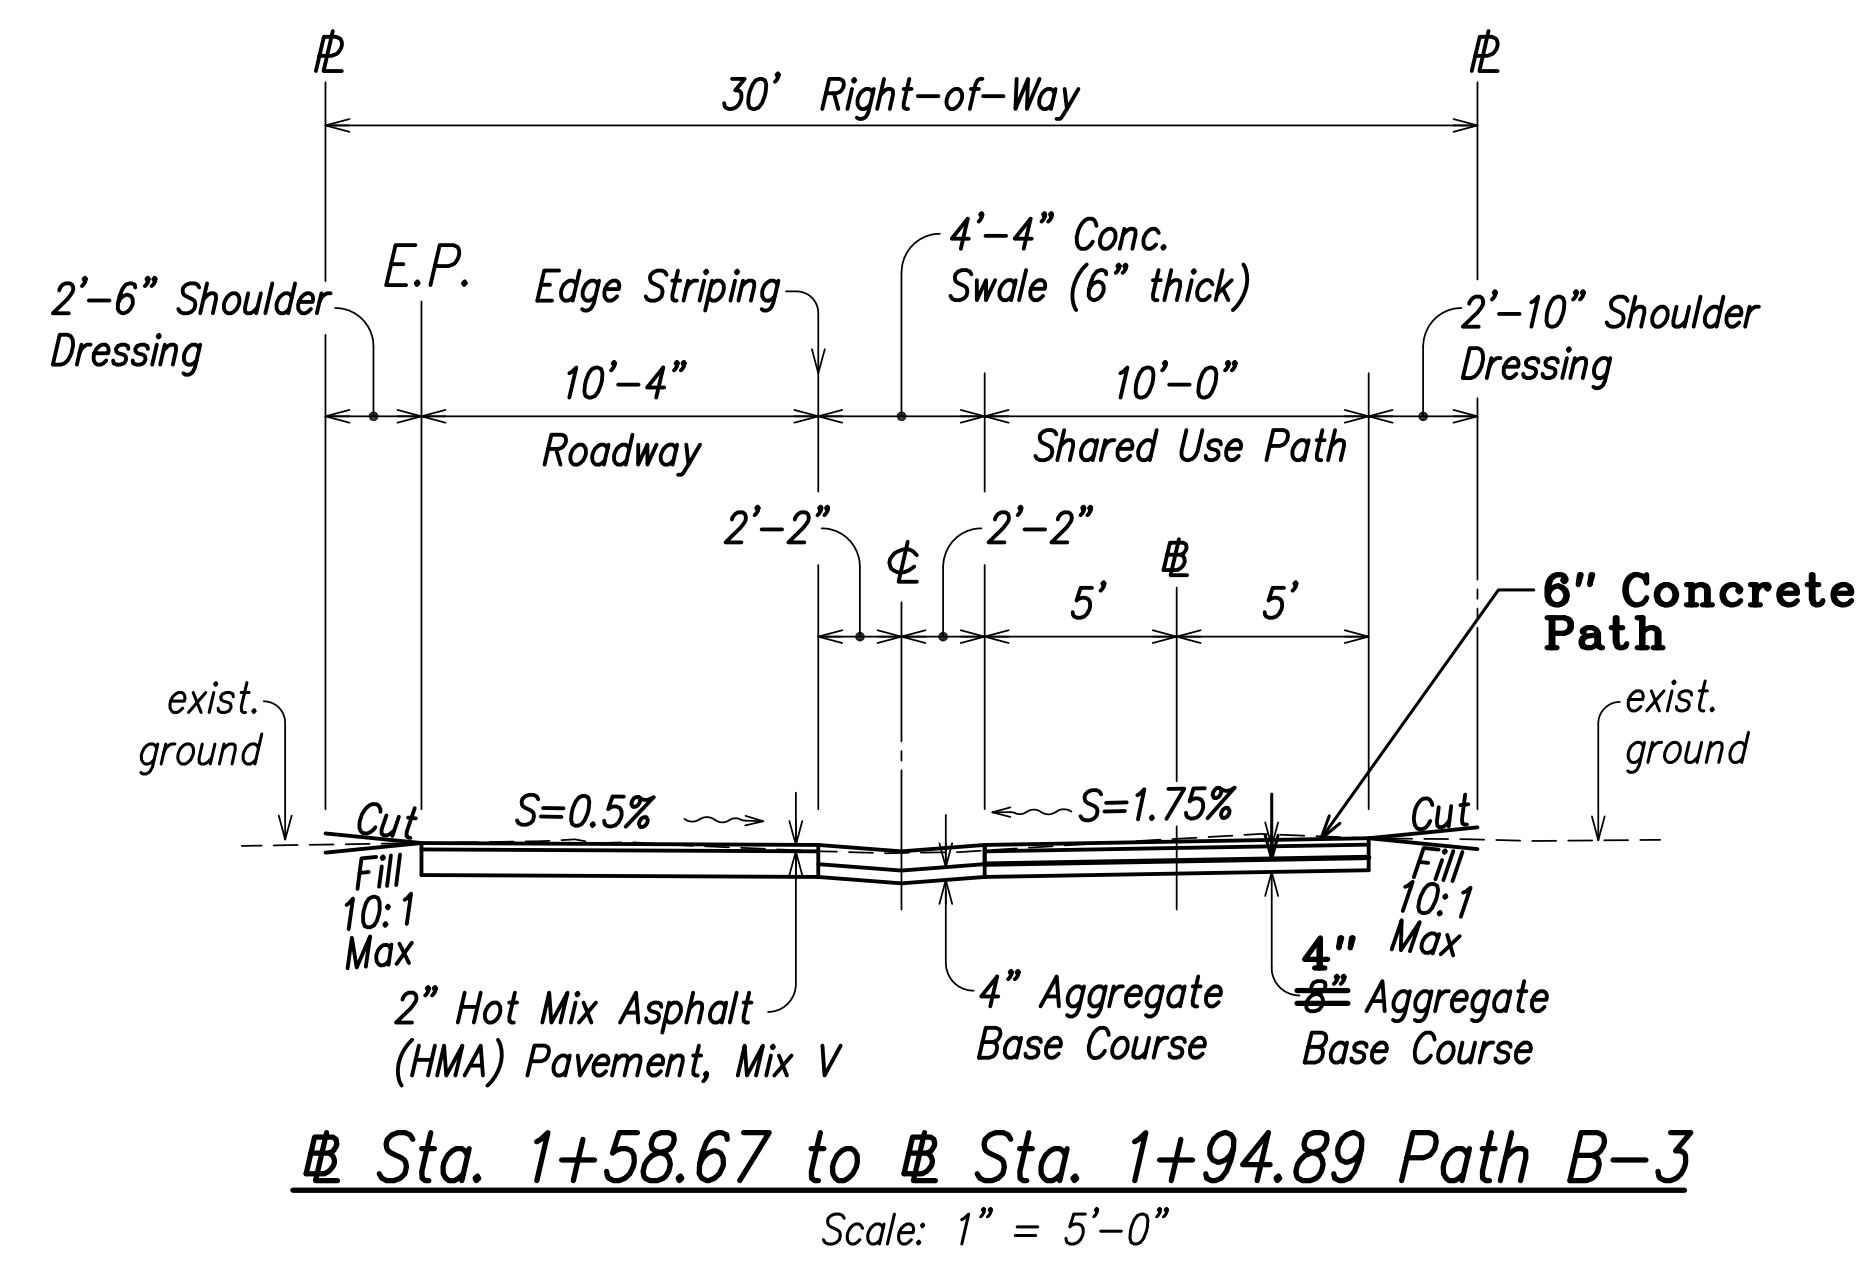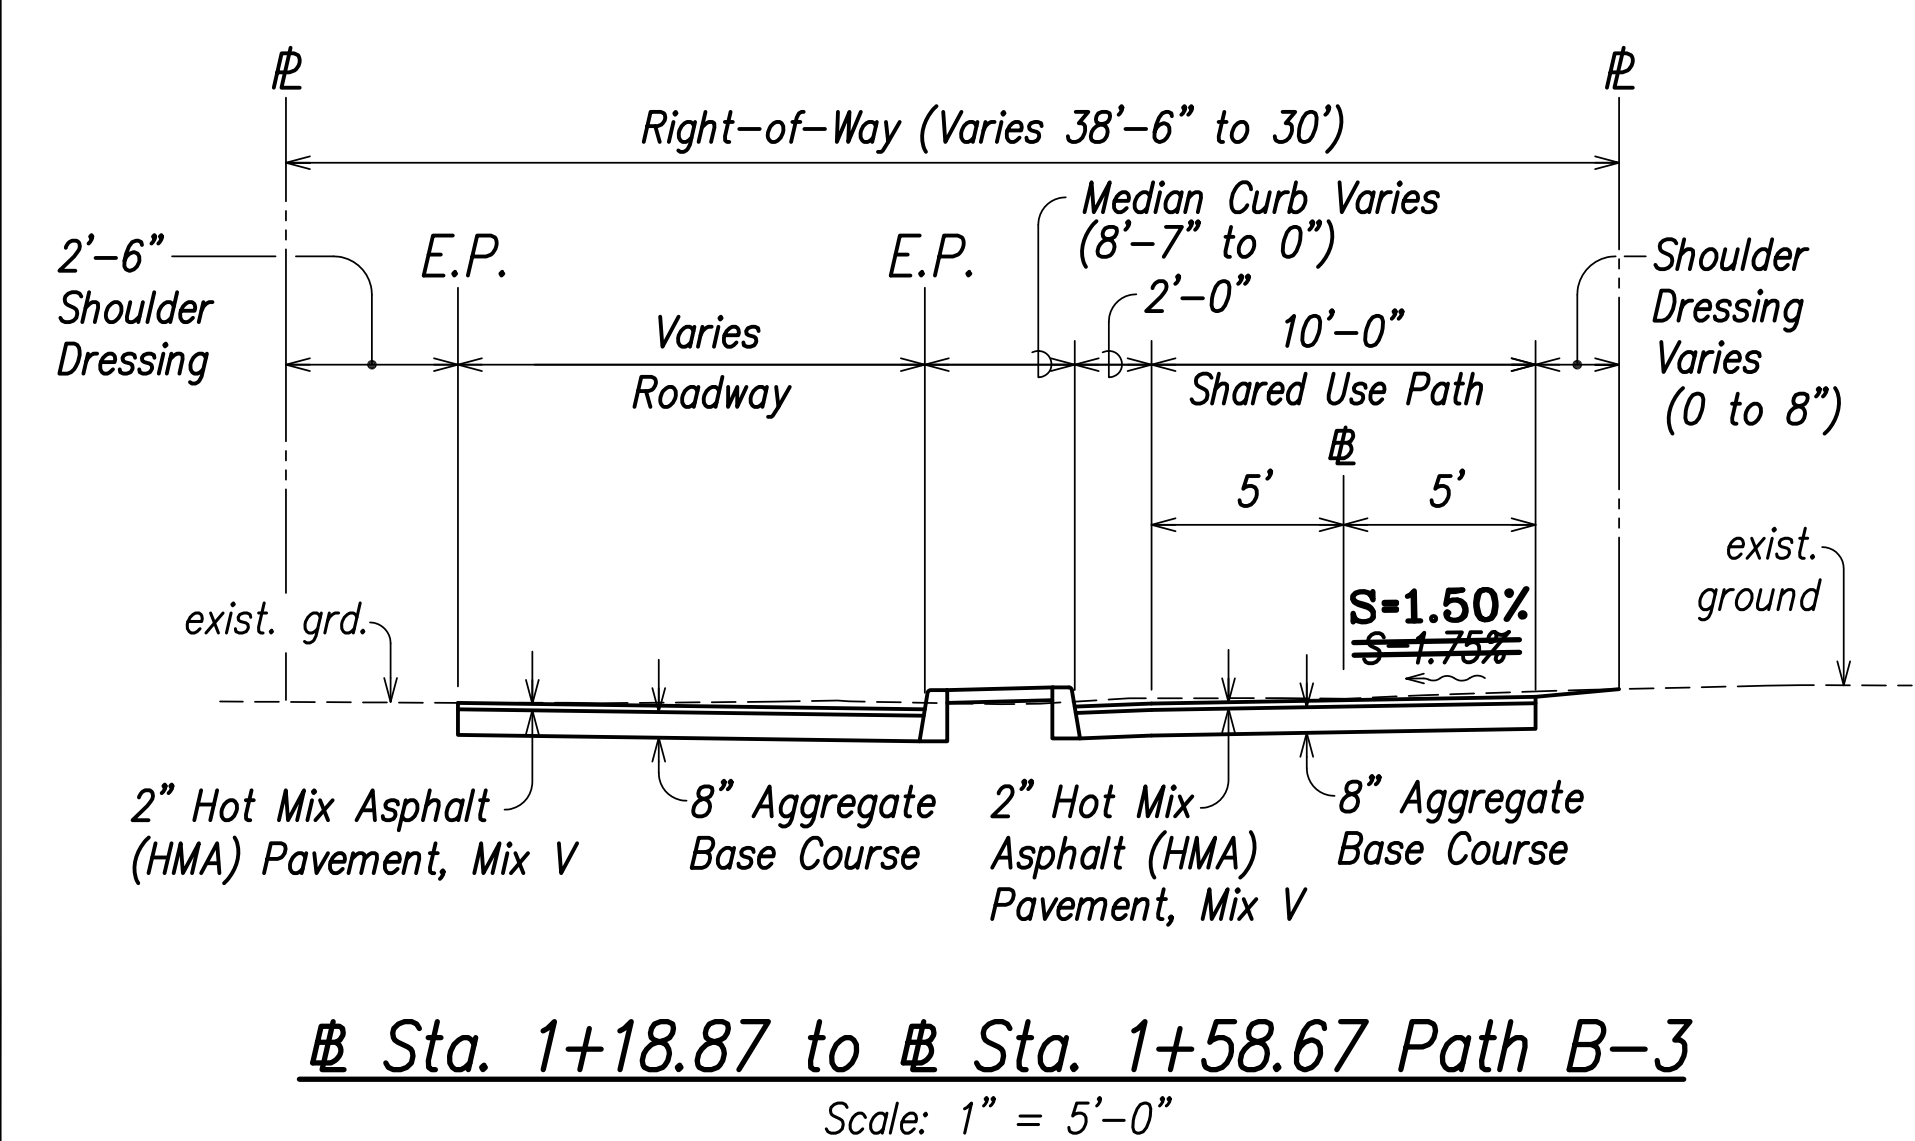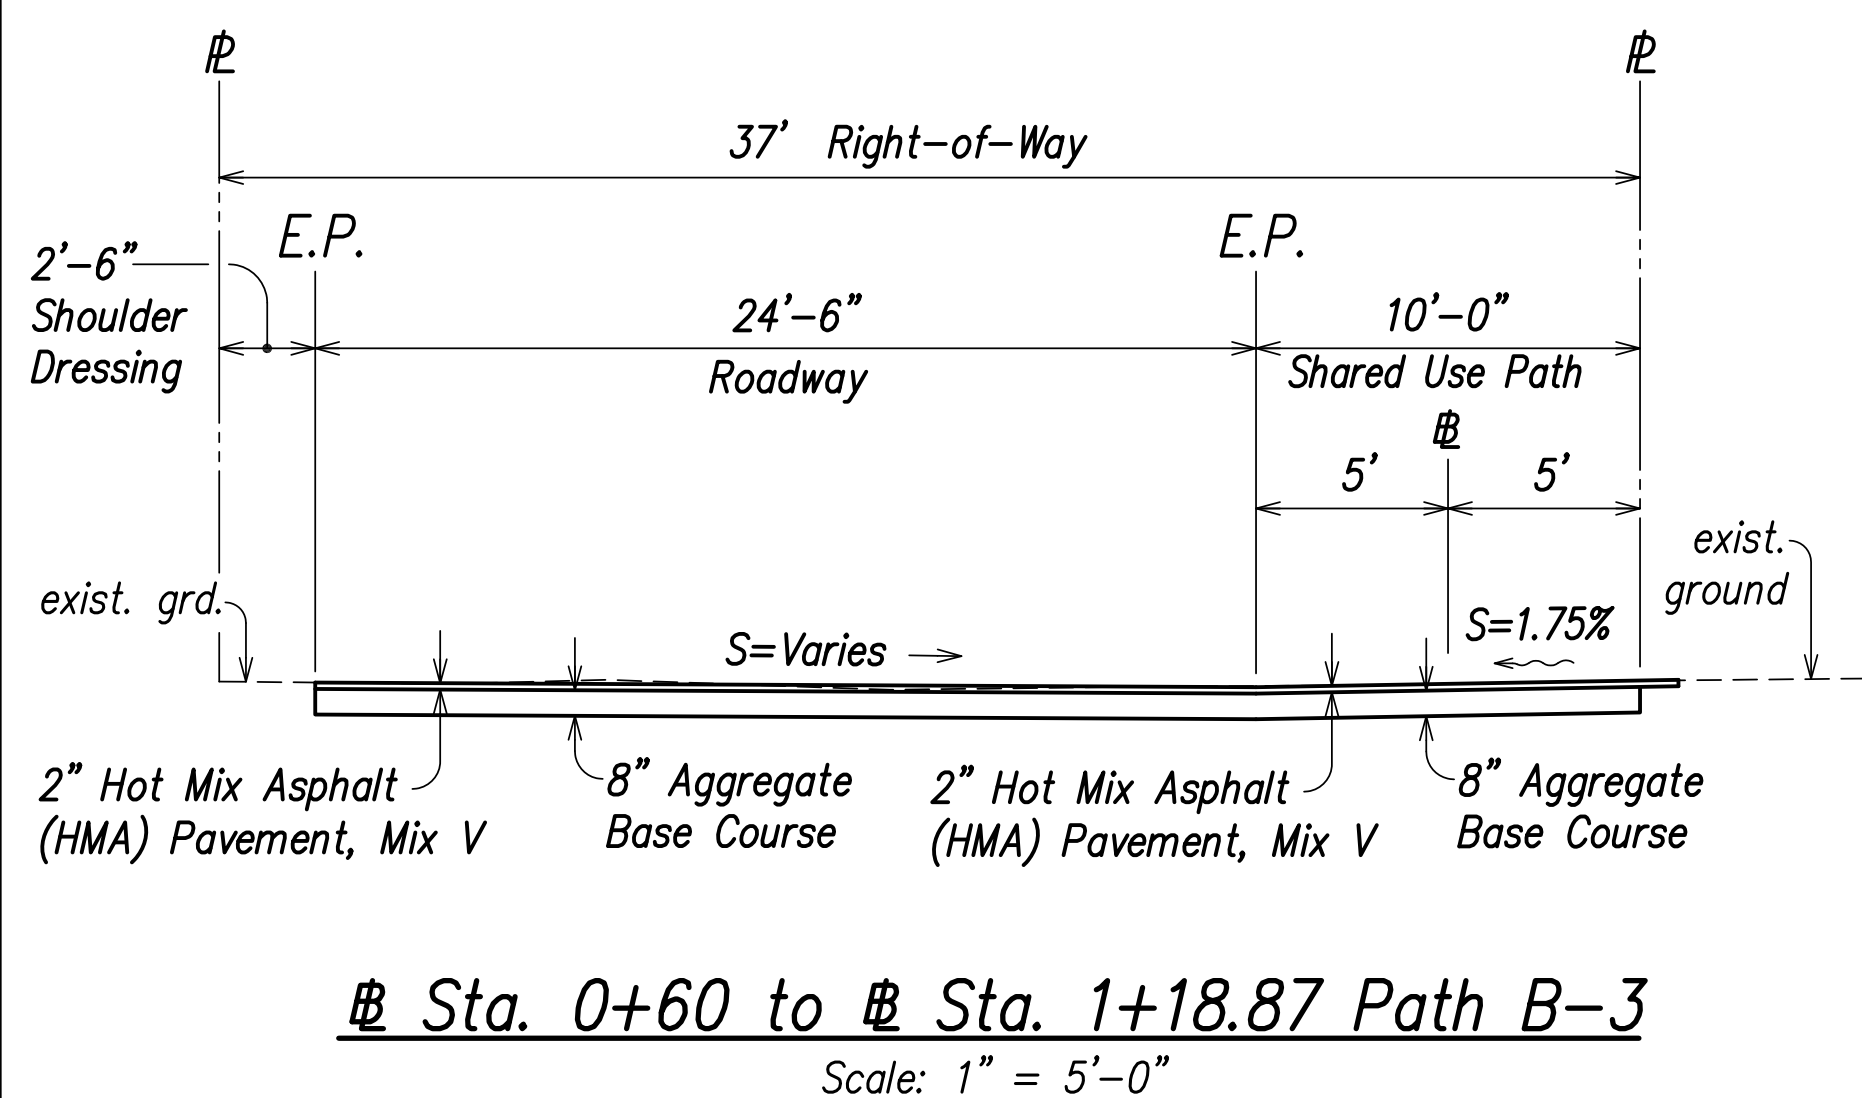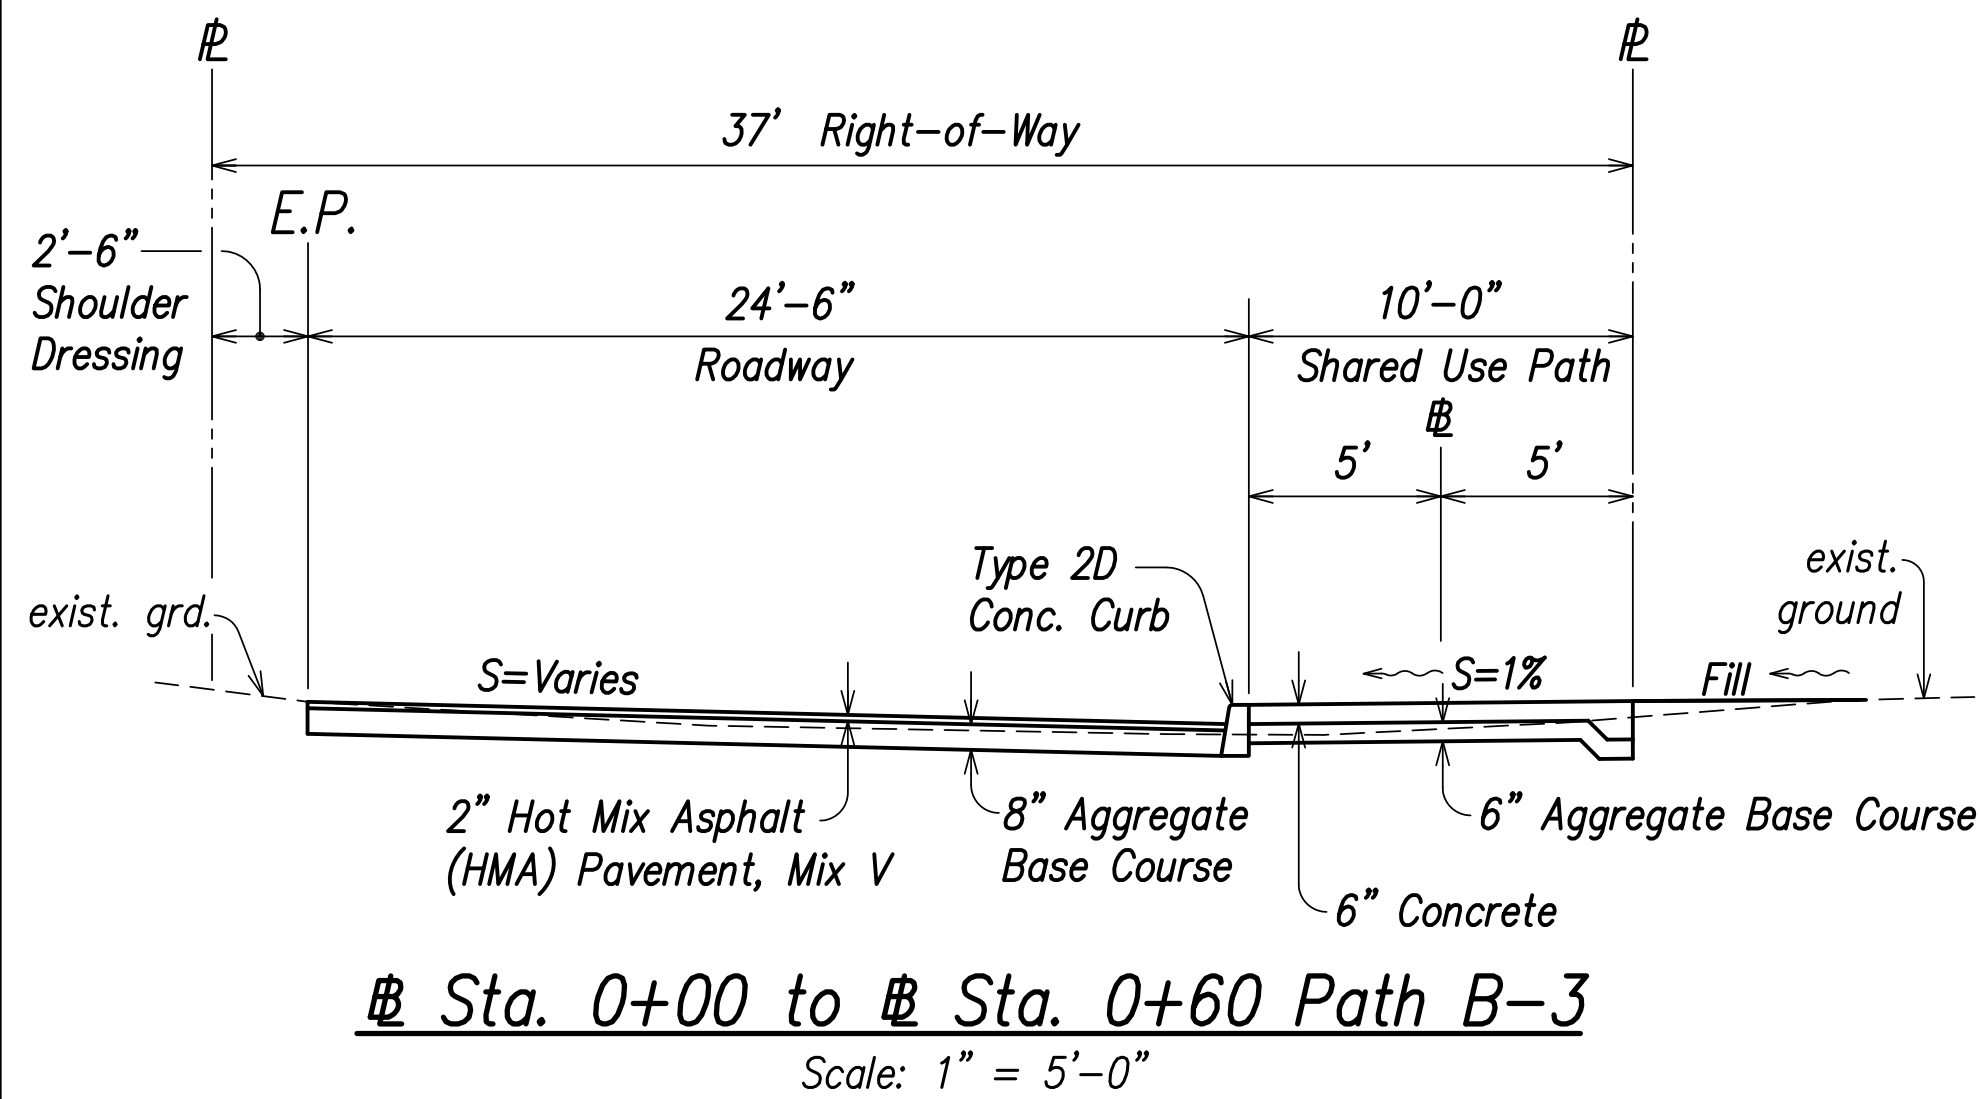

LEGEND FOR AS-BUILT POSTINGS
 Squiggly line for as-built deletion
 Double line for as-built deletion
Roadway Text for as-built posting

APPROVED:

COUNTY ENGINEER
(FOR WORK WITHIN COUNTY RIGHT OF WAY)

COUNTY OF KAUAI
DEPARTMENT OF PUBLIC WORKS
LYDGATE PARK TO KAPA'A BIKE/
PEDESTRIAN PATH PHASE B
KAPA'A, KAUAI, HAWAII

TYPICAL SECTIONS - 3

FEDERAL-AID PROJECT NO. STP-0700(61)
DATE: NOVEMBER 2011

DRAWN BY:	NGA	F.B.	C.B.	SHEET
TRACED BY:				C2.3
CHECKED BY:	RMA			OF SHEETS

FED. ROAD DIST. NO.	STATE	FED. AID PROJ. NO.	FISCAL YEAR	SHEET NO.	TOTAL SHEETS
HAWAII	HAW.	STP-0700(61)	2011	C.O. 19	143

Abbreviations:


- Baseline of Shared Use Path
- R/W Right-of-Way
- Property Line
- E.P. Edge of Pavement
- L.G. Limits of Grading

LEGEND FOR
AS-BUILT POSTINGS


 Squiggly line for as-built deletion

~~100-00~~ Double line for as-built deletion


Roadway Text for as-built posting

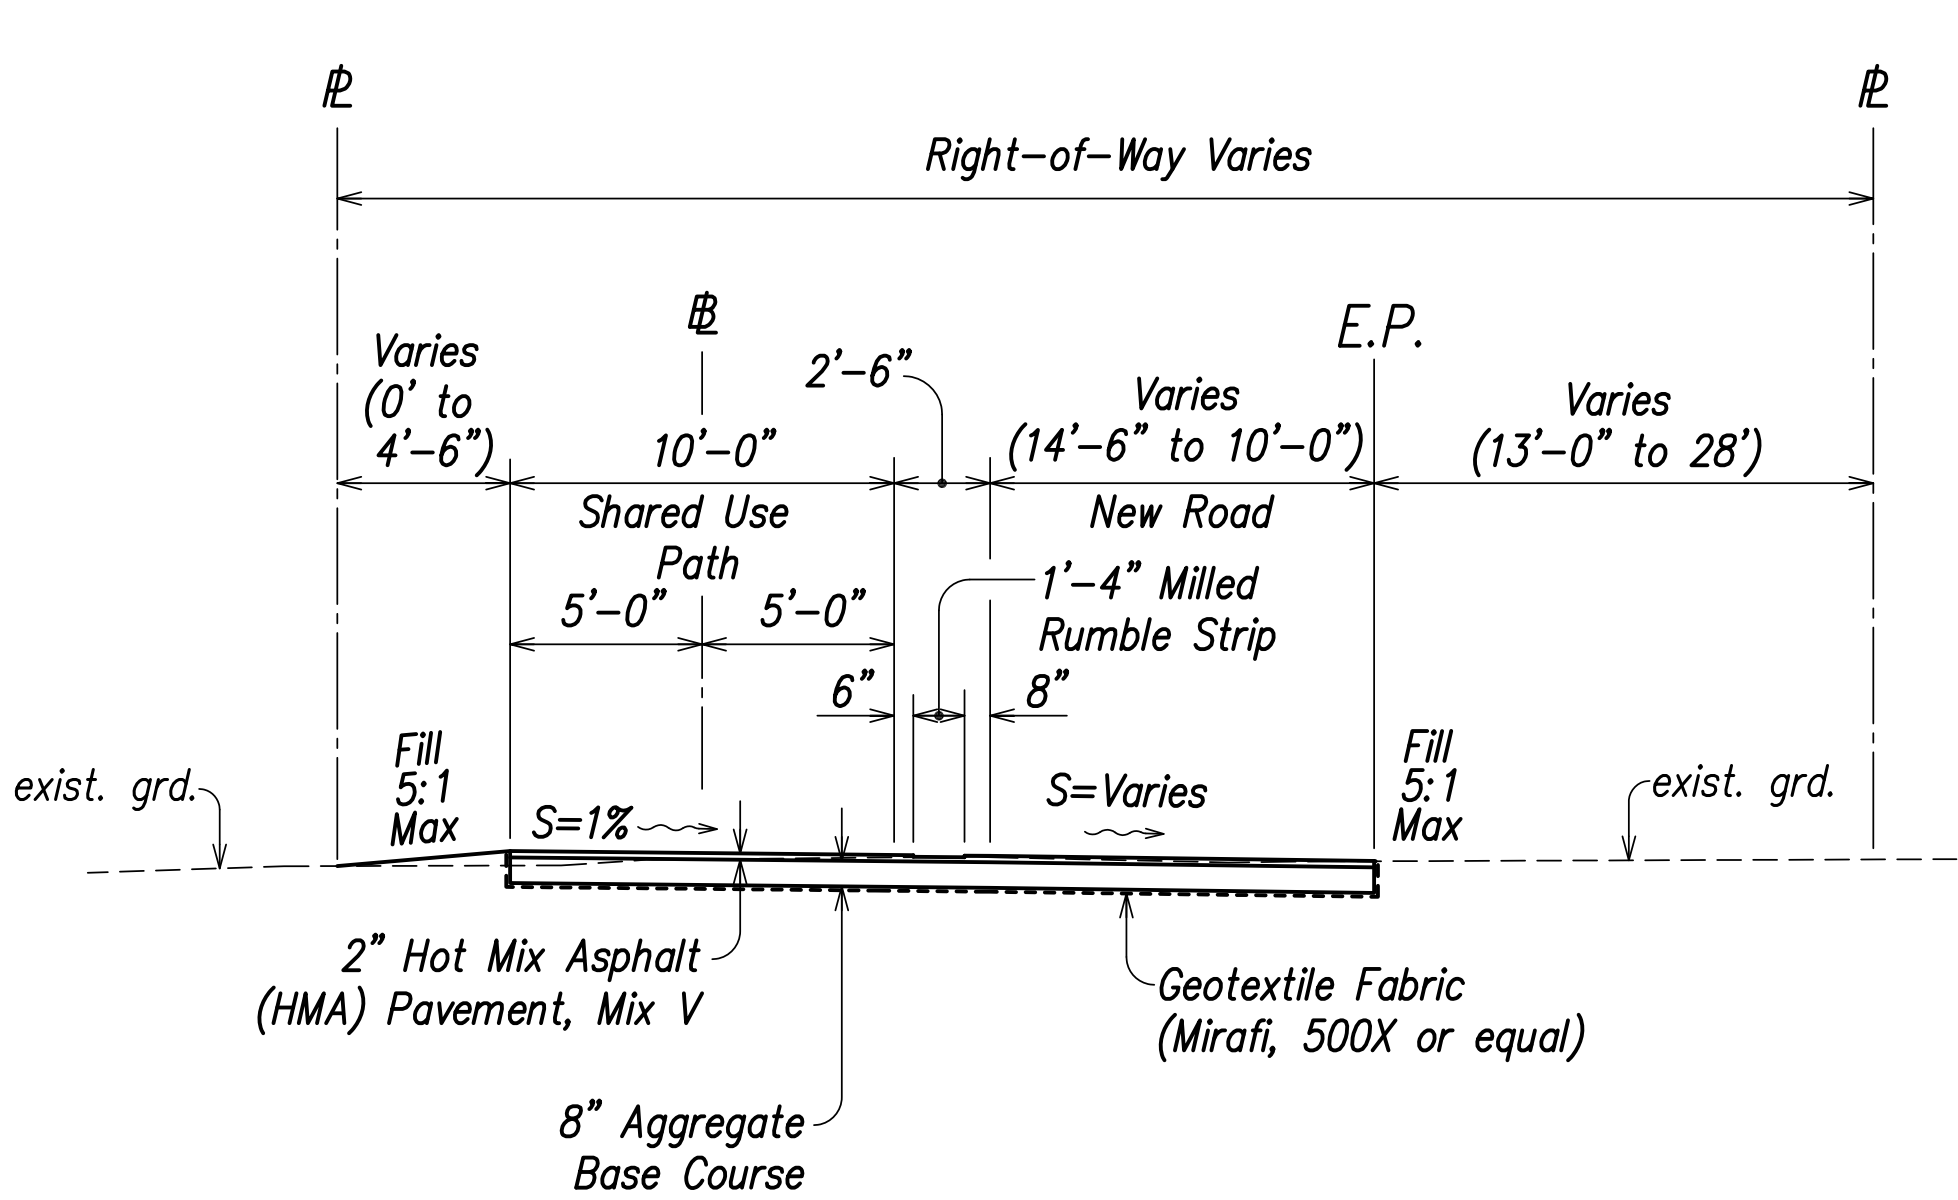


Sta. 0+90.61 to Sta. 1+06.06 Path B-4
Scale: 1" = 5'-0"

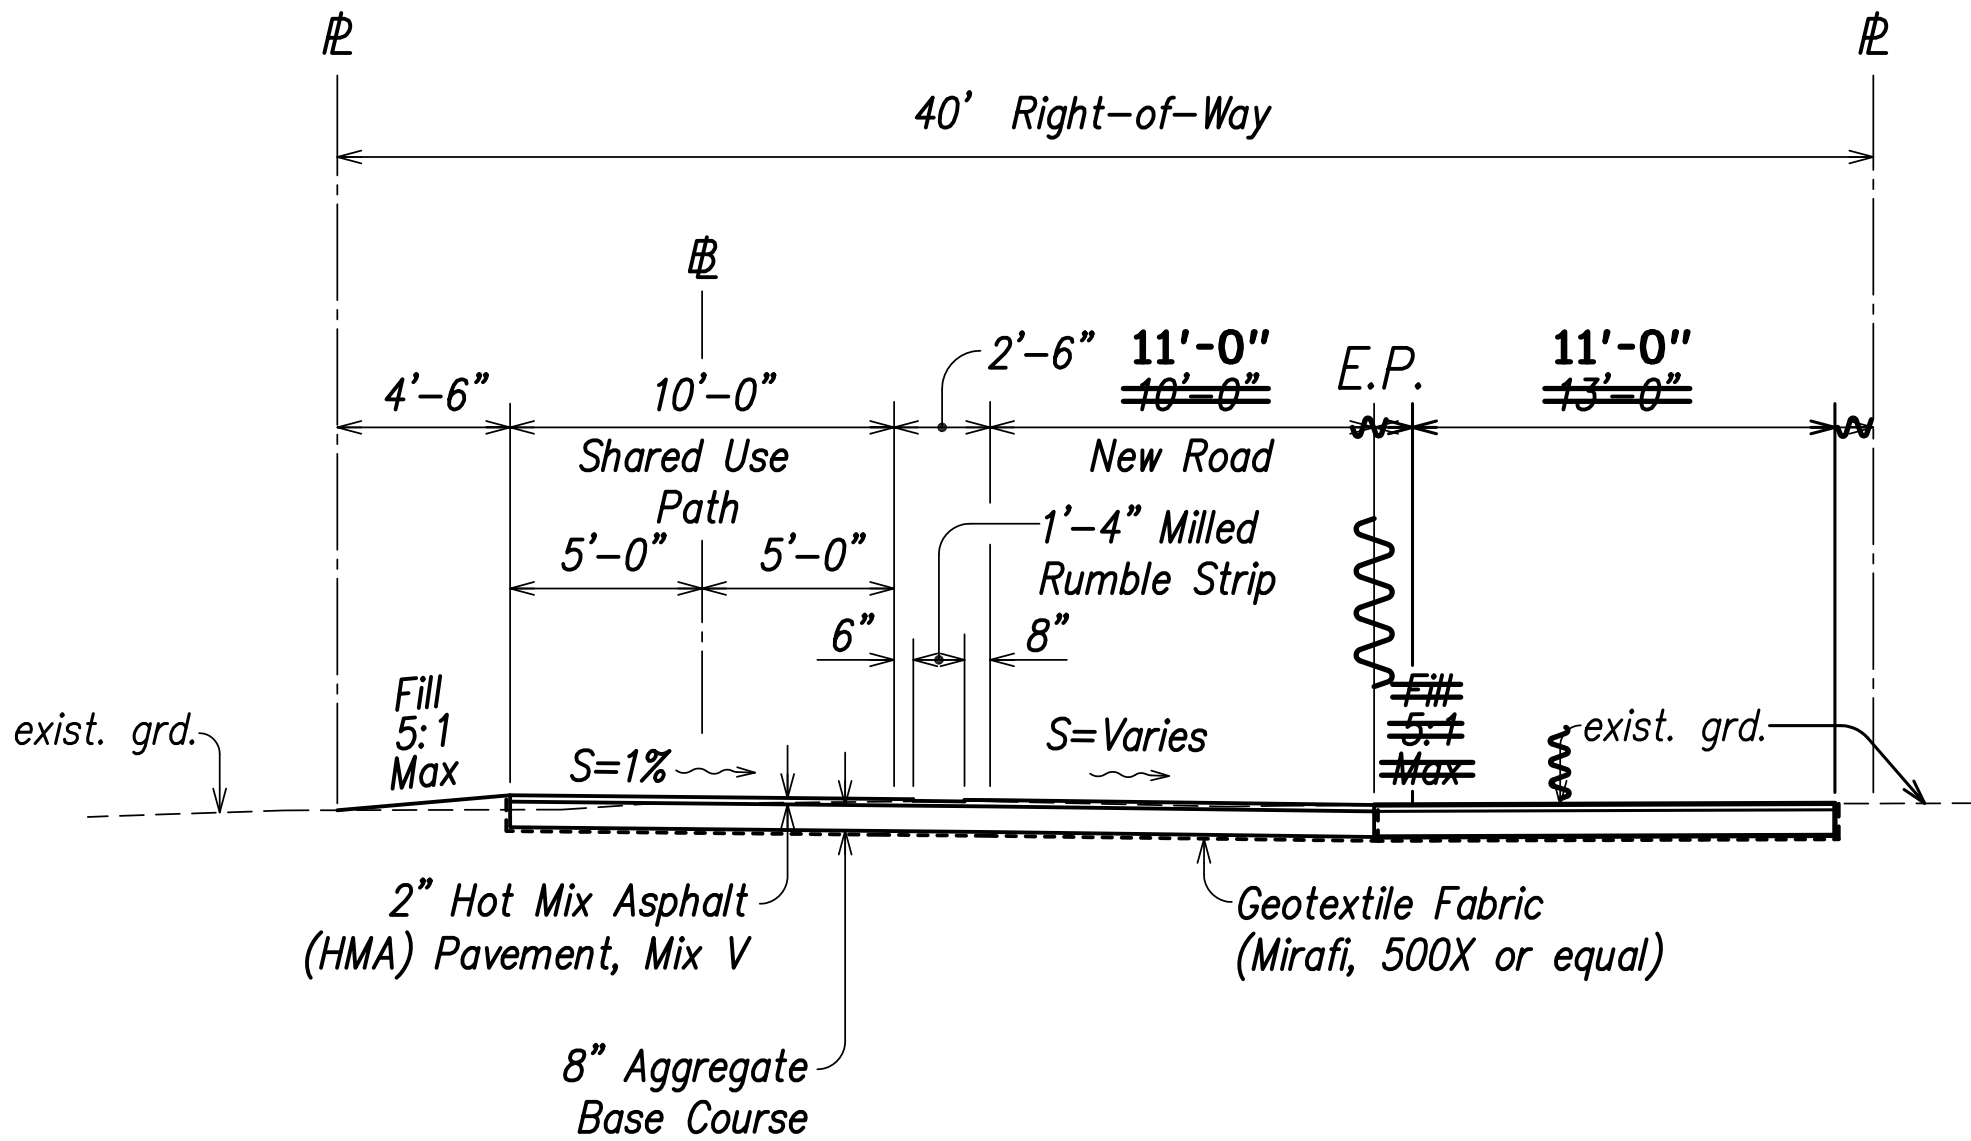


6+25 (Back) and
Sta. 1+06.06 to Sta. 6+50
~~Sta. 8+00 to Sta. 8+75 and~~
Sta. 9+50 to Sta. 16+73.12 Path B-4
11+00 (Foward) Scale: 1" = 5'-0"

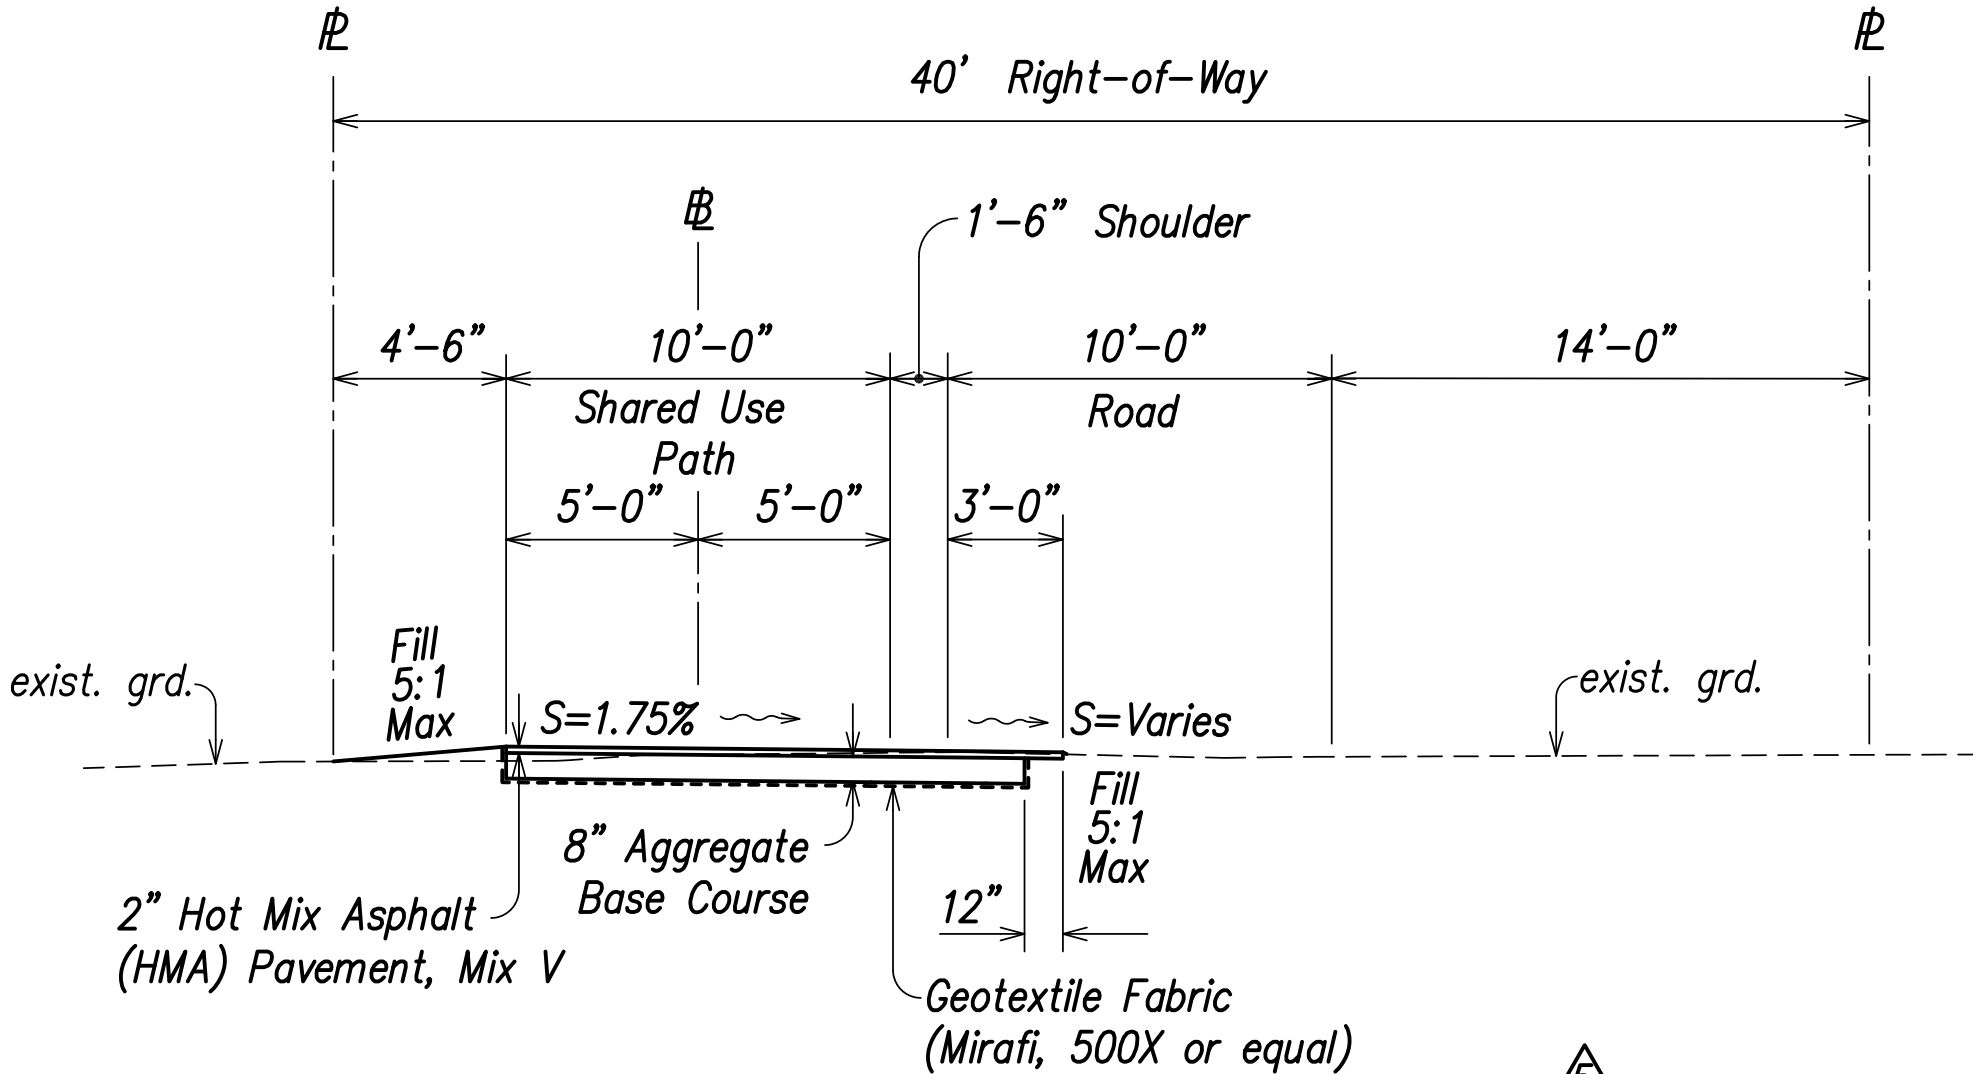


Sta. 6+75 to Sta. 7+75
and Sta. 9+00 to Sta. 9+25 Path B-4
Scale: 1" = 5'-0"

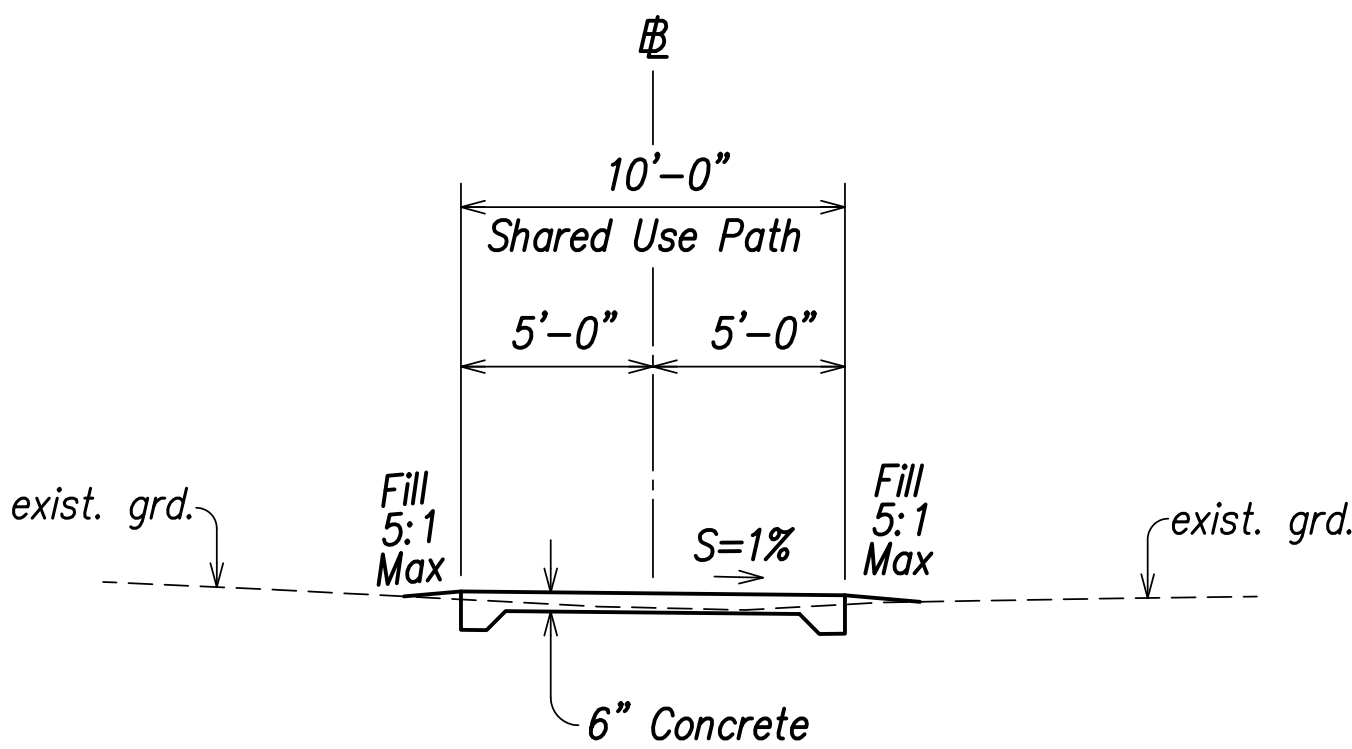

Sta. 0+00 to Sta. 1+25 Path B-5
Scale: 1" = 5'-0"

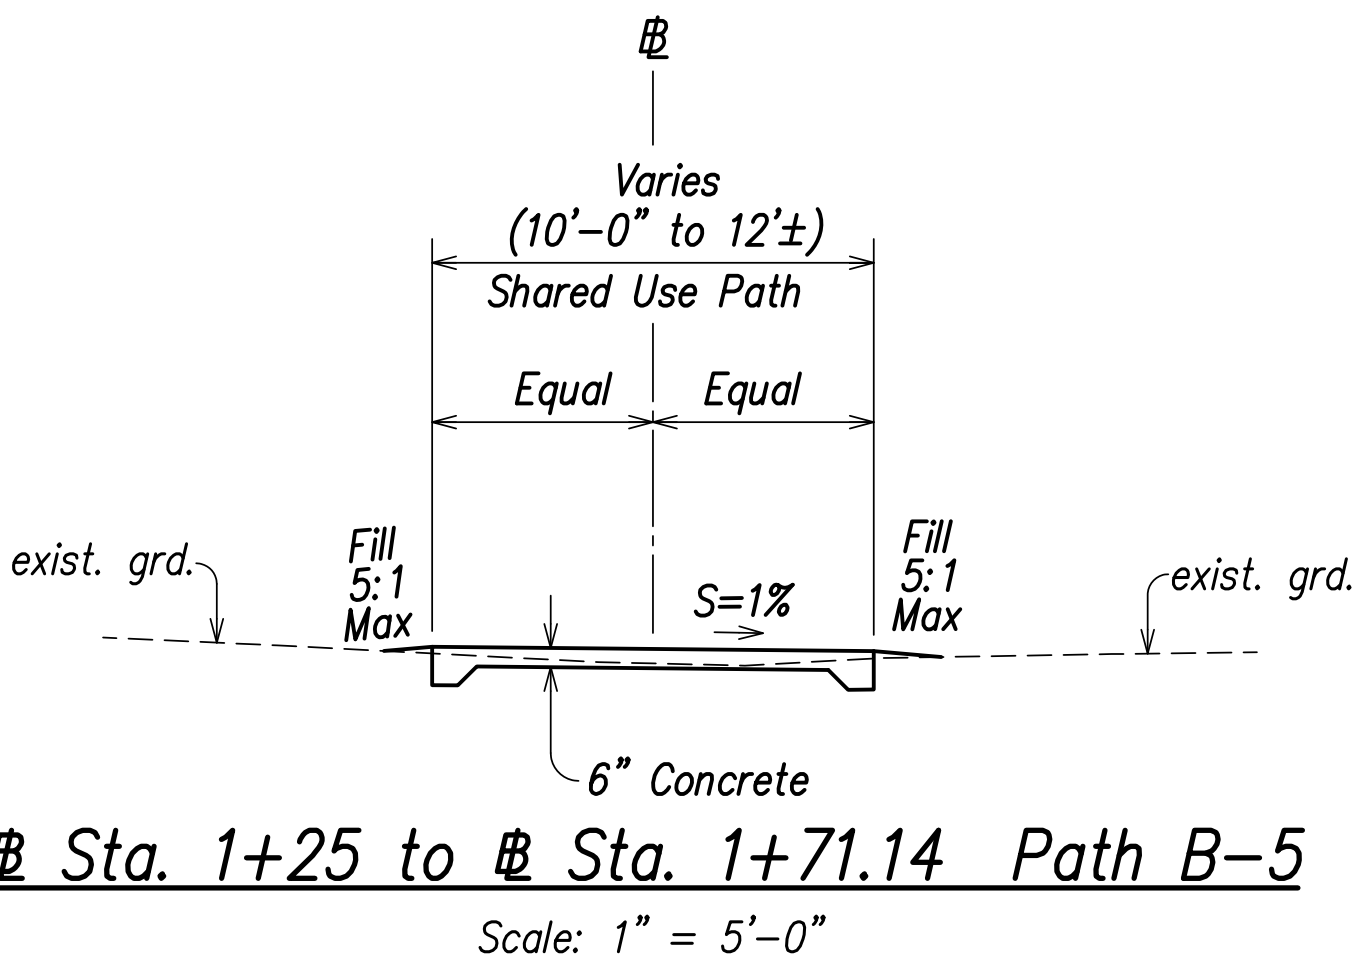


Sta. 1+25 to Sta. 1+71.14 Path B-5
Scale: 1" = 5'-0"

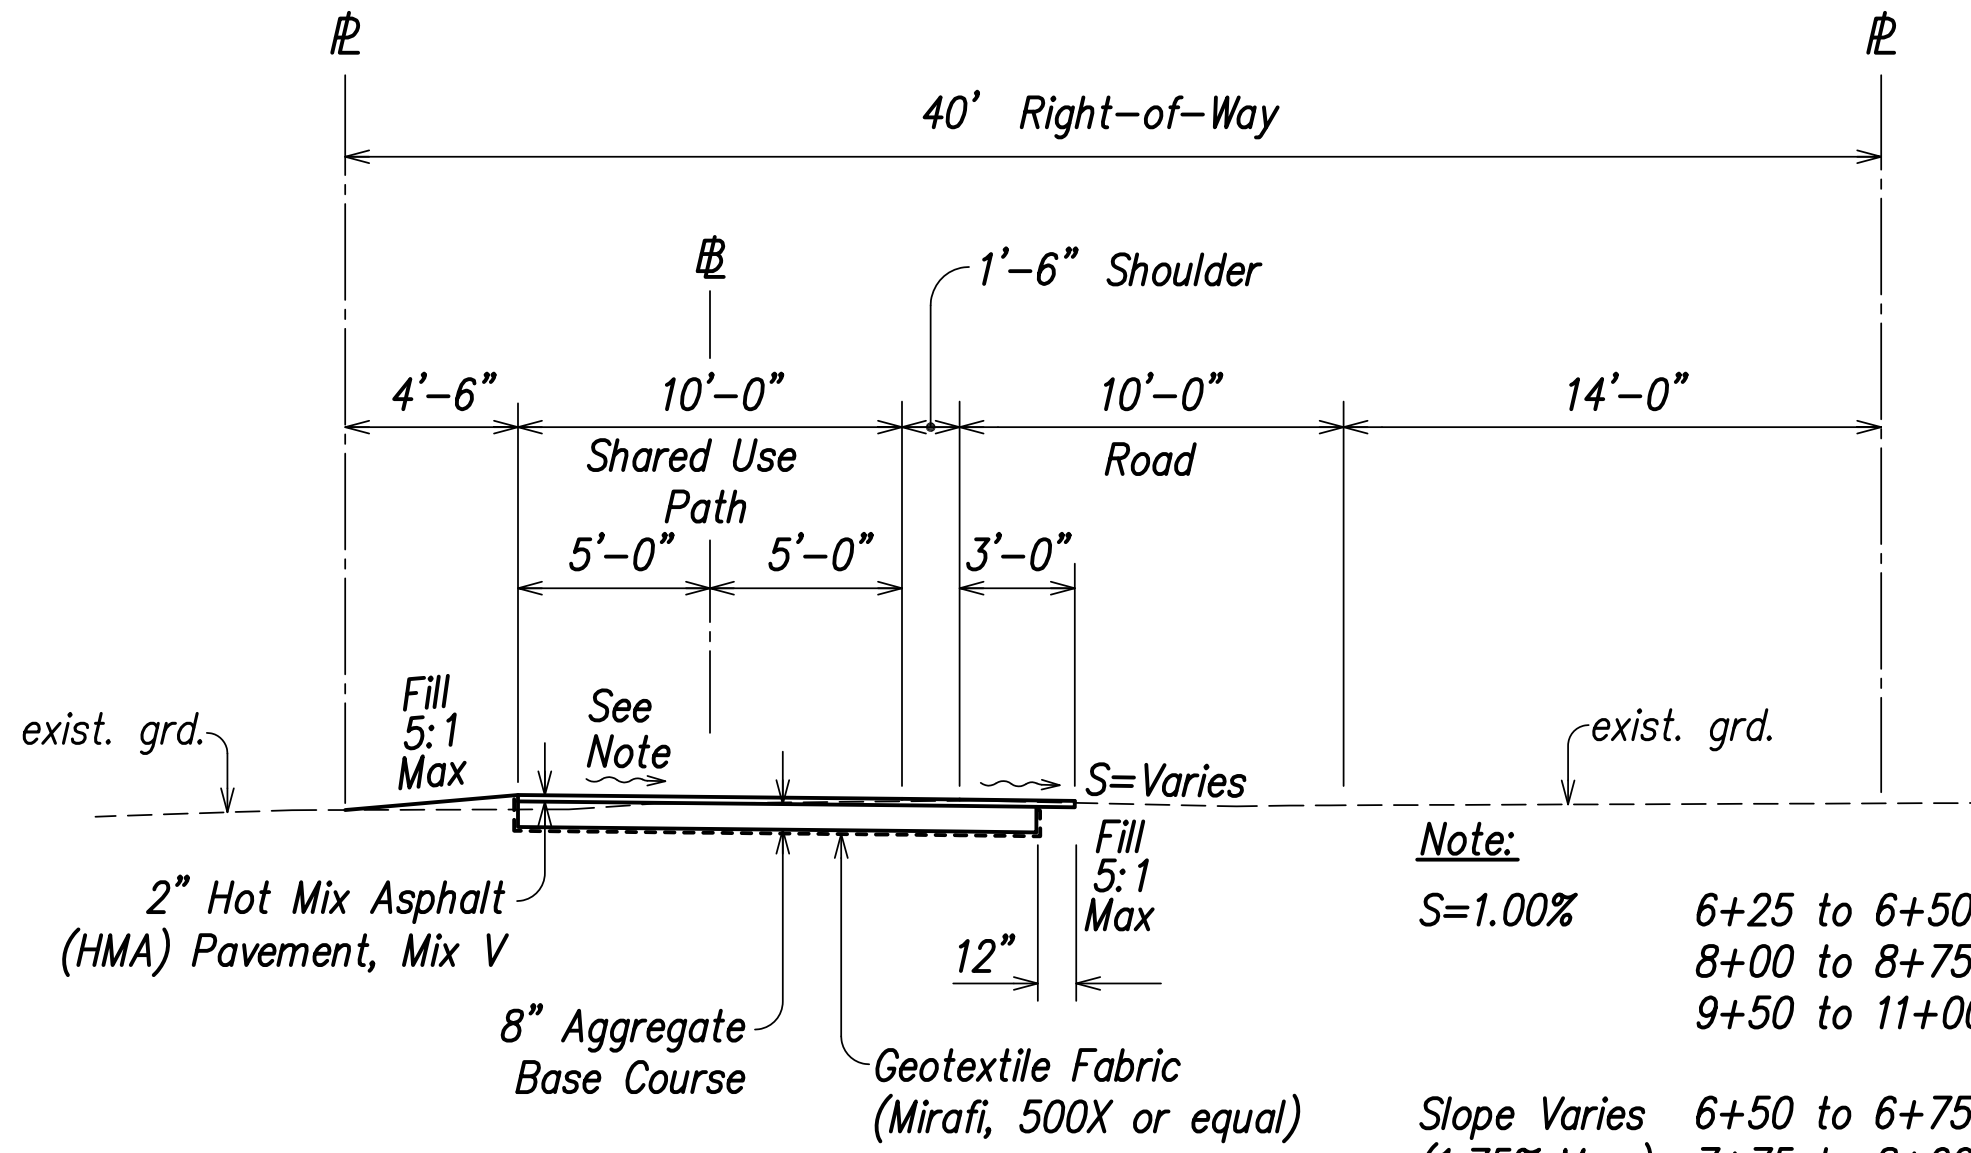

Sta. 6+25 (Foward) to Sta. 6+75,
Sta. 7+75 to Sta. 9+00 and
Sta. 9+25 to Sta. 11+00 (Back) Path B-4
Scale: 1" = 5'-0"

APPROVED:

COUNTY ENGINEER (FOR WORK WITHIN COUNTY RIGHT OF WAY) DATE

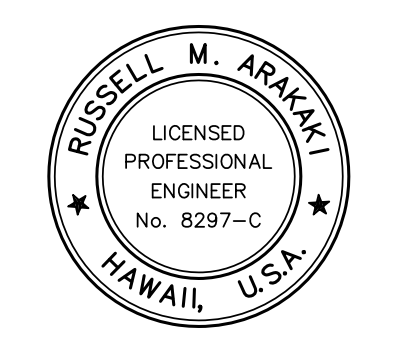

THIS WORK WAS PREPARED BY ME OR UNDER MY SUPERVISION.

Russell M. Araki 4-30-14
SIGNATURE EXPIRATION DATE OF THE LICENSE

DATE	REVISION
4/01/13	Revised Typical Sections
COUNTY OF KAUAI DEPARTMENT OF PUBLIC WORKS LYDGATE PARK TO KAPA'A BIKE/ PEDESTRIAN PATH PHASE B KAPA'A, KAUAI, HAWAII	
TYPICAL SECTIONS - 4	
FEDERAL-AID PROJECT NO. STP-0700(61) DATE: NOVEMBER 2011	
DRAWN BY: NGA	F.B. C.B. SHEET
TRACED BY: RMA	C2.4 OF SHEETS