


DIST. NO.	STATE	PROJ. NO.	FISCAL YEAR	SHEET NO.	TOTAL SHEETS
HAWAII	HAW.	583A-01-71	1971	2	10

GENERAL NOTES:

- The typical sections shown are in general only and is not intended to depict any specific location.
- Leveling of the existing pavement surface and exposing the edges of the existing pavement, shall be the responsibility of the Contractor.
- "Brooming off" shall be considered incidental to the item "Asphalt Concrete Pavement, Mix No. V".
- When paving make smooth connections from the traveled way to driveways, approach roads, intersections and other previously paved areas.
- Patching of all cracks and holes in the existing pavement shall be done in accordance with Section 409 Seal Coat of the Standard Specifications as amended and as directed by the Engineer. This work shall not be measured or paid for directly but shall be considered incidental to "Asphalt Concrete Pavement".
- The contractor shall keep at least one lane open to traffic during working hours and both lanes open to traffic during non-working hours.
- When super is less than 0.063 foot per foot, shoulder slope shall be $\frac{3}{4}$ " per foot. When super is equal to or greater than 0.063 foot per foot, the shoulder slope shall be the same as the rate of super. This note applies only to the shoulder on the lower side of the super.
- All tractor crossings presently being used shall not be resurfaced.
- The contractors attention is directed to Sub-section 104.08 Availability of funds of the Special Provisions.
- Trimming and dressing shoulders shall include but not be limited to clearing, grubbing, grading and compacting the shoulder area as shown on the "Typical Sections". This item shall not be paid for directly but shall be considered incidental to the various contract items.
- In general, existing paved parking areas adjacent to the edges of pavement shall be repaved.


CONSTRUCTION NOTE:

- Contractor shall install at Sta. 34+00 Right, warning sign, designation W1-2L and at Sta. 44+00 Left, W1-2R

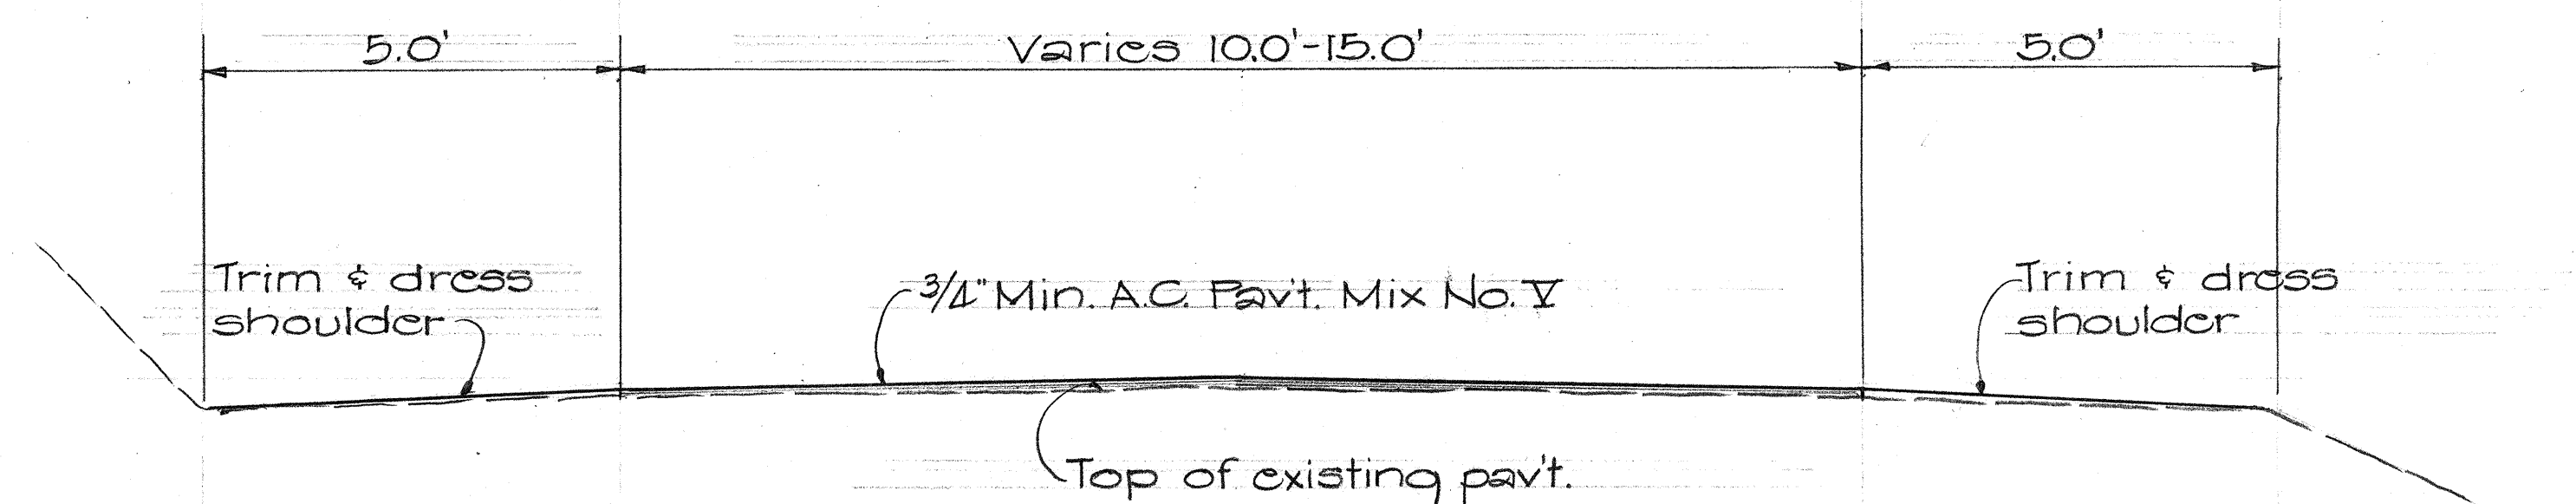


TYPICAL SECTION ON TANGENT

Scale: $\frac{1}{2}$ " = 1'-0"

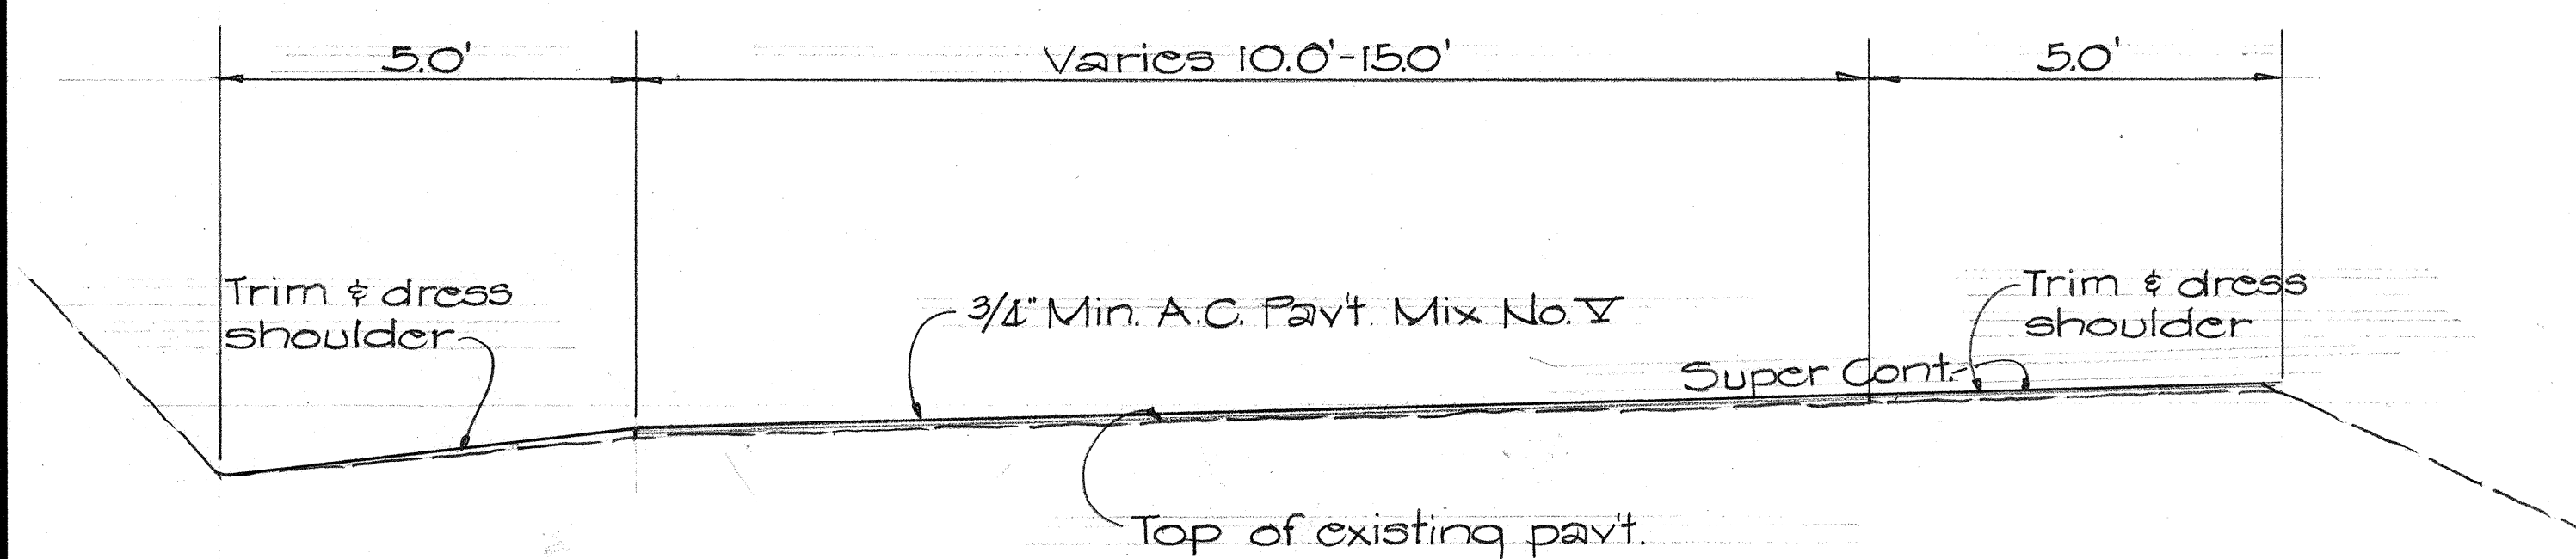

TYPICAL SECTION OF CURVE

Scale: $\frac{1}{2}$ " = 1'-0"

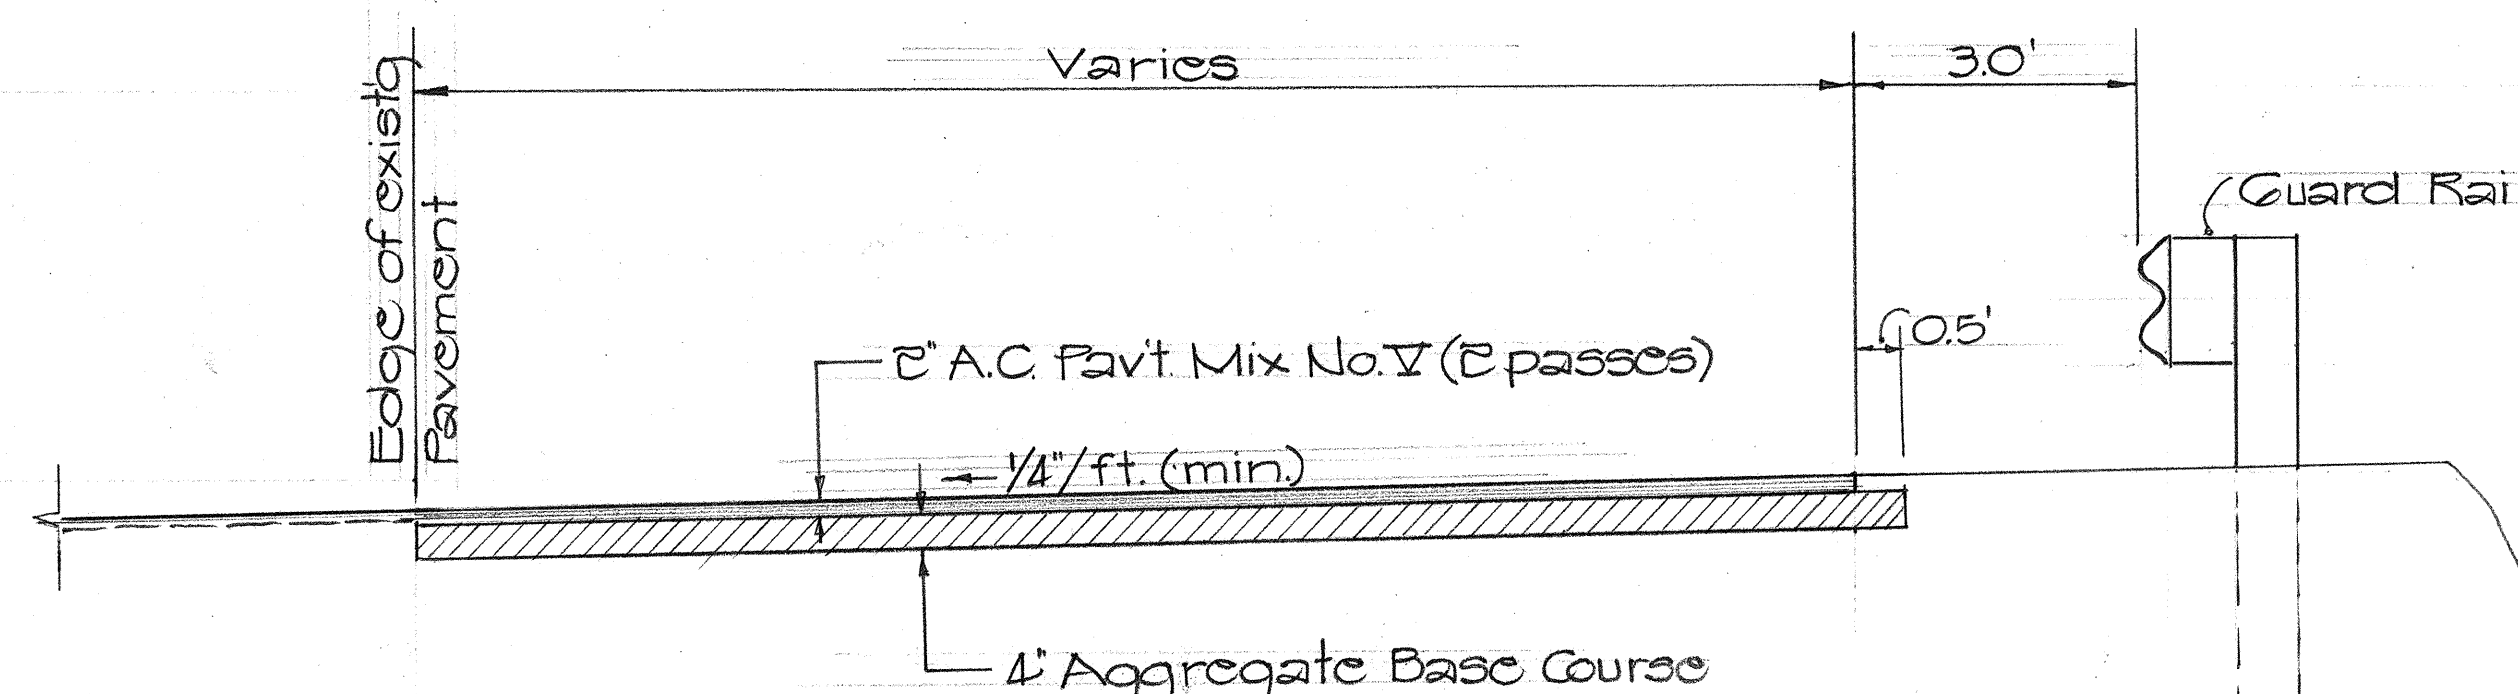

TYPICAL SECTION OF PARKING APRON

Scale: $\frac{1}{2}$ " = 1'-0"

SURVEY PLATTED BY	DATE
DESIGNED BY	
QUANTITIES BY	
CHECKED BY	
ORIGINAL PLAN	
NOTE BOOK	
No.	

STATE OF HAWAII DEPARTMENT OF TRANSPORTATION HIGHWAYS DIVISION	
TYPICAL SECTION & NOTES	
RESURFACING A PORTION OF MAALO ROAD	
PROJ. NO 583A-01-71	
Scale: As Shown	Sept. 1970
SHEET No. 1 OF 1 SHEETS	