INDEX TO DRAWINGS	
SHEET NO.	DESCRIPTION
1	TITLE SHEET
2	STANDARD PLANS SUMMARY
3	GENERAL NOTES
4	TYPICAL SECTION
5 – 11	ROADWAY PLAN
12 – 17	TRAFFIC MARKING AND SIGN PLAN
18	TRAFFIC SUMMARIES AND PAVEMENT
	MARKING & STRIPING
	· .

STATE OF HAWAII


## DEPARTMENT OF TRANSPORTATION

HIGHWAYS DIVISION
HONOLULU, HAWAII

"AS-BUILT"
PLANS FOR

## MAALO ROAD RESURFACING M.P. 0.00 TO M.P. 1.90 PROJECT NO. 583A-01-95M


DISTRICT OF LIHUE ISLAND OF KAUAI

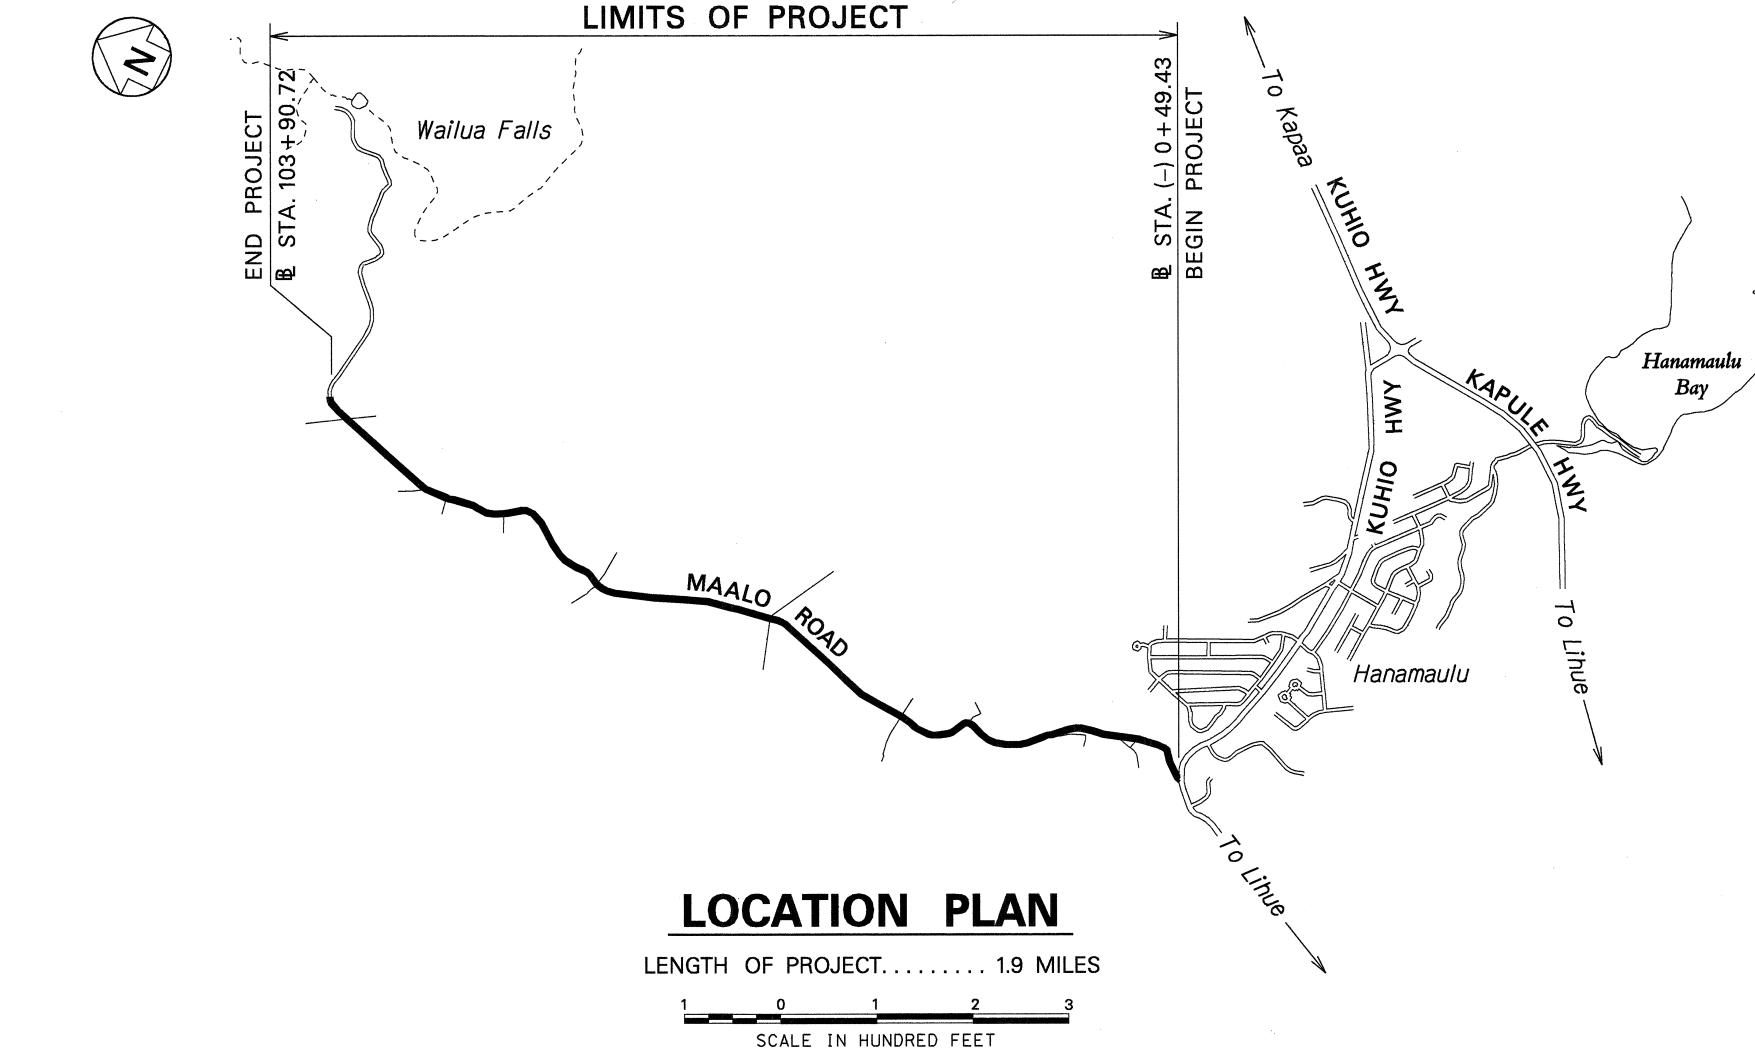


FED. ROAD DIST. NO. STATE PROJ. NO. FISCAL YEAR NO. SHEETS

HAWAII HAW. 583A-01-95M 1995 1 18



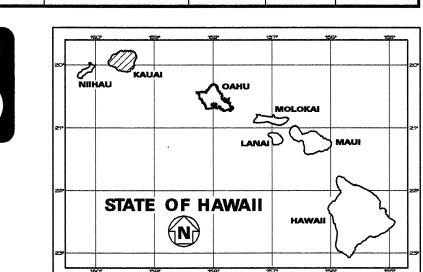

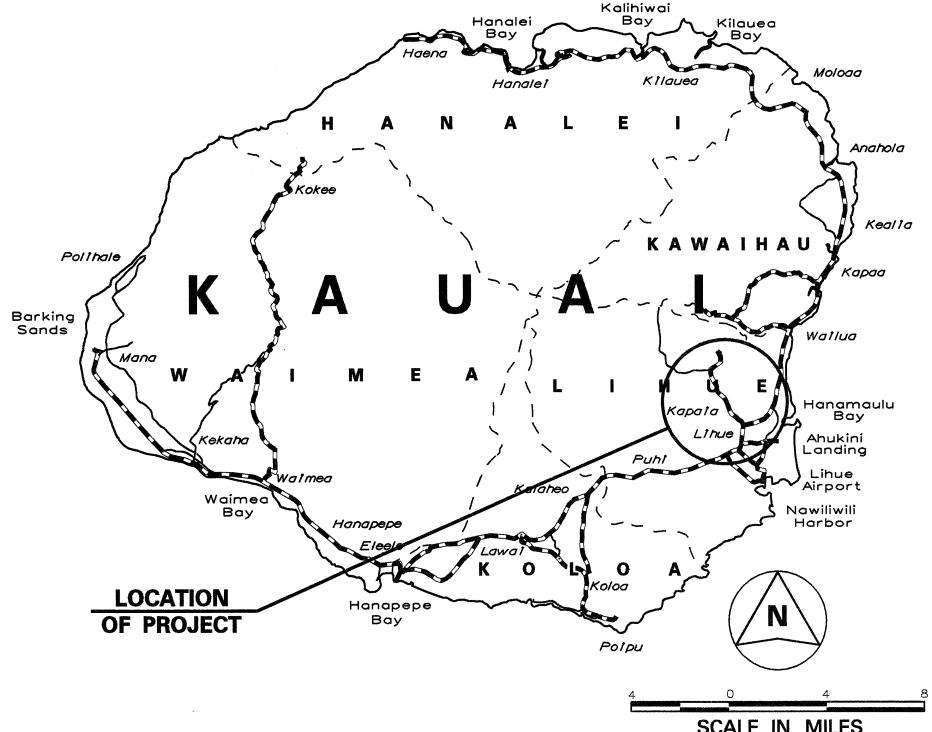

---- FEDERAL AID PROJECTS PREVIOUSLY CONSTRUCTED OR UNDER CONSTRUCTION

MILE POST 0.00 TO MILE POST 1.90

NO SIGNIFICANT CHANGES WERE MADE DURING CONSTRUCTION ON THESE PLANS EXCEPT CHANGES IN THE ORIGINAL THEORETICAL QUANTITIES. FOR ACTUAL QUANTITIES, REFER TO PROJECT LEDGER AND/OR COMPUTATION BOOK.

D. Maeda by: Mys RESIDENT ENGINEER

9-22-97 DATE

DEPARTMENT OF TRANSPORTATION STATE OF HAWAII

APPROVED:

DIR. OF TRANSPORTATION DATE

1