

|                     |       |            |             |           |              |
|---------------------|-------|------------|-------------|-----------|--------------|
| FED. ROAD DIST. NO. | STATE | PROJ. NO.  | FISCAL YEAR | SHEET NO. | TOTAL SHEETS |
| HAWAII              | HAW.  | 583-01-95M | 1995        | 18        | 18           |

| TRAFFIC SIGN SUMMARY |                                       |                    |          |                         |           |
|----------------------|---------------------------------------|--------------------|----------|-------------------------|-----------|
| SIGN NO.             | MESSAGE                               | QUANTITY           |          |                         |           |
|                      |                                       | 10 SQ. FT. OR LESS |          | GREATER THAN 10 SQ. FT. |           |
|                      |                                       | W/POST             | W/O POST | W/POSTS                 | W/O POSTS |
| RI-1                 | "STOP"                                | 2                  |          |                         |           |
| R2-1(25)             | "SPEED LIMIT 25"                      |                    |          | 3                       |           |
| W1-1(L)              | CURVE AHEAD (PICTORIAL)               | 1                  |          |                         |           |
| W1-1(R)              | CURVE AHEAD (PICTORIAL)               | 1                  |          |                         |           |
| W1-6(L)              | SHARP CHANGE IN ALIGNMENT (PICTORIAL) | 1                  |          |                         |           |
| W1-6(R)              | SHARP CHANGE IN ALIGNMENT (PICTORIAL) | <del>2</del> 1     |          |                         |           |
| W8-6                 | "TRUCK CROSSING"                      | 2                  |          |                         |           |
| W5-2                 | NARROW BRIDGE                         |                    |          |                         |           |
|                      | TOTAL                                 | <del>4</del> 8     |          | 3                       |           |

| REFLECTOR MARKER SUMMARY |          |       |                 |       |                 |       |
|--------------------------|----------|-------|-----------------|-------|-----------------|-------|
| TYPE                     | QUANTITY |       |                 |       |                 |       |
|                          | W/O POST |       | W/FLEXIBLE POST |       | W/STEEL POST    |       |
|                          | YELLOW   | WHITE | YELLOW          | WHITE | YELLOW          | WHITE |
| RM-3                     | 33       |       |                 |       | <del>2</del> 19 |       |
| RM-4                     |          |       |                 |       | 4               |       |
| OM-TYPE II               | 61       |       |                 |       |                 |       |

| ROUTE MARKER SUMMARY |                                                                          |     |                 |          |                 |          |
|----------------------|--------------------------------------------------------------------------|-----|-----------------|----------|-----------------|----------|
| SIGN ASSEMBLY        | SIGN NO. AND MESSAGE                                                     |     | TYPE A ASSEMBLY |          | TYPE B ASSEMBLY |          |
|                      |                                                                          |     | W/POST          | W/O POST | W/POST          | W/O POST |
| SRM-1                | M1-6                                                                     | 583 | 1               |          |                 |          |
| SRM-2                | M3-1 NORTH<br>M1-6 56<br>M6-1(L) ←<br>M3-1 SOUTH<br>M1-6 56<br>M6-1(R) → |     |                 |          | ≠               | 1        |
|                      | TOTAL                                                                    |     | 1               |          | ≠               | 1        |

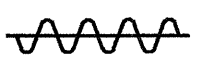
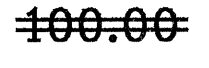
| CONSTRUCTION SIGN SUMMARY |                         |         |          |
|---------------------------|-------------------------|---------|----------|
| SIGN NO.                  | MESSAGE                 | W/POSTS | W/O POST |
| CG20-2                    | END CONSTRUCTION        | 2       | ---      |
| CW20-1d                   | ROAD CONSTRUCTION AHEAD | 2       | ---      |

| MILEPOST MARKER SUMMARY |       |          |          |
|-------------------------|-------|----------|----------|
| SIGN NO. AND MESSAGE    |       | QUANTITY |          |
|                         |       | W/POST   | W/O POST |
| D10-1                   | 0     | 1        | ---      |
| D10-7                   | 583   |          |          |
| D10-1                   | 1     | 1        | ---      |
| D10-7                   | 583   |          |          |
| D10-1                   | 2     | 1        | ---      |
| D10-7                   | 583   |          |          |
|                         | TOTAL | 3        | ---      |

| PAVEMENT MARKING SUMMARY                                                                                                  |                           |
|---------------------------------------------------------------------------------------------------------------------------|---------------------------|
| DESCRIPTION                                                                                                               | QUANTITY                  |
| PAVEMENT MARKERS<br>TYPE C _____<br>TYPE D _____                                                                          | 525 EA.<br>525 EA.        |
| TAPE - TYPE I OR THERMOPLASTIC EXTRUSION<br>DOUBLE 4-INCH PAVEMENT STRIPE (YELLOW) _____                                  | 10,485 L.F.               |
| TAPE - TYPE II OR THERMOPLASTIC EXTRUSION<br>4-INCH PAVEMENT STRIPE (WHITE) _____<br>8-INCH PAVEMENT STRIPE (WHITE) _____ | 19,150 L.F.<br>1,820 L.F. |

NOTES:

- Tape, Type I or Thermoplastic Extrusion (No Passing Zones, Channelizing Lines or Solid Lines)
- Tape, Type II or Thermoplastic Extrusion (Transverse Median Markings, Transverse Shoulder Markings, Channelizing Islands or Edge Striping)
- Tape, Type III or Thermoplastic Extrusion (Guide Lines Pavement Words or Pavement Arrows)

| LEGEND FOR AS-BUILT POSTINGS                                                          |                                     |
|---------------------------------------------------------------------------------------|-------------------------------------|
|  | Squiggly line for as-built deletion |
|  | Double line for as-built deletion   |
| Roadway                                                                               | Text for as-built posting           |

|                                                                      |
|----------------------------------------------------------------------|
| STATE OF HAWAII<br>DEPARTMENT OF TRANSPORTATION<br>HIGHWAYS DIVISION |
| <b>TRAFFIC SUMMARIES AND PAVEMENT MARKING SUMMARY</b>                |
| MAALO ROAD RESURFACING                                               |
| M.P. 0.00 TO M.P. 1.90                                               |
| Project No. 583A-01-95M                                              |
| Scale: No Scale      Date: April, 1995                               |
| SHEET No. 1 OF 1 SHEETS                                              |

|               |                   |      |
|---------------|-------------------|------|
| ORIGINAL PLAN | SURVEY PLOTTED BY | DATE |
| NOTED BOOK    | DRAWN BY          |      |
| DESIGNED BY   | TRACED BY         |      |
| CHECKED BY    | DESIGNED BY       |      |
|               | CHECKED BY        |      |