




FED. ROAD DIST. NO.	STATE	PROJ. NO.	FISCAL YEAR	SHEET NO.	TOTAL SHEETS
HAWAII	HAW.	583A-01-95M	1995	5	18

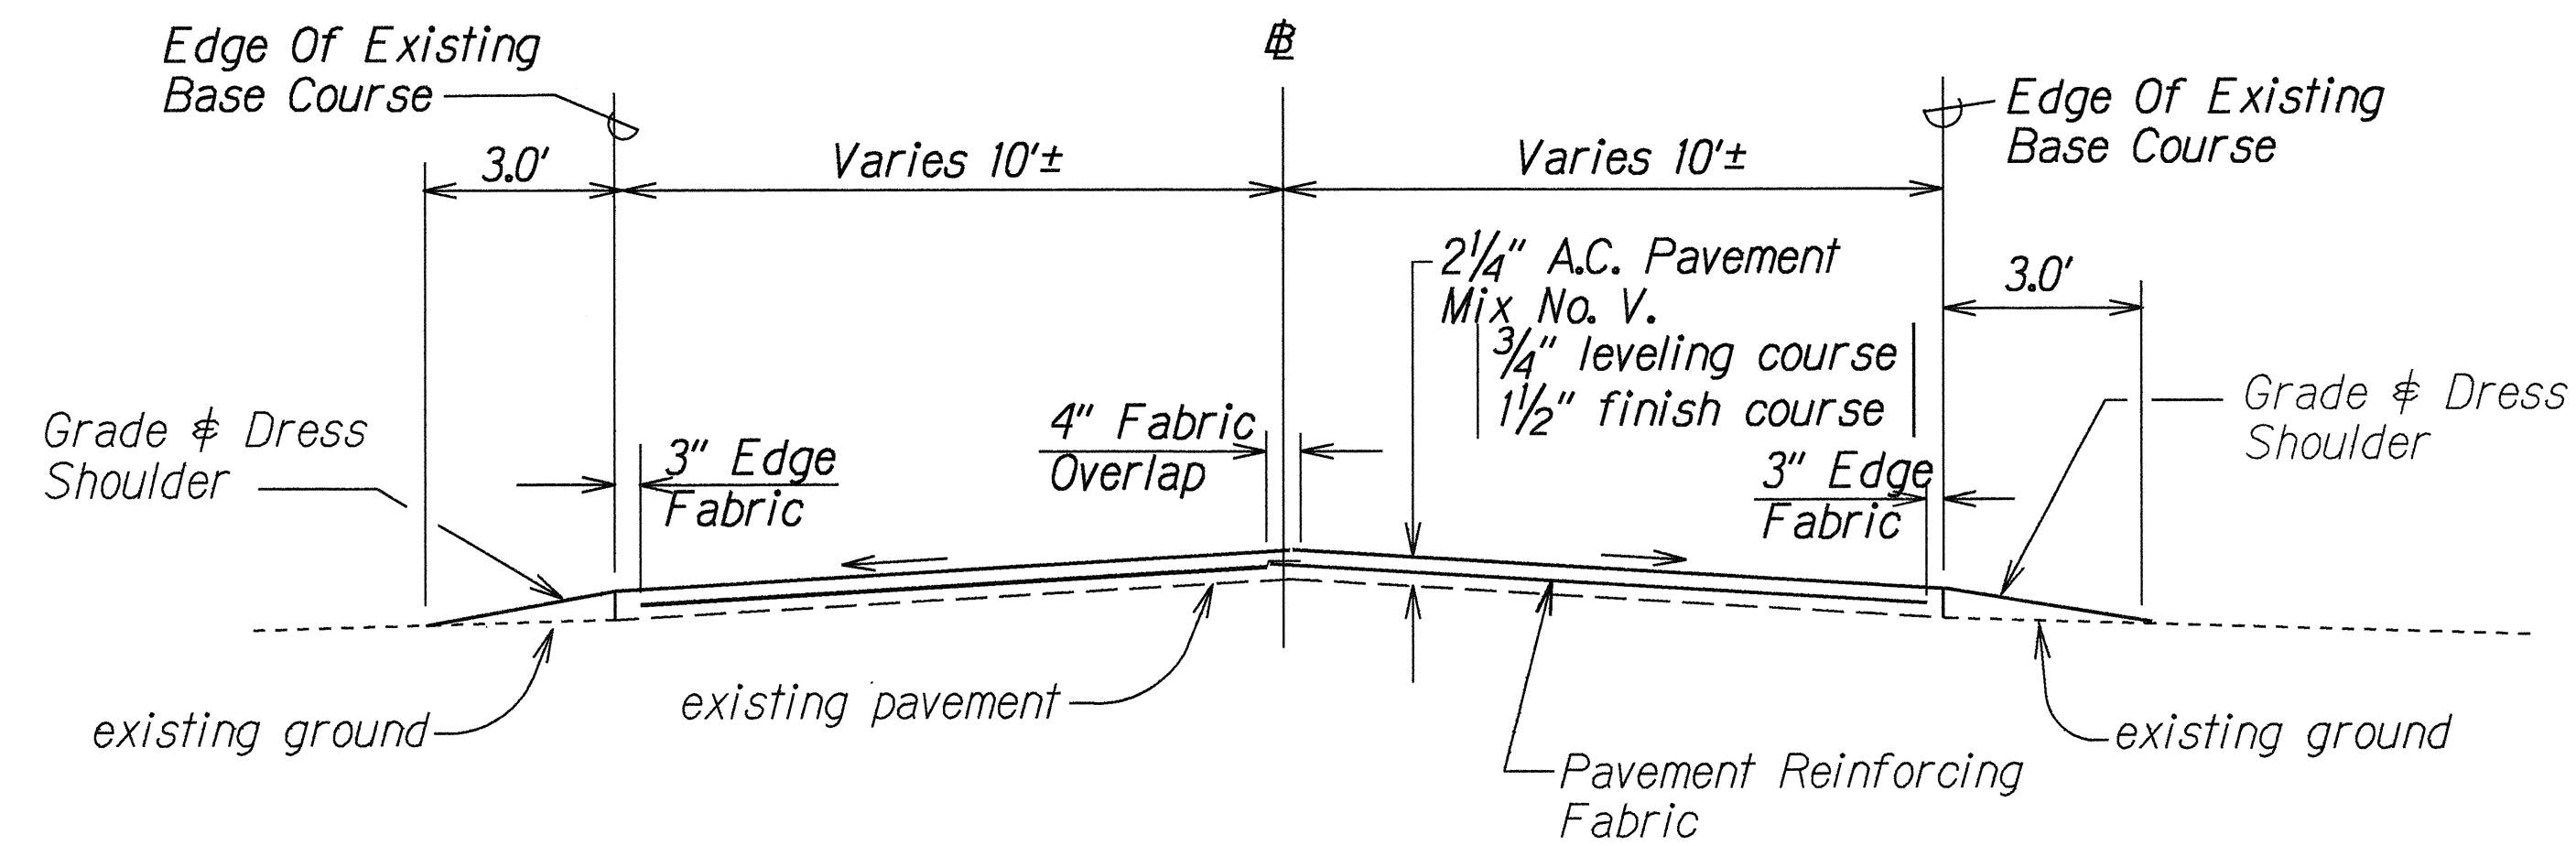


TYPICAL SECTION ON TANGENT
Scale: 3/8"=1'-0"

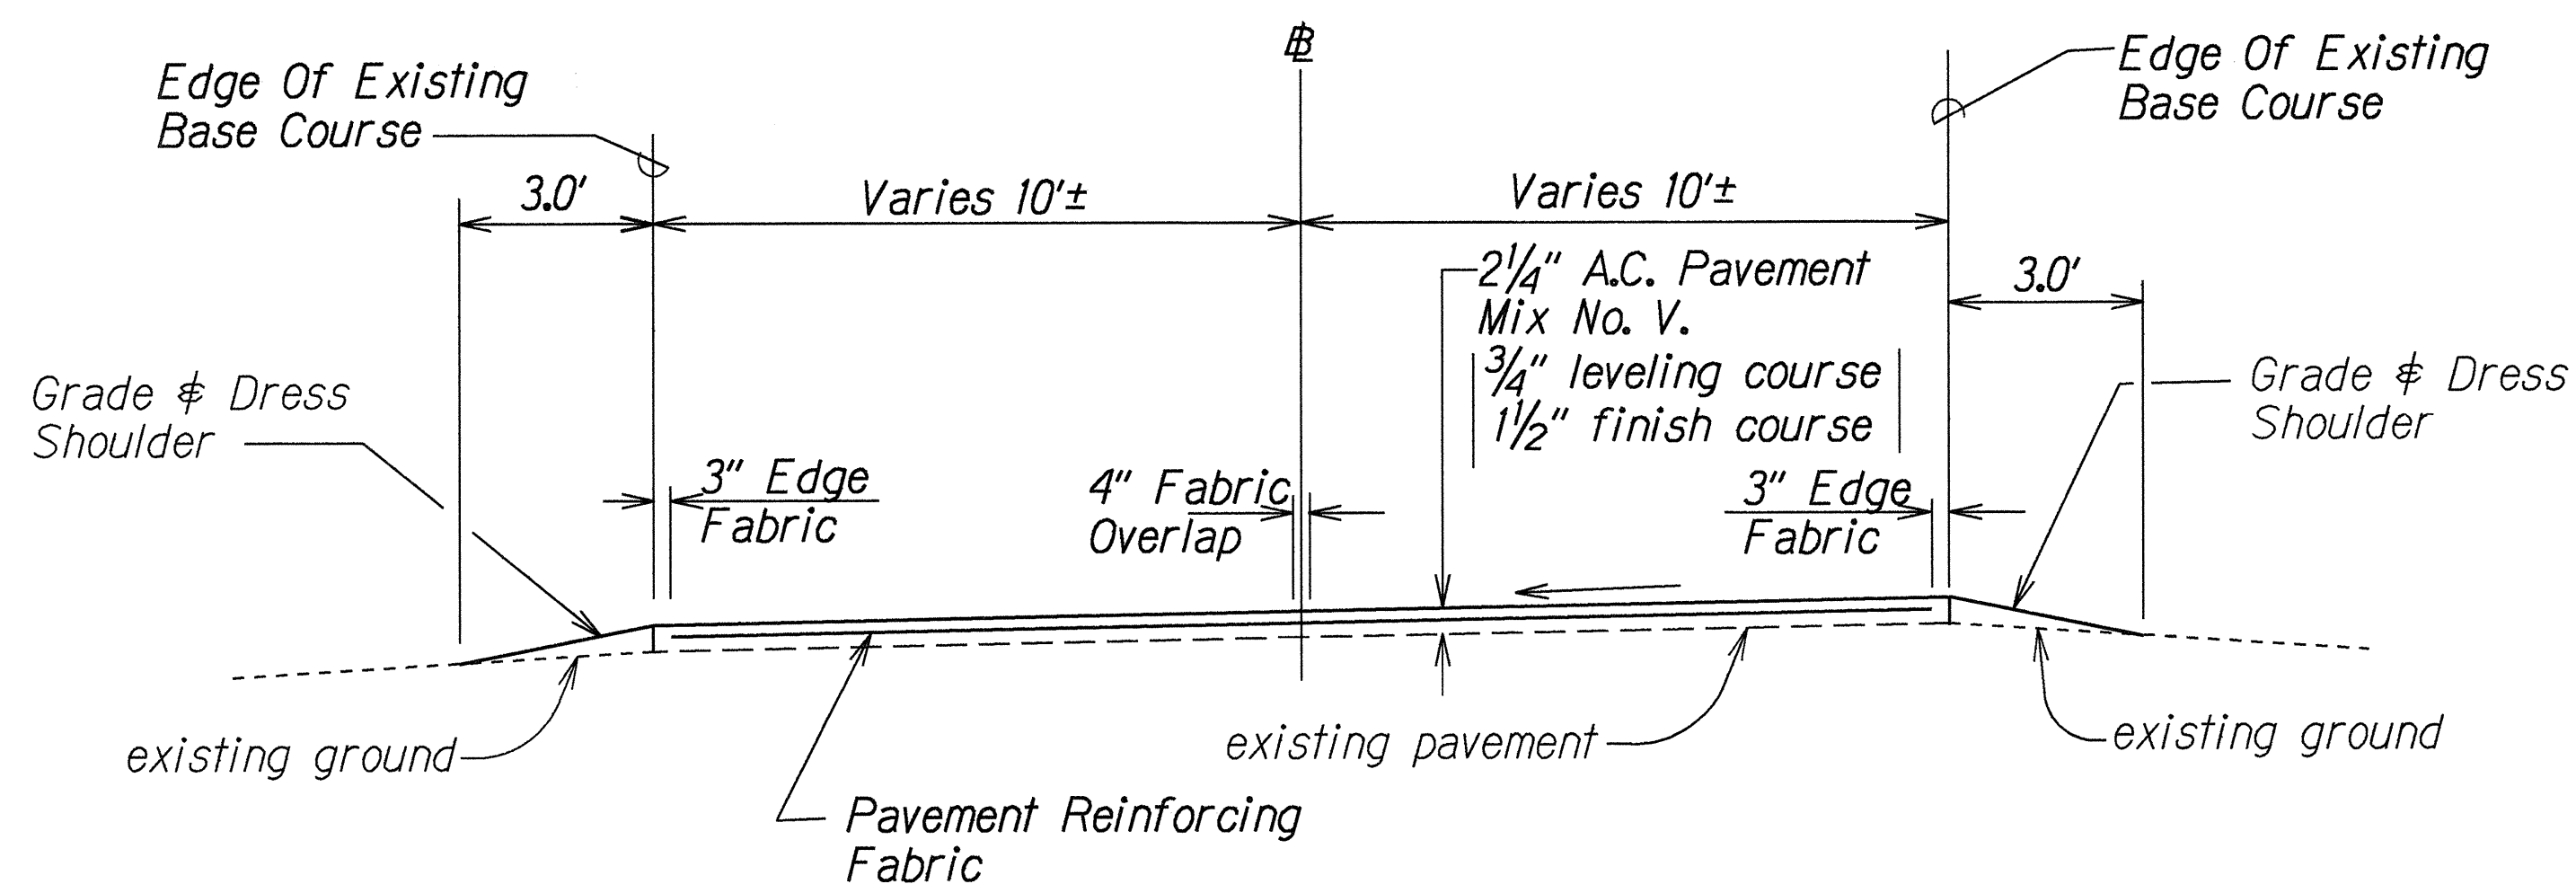


TYPICAL SECTION ON CURVE
Scale: 3/8"=1'-0"

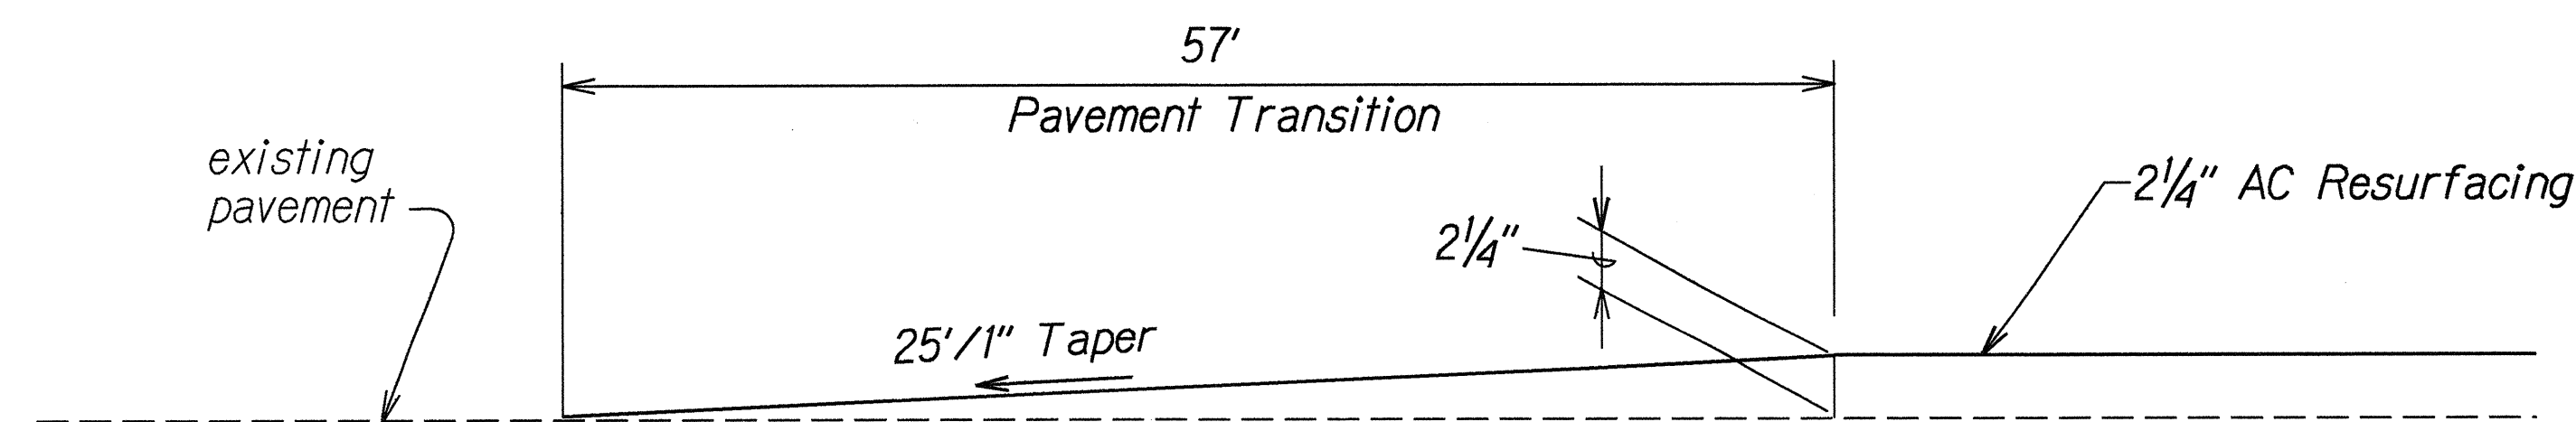

PAVEMENT TRANSITION AT BEGINNING AND AT END OF PROJECT
Not to Scale

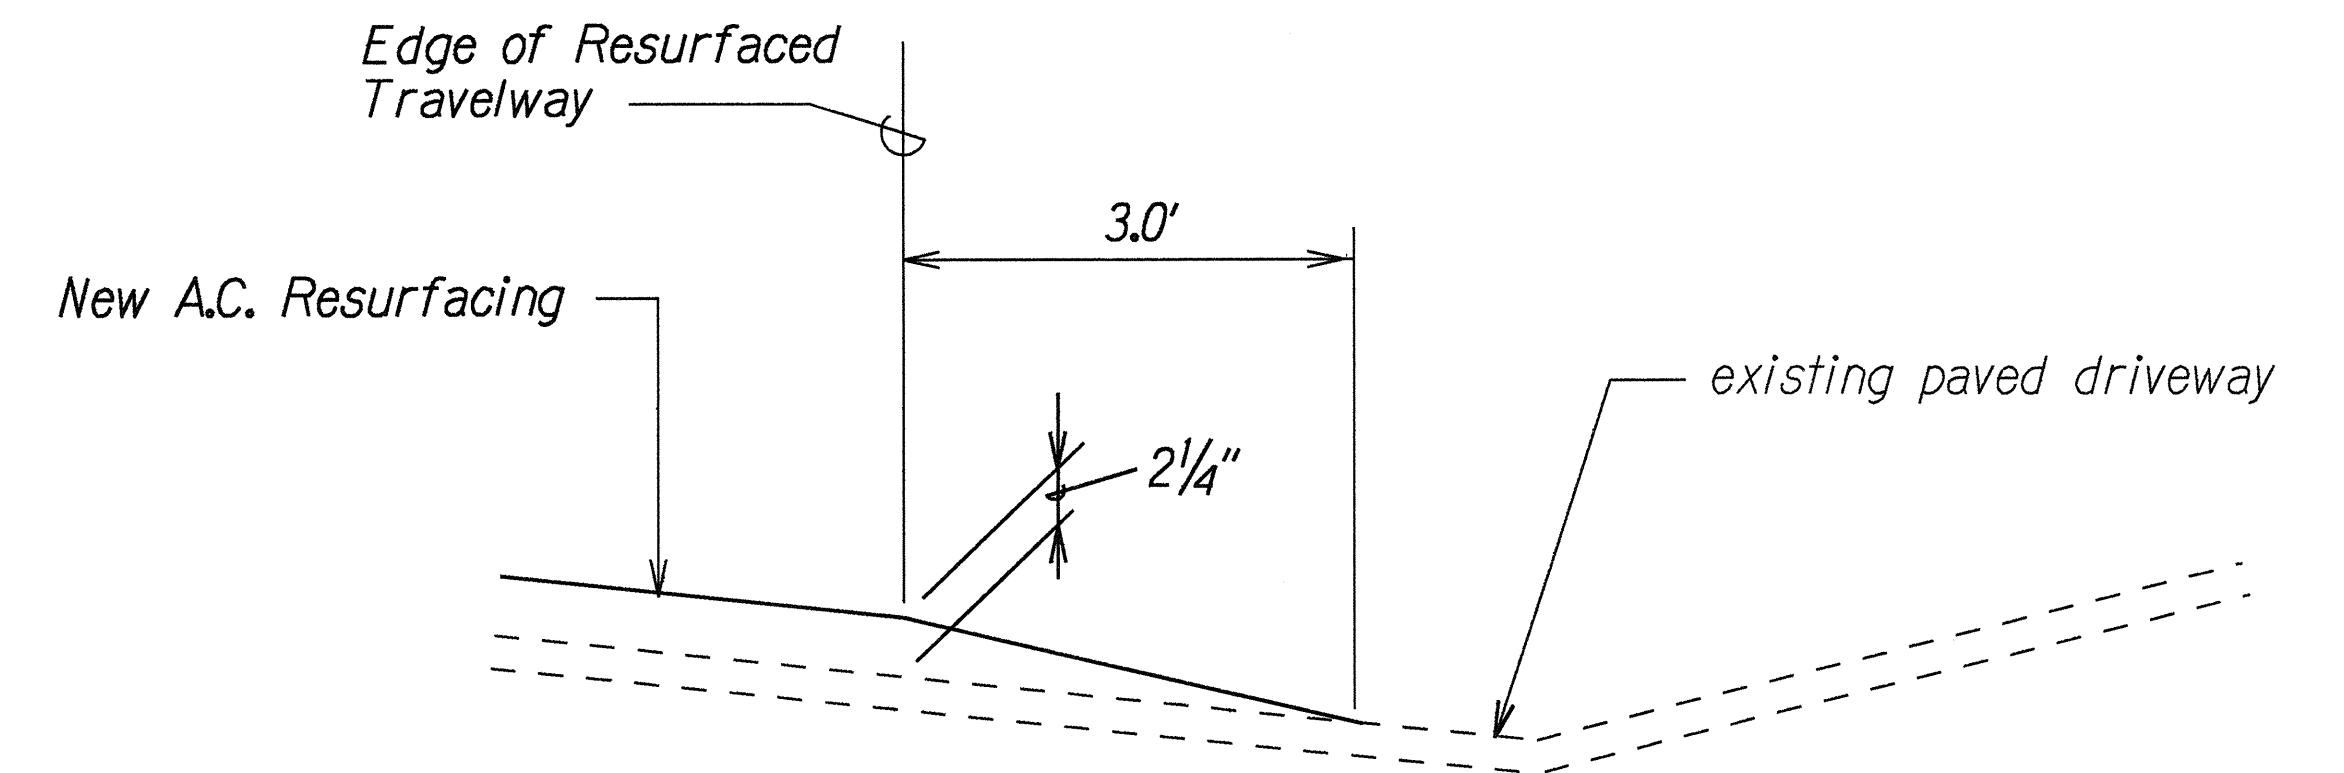

PAVEMENT TRANSITION AT EXISTING PAVED DRIVEWAY
Not to Scale

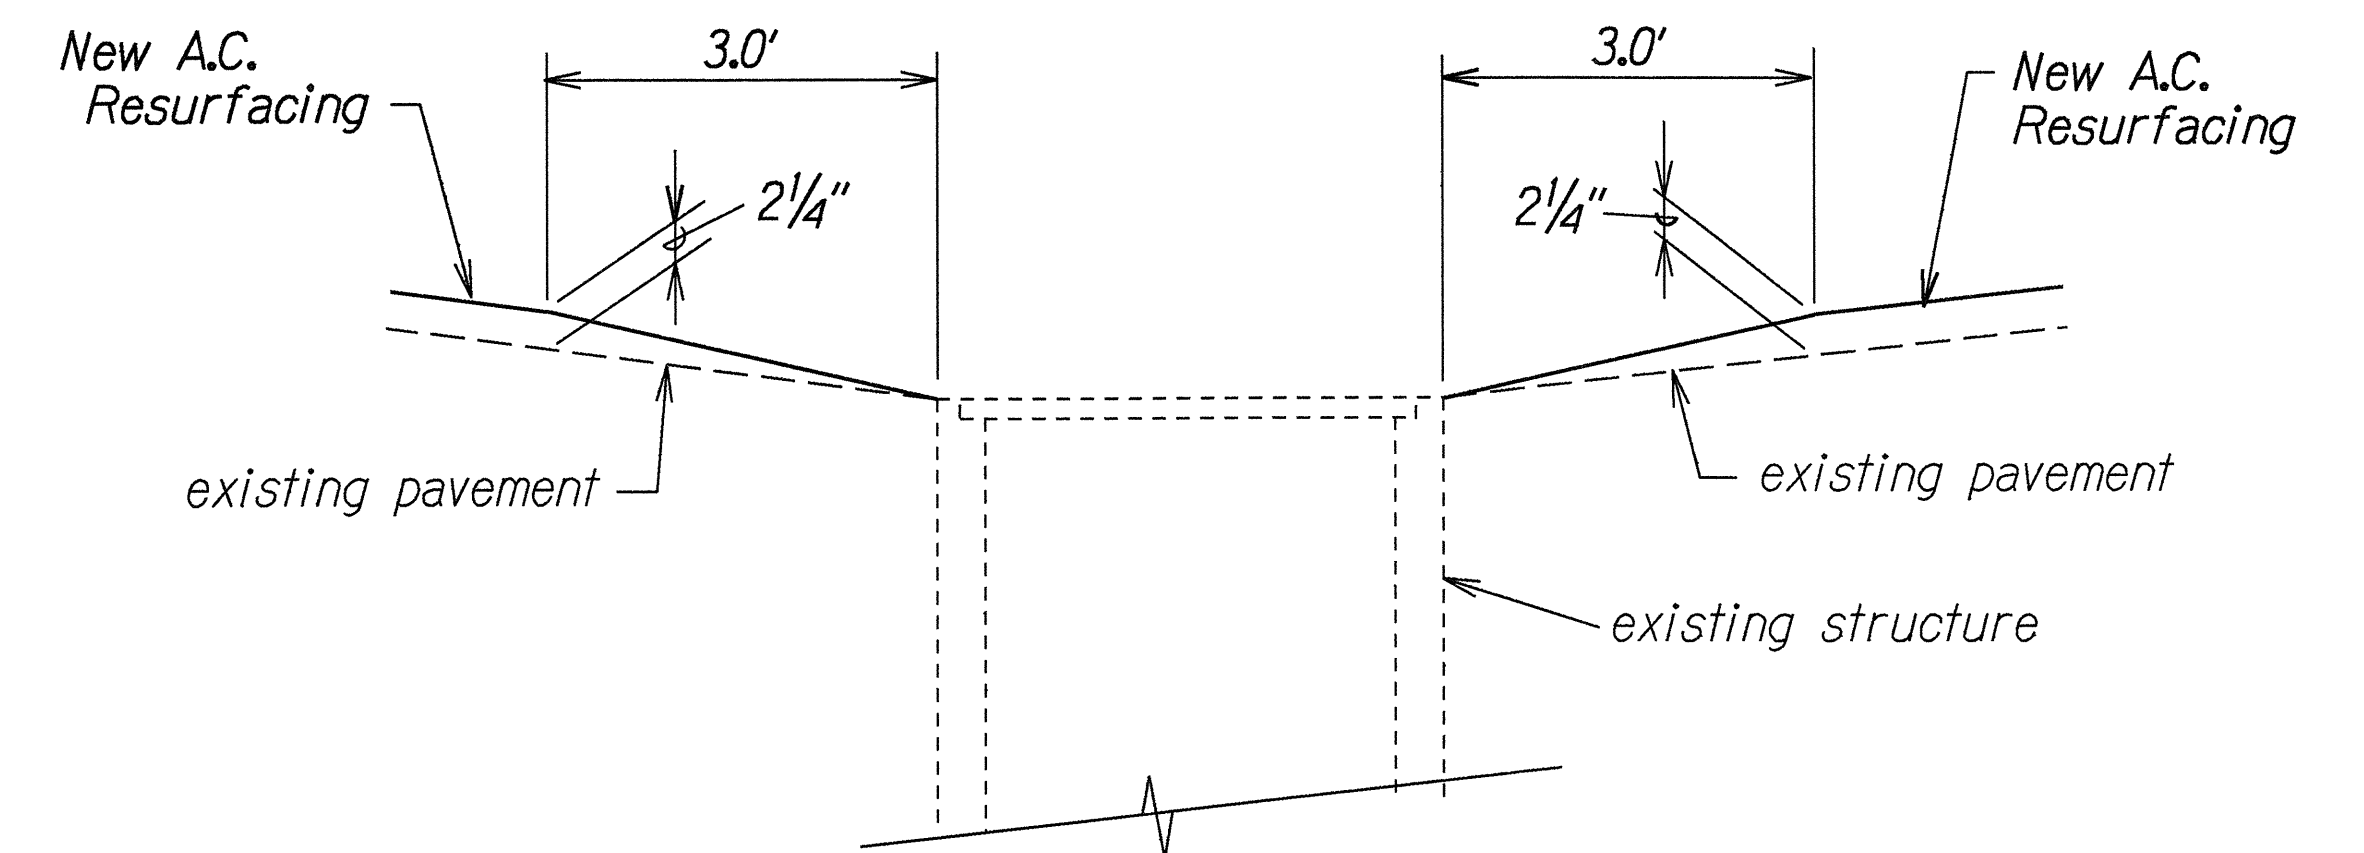

PAVEMENT TRANSITION AT EXISTING STRUCTURE
Not to Scale

SURVEY PLOTTED BY	DATE
DRAWN BY	
DESIGNED BY	
CHECKED BY	
ORIGINAL PLAN	
NOTE BOOK	
dd ke-2	
Wreaths.dgn	

STATE OF HAWAII
DEPARTMENT OF TRANSPORTATION
HIGHWAYS DIVISION

TYPICAL SECTION

MAALO ROAD RESURFACING
M.P. 0.00 TO M.P. 1.90
Project No. 583A-01-95M

Scale: 3/8" = 1'-0" Date: Mar, 1995

SHEET No. 1 OF 1 SHEETS