
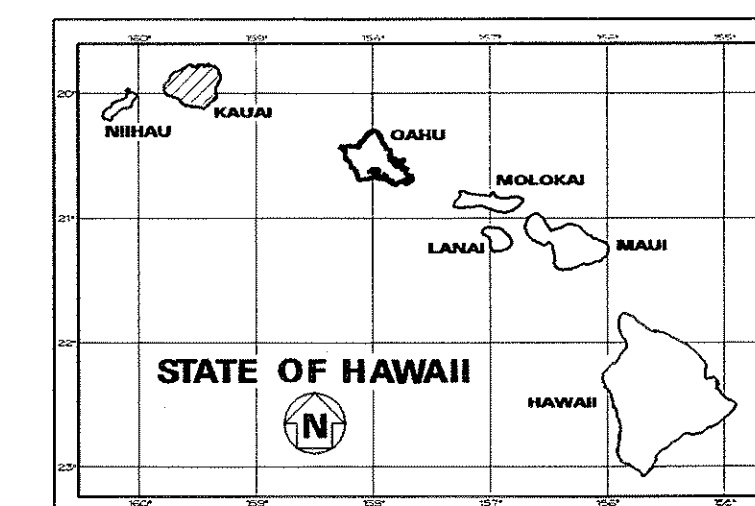


| FED. ROAD<br>DIST. NO. | STATE | PROJ. NO.   | FISCAL<br>YEAR | SHEET<br>NO. | TOTAL<br>SHEETS |
|------------------------|-------|-------------|----------------|--------------|-----------------|
| HAWAII                 | HAW.  | 583A-01-01M | 2004           | 1            | 33              |

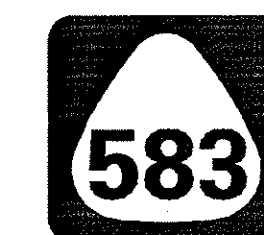

STATE OF HAWAII

DEPARTMENT OF TRANSPORTATION

HIGHWAYS DIVISION

HONOLULU, HAWAII


**"AS-BUILT"**

PLANS FOR

**MAALO ROAD RESURFACING**

**VICINITY OF WAILUA FALLS**

**PROJECT NO. 583A-01-01M**

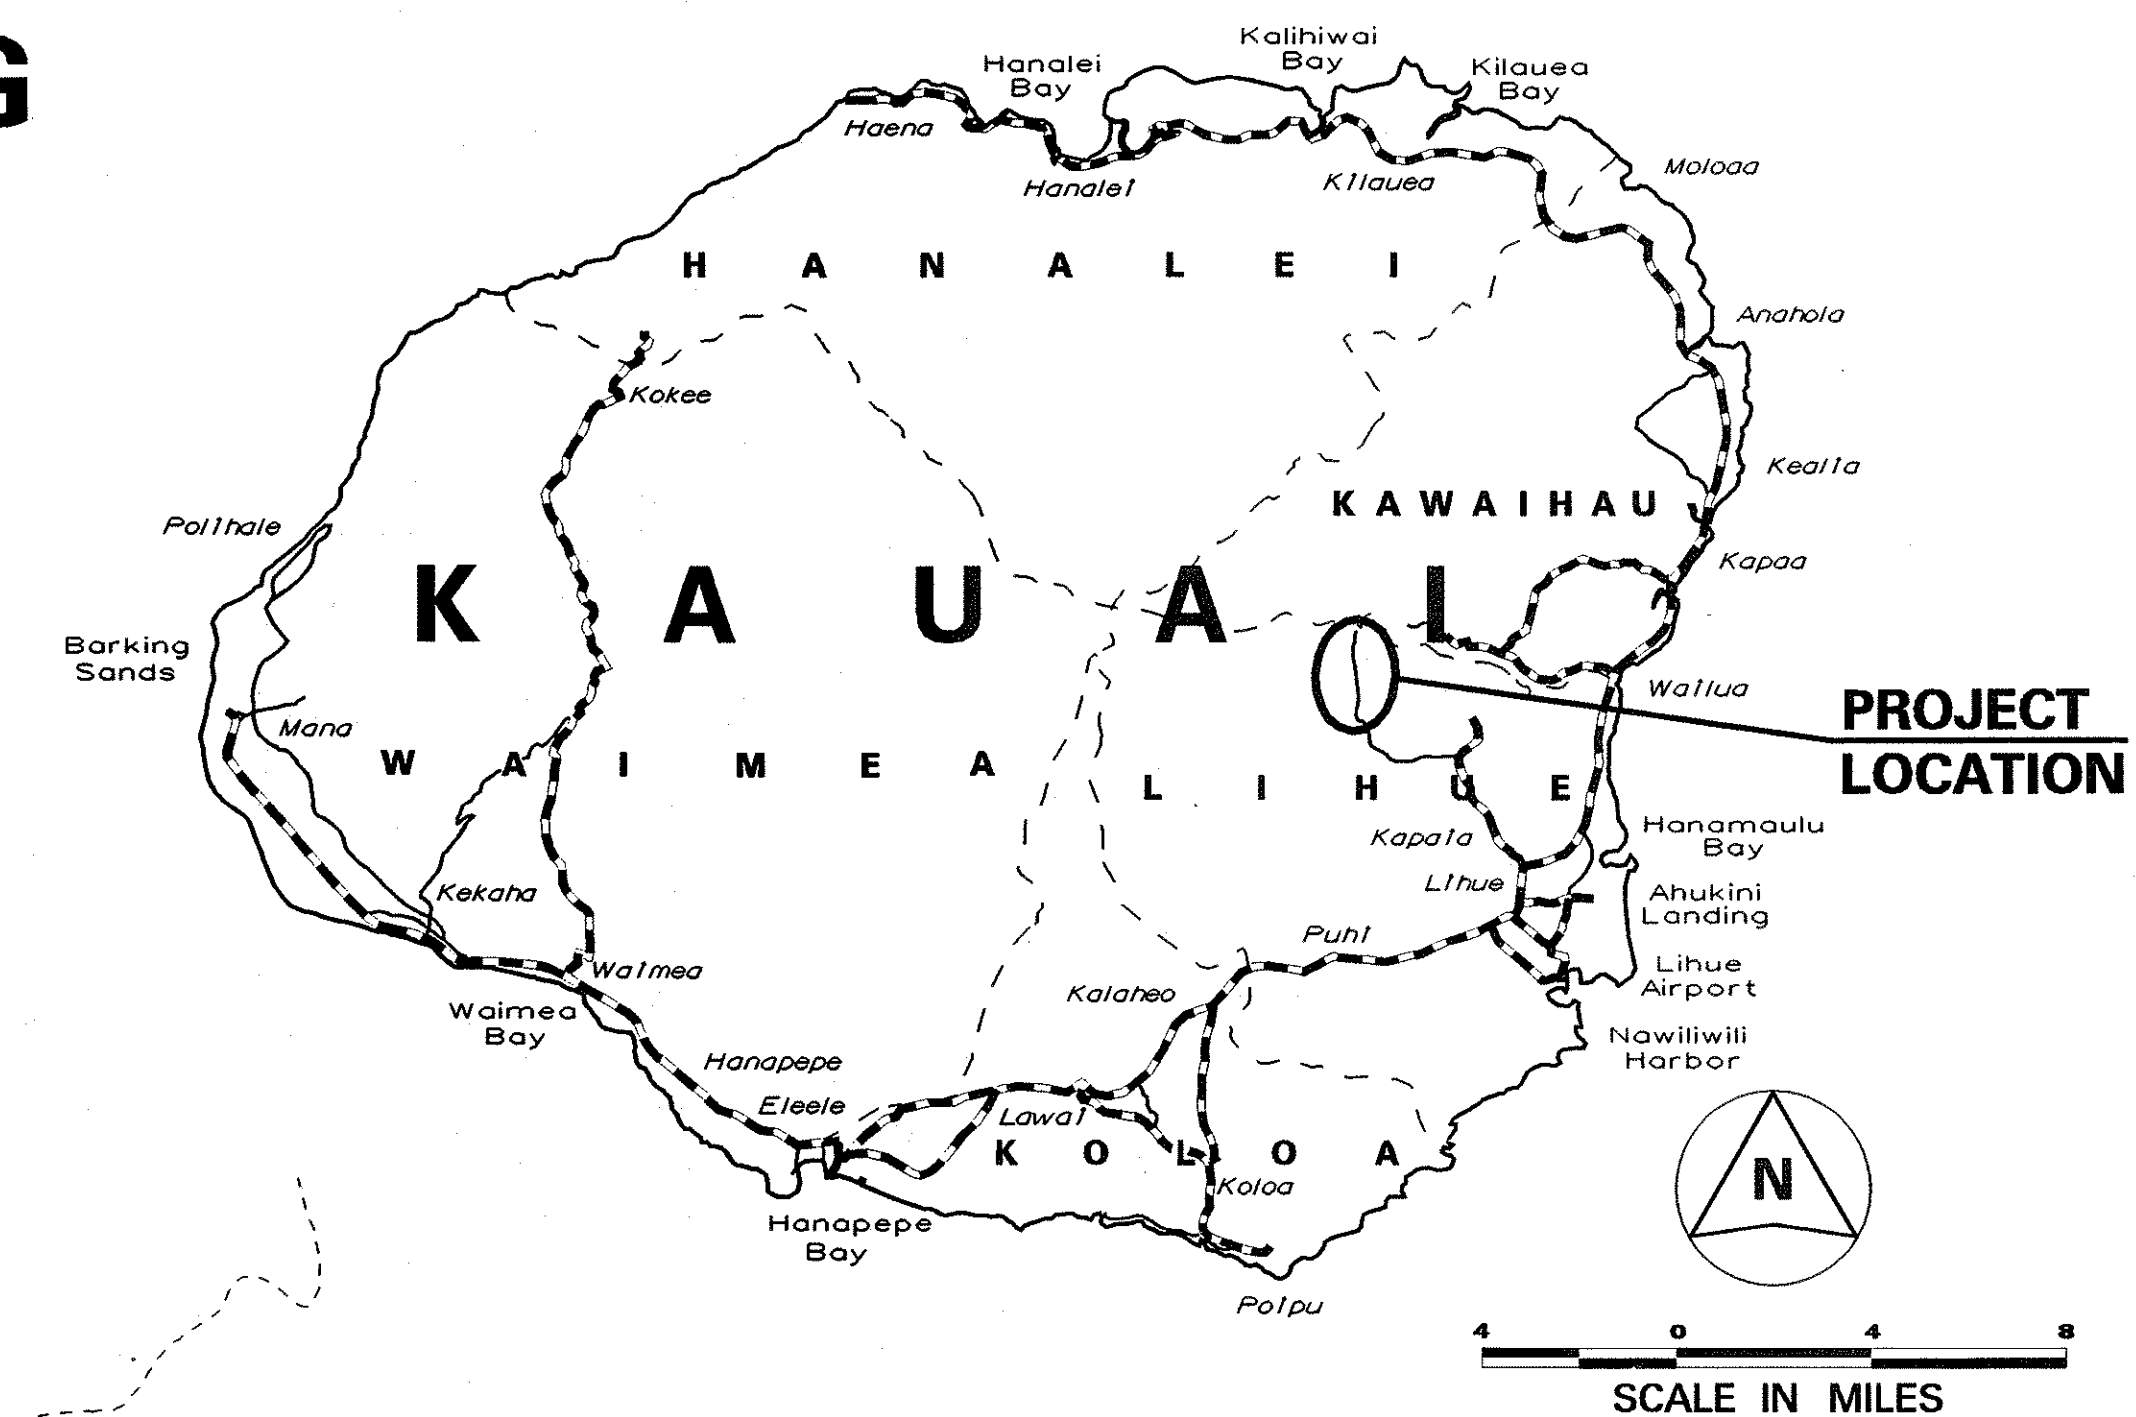DISTRICT OF LIHUE  
ISLAND OF KAUAI

**FEDERAL AID PROJECTS PREVIOUSLY CONSTRUCTED OR UNDER CONSTRUCTION**

MILE POST 3.00 TO MILE POST 3.94

NO SIGNIFICANT CHANGES WERE MADE DURING CONSTRUCTION ON THESE PLANS EXCEPT CHANGES IN THE ORIGINAL THEORETICAL QUANTITIES, FOR ACTUAL QUANTITIES, REFER TO PROJECT LEDGER AND/OR COMPUTATION BOOK.


*Robert Jones* 1/9/08  
\_\_\_\_\_  
RESIDENT ENGINEER

DEPARTMENT OF TRANSPORTATION  
STATE OF HAWAII

APPROVED:


Specimen 9-16-03  
for DIR. OF TRANSPORTATION DATE

| INDEX TO DRAWINGS |                                            |
|-------------------|--------------------------------------------|
| SHEET NO.         | DESCRIPTION                                |
| 1                 | TITLE SHEET                                |
| 2                 | STANDARD PLANS SUMMARY                     |
| 3                 | GENERAL NOTES AND LEGEND                   |
| 4-5               | WATER POLLUTION AND EROSION CONTROL NOTES  |
| 6-8               | TYPICAL SECTIONS                           |
| 9-15              | GUARDRAIL DETAILS AND NOTES                |
| 16                | PORTABLE PHYSICAL BARRIER                  |
| 17                | RECONSTRUCT EMERGENCY TELEPHONE STATION    |
| 18-20             | ROADWAY PLAN                               |
| 21                | PAVEMENT GRADES                            |
| 22                | PAVEMENT MARKING LEGEND, DETAILS AND NOTES |
| 23-25             | PAVEMENT MARKING AND TRAFFIC SIGNING PLAN  |
| 26                | TRAFFIC SUMMARIES                          |
| 27                | PAVEMENT MARKING SUMMARY                   |
| 28                | SIGN DETAILS                               |
| 29-33             | AESTHETIC RAILING PLANS AND DETAILS        |

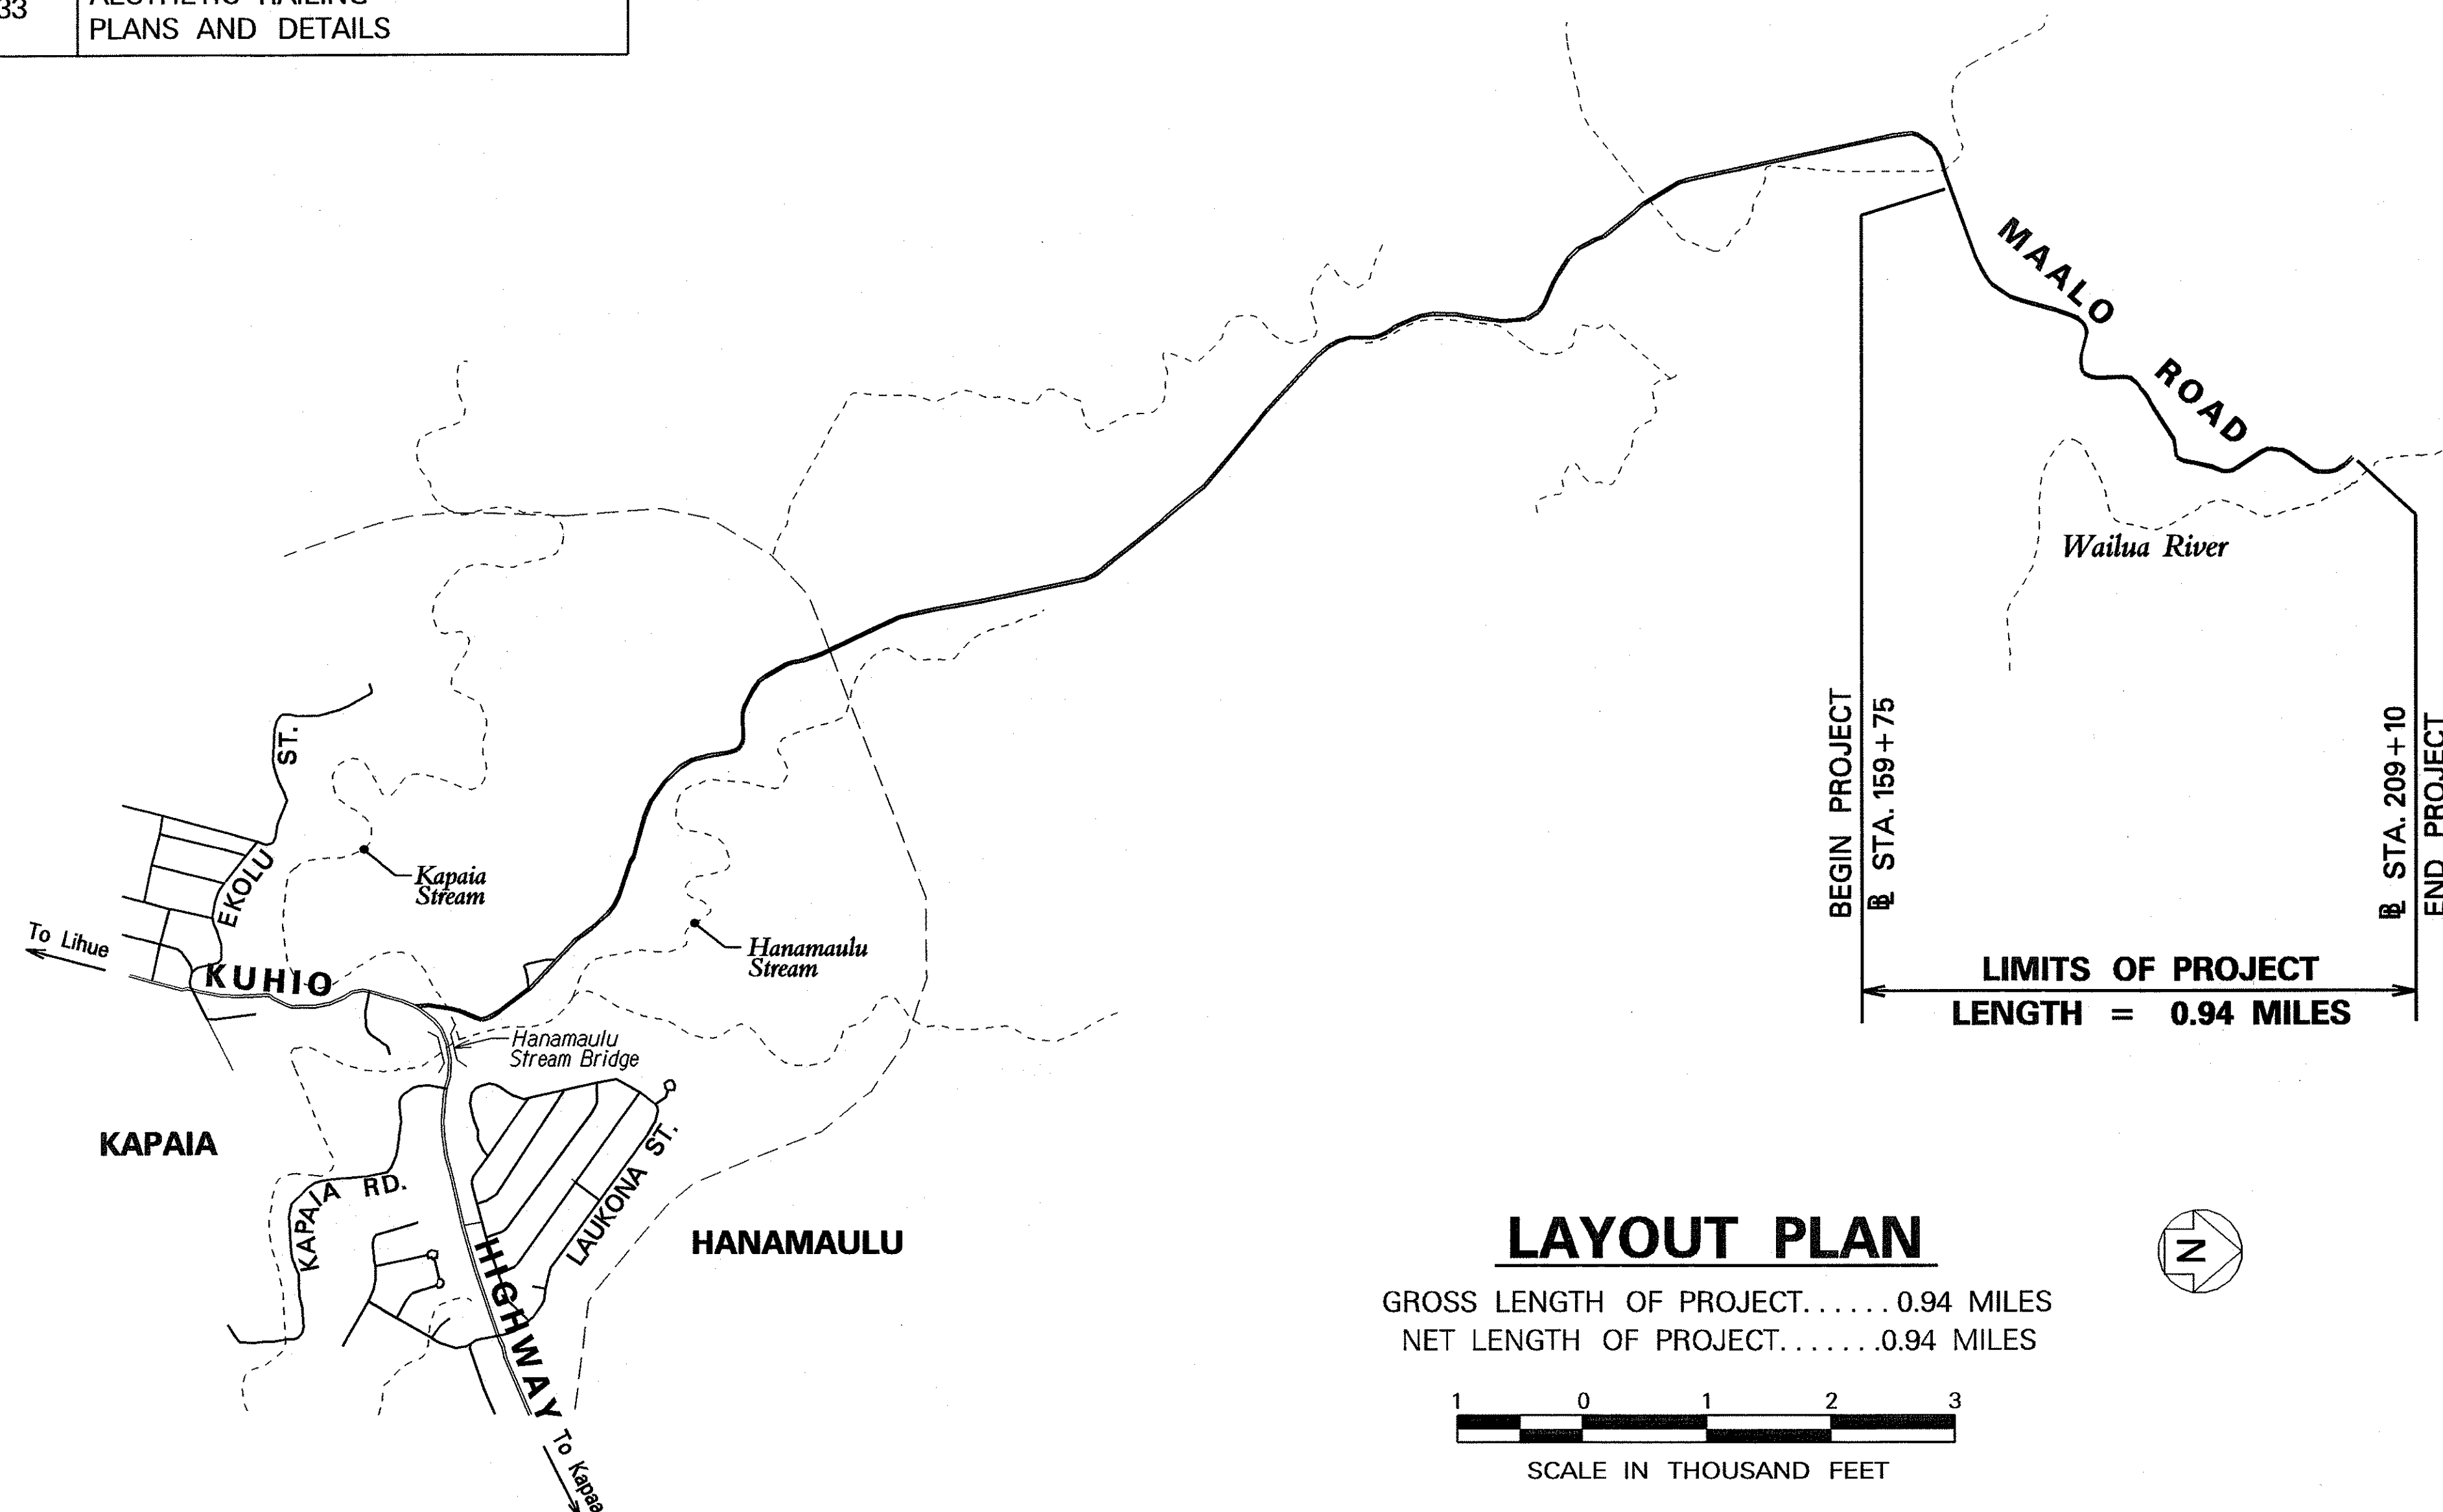

## LAYOUT PLAN

GROSS LENGTH OF PROJECT.....0.94 MILES  
NET LENGTH OF PROJECT.....0.94 MILES

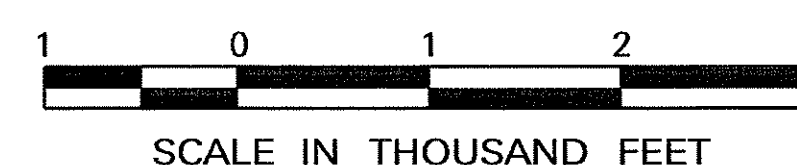

|             |            |          |             |
|-------------|------------|----------|-------------|
| HWY-K       | HWY-KE     | 274-3118 | AUGUST 2003 |
| DESIGNED BY | MANAGED BY | PHONE    | DATE        |