
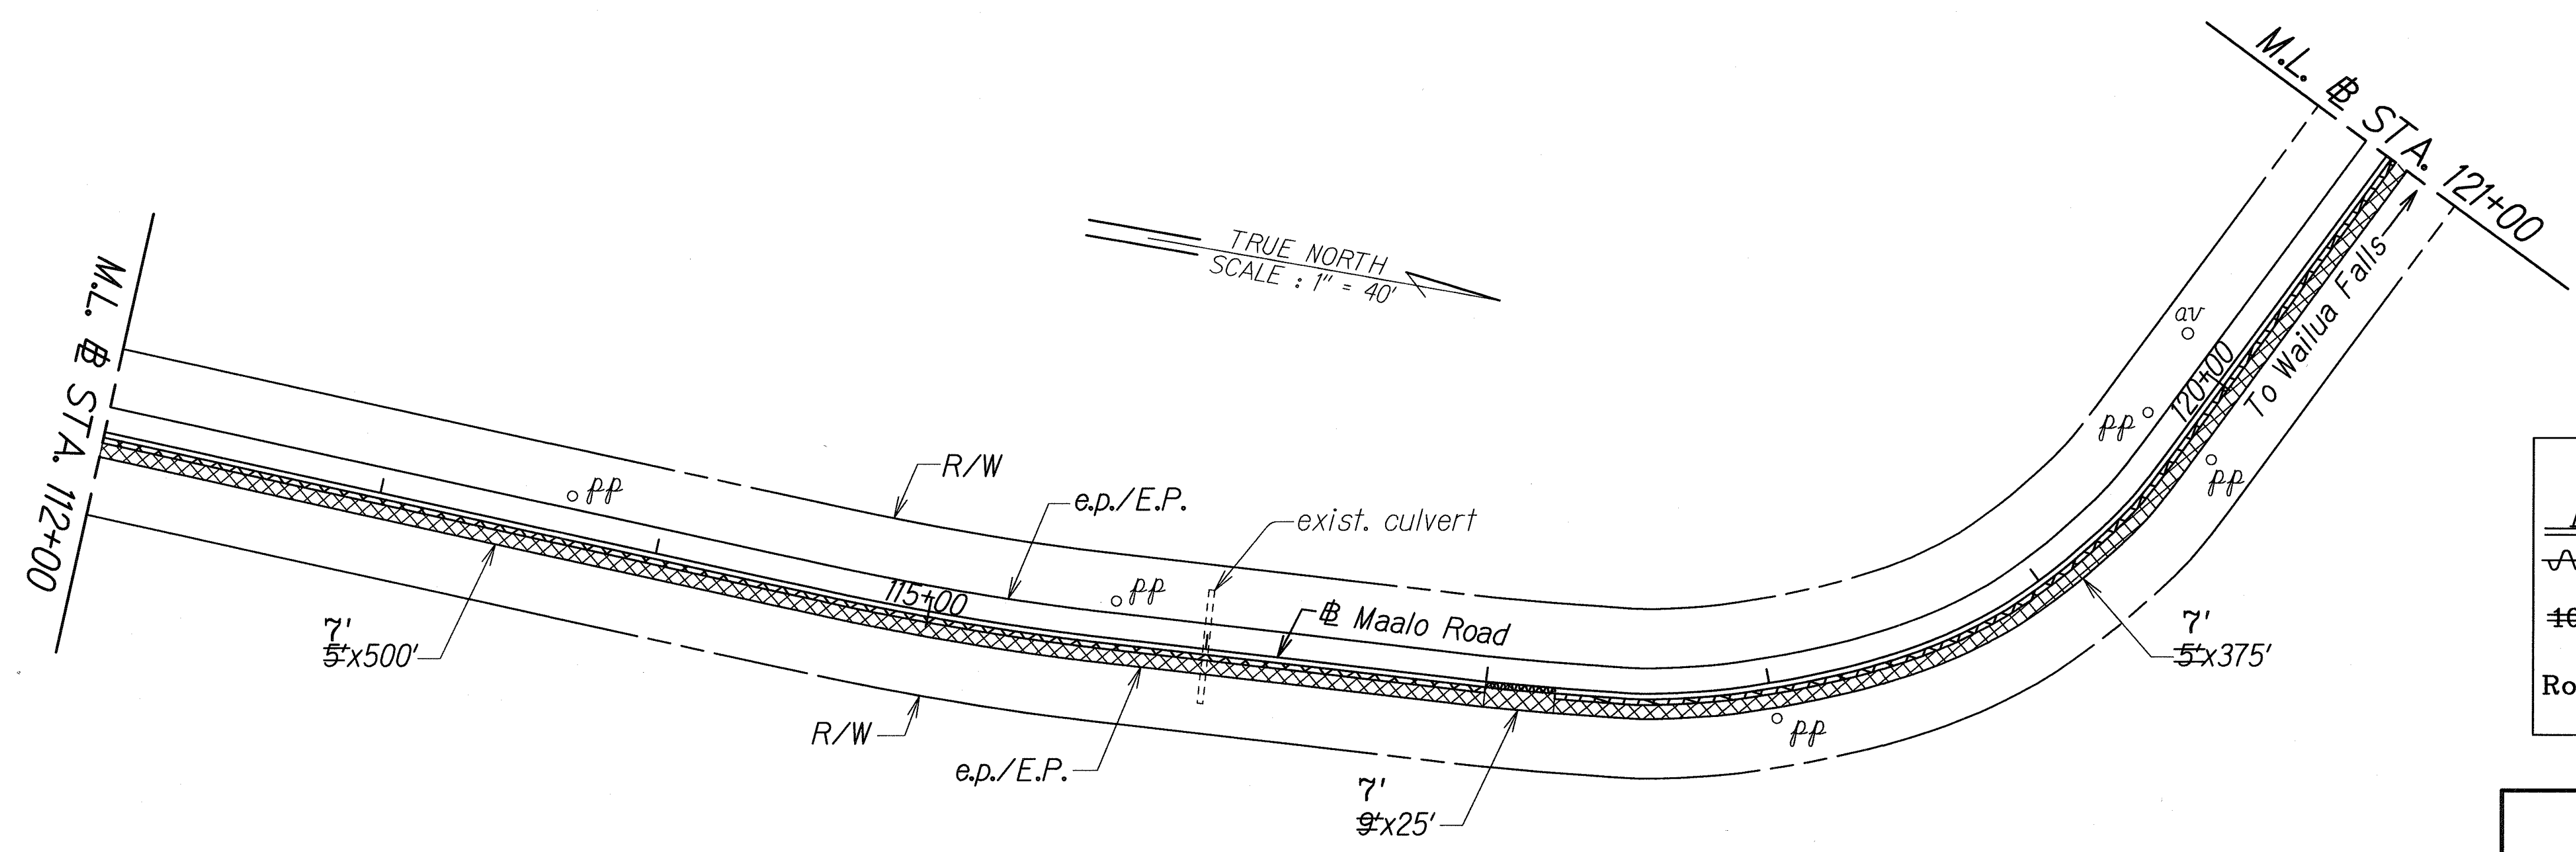


FED. ROAD DIST. NO.	STATE	PROJ. NO.	FISCAL YEAR	SHEET NO.	TOTAL SHEETS
HAWAII	HAW.	583A-01-07M	2007	9	15

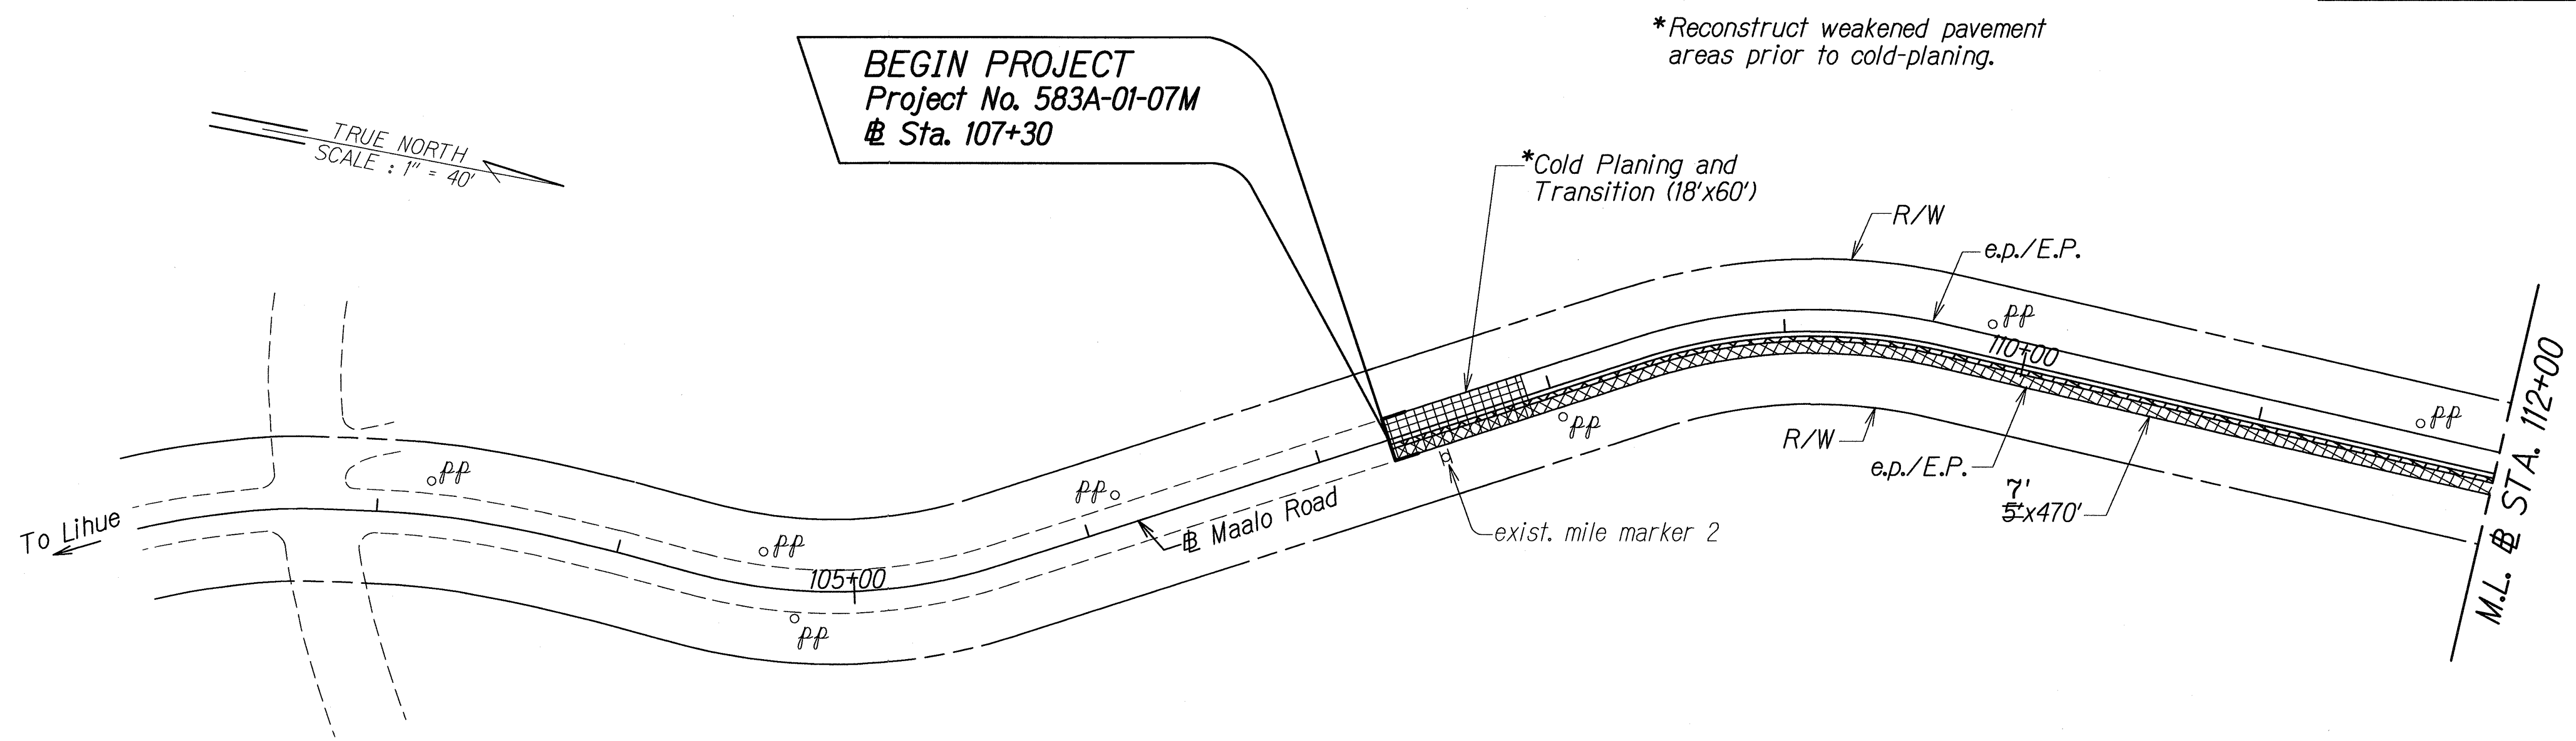

LEGEND FOR AS-BUILT POSTINGS	
	Squiggly line for as-built deletion
	Double line for as-built deletion
Roadway	Text for as-built posting

STATE OF HAWAII
DEPARTMENT OF TRANSPORTATION
HIGHWAYS DIVISION

ROADWAY PLAN



MAALO ROAD RESURFACING
Mile Post 2.0 to Mile Post 3.0
Project No. 583A-01-07M

Scale: 1" = 40' Date: April 2007

ORIGINAL PLAN	SURVEY PLOTTED BY	DATE
NOTE BOOK	DRAWN BY	12/06
DESIGNED BY	CHECKED BY	
MAKAPOLLO		

AS-BUILT

FED. ROAD DIST. NO.	STATE	PROJ. NO.	FISCAL YEAR	SHEET NO.	TOTAL SHEETS
HAWAII	HAW.	583A-01-07M	2007	10	15

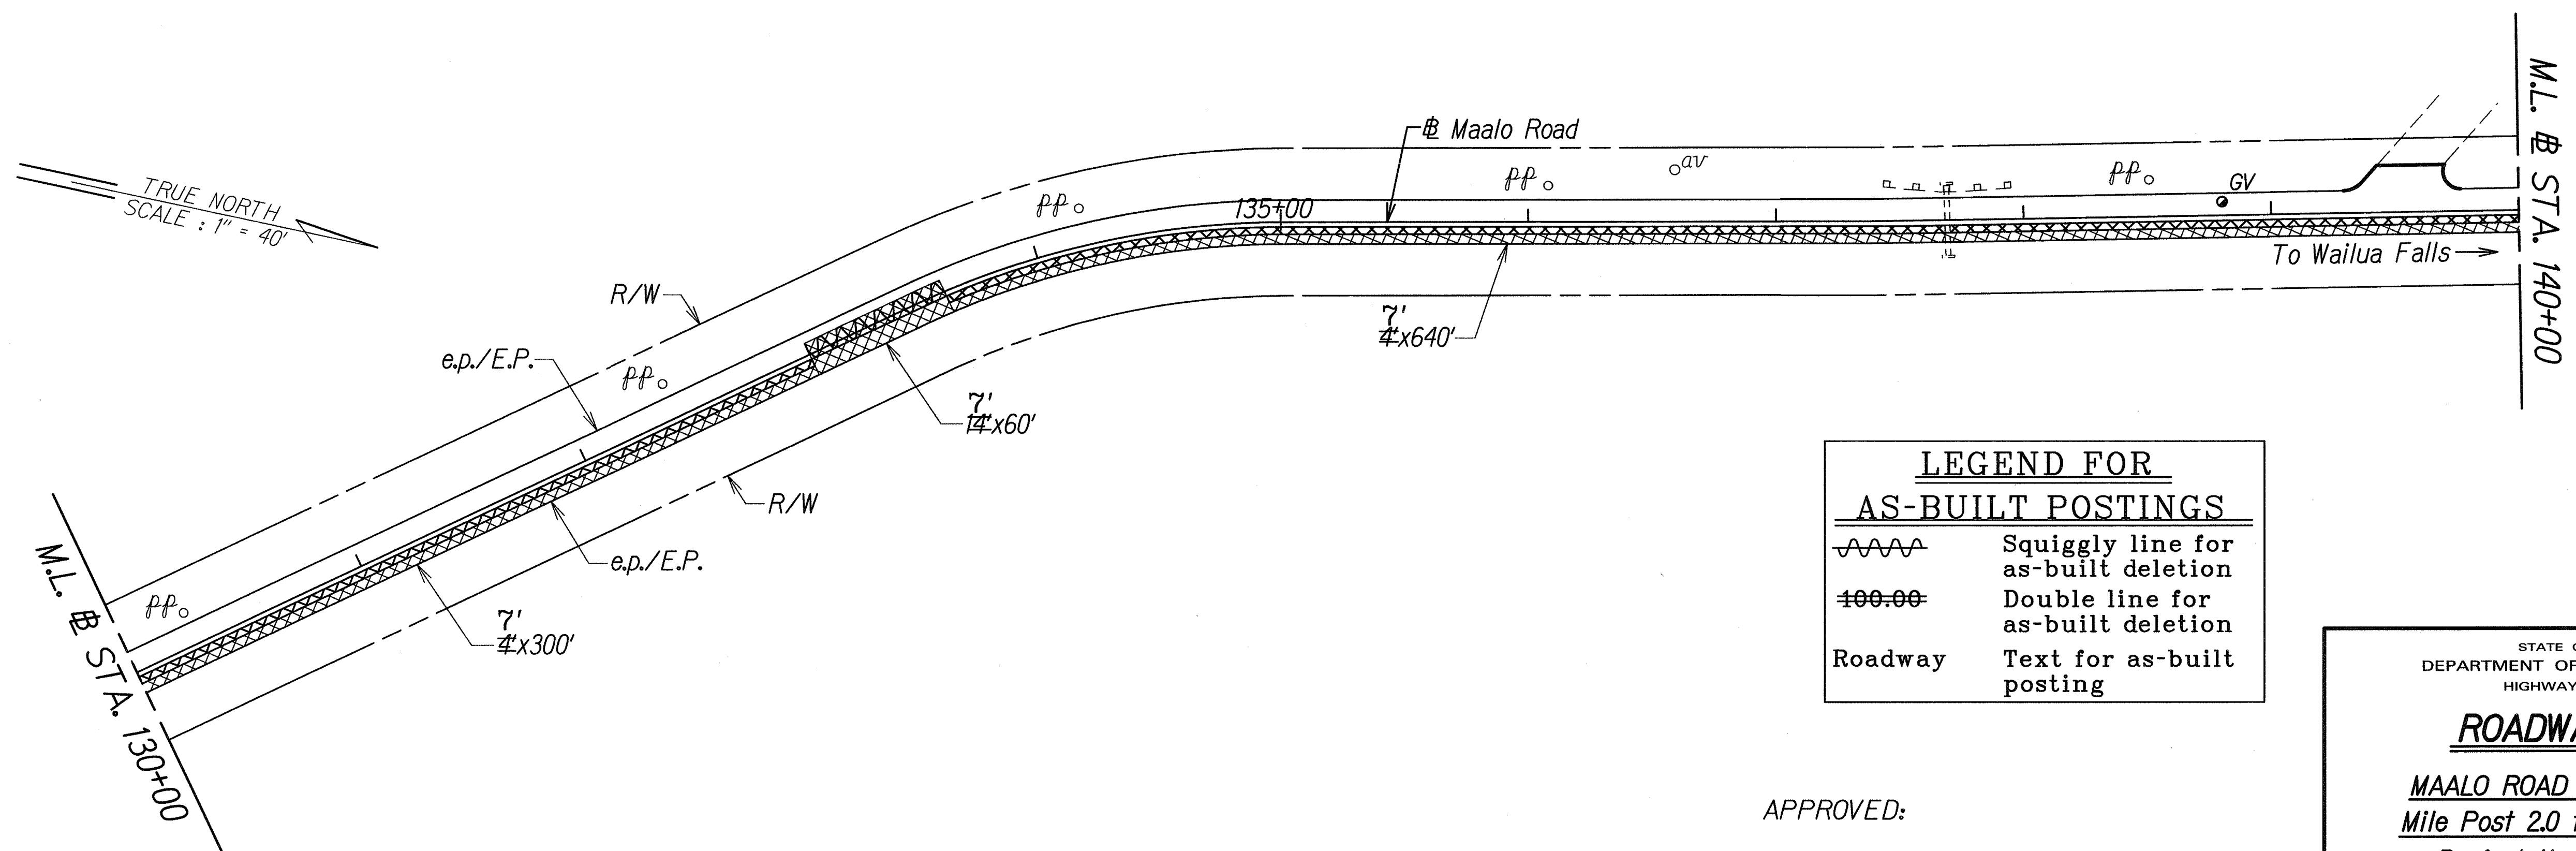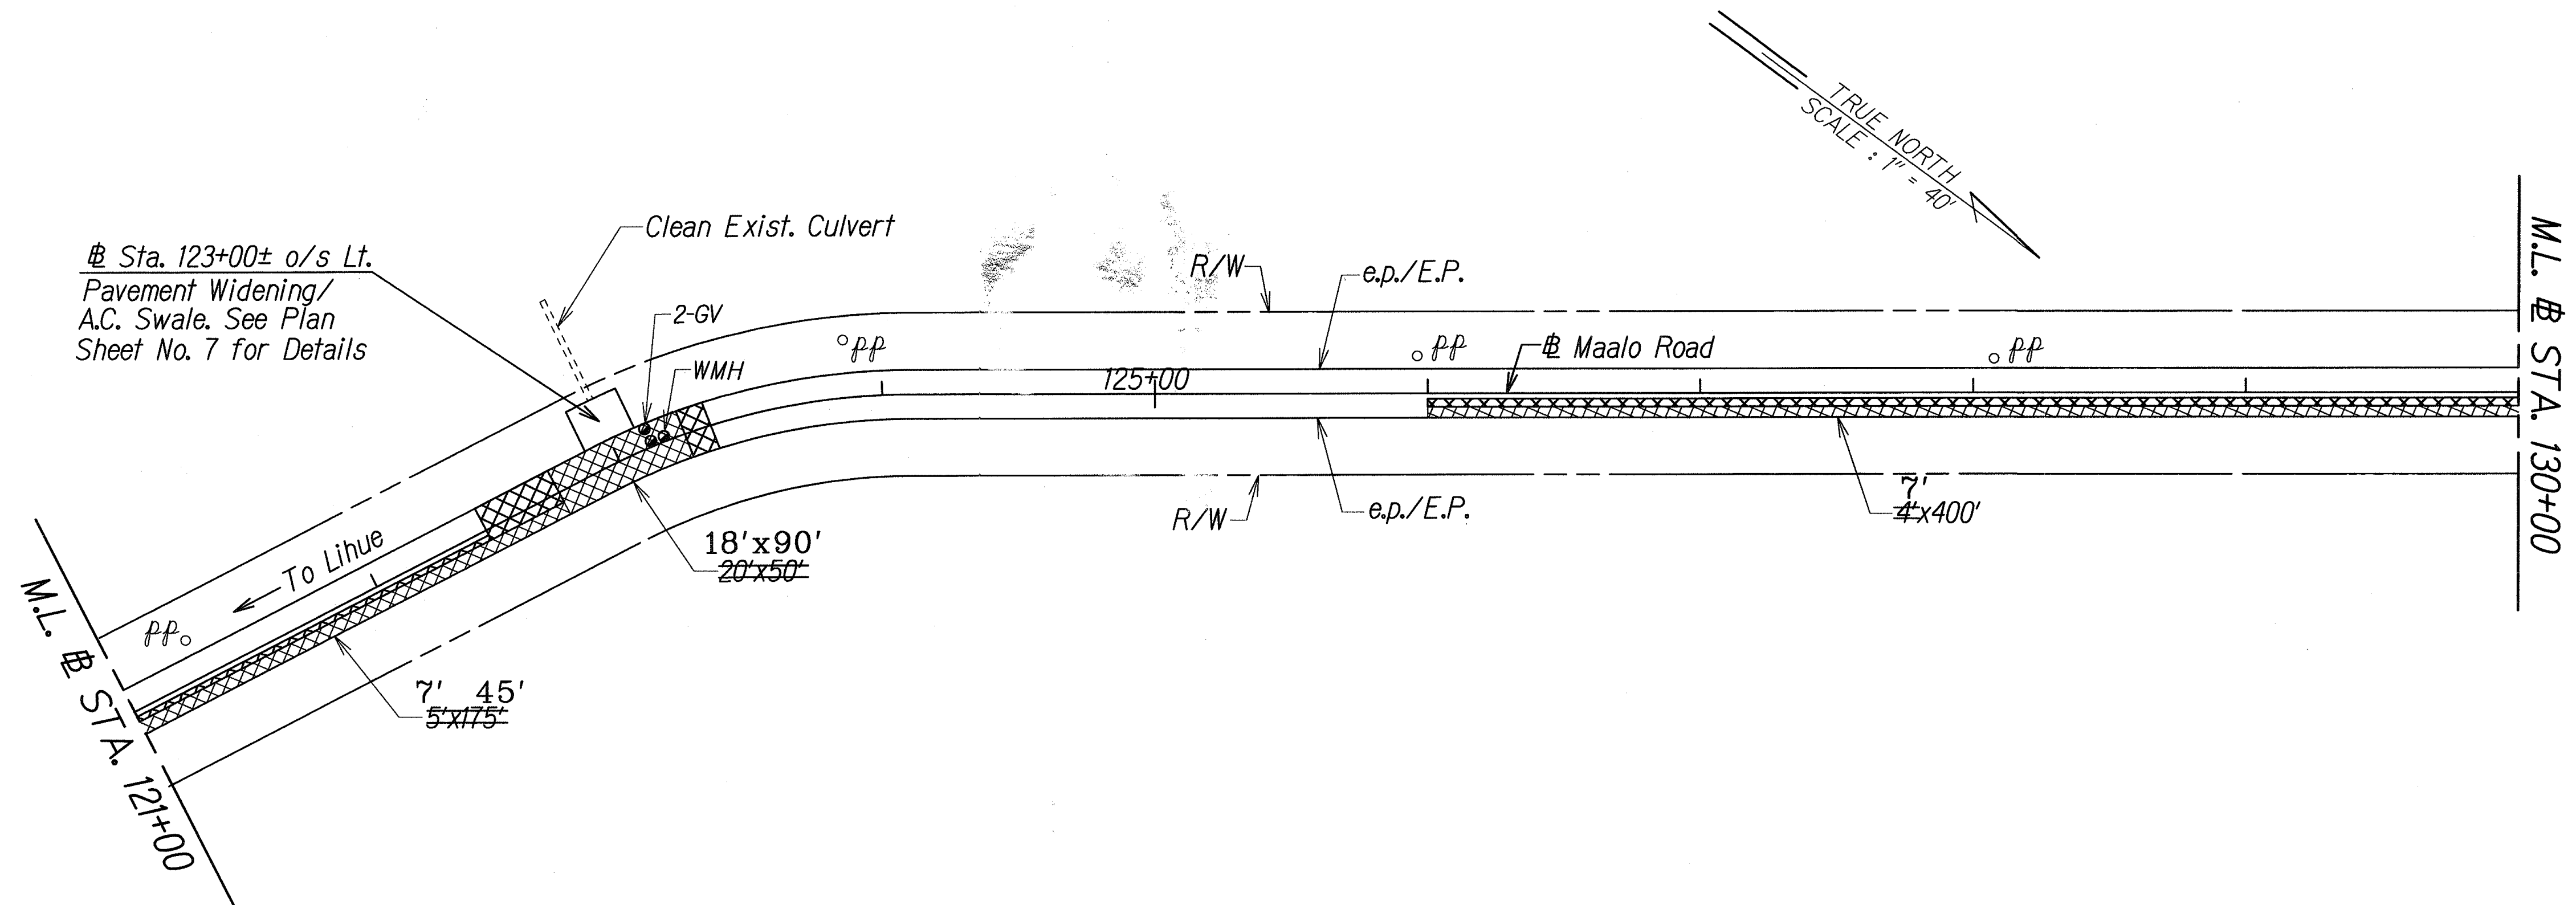

LEGEND FOR AS-BUILT POSTINGS	
	Squiggly line for as-built deletion
	Double line for as-built deletion
Roadway	Text for as-built posting

APPROVED:

Manager & Chief Engineer Date
Department of Water

STATE OF HAWAII
DEPARTMENT OF TRANSPORTATION
HIGHWAYS DIVISION

ROADWAY PLAN



MAALO ROAD RESURFACING
Mile Post 2.0 to Mile Post 3.0
Project No. 583A-01-07M

Scale: 1" = 40' Date: April 2007

SHEET No. 2 OF 3 SHEETS

ORIGINAL PLAN	SURVEY PLOTTED BY	DATE
NOTE BOOK	DRAWN BY	12/06
DESIGNED BY	CHECKED BY	
QUANTITIES BY		

FED. ROAD DIST. NO.	STATE	PROJ. NO.	FISCAL YEAR	SHEET NO.	TOTAL SHEETS
HAWAII	HAW.	583A-01-07M	2007	11	15

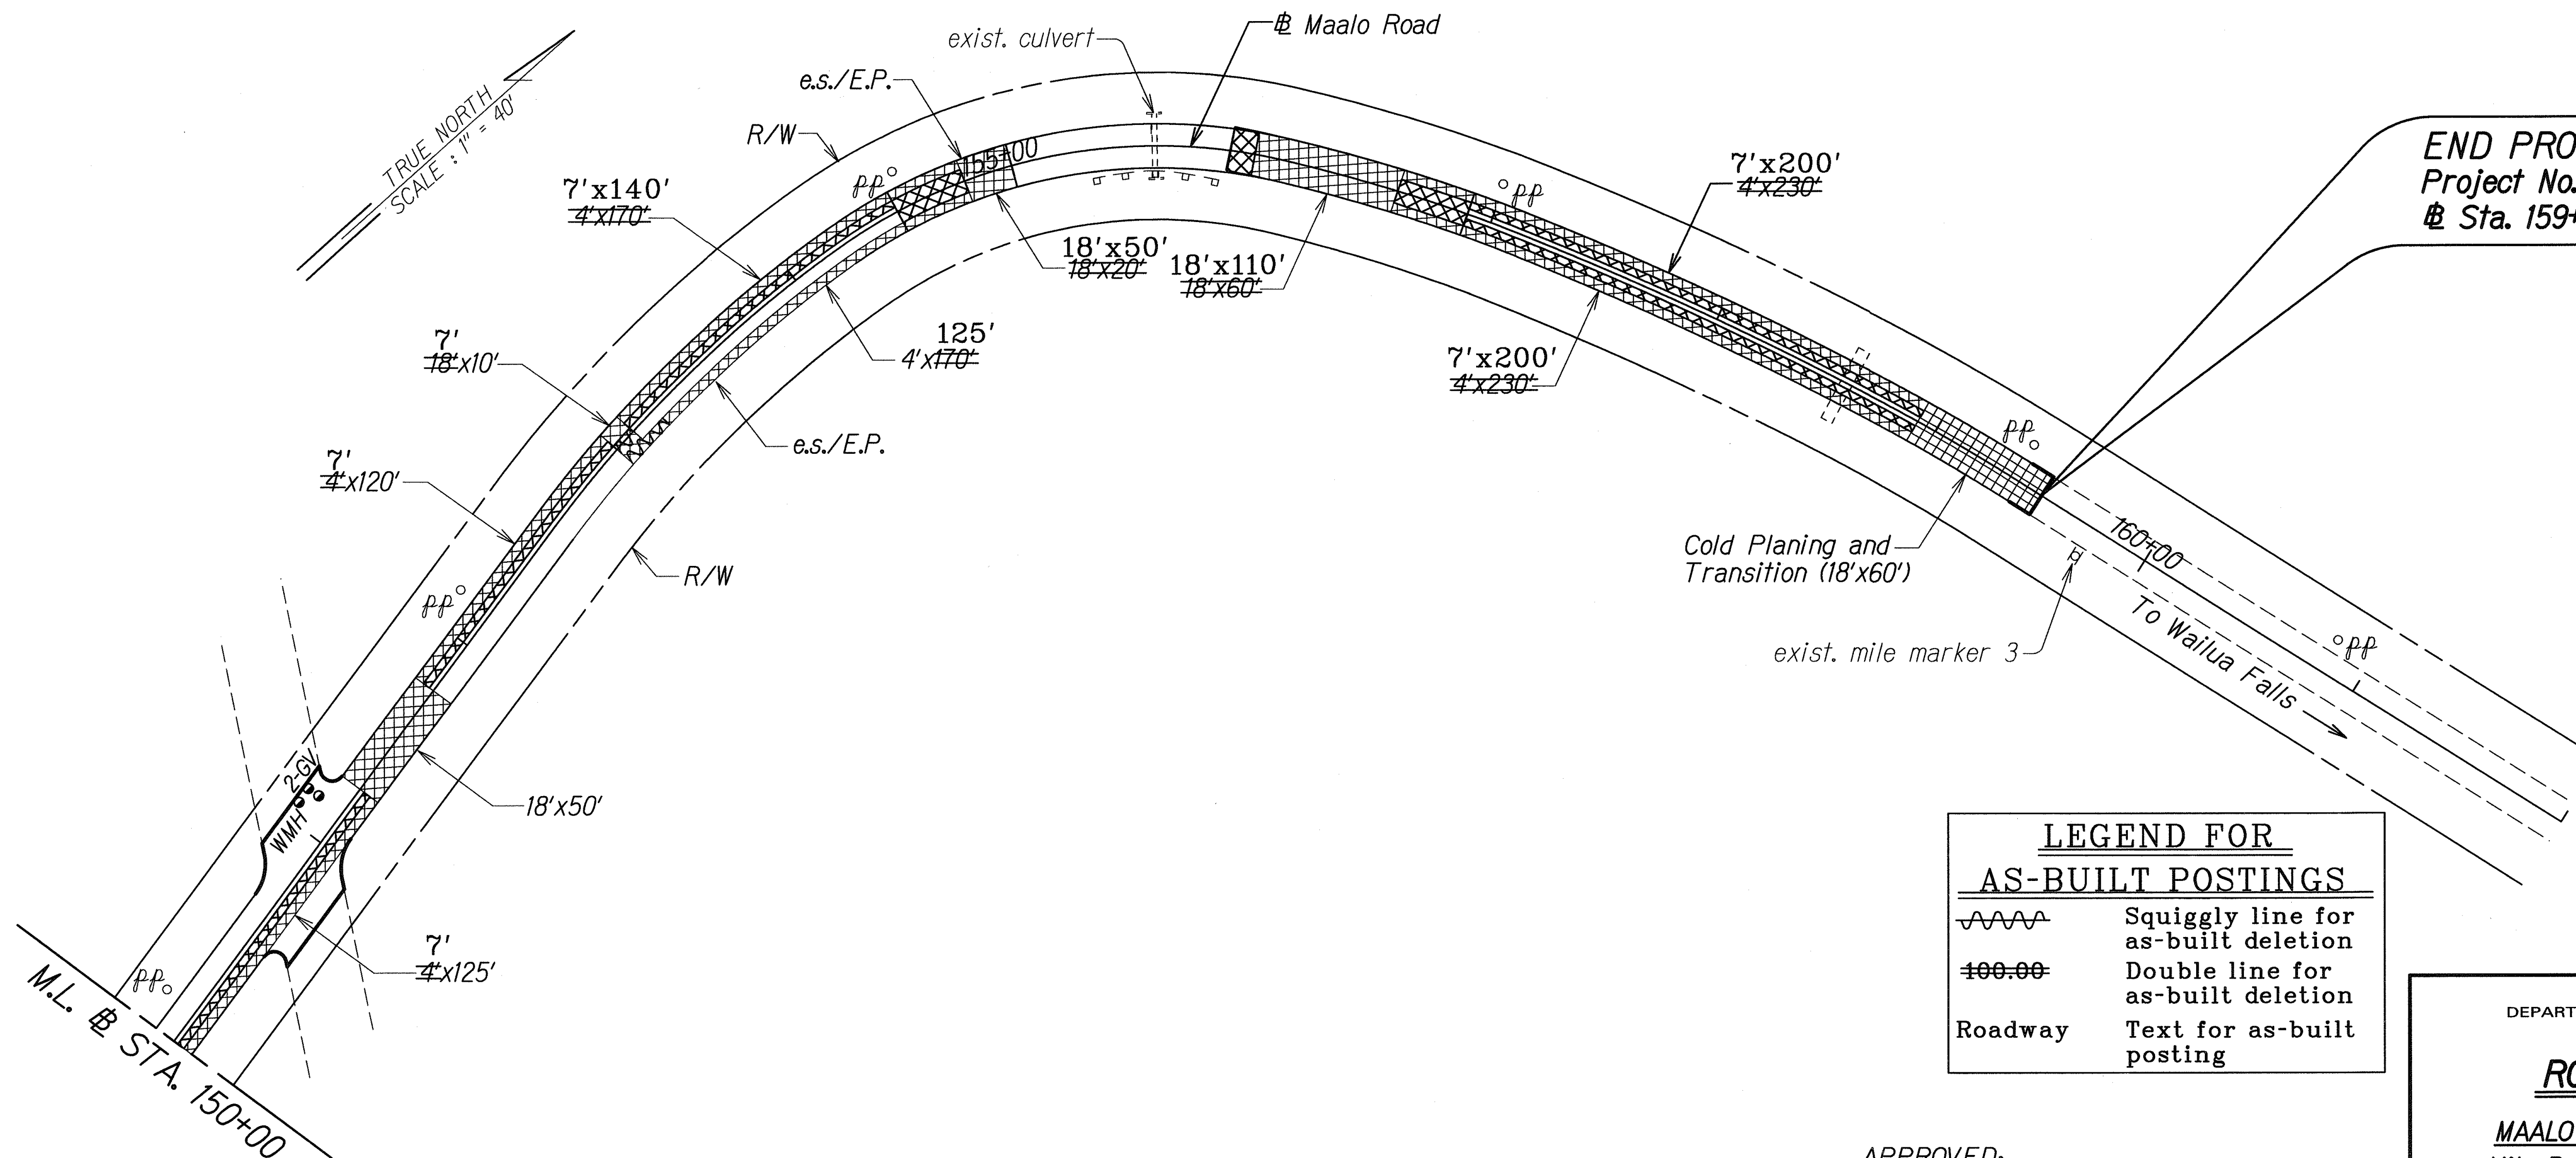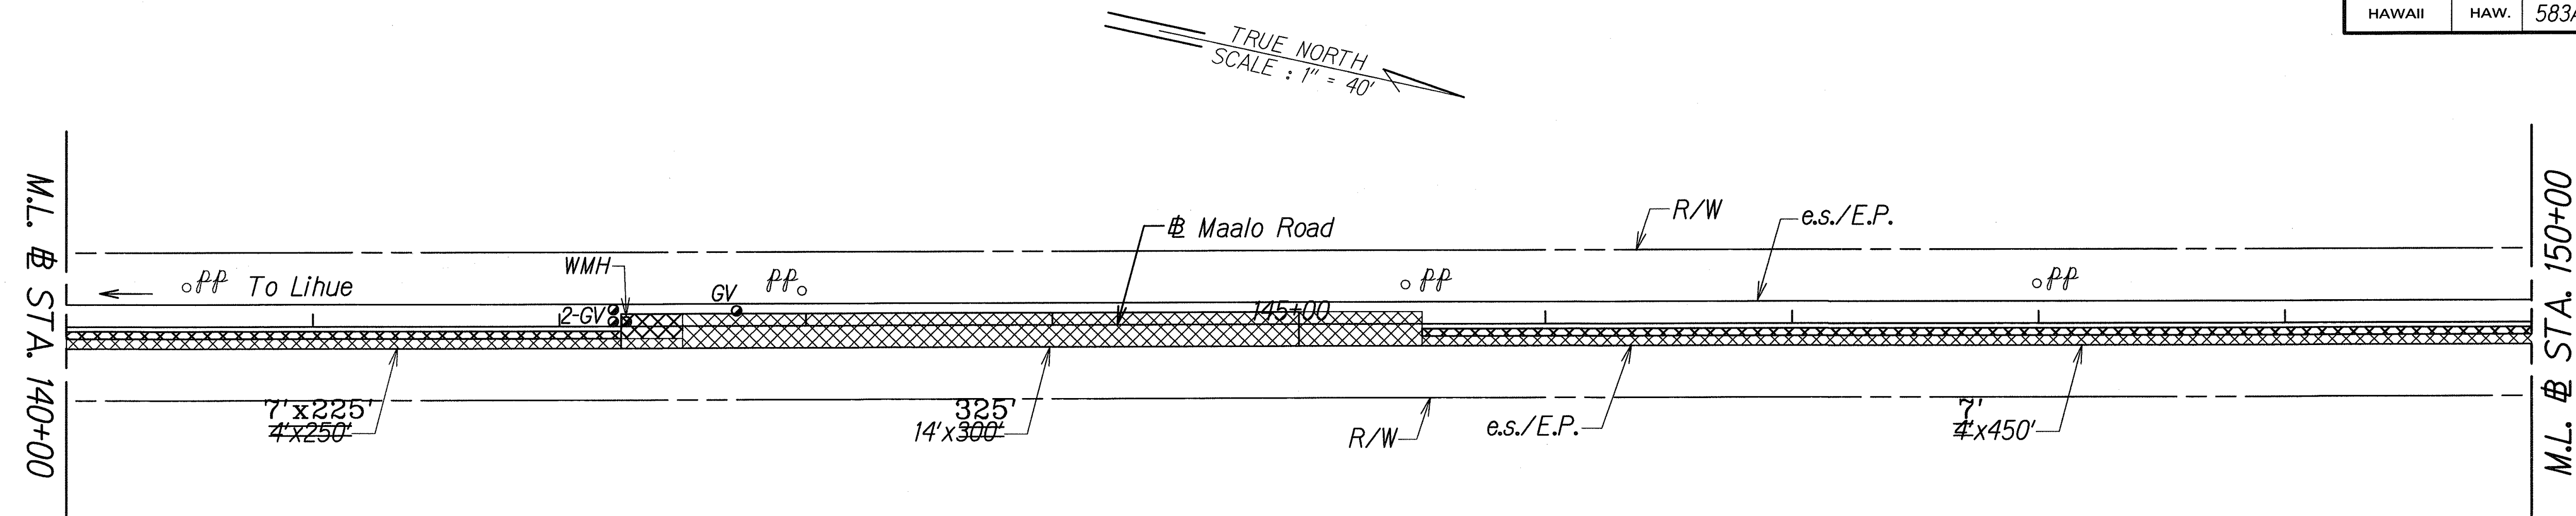

LEGEND FOR AS-BUILT POSTINGS	
	Squiggly line for as-built deletion
	Double line for as-built deletion
Roadway	Text for as-built posting

APPROVED:

Manager & Chief Engineer Date
Department of Water

STATE OF HAWAII
DEPARTMENT OF TRANSPORTATION
HIGHWAYS DIVISION
ROADWAY PLAN
MAALO ROAD RESURFACING
Mile Post 2.0 to Mile Post 3.0
Project No. 583A-01-07M
Scale: 1" = 40' Date: April 2007
SHEET No. 3 OF 3 SHEETS

AS-BUILT

DESIGNED BY	DATE
DRAWN BY	
CHECKED BY	
NOTED BY	
QUANTITIES BY	
REVISIONS	