


FED. ROAD DIST. NO.	STATE	FED. AID PROJ. NO.	FISCAL YEAR	SHEET NO.	TOTAL SHEETS
HAWAII	HAW.	ARR-0583(1)	2009	9	17

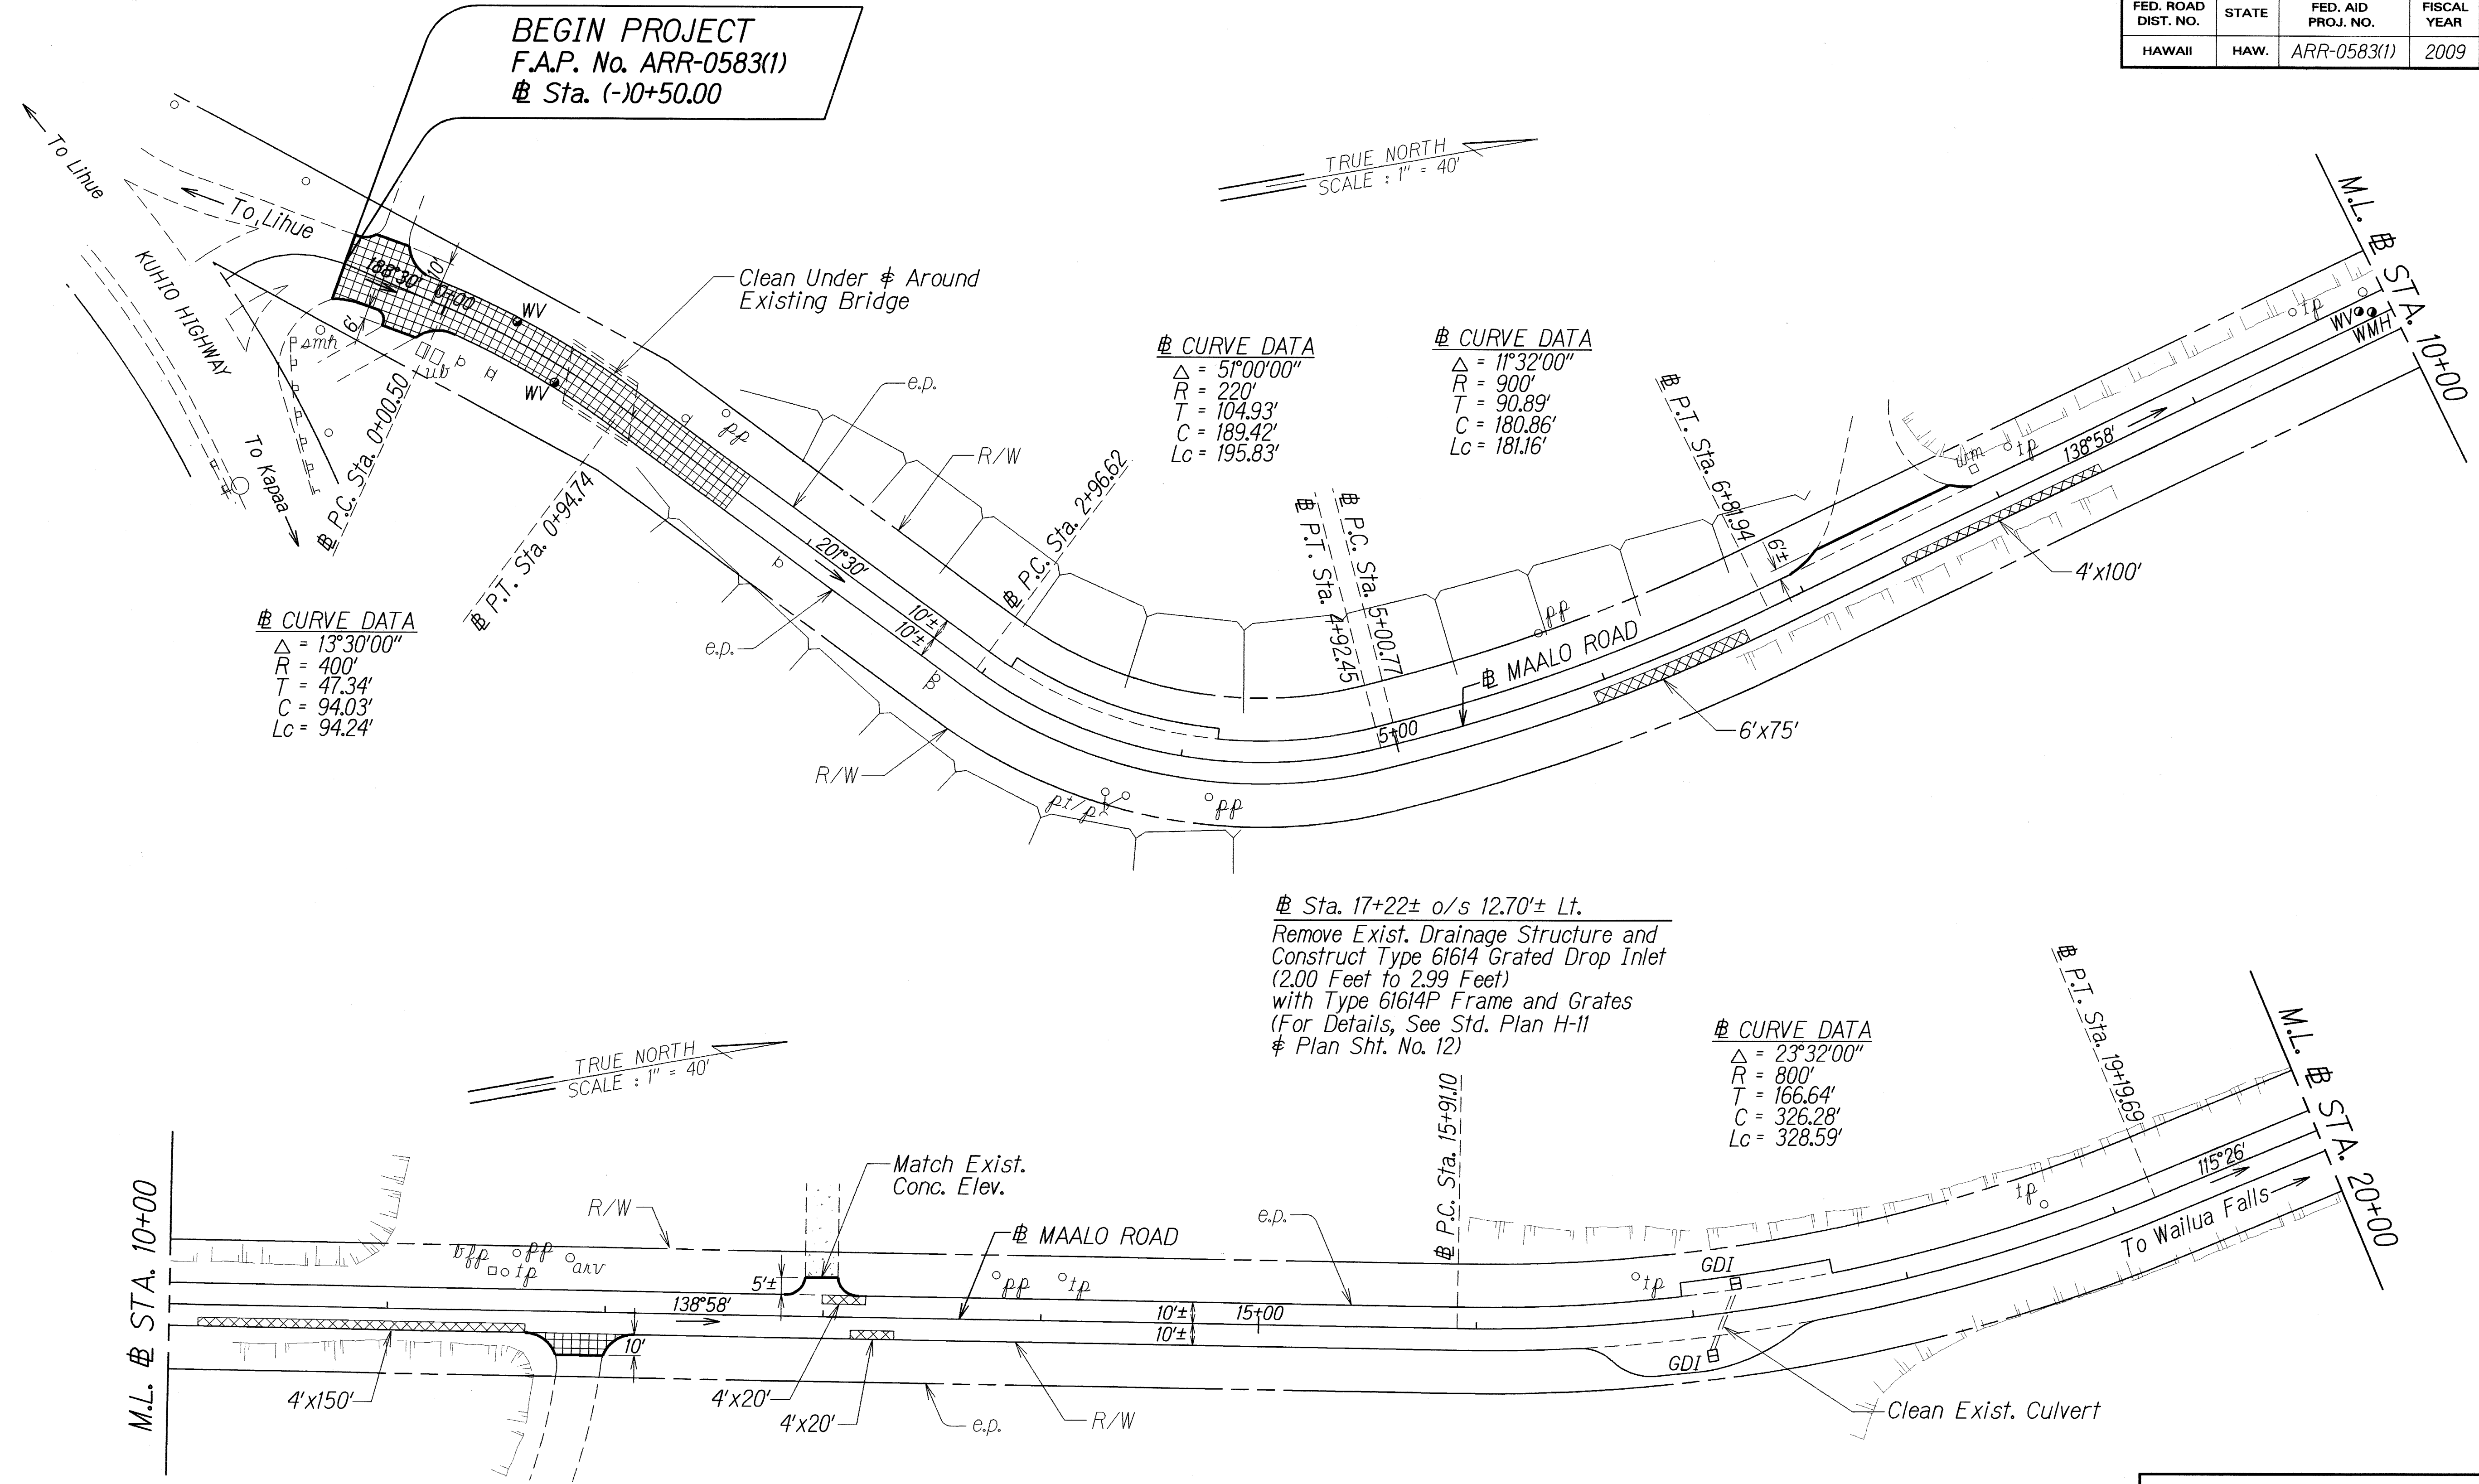

SURVEY PLOTTED BY	DATE
DRAWN BY	8/208
NOTED BY	
CHECKED BY	

Sta. 17+10± o/s 18.90± Rt.
Remove Exist. Drainage Structure and Construct Type 61614 Grated Drop Inlet (3.00 Feet to 3.99 Feet) with Type 61614P Frame and Grates (For Details, See Std. Plan H-11 & Plan Sht. No. 12)

APPROVED:
Manager & Chief Engineer
Department of Water
3/20/09
Date

STATE OF HAWAII
DEPARTMENT OF TRANSPORTATION
HIGHWAYS DIVISION


ROADWAY PLAN

MAALO ROAD RESURFACING
Mile Post 0.0 to Mile Post 1.0
Federal-Aid Project No. ARR-0583(1)

Scale: 1" = 40' Date: March 2009

SHEET No. 1 OF 3 SHEETS

FED. ROAD DIST. NO.	STATE	FED. AID PROJ. NO.	FISCAL YEAR	SHEET NO.	TOTAL SHEETS
HAWAII	HAW.	ARR-0583(1)	2009	10	17

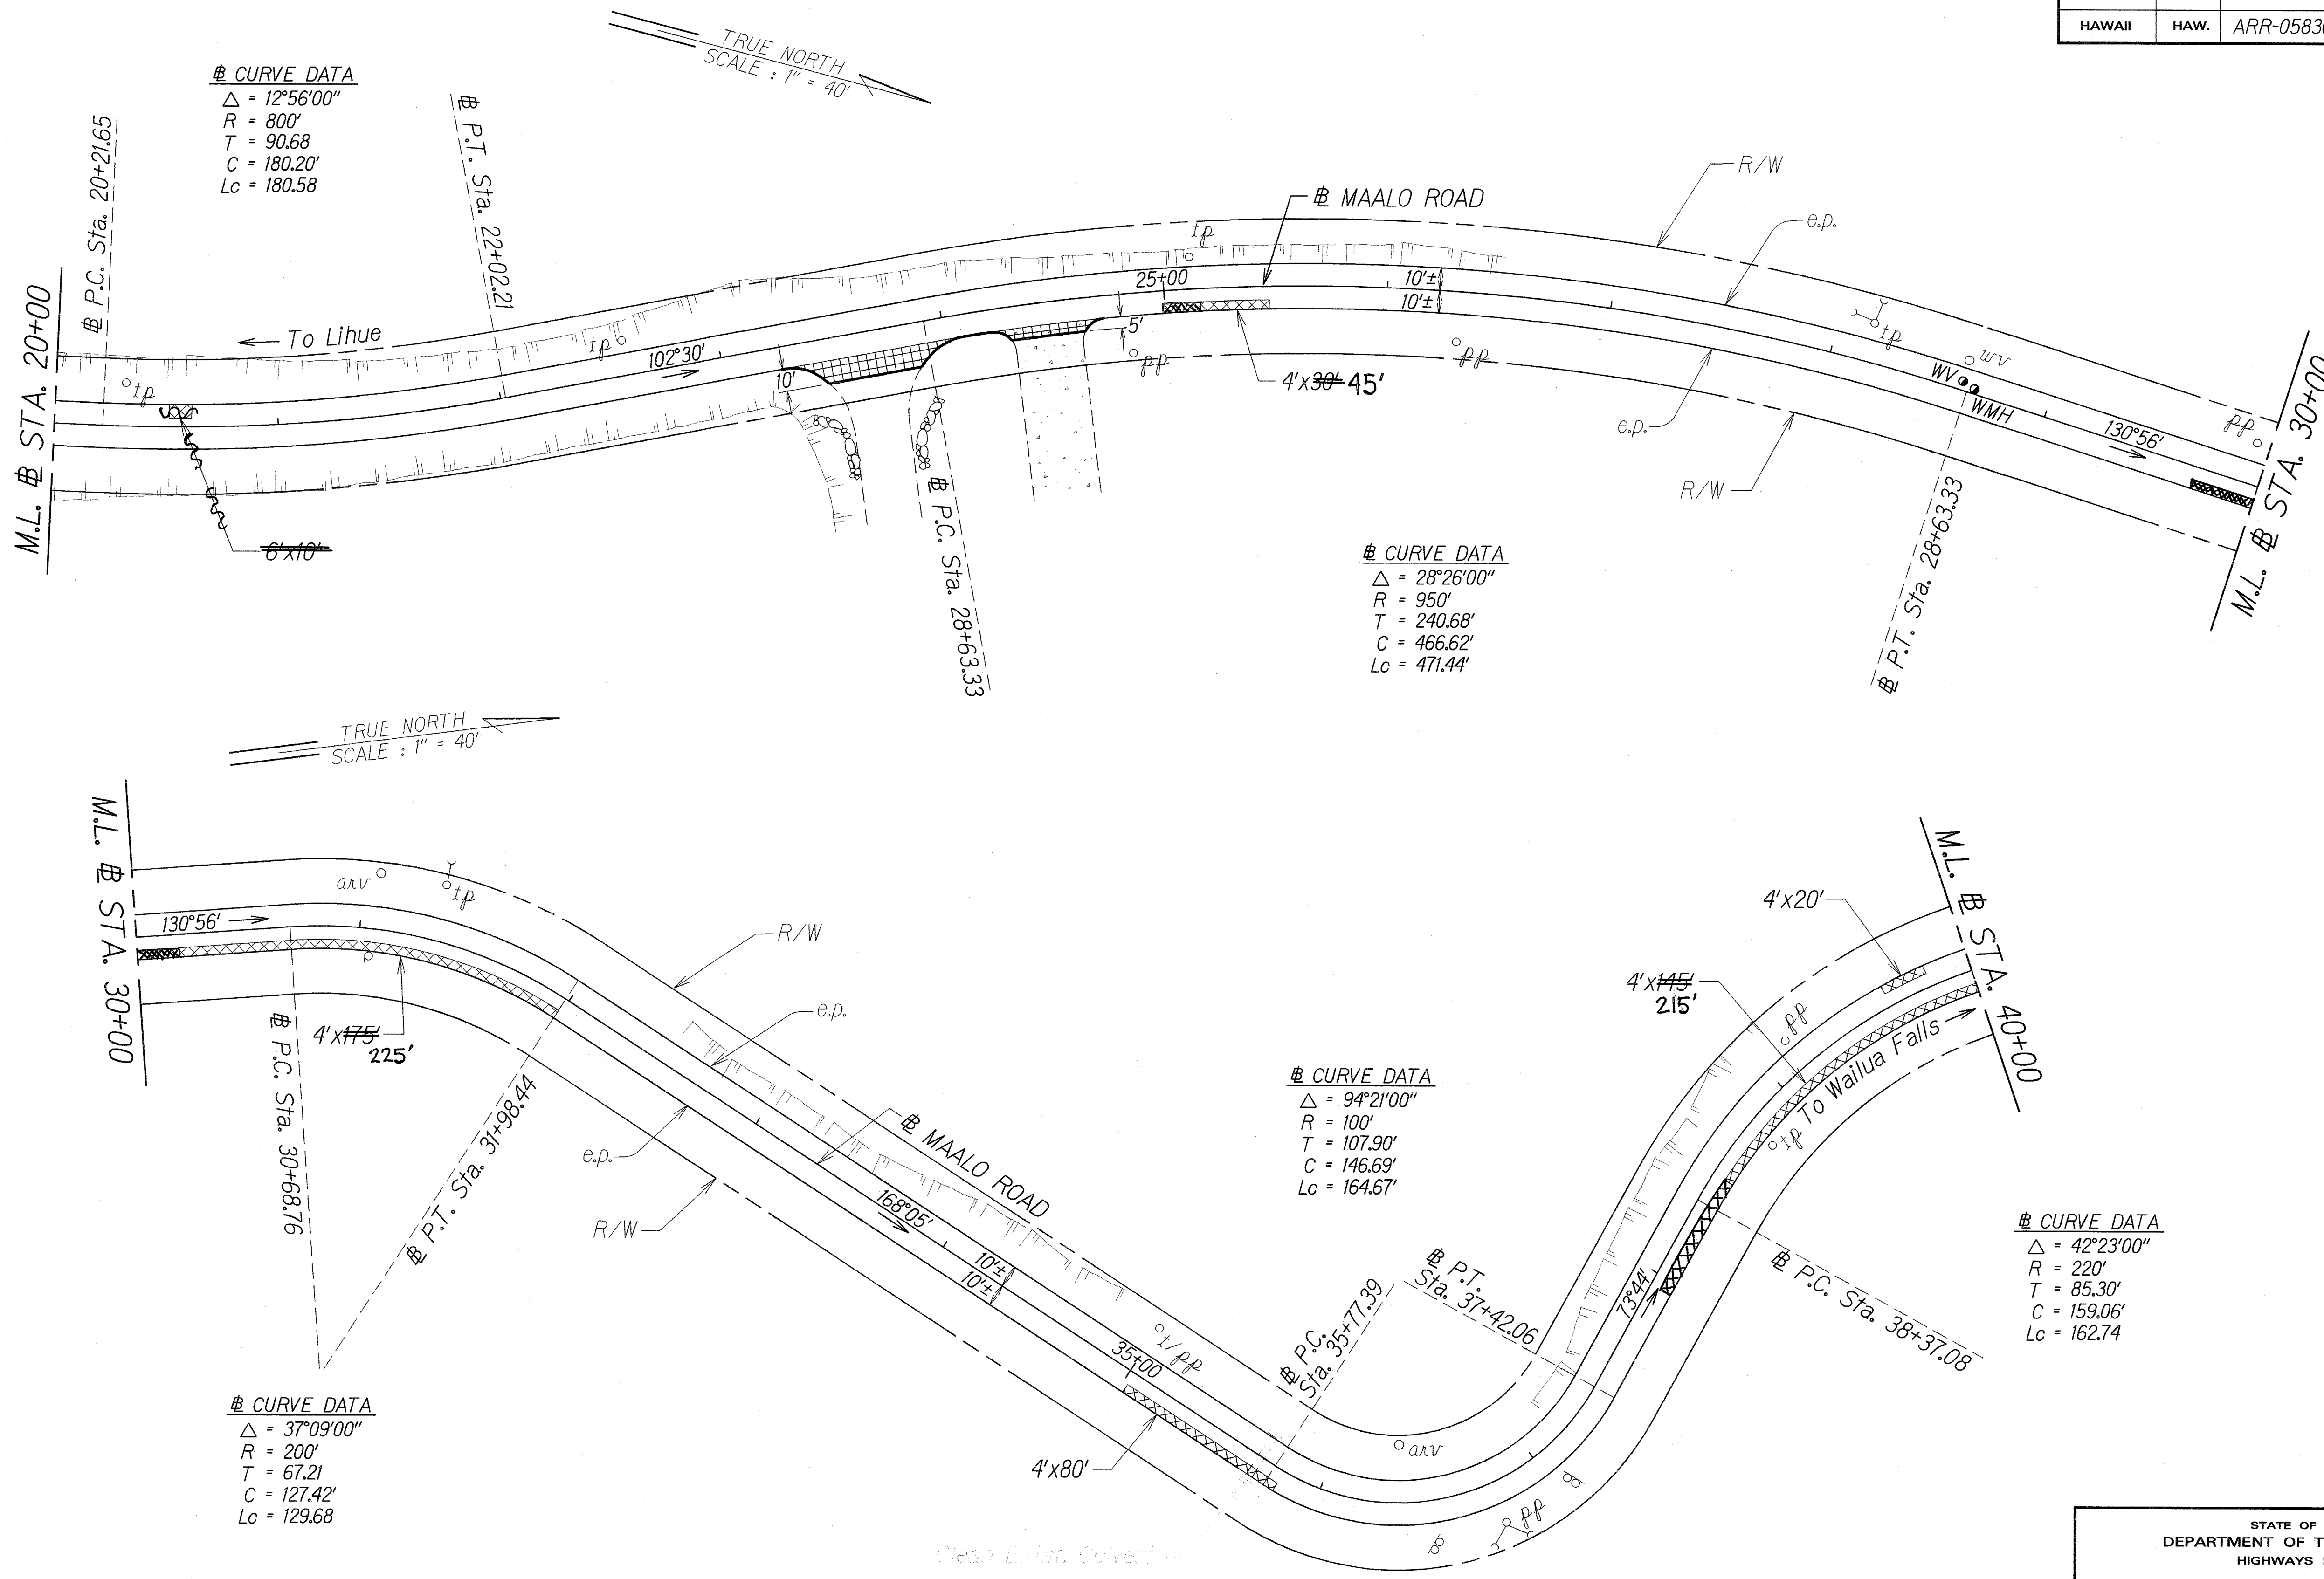

ORIGINAL PLAN	DATE
DESIGNED BY	2/08
DESIGNED BY	
QUANTITIES BY	
CHECKED BY	

APPROVED: _____
 Manager & Chief Engineer
 Department of Water
 Date: 3/30/09

STATE OF HAWAII
 DEPARTMENT OF TRANSPORTATION
 HIGHWAYS DIVISION


ROADWAY PLAN

MAALO ROAD RESURFACING
 Mile Post 0.0 to Mile Post 1.0
 Federal-Aid Project No. ARR-0583(1)

Scale: 1" = 40' Date: March 2009

SHEET No. 2 OF 3 SHEETS

FED. ROAD DIST. NO.	STATE	FED. AID PROJ. NO.	FISCAL YEAR	SHEET NO.	TOTAL SHEETS
HAWAII	HAW.	ARR-0583(1)	2009	11	17

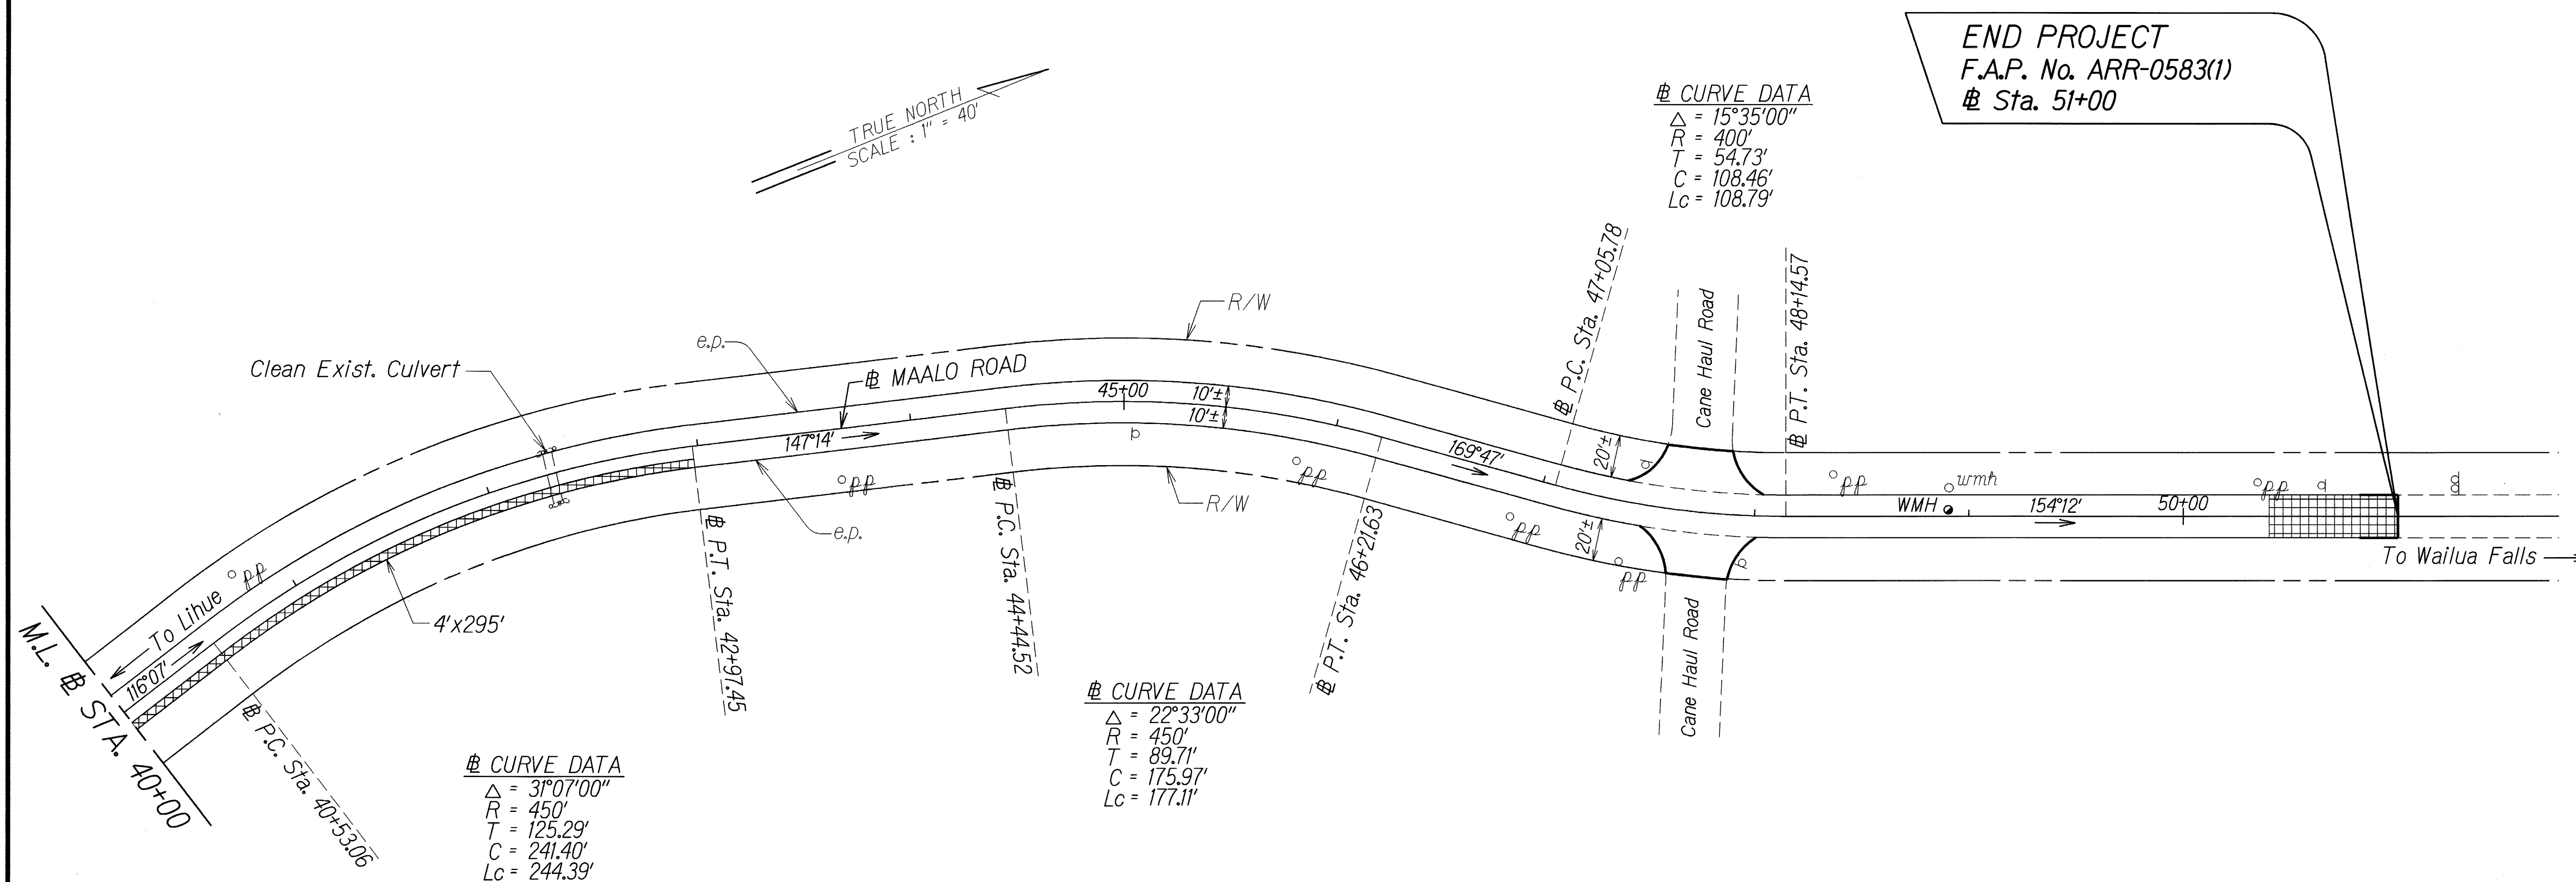

DATE	8/08
SURVEY PLOTTED BY	
DRAWN BY	
NOTE BOOK	
QUANTITIES BY	
CHECKED BY	

APPROVED:
 Manager & Chief Engineer
 Department of Water
 Date: 3/20/09

STATE OF HAWAII
 DEPARTMENT OF TRANSPORTATION
 HIGHWAYS DIVISION

ROADWAY PLAN

MAALO ROAD RESURFACING
 Mile Post 0.0 to Mile Post 1.0
 Federal-Aid Project No. ARR-0583(1)

Scale: 1" = 40' Date: March 2009

SHEET No. 3 OF 3 SHEETS