

INDEX TO DRAWINGS	
SHEET NO.	DESCRIPTION
1	TITLE SHEET
2	STANDARD PLANS SUMMARY
3	GENERAL NOTES AND LEGENDS
4 - 5	WATER POLLUTION AND EROSION CONTROL NOTES
6 - 8	TYPICAL SECTIONS
9 - 11	ROADWAY PLAN
12 - 13	DRAINAGE DETAILS
14	PAVEMENT MARKING LEGEND, DETAILS AND NOTES
15 - 17	PAVEMENT MARKING AND TRAFFIC SIGNING PLAN

STATE OF HAWAII

DEPARTMENT OF TRANSPORTATION

HIGHWAYS DIVISION

HONOLULU, HAWAII

PLANS FOR

MAALO ROAD RESURFACING




MILE POST 0.0 TO MILE POST 1.0

FEDERAL-AID PROJECT NO. ARR-0583(1)

DISTRICT OF LIHUE

ISLAND OF KAUAI

FED. ROAD DIST. NO.	STATE	FED. AID PROJ. NO.	FISCAL YEAR	SHEET NO.	TOTAL SHEETS
HAWAII	HAW.	ARR-0583(1)	2009	1	17

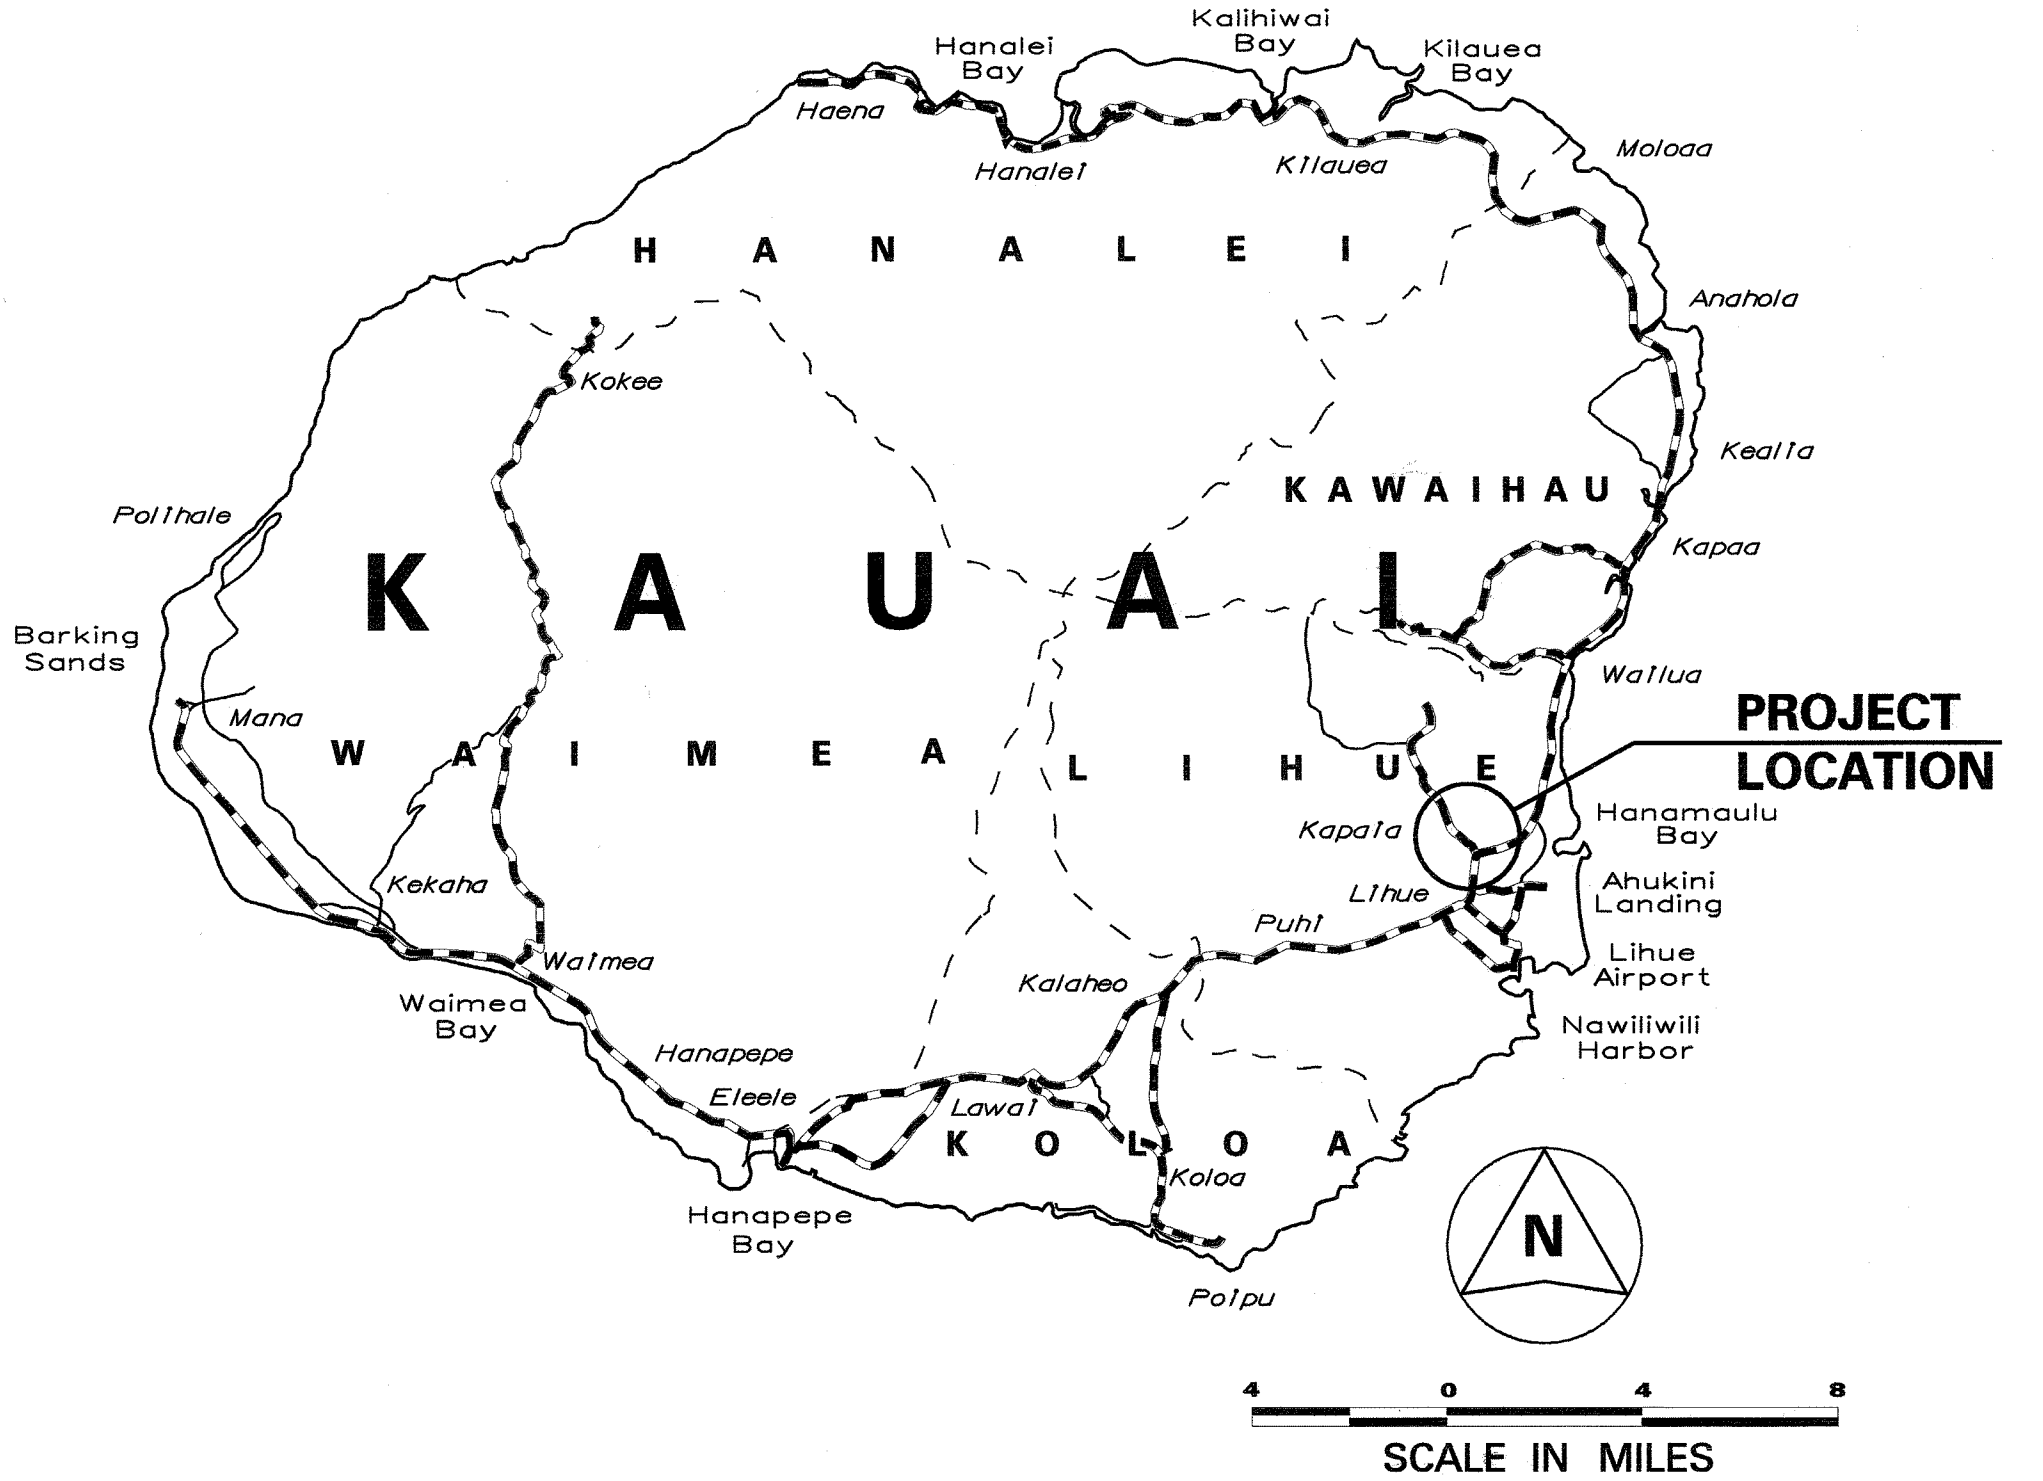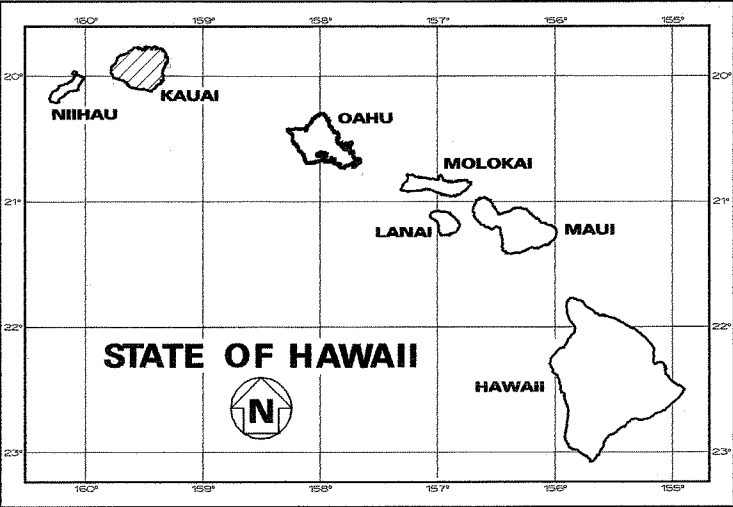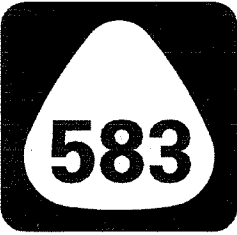

FEDERAL AID PROJECTS PREVIOUSLY CONSTRUCTED OR UNDER CONSTRUCTION

MILE POST 0.0 TO MILE POST 1.0

DESIGN DESIGNATION

ADT (2009).....	1,000
ADT (2029).....	1,400
DHV	200
D	55/45
T	4.5 %
V	25 M.P.H.

CHANGES MADE DURING CONSTRUCTION HAVE BEEN INCORPORATED ON THESE PLANS EXCEPT CHANGES IN THE ORIGINAL THEORETICAL QUANTITIES. FOR ACTUAL QUANTITIES, REFER TO PROJECT LEDGER AND/OR COMPUTATION BOOK.

8/30/10

DEPARTMENT OF TRANSPORTATION STATE OF HAWAII	
APPROVED:	
DIR. OF TRANSPORTATION	DATE

DESIGNED BY

HWY-K

MANAGED BY



HWY-KE

PHONE

241-3000

DATE

MAR. 2009

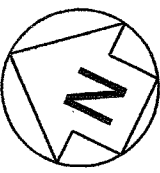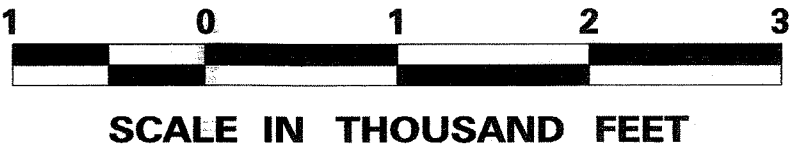

LAYOUT PLAN

GROSS LENGTH OF PROJECT.....1.00 MILE

NET LENGTH OF PROJECT.....0.98 MILES

