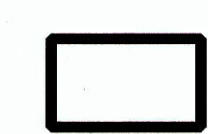
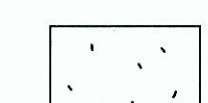


FED. ROAD DIST. NO.	STATE	PROJ. NO.	FISCAL YEAR	SHEET NO.	TOTAL SHEETS
HAWAII	HAW.	5600-01-12	2012	2	3


LEGEND



 4" AC Mix IV
 12" Aggregate Base
 or
 Match Existing Pavement


 2" Min. AC Mix IV


 CLSM


 GRP

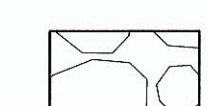
 Dumped Riprap

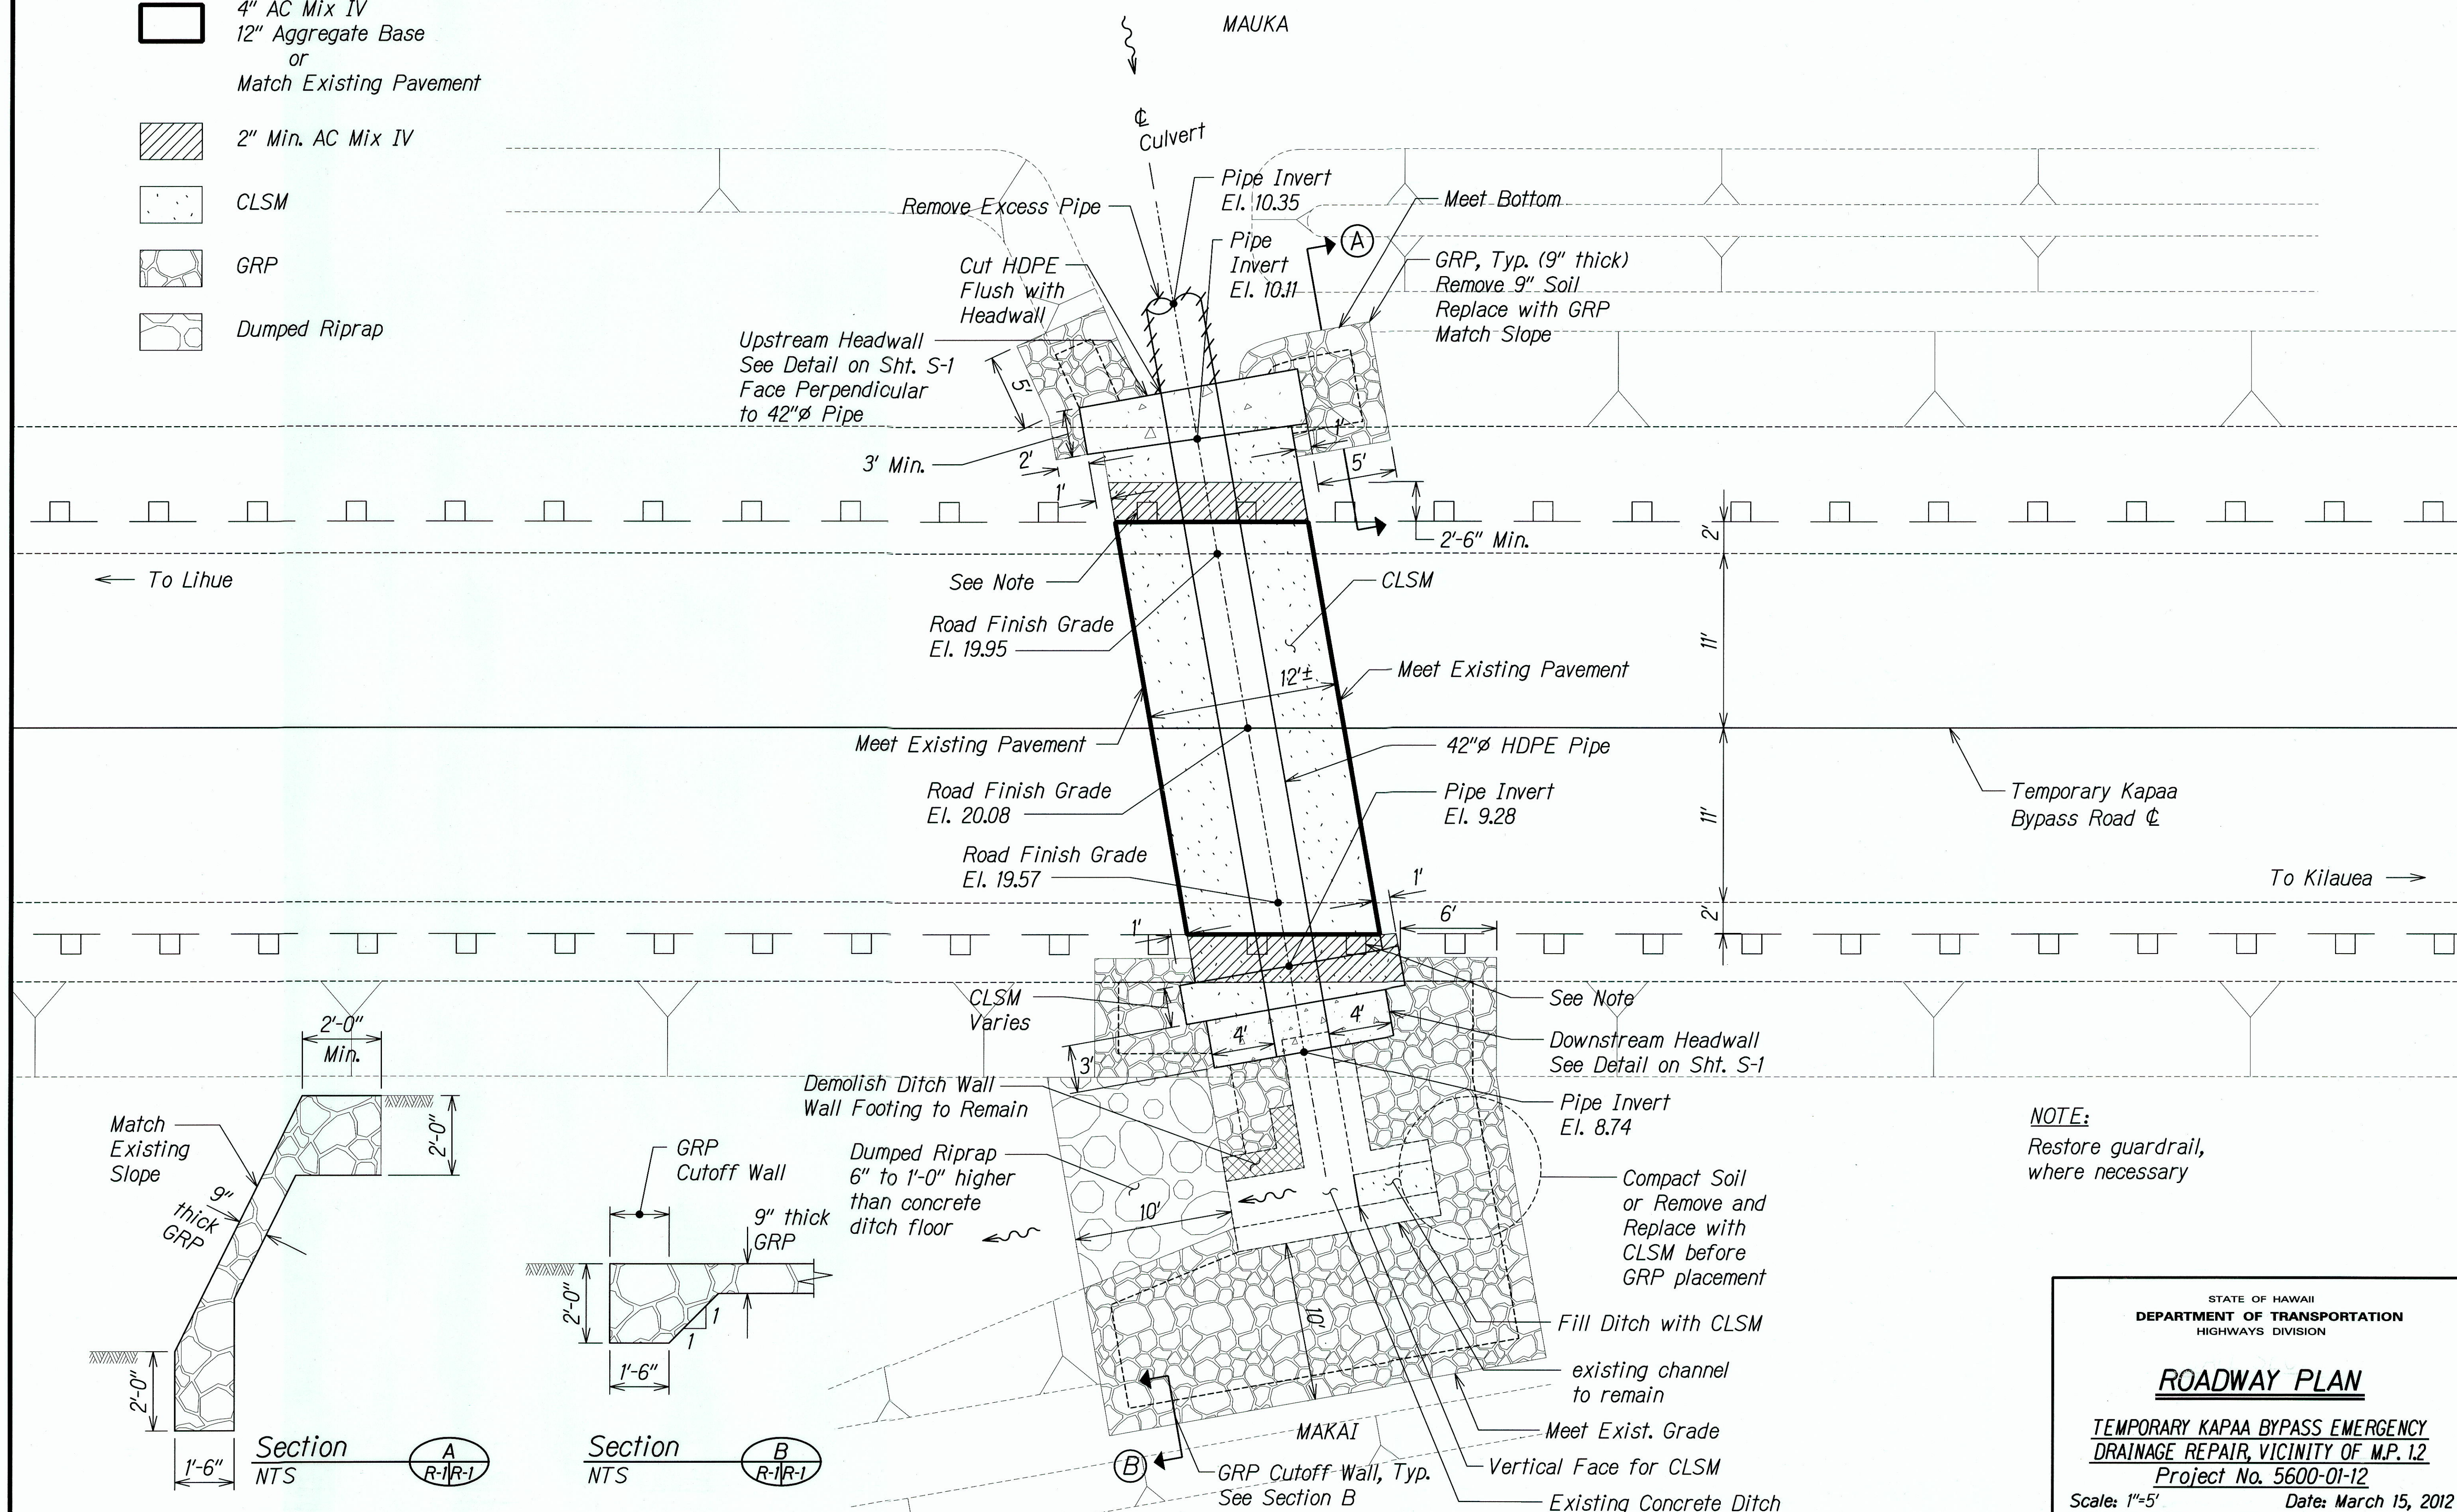

NOTE:
 Restore guardrail,
 where necessary

STATE OF HAWAII
 DEPARTMENT OF TRANSPORTATION
 HIGHWAYS DIVISION

ROADWAY PLAN
 TEMPORARY KAPAA BYPASS EMERGENCY
 DRAINAGE REPAIR, VICINITY OF M.P. 1.2
 Project No. 5600-01-12
 Scale: 1"=5' Date: March 15, 2012
 SHEET No. R-1 OF 1 SHEETS

"AS-BUILT"