

INDEX TO DRAWINGS	
SHEET NO.	DESCRIPTION
1	TITLE SHEET
2	ROADWAY PLAN
3	HEADWALL SECTIONS

STATE OF HAWAII

DEPARTMENT OF TRANSPORTATION

HIGHWAYS DIVISION

HONOLULU, HAWAII

"AS-BUILT"

PLANS FOR

TEMPORARY KAPAA BYPASS

EMERGENCY DRAINAGE REPAIR,




VICINITY OF M.P. 1.2

PROJECT NO. 5600-01-12

DISTRICT OF KAWAIHAU

ISLAND OF KAUAI

FED. ROAD DIST. NO.	STATE	PROJ. NO.	FISCAL YEAR	SHEET NO.	TOTAL SHEETS
HAWAII	HAW.	5600-01-12	2012	1	3

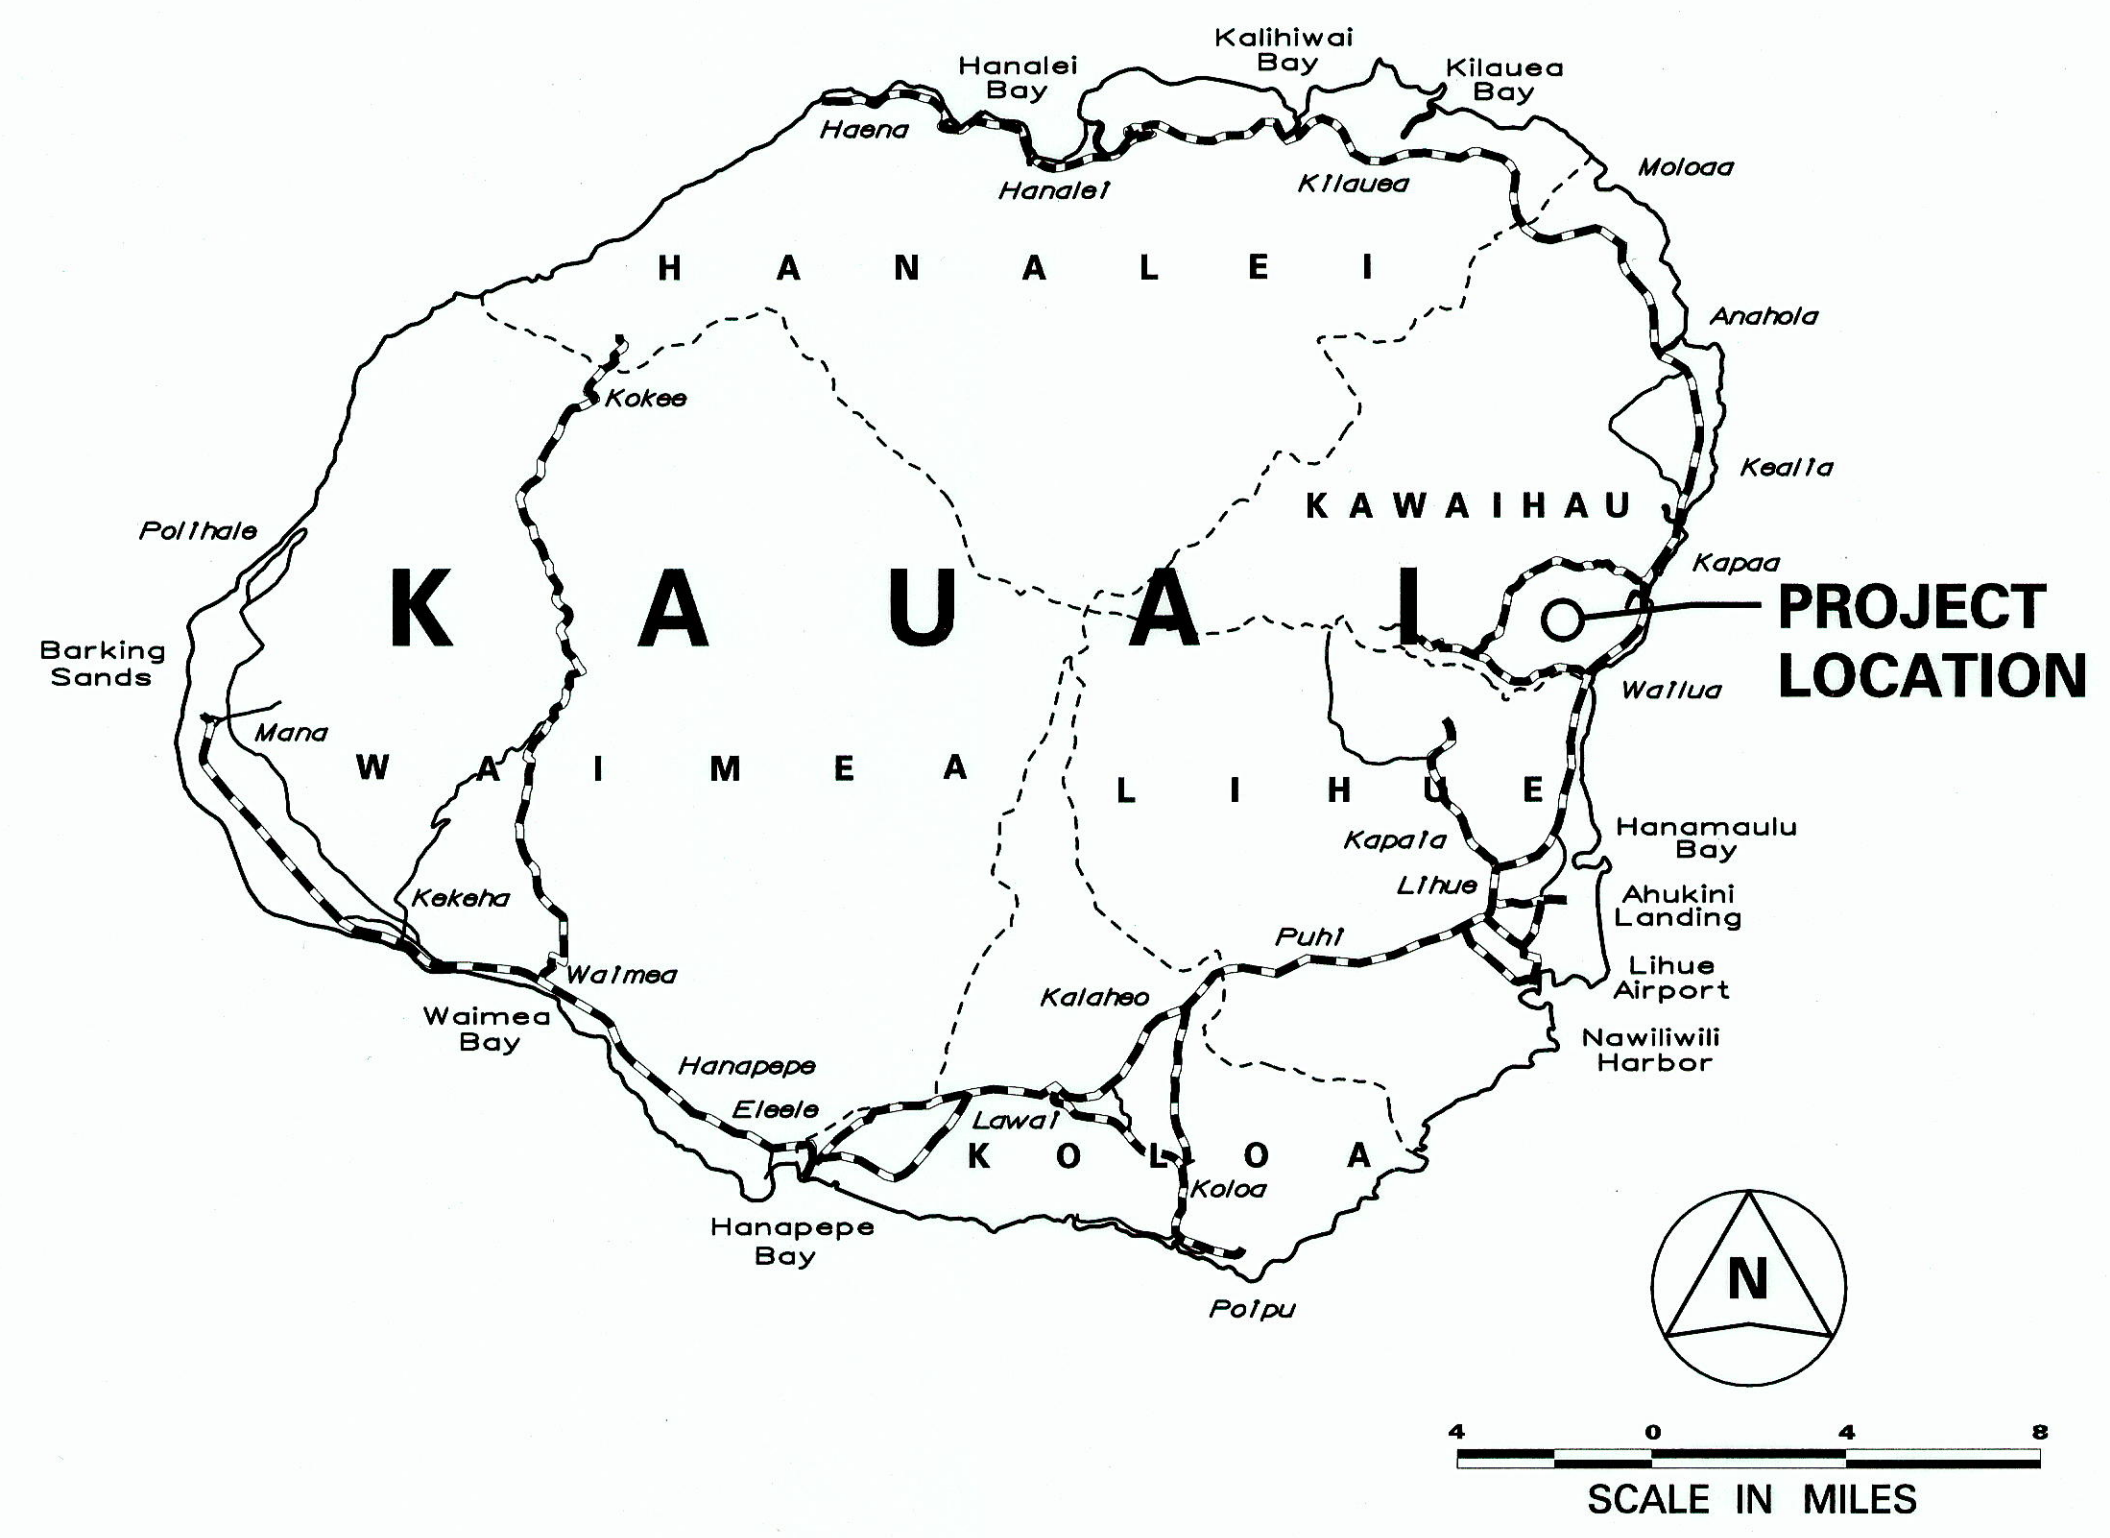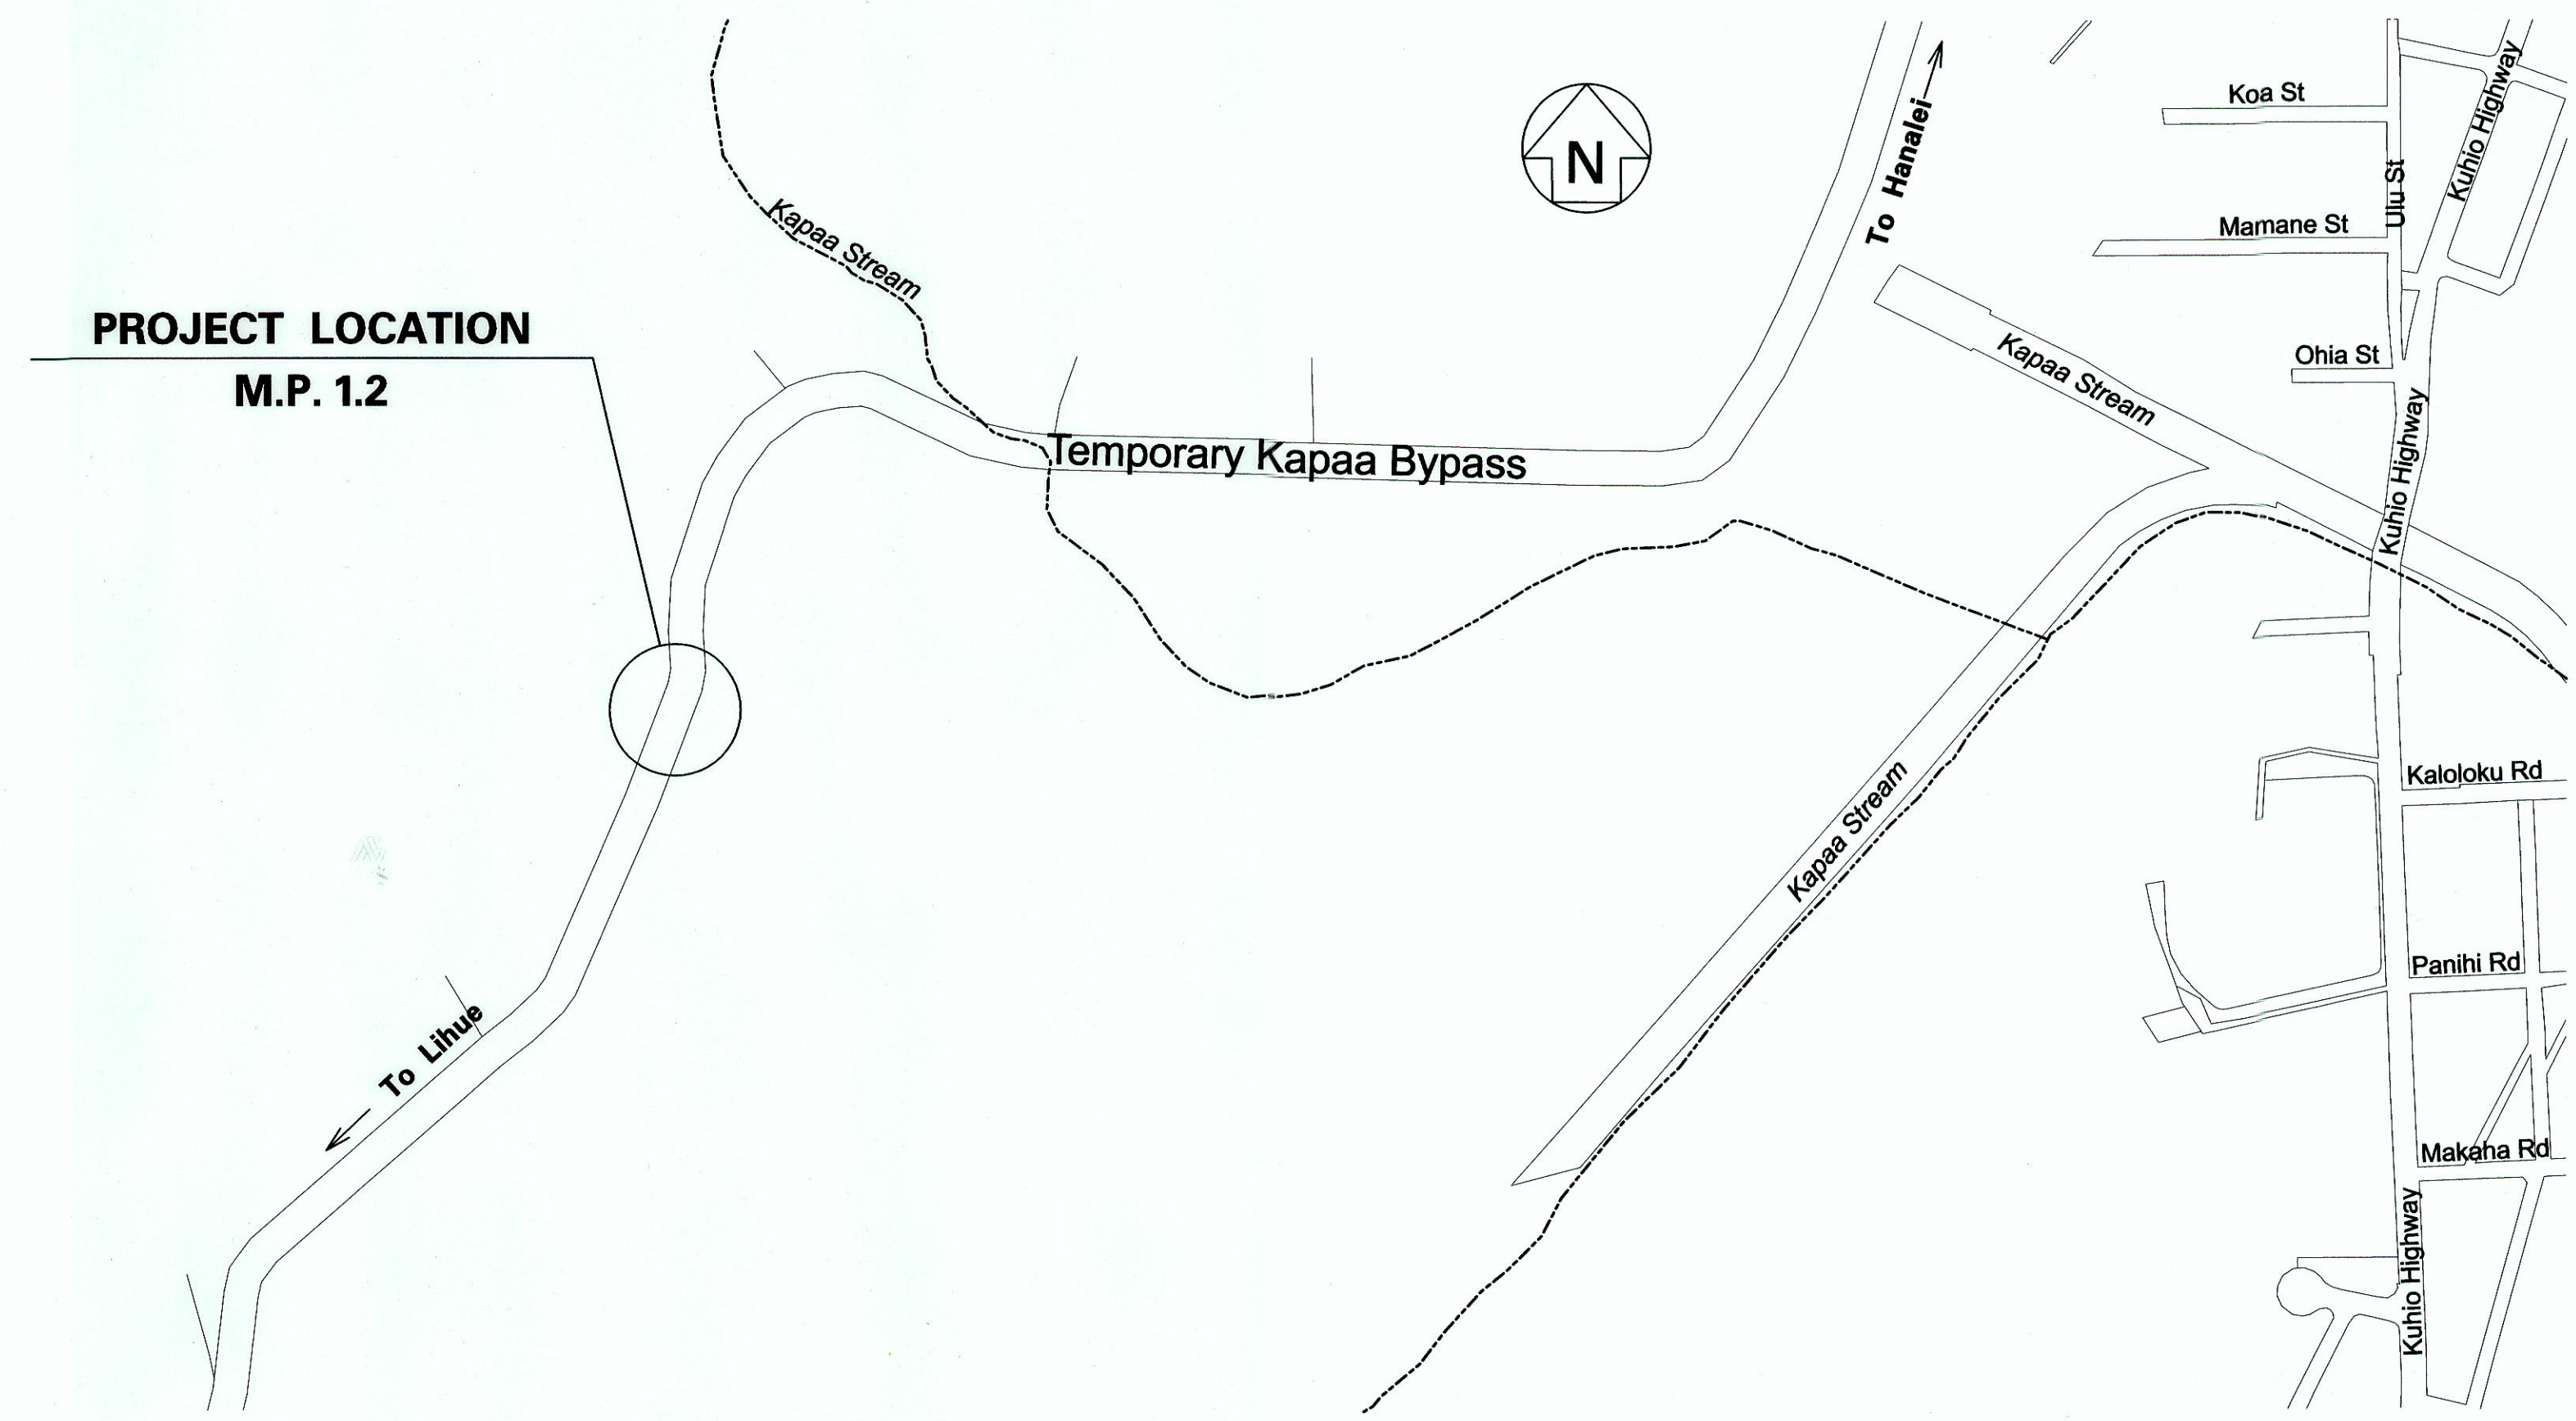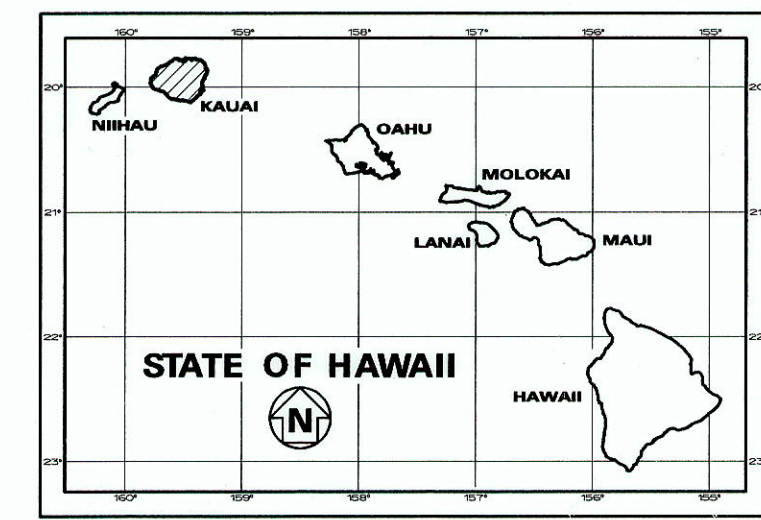

CHANGES MADE DURING CONSTRUCTION HAVE BEEN INCORPORATED ON THESE PLANS EXCEPT CHANGES IN THE ORIGINAL THEORETICAL QUANTITIES. FOR ACTUAL QUANTITIES, REFER TO PROJECT LEDGER AND/OR COMPUTATION BOOK.

William R. Hahala
 RESIDENT ENGINEER

January 14, 2013
 DATE

DEPARTMENT OF TRANSPORTATION

STATE OF HAWAII

APPROVED:

John C. Higgins

DISTRICT ENGINEER

2/10/15

DATE

ORIGINAL PLAN

NOTE BOOK

DATE

SURVEY PLOTTED BY

DRAWN BY

DESIGNED BY

CHECKED BY

DATE

DESIGNED BY

MANAGED BY

PHONE

DATE

LAYOUT PLAN

Not to Scale