



FED. ROAD DIST. NO.	STATE	PROJ. NO.	FISCAL YEAR	SHEET NO.	TOTAL SHEETS
HAWAII	HAW.	5600-02-10M	2010	9	29

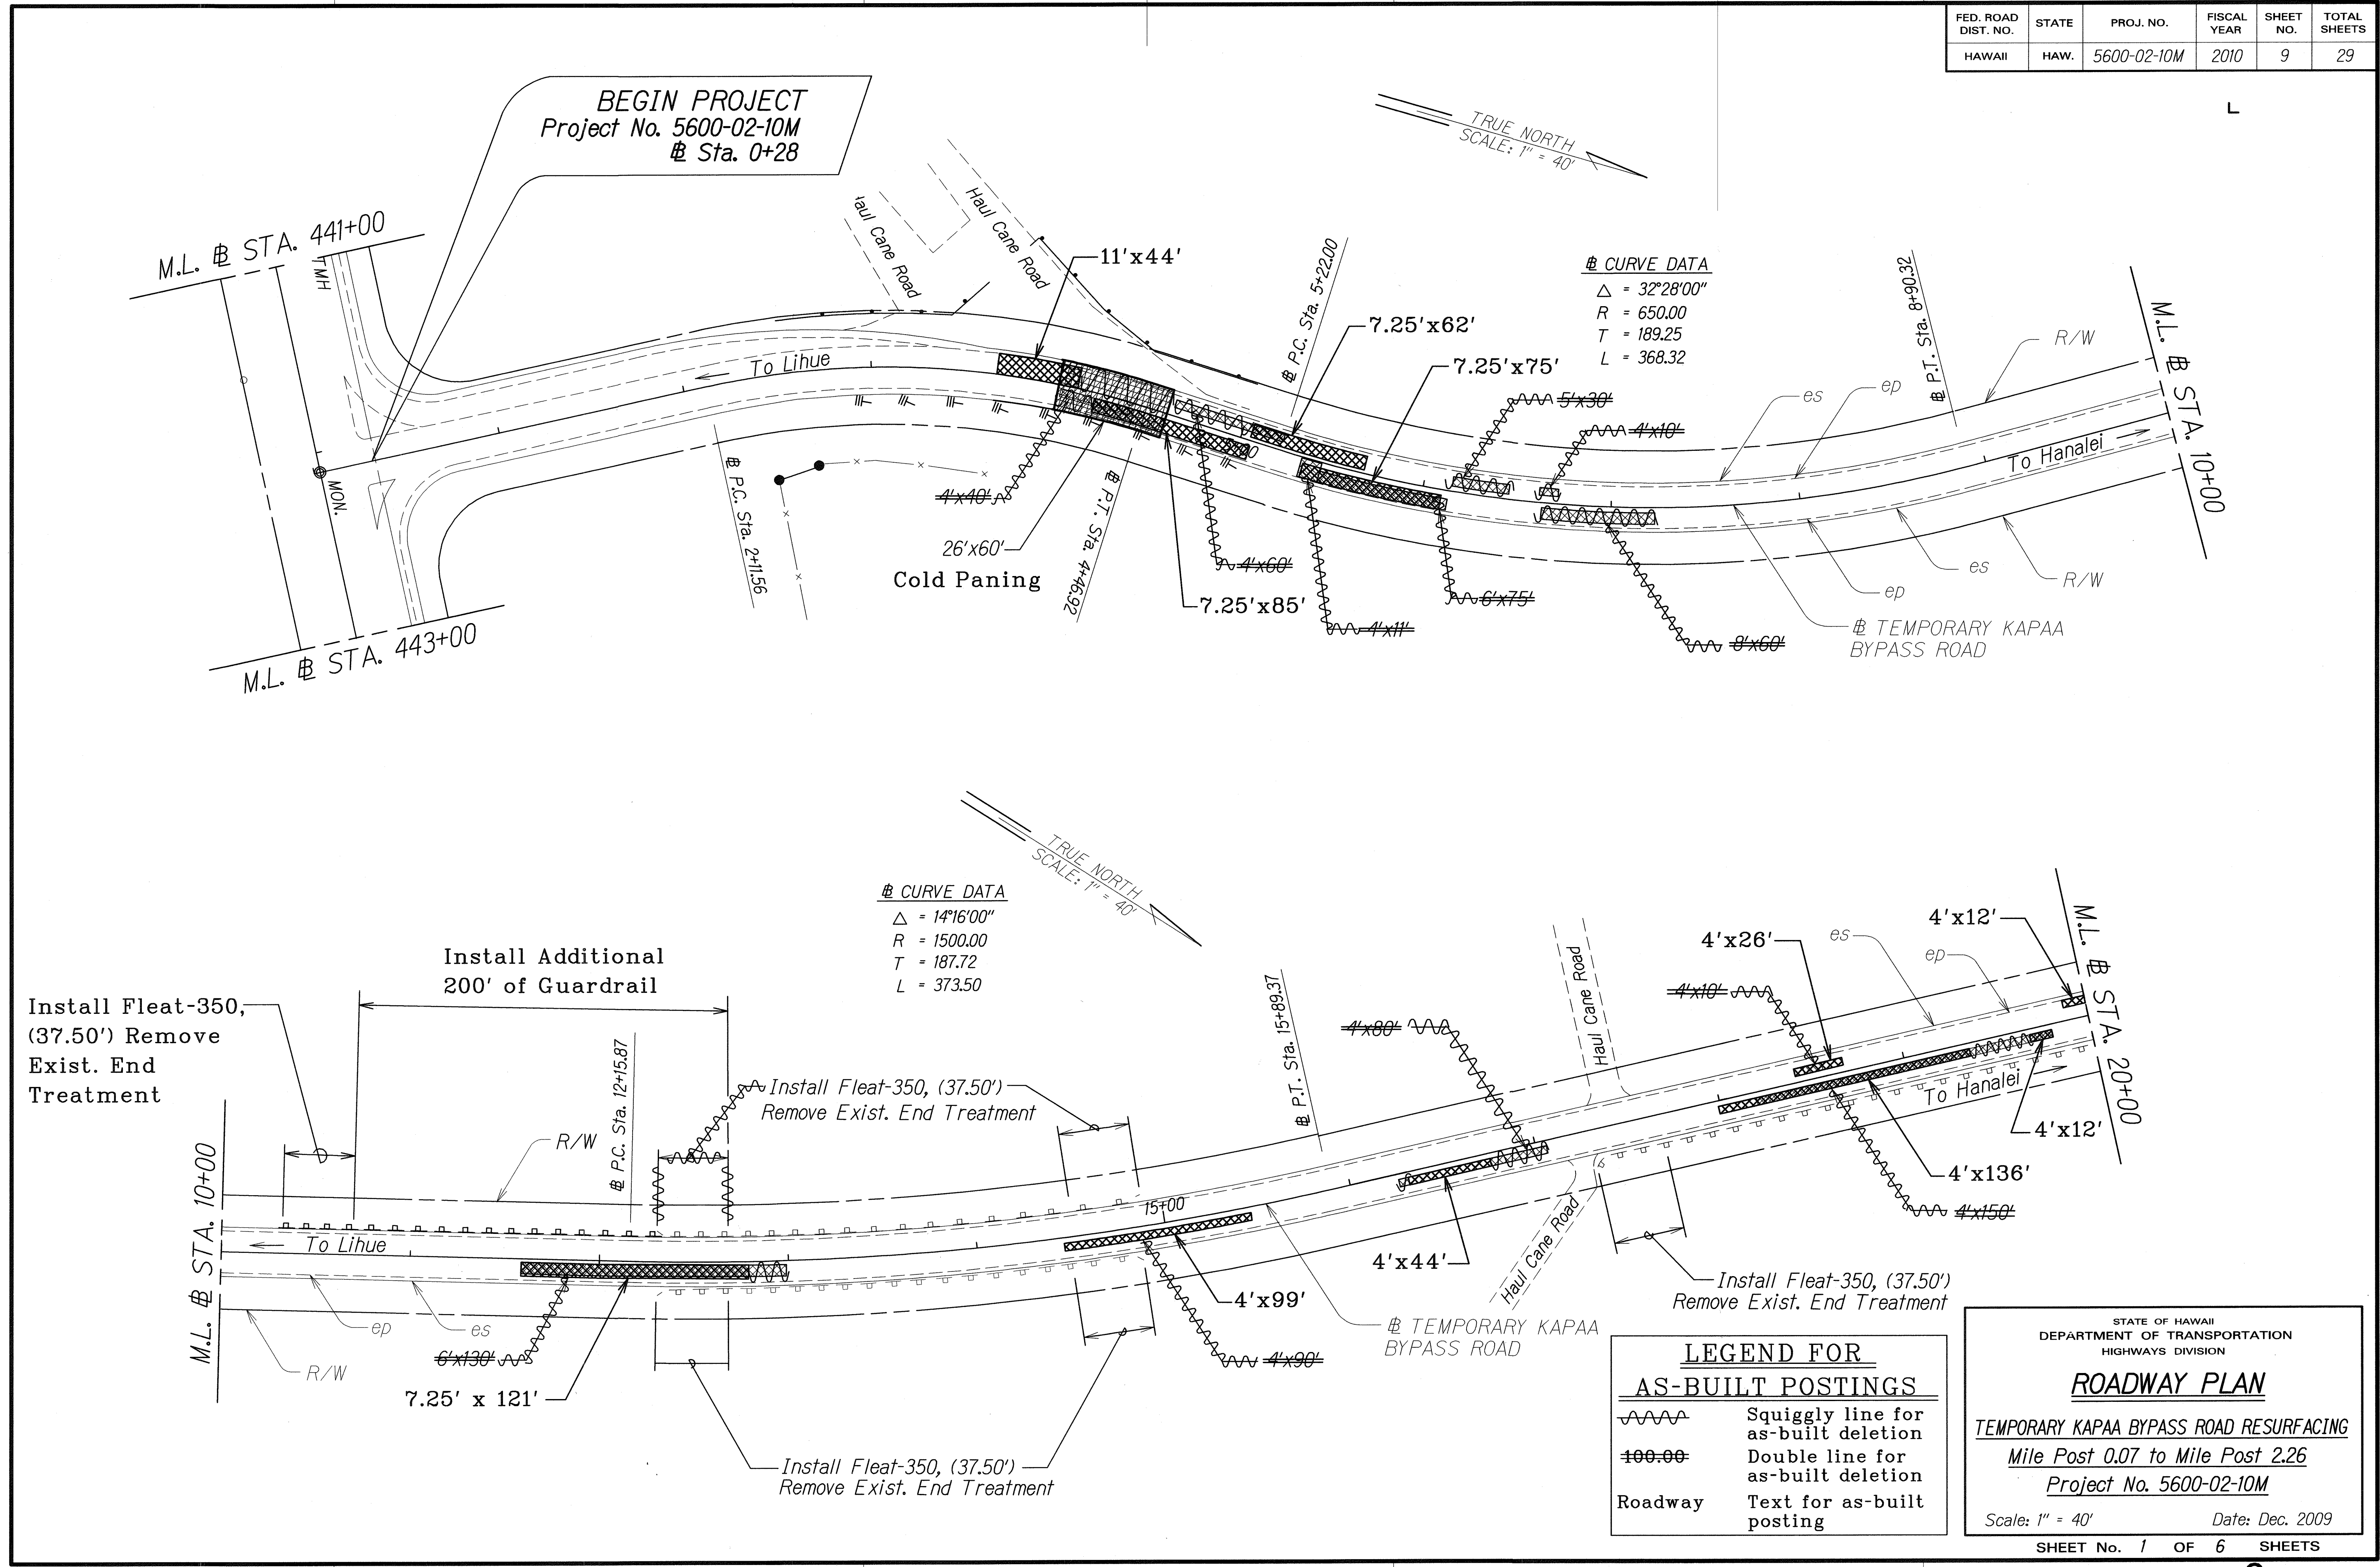

ORIGINAL PLAN	SURVEY PLOTTED BY	DATE
DRAWN BY		12/09
NOTED BY		
CHECKED BY		
DATE		

FED. ROAD DIST. NO.	STATE	PROJ. NO.	FISCAL YEAR	SHEET NO.	TOTAL SHEETS
HAWAII	HAW.	5600-02-10M	2010	10	29

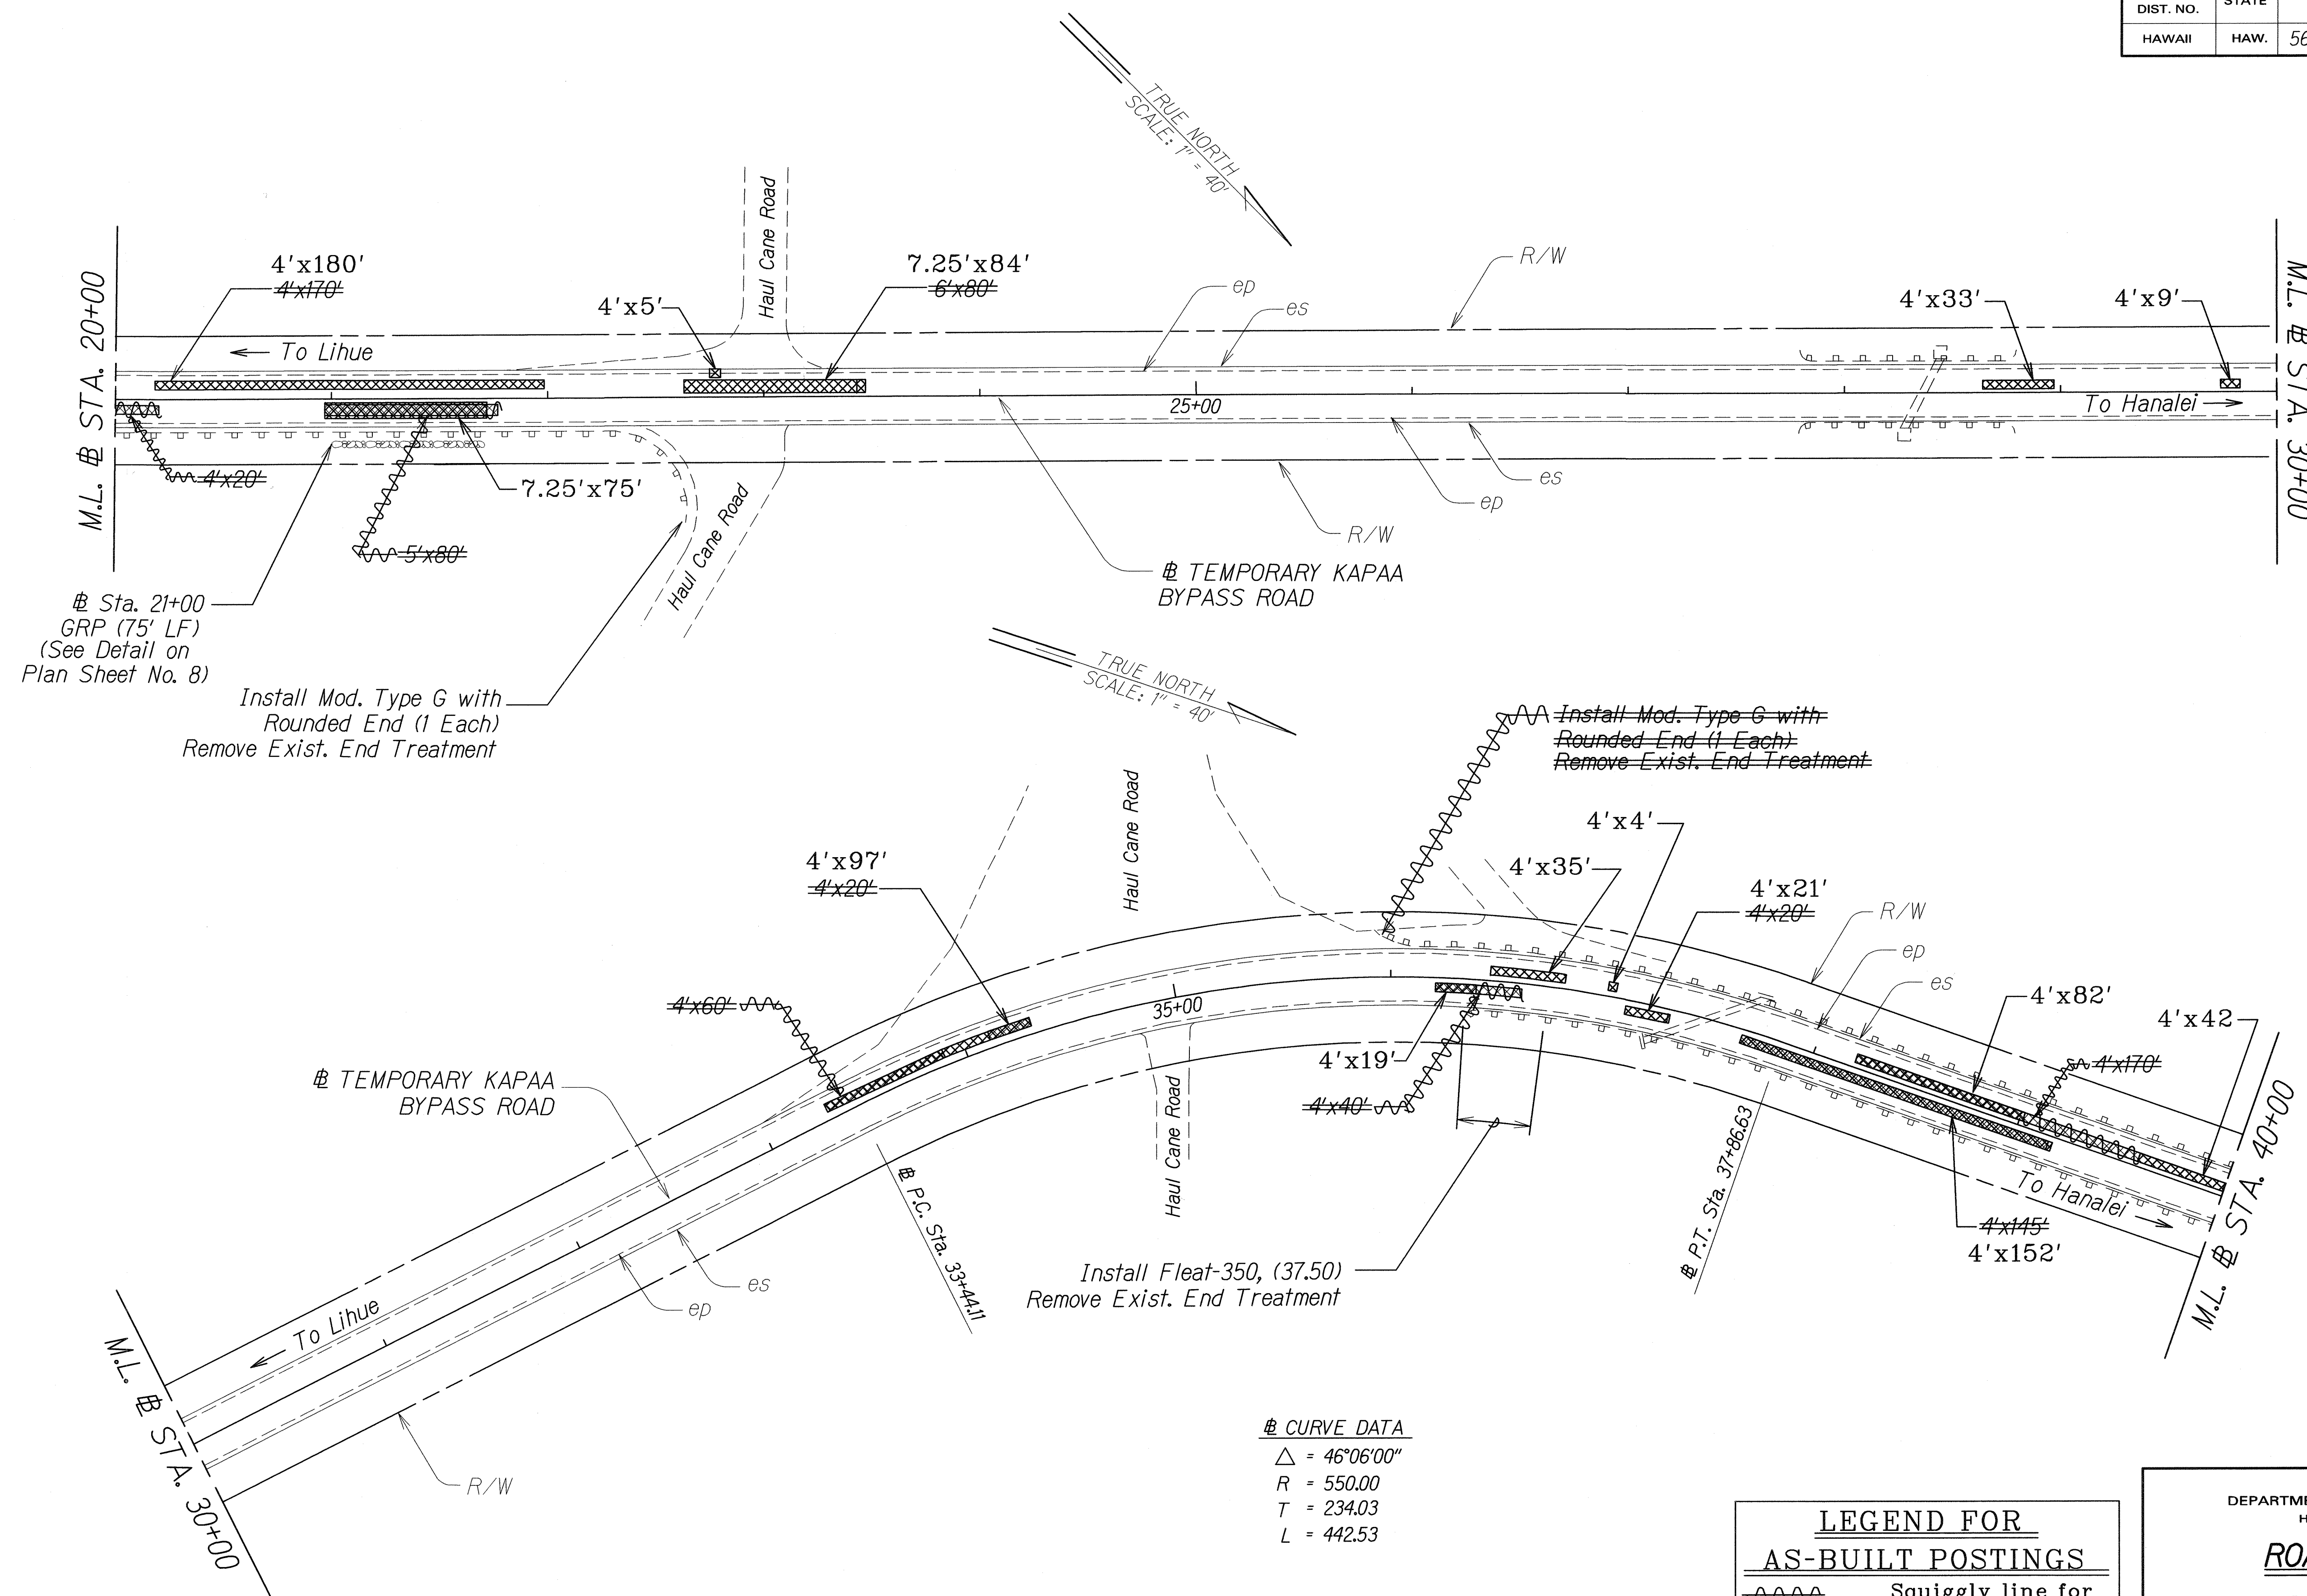

CURVE DATA
 $\Delta = 46^{\circ}06'00''$
 $R = 550.00$
 $T = 234.03$
 $L = 442.53$

LEGEND FOR AS-BUILT POSTINGS	
	Squiggly line for as-built deletion
	Double line for as-built deletion
Roadway	Text for as-built posting



STATE OF HAWAII DEPARTMENT OF TRANSPORTATION HIGHWAYS DIVISION	
ROADWAY PLAN	
TEMPORARY KAPAA BYPASS ROAD RESURFACING	
Mile Post 0.07 to Mile Post 2.26	
Project No. 5600-02-10M	
Scale: 1" = 40'	Date: Dec. 2009
SHEET No. 2 OF 6 SHEETS	

"AS-BUILT"

10

ORIGINAL PLAN	SURVEY PLOTTED BY	DATE
NOTE BOOK	DRAWN BY	12/09
DESIGNED BY	CHECKED BY	
NO.		

FED. ROAD DIST. NO.	STATE	PROJ. NO.	FISCAL YEAR	SHEET NO.	TOTAL SHEETS
HAWAII	HAW.	5600-02-10M	2010	11	29

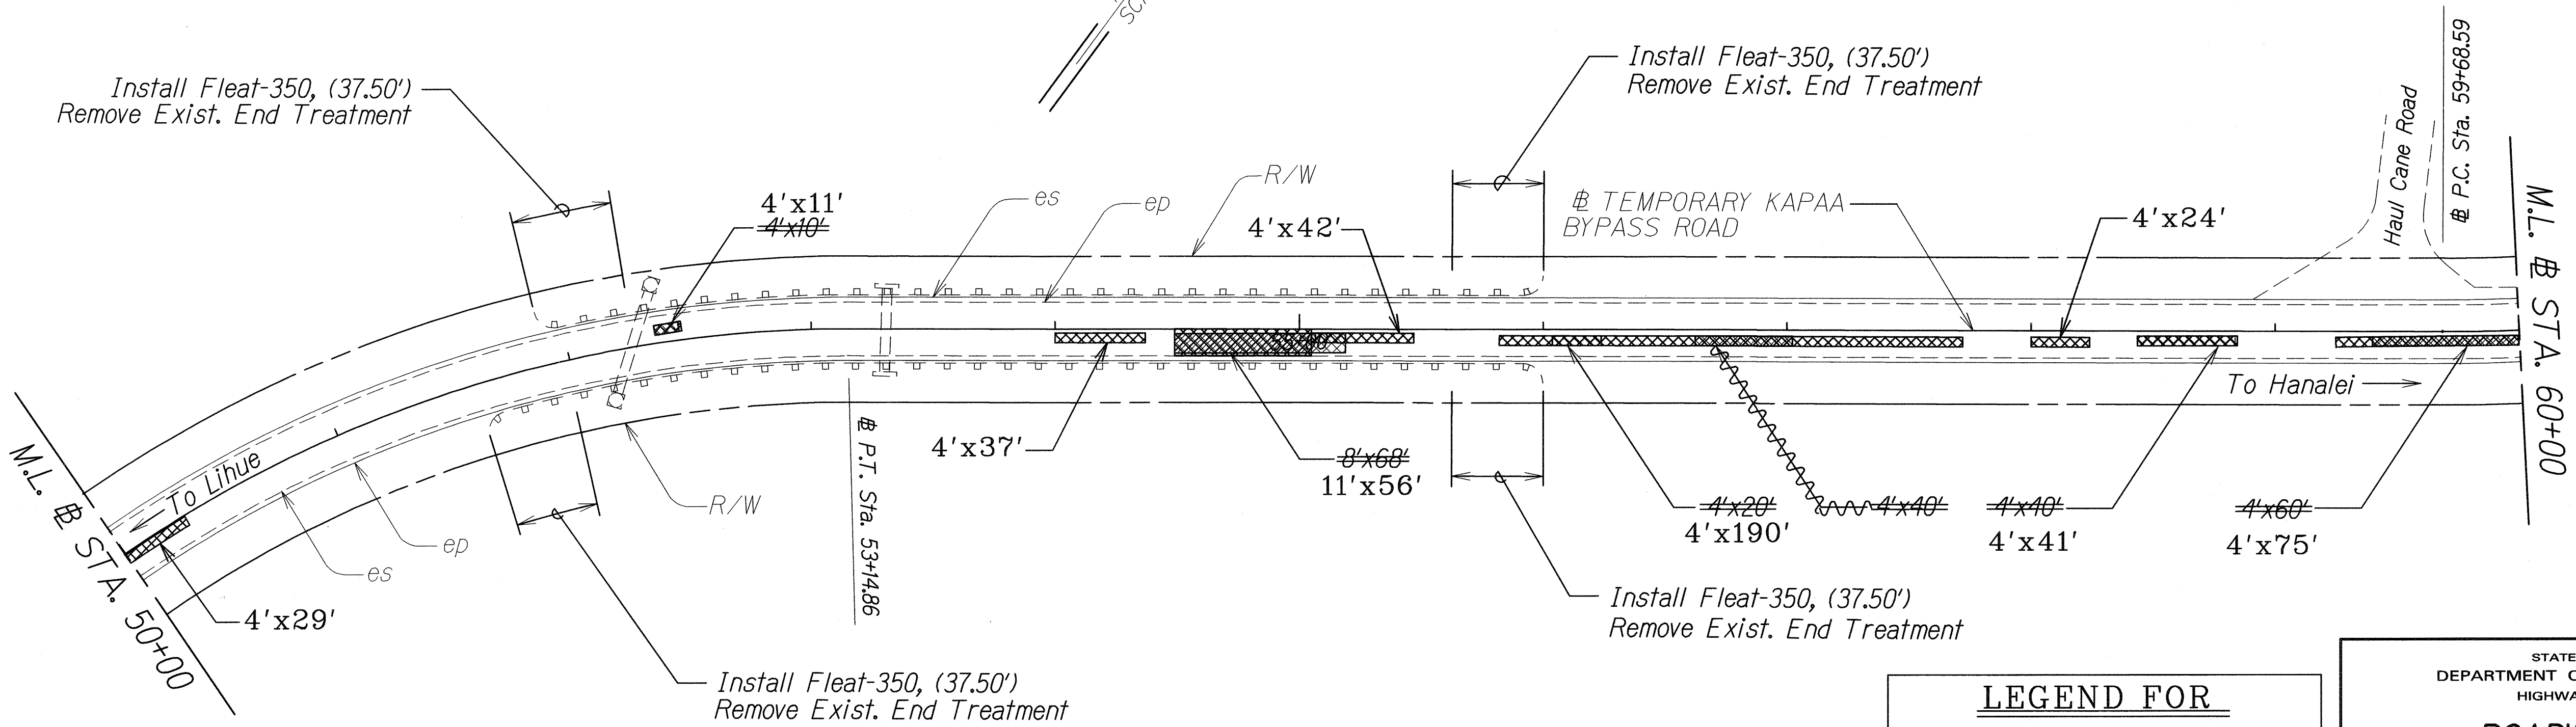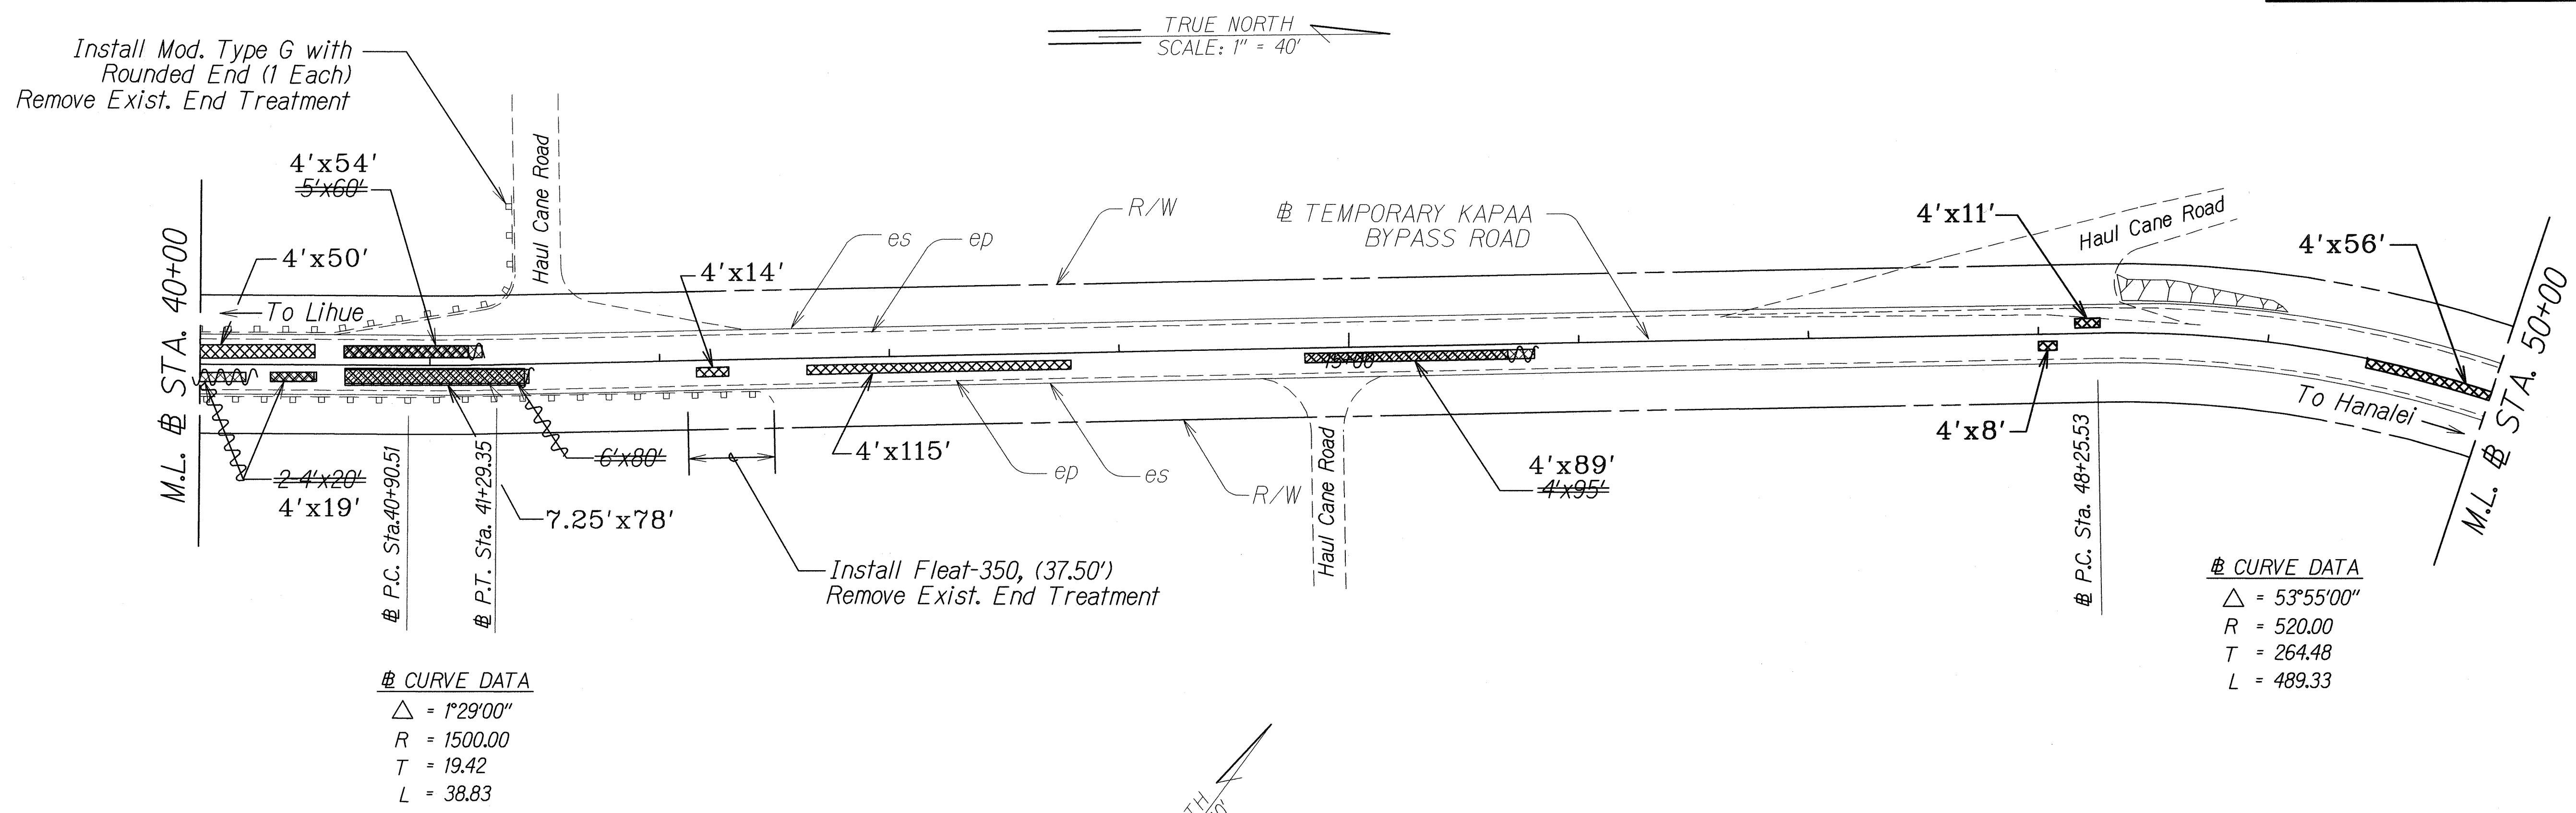

ORIGINAL PLAN	SURVEY PLOTTED BY	DATE
NOTE BOOK	DRAWN BY	12/03
REFERENCE	DESIGNED BY	
REVISION	CHECKED BY	
DATE		

LEGEND FOR AS-BUILT POSTINGS	
	Squiggly line for as-built deletion
	Double line for as-built deletion
Roadway	Text for as-built posting

STATE OF HAWAII
DEPARTMENT OF TRANSPORTATION
HIGHWAYS DIVISION

ROADWAY PLAN

TEMPORARY KAPAA BYPASS ROAD RESURFACING

Mile Post 0.07 to Mile Post 2.26

Project No. 5600-02-10M


Scale: 1" = 40'

Date: Dec. 2009

SHEET No. 3 OF 6 SHEETS

"AS-BUILT"


FED. ROAD DIST. NO.	STATE	PROJ. NO.	FISCAL YEAR	SHEET NO.	TOTAL SHEETS
HAWAII	HAW.	5600-02-10M	2010	12	29

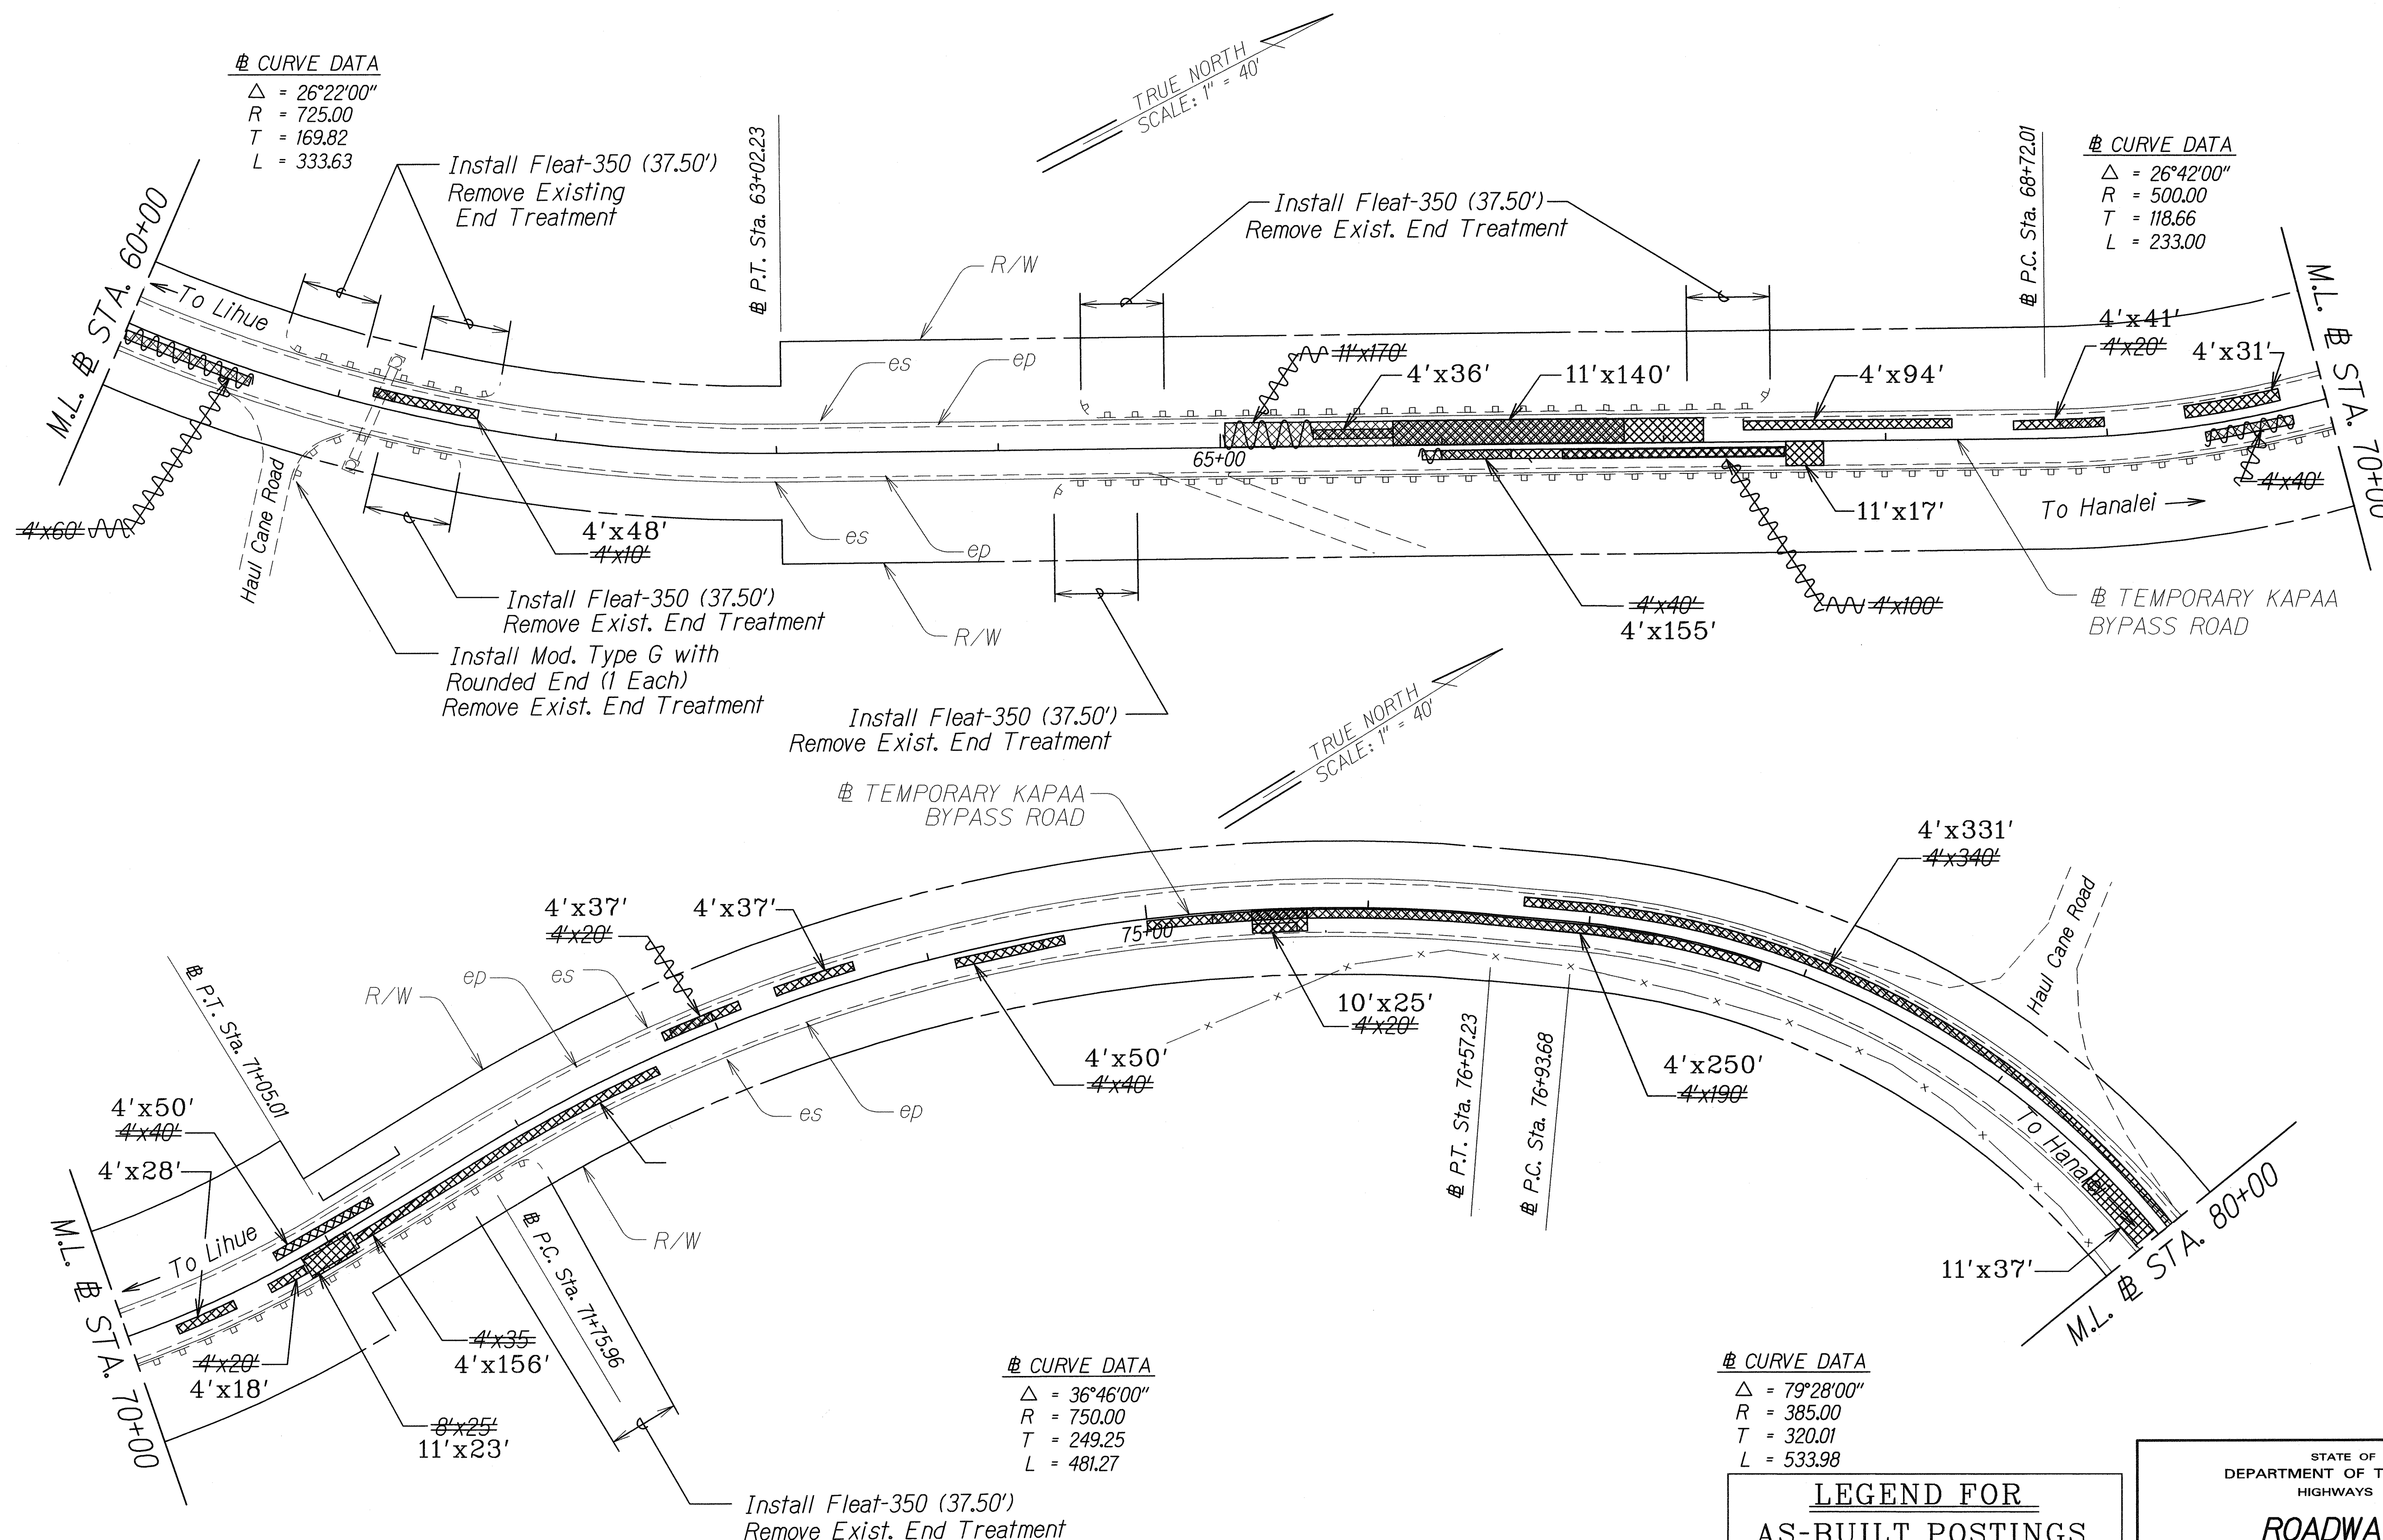

ORIGINAL PLAN	SURVEY PLOTTED BY	DATE
NOTE BOOK	DRAWN BY	12/09
DESIGNED BY	CHECKED BY	
PHOTOGRAPH		

"AS-BUILT"

FED. ROAD DIST. NO.	STATE	PROJ. NO.	FISCAL YEAR	SHEET NO.	TOTAL SHEETS
HAWAII	HAW.	5600-02-10M	2010	13	29

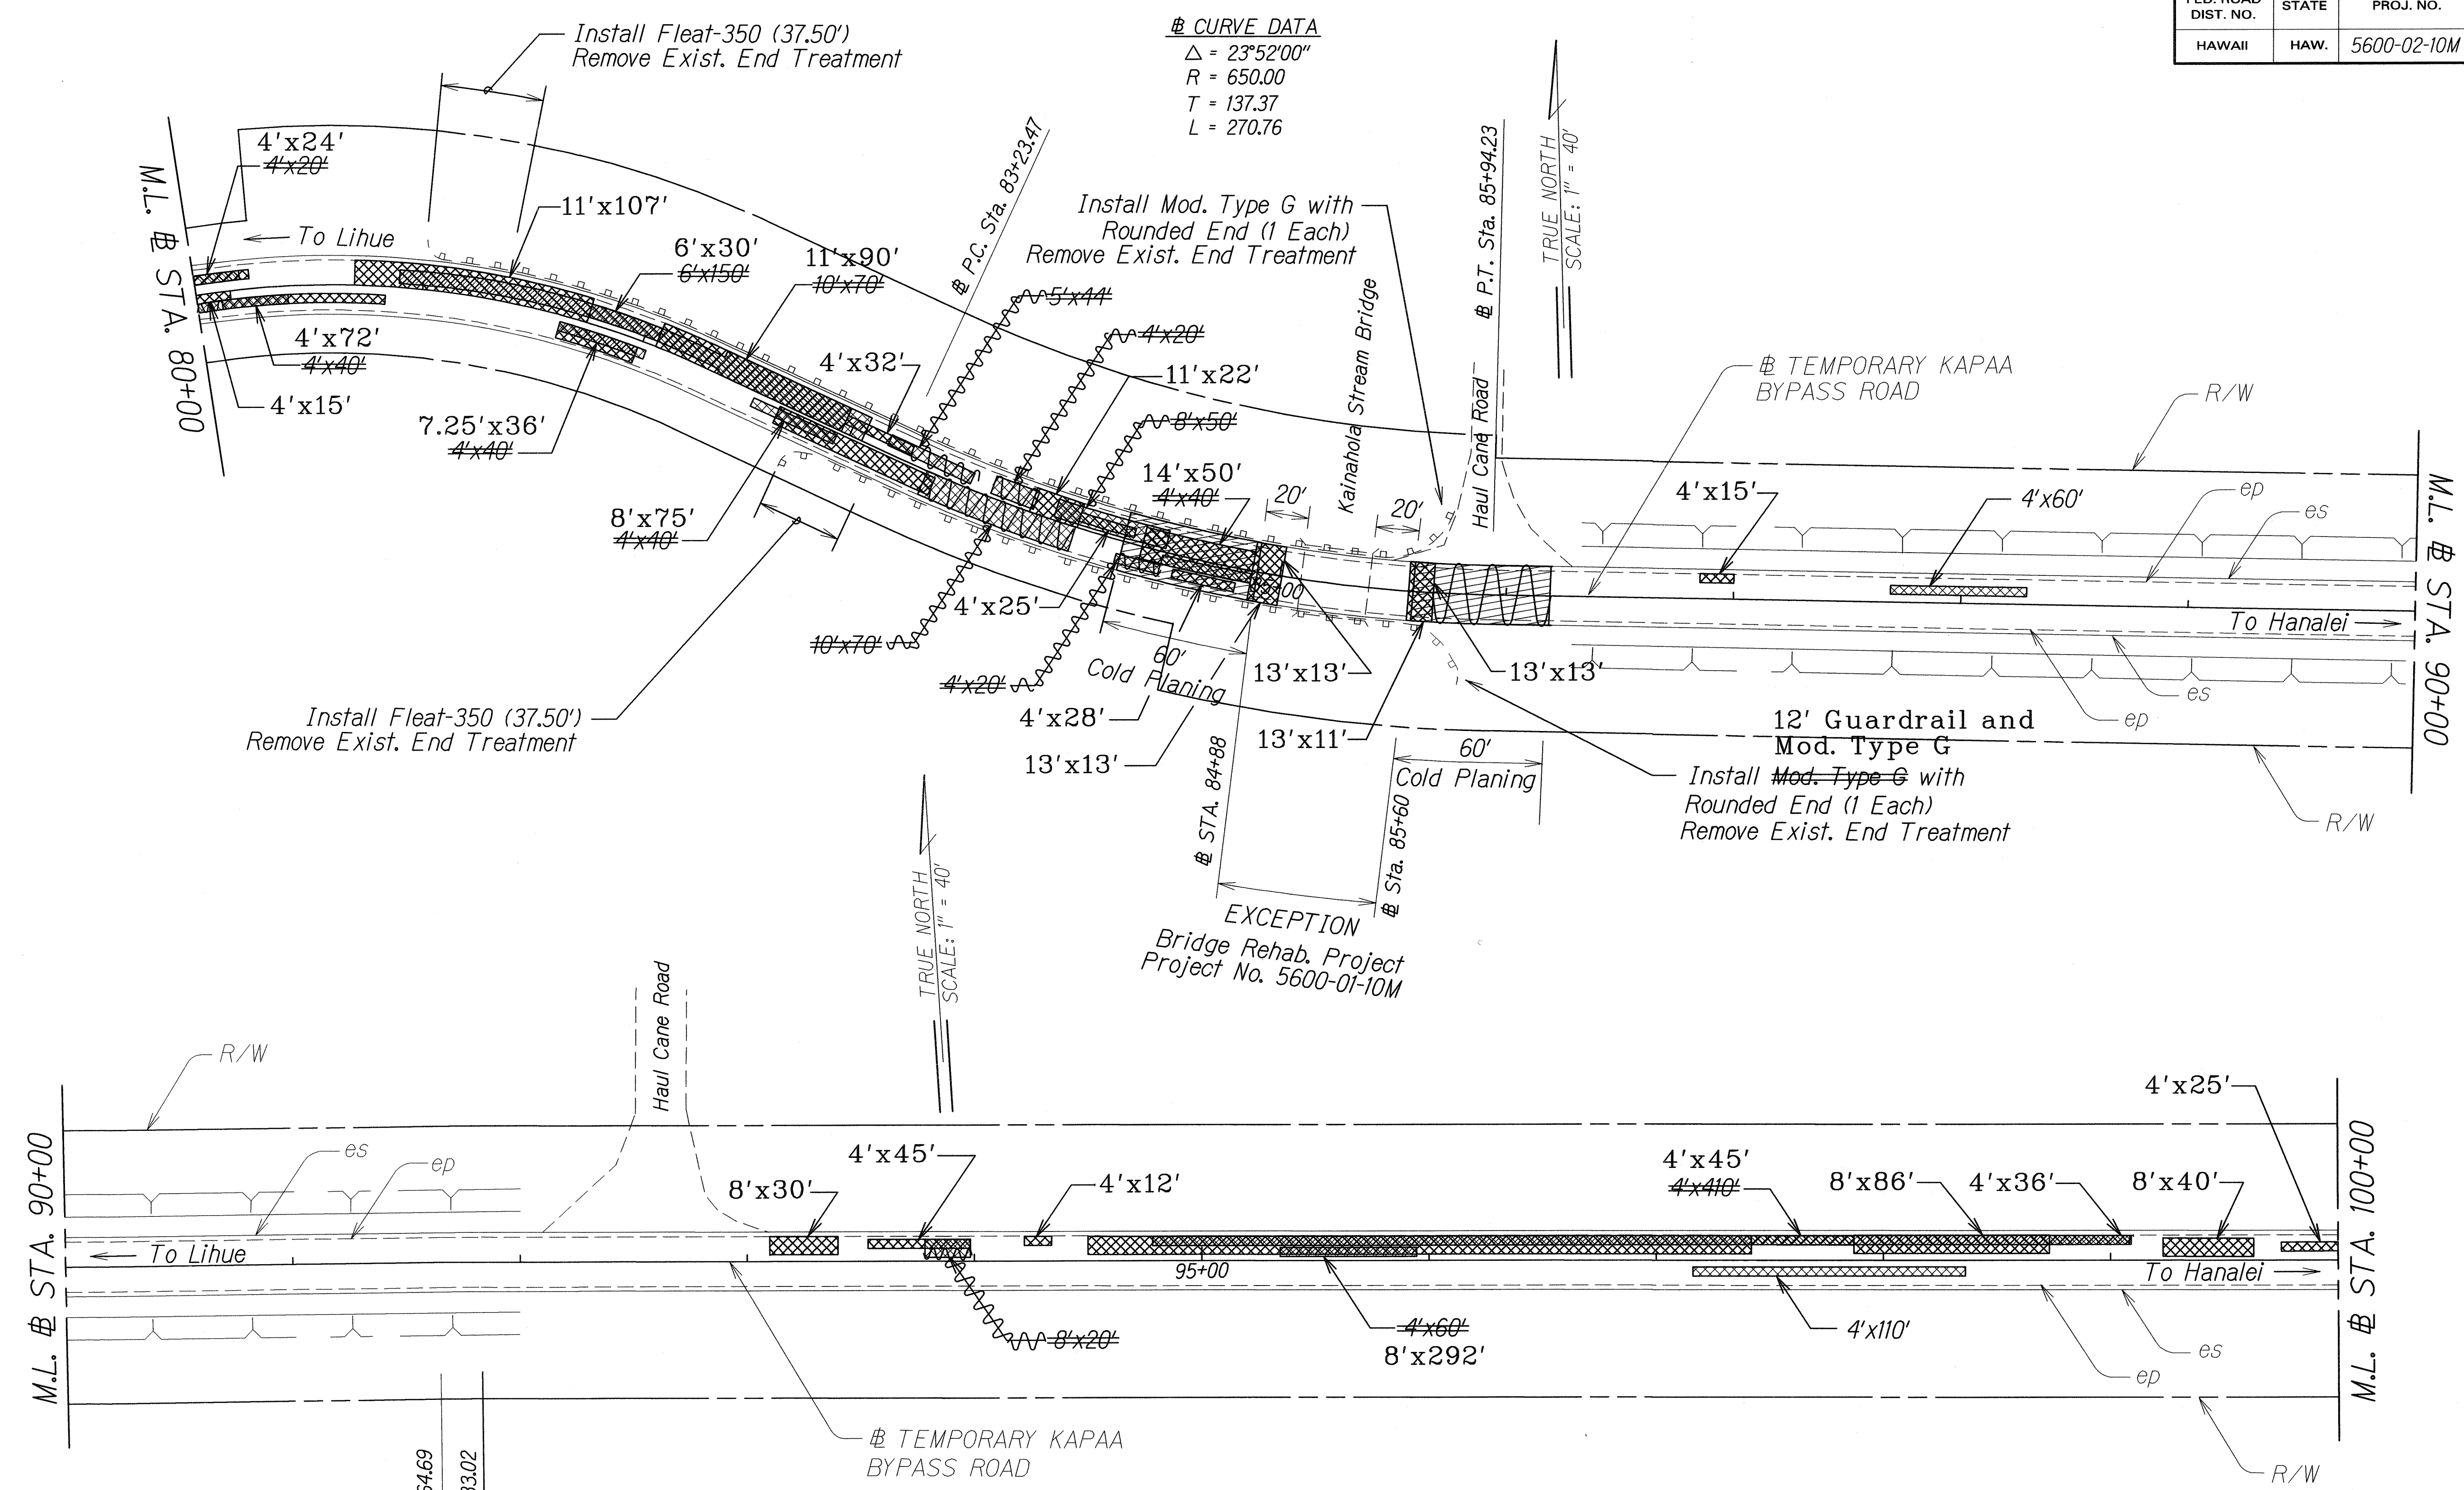

CURVE DATA
 $\Delta = 23^\circ 52' 00''$
 $R = 650.00$
 $T = 137.37$
 $L = 270.76$

CURVE DATA
 $\Delta = 0^\circ 42' 00''$
 $R = 1500.00$
 $T = 9.16$
 $L = 18.33$

LEGEND FOR AS-BUILT POSTINGS	
	Squiggly line for as-built deletion
	Double line for as-built deletion
Roadway	Text for as-built posting

STATE OF HAWAII
DEPARTMENT OF TRANSPORTATION
HIGHWAYS DIVISION

ROADWAY PLAN

TEMPORARY KAPAA BYPASS ROAD RESURFACING
Mile Post 0.07 to Mile Post 2.26
Project No. 5600-02-10M


Scale: 1" = 40' Date: Dec. 2009

SHEET No. 5 OF 6 SHEETS

ORIGINAL PLAN	SURVEY PLOTTED BY	DATE
TRACED BY		12/10
NOTE BOOK		
QUANTITIES BY		
CHECKED BY		

"AS-BUILT"

FED. ROAD DIST. NO.	STATE	PROJ. NO.	FISCAL YEAR	SHEET NO.	TOTAL SHEETS
HAWAII	HAW.	5600-02-10M	2010	14	29

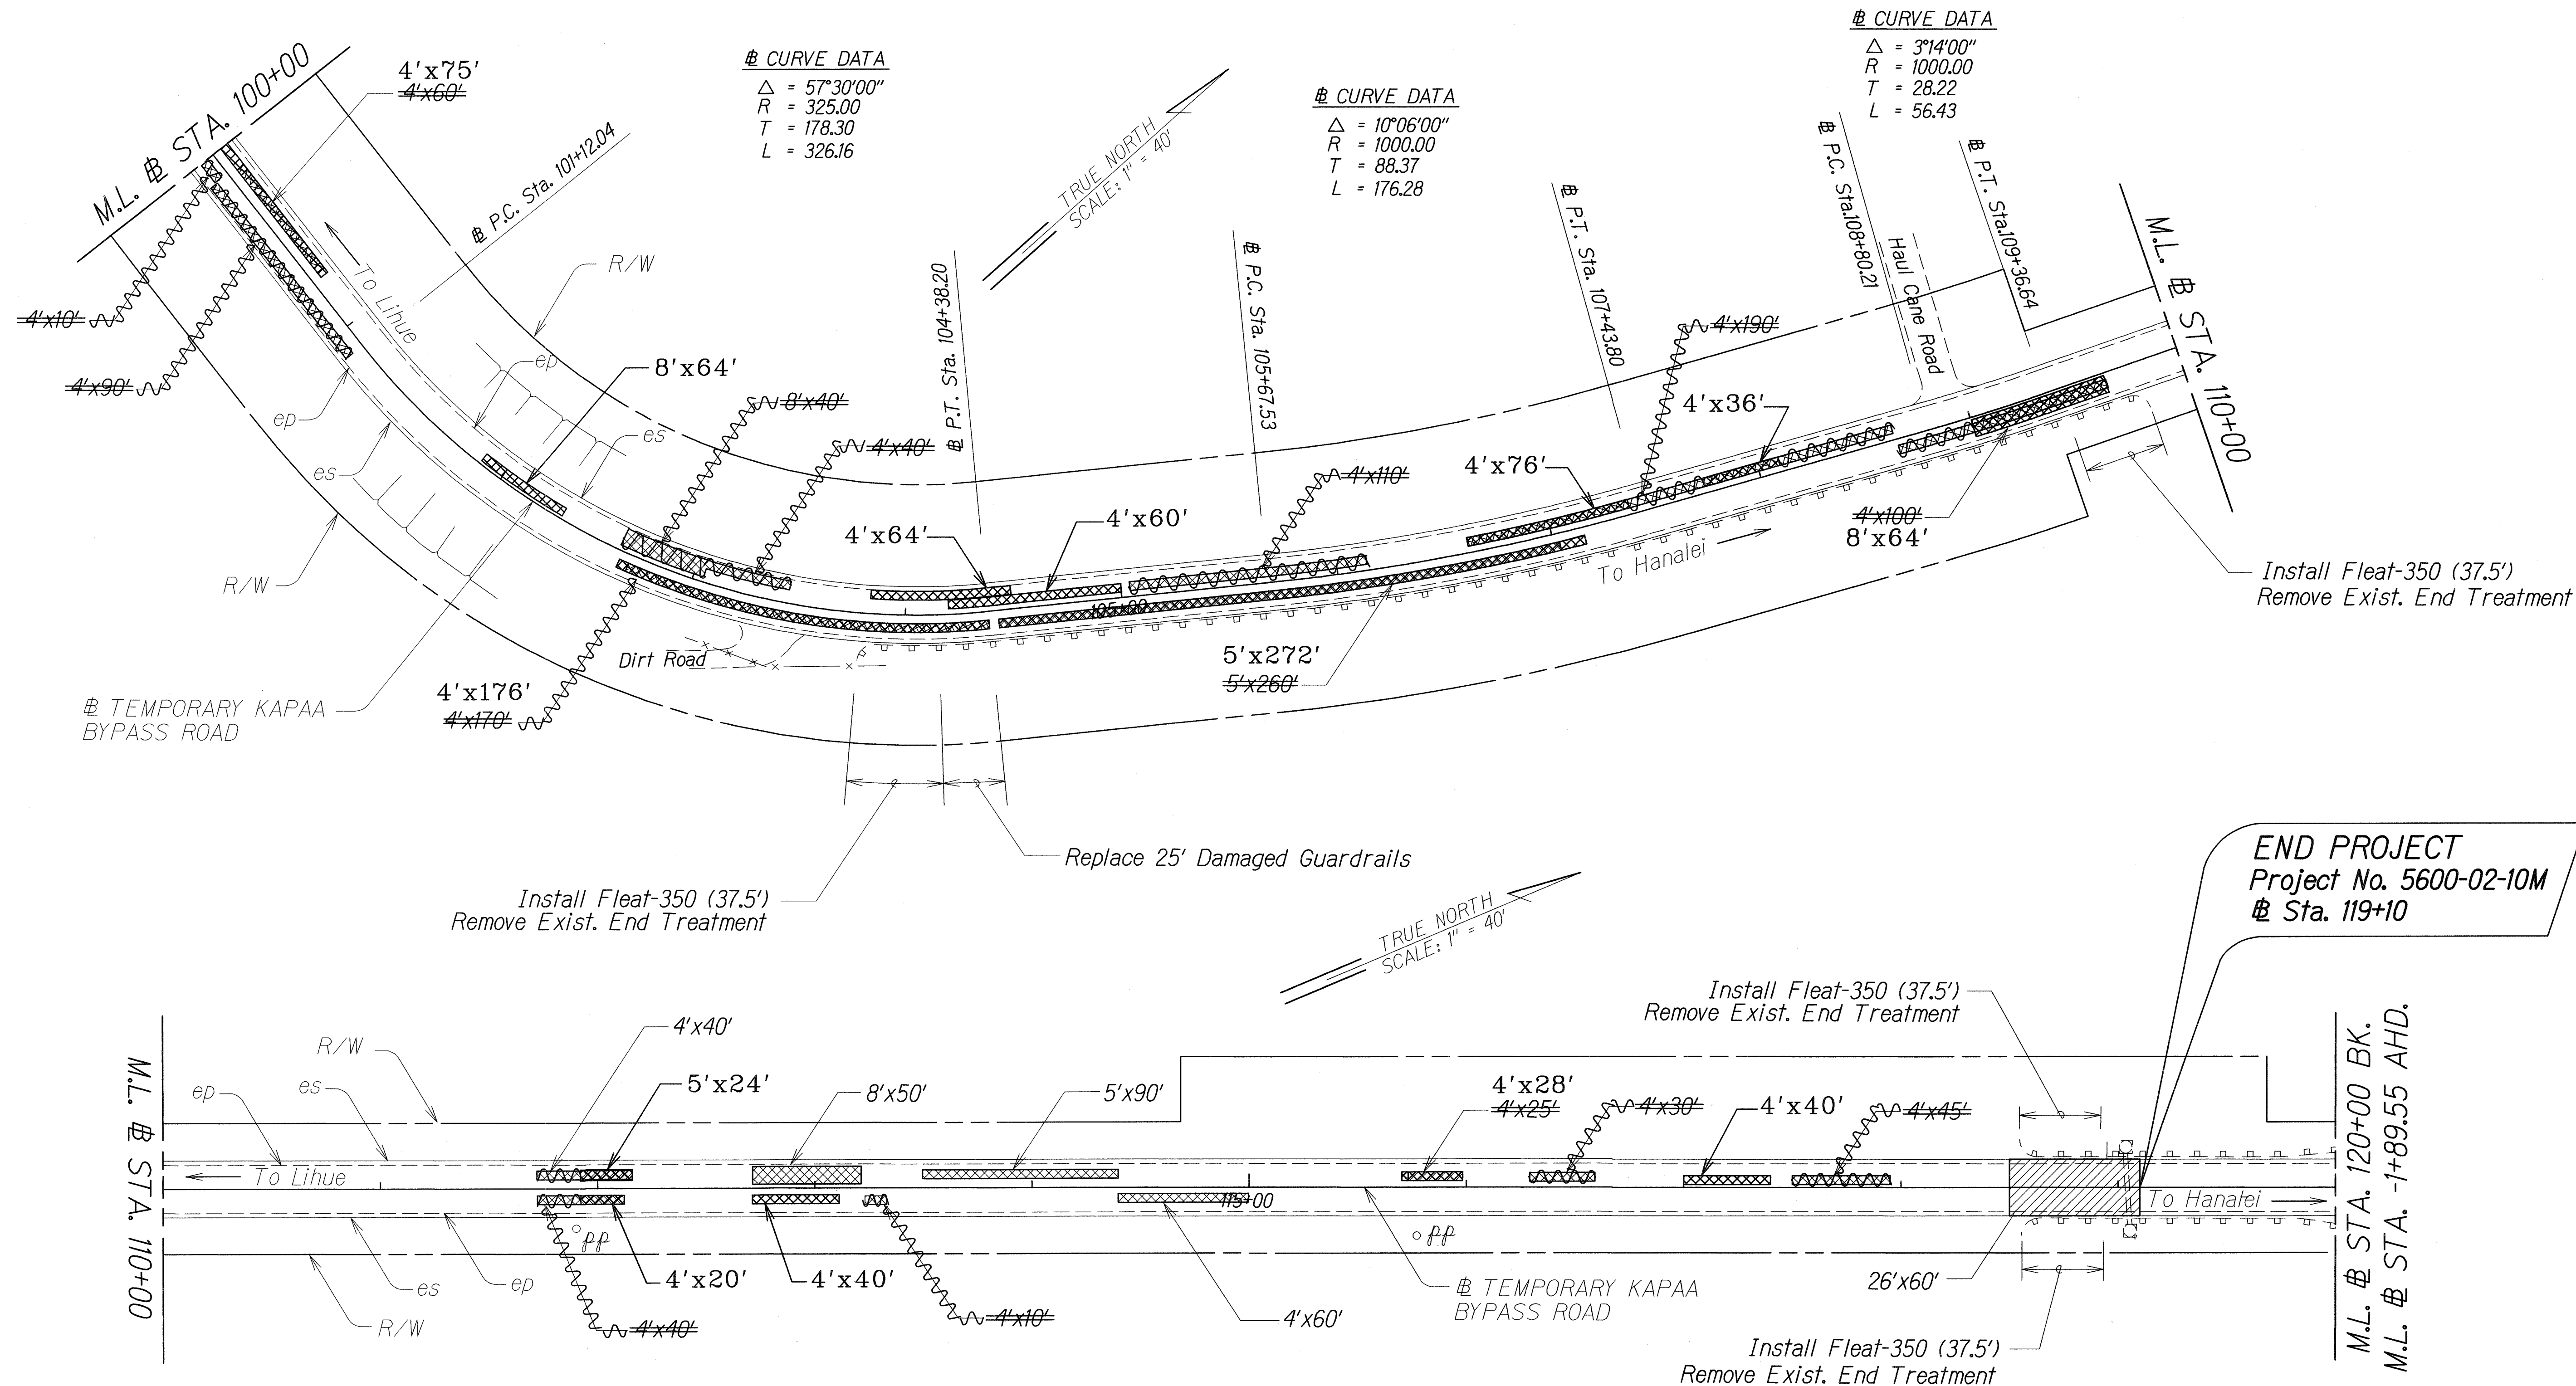


ORIGINAL PLAN	SURVEY PLOTTED BY	DATE
NOTE BOOK	DRAWN BY	12/03
REFERENCE	DESIGNED BY	
PHOTOGRAPH	CHECKED BY	

LEGEND FOR AS-BUILT POSTINGS	
	Squiggly line for as-built deletion
	Double line for as-built deletion
Roadway	Text for as-built posting

STATE OF HAWAII DEPARTMENT OF TRANSPORTATION HIGHWAYS DIVISION	
ROADWAY PLAN	
TEMPORARY KAPAA BYPASS ROAD RESURFACING	
Mile Post 0.07 to Mile Post 2.26	
Project No. 5600-02-10M	
Scale: 1" = 40'	Date: Dec. 2009
SHEET No. 6 OF 6 SHEETS	

FED. ROAD DIST. NO.	STATE	PROJ. NO.	FISCAL YEAR	SHEET NO.	TOTAL SHEETS
HAWAII	HAW.	5600-02-10M	2010	ADD.14S1	29

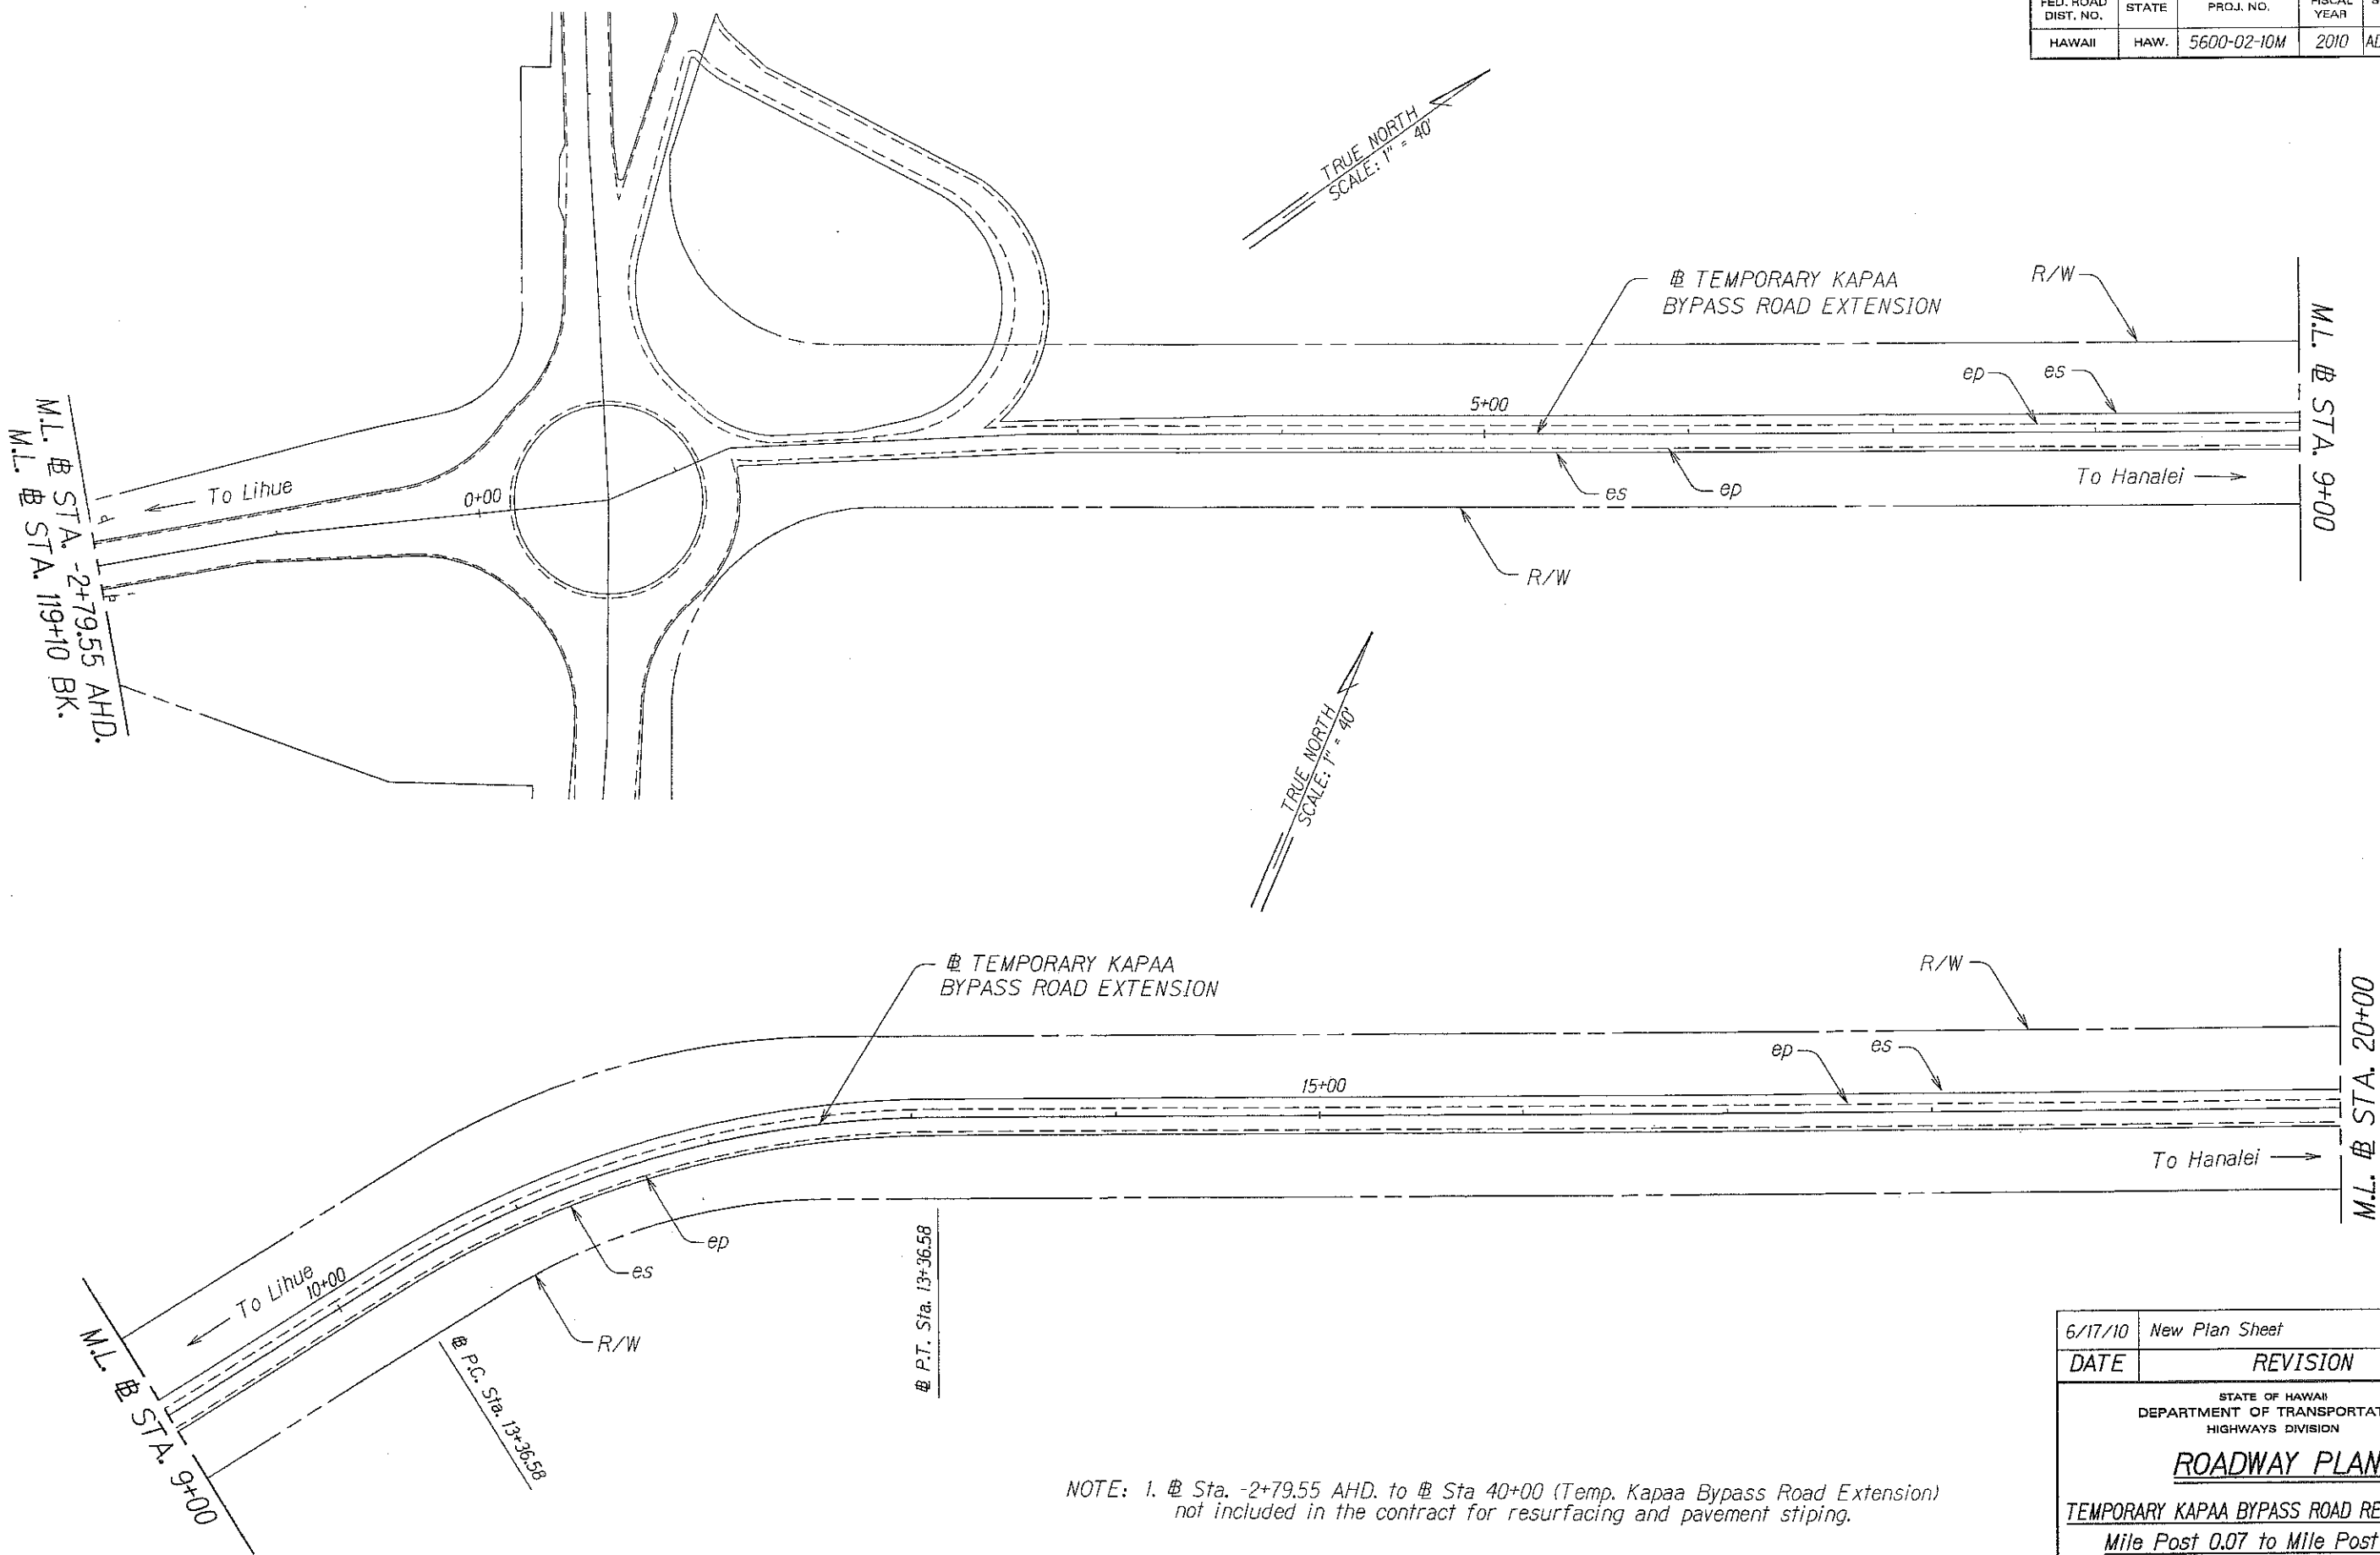


DESIGNED BY	DATE
DRAWN BY	6/10
CHECKED BY	
IN CHARGE	
NOTED BY	
QUANTITIES BY	
CHECKED BY	
IN CHARGE	

NOTE: 1. Sta. -2+79.55 AHD. to Sta 40+00 (Temp. Kapaa Bypass Road Extension) not included in the contract for resurfacing and pavement stiping.


6/17/10	New Plan Sheet
DATE	REVISION
STATE OF HAWAII DEPARTMENT OF TRANSPORTATION HIGHWAYS DIVISION	
ROADWAY PLAN	
TEMPORARY KAPAA BYPASS ROAD RESURFACING	
Mile Post 0.07 to Mile Post 2.26	
Project No. 5600-02-10M	
Scale: 1" = 40'	Date: June 2010
SHEET No. 1 OF 2 SHEETS	

ADD.14S1

FED. ROAD DIST. NO.	STATE	PROJ. NO.	FISCAL YEAR	SHEET NO.	TOTAL SHEETS
HAWAII	HAW.	5600-02-10M	2010	ADD.14S2	29

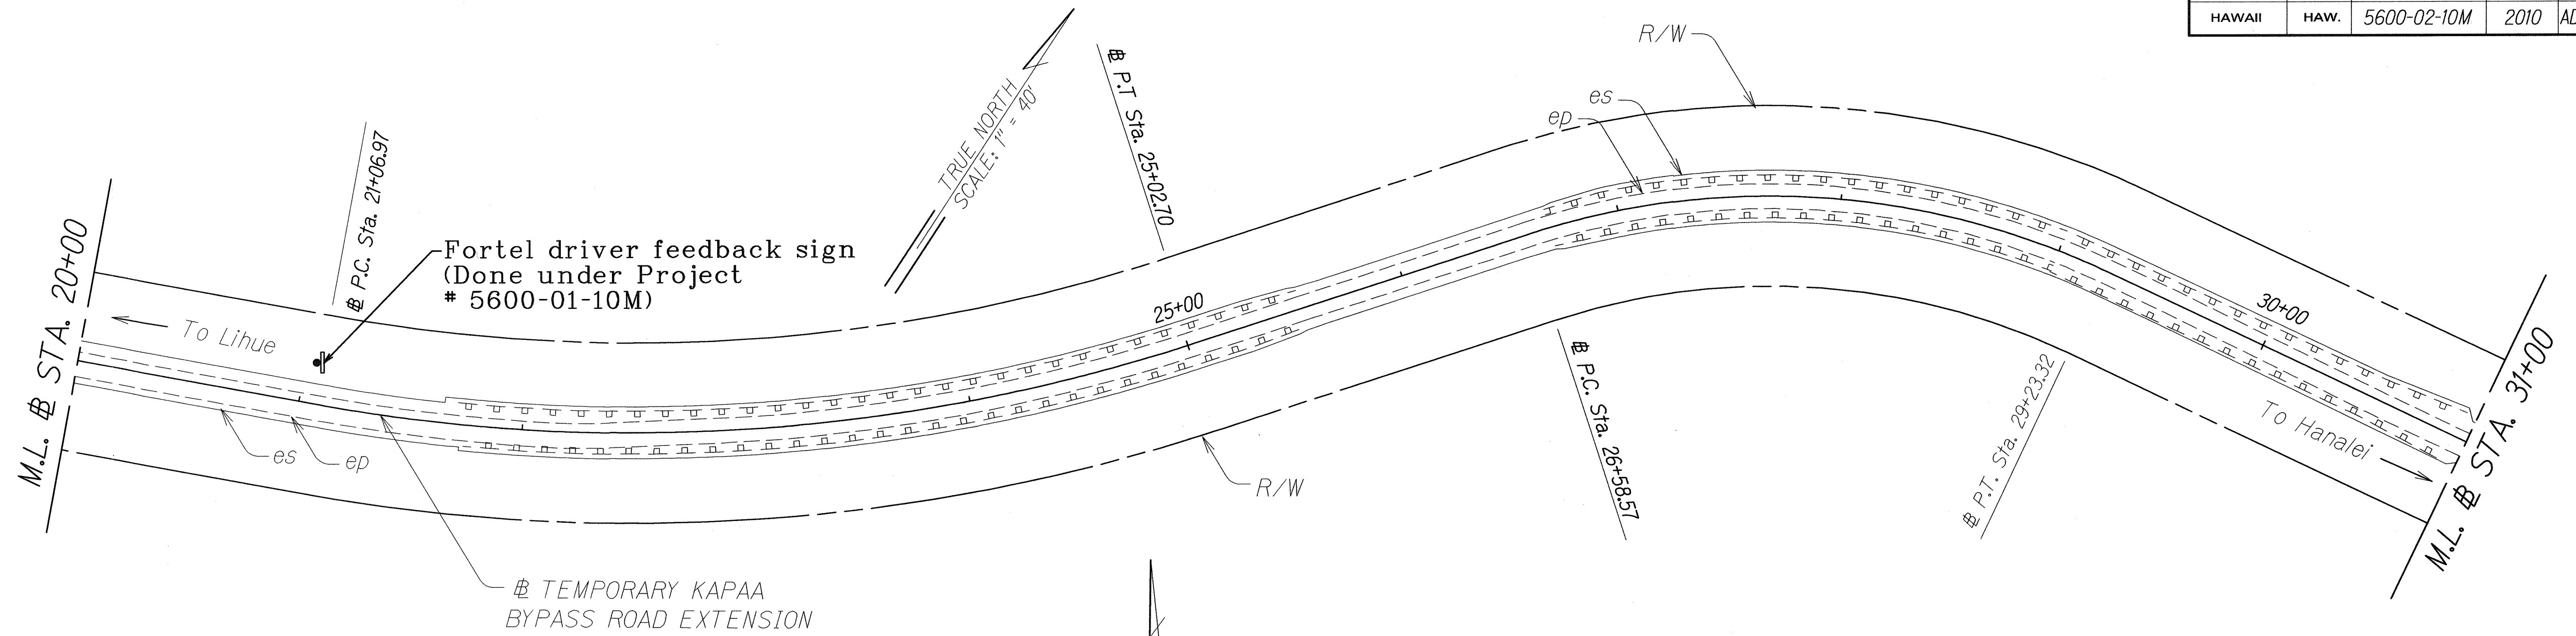

LEGEND FOR AS-BUILT POSTINGS	
	Squiggly line for as-built deletion
	Double line for as-built deletion
Roadway	Text for as-built posting

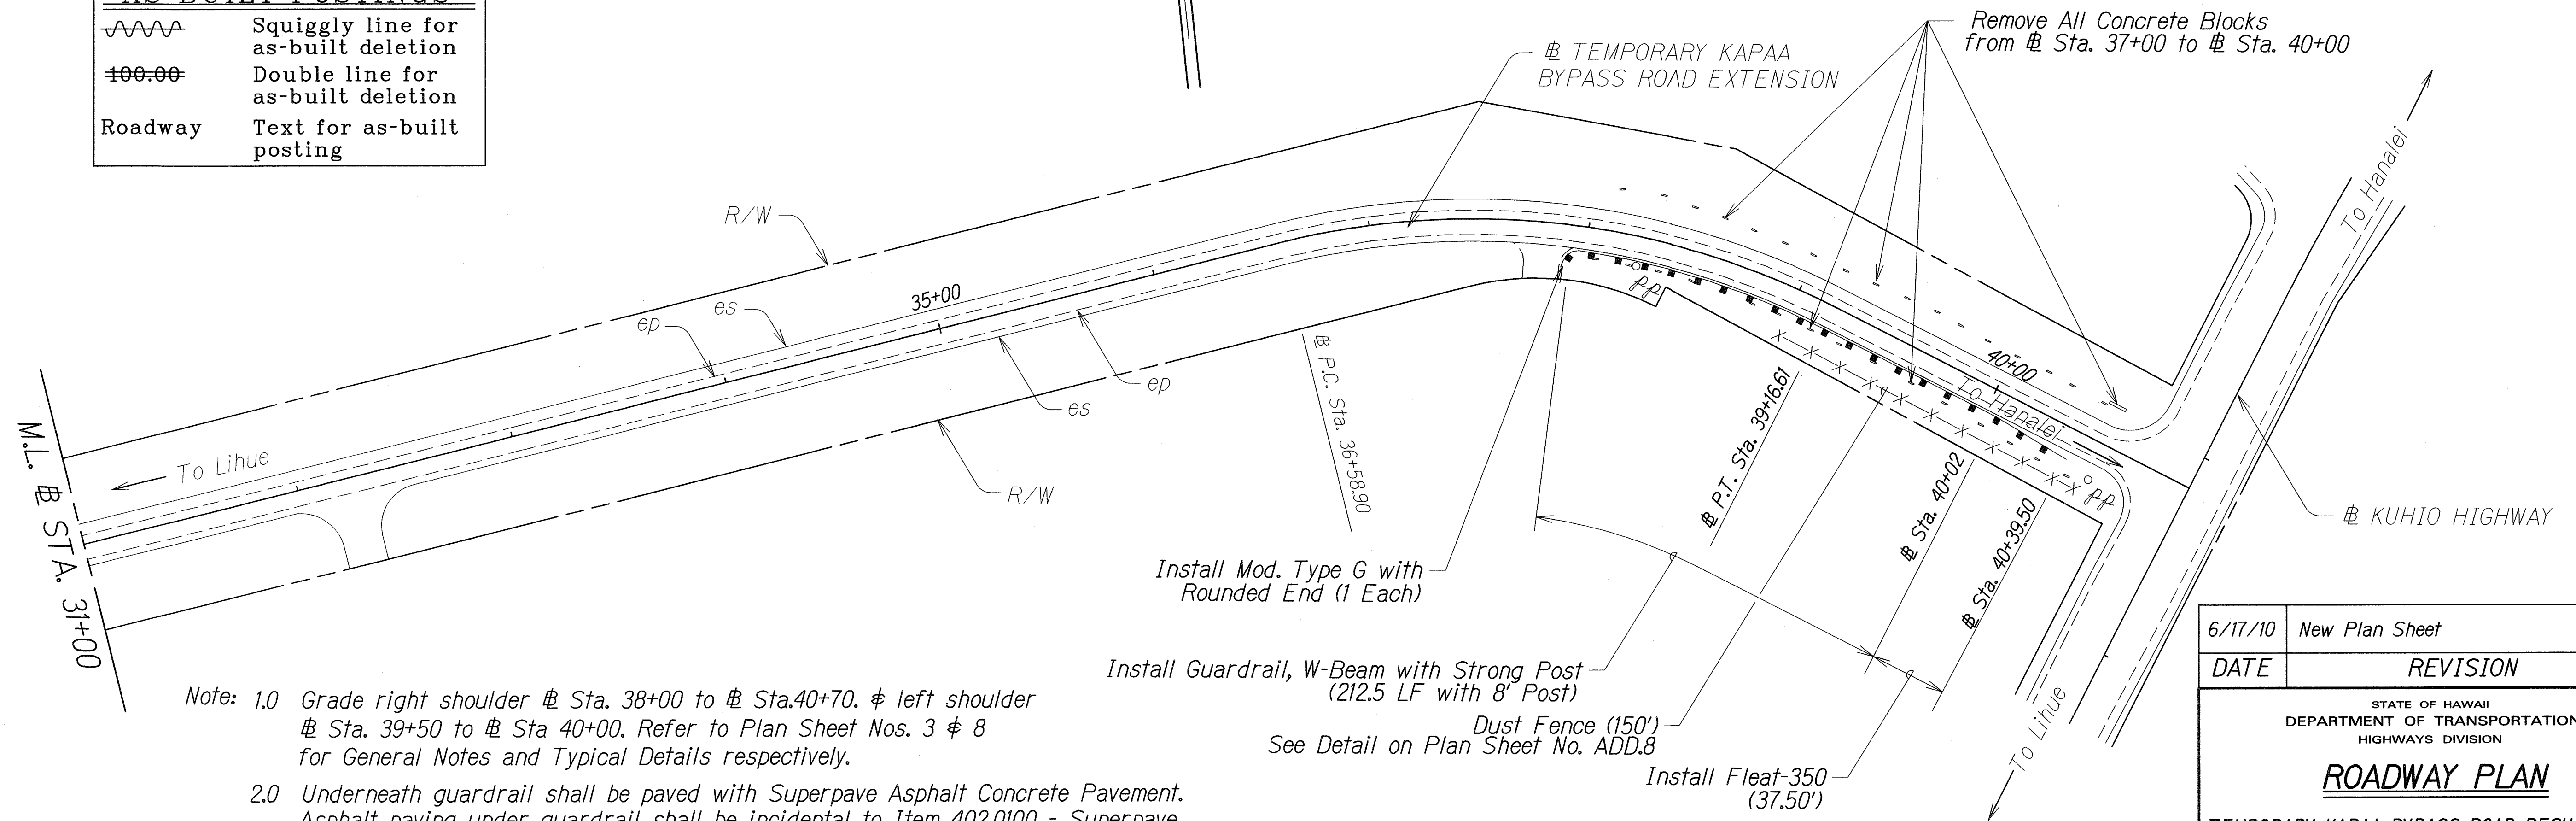

- Note: 1.0 Grade right shoulder @ Sta. 38+00 to @ Sta.40+70. # left shoulder @ Sta. 39+50 to @ Sta 40+00. Refer to Plan Sheet Nos. 3 & 8 for General Notes and Typical Details respectively.
- 2.0 Underneath guardrail shall be paved with Superpave Asphalt Concrete Pavement. Asphalt paving under guardrail shall be incidental to Item 402.0100 - Superpave Asphalt Concrete Pavement and will not be paid separately. (Refer to Plan Sheet No. 7 for Typical Section)
- 3.0 @ Sta. -2+79.55 AHD. to @ Sta 40+00 (Temp. Kapaa Bypass Road Extension) not included in the contract for resurfacing and pavement stiping.

ORIGINAL PLAN	DATE
DRAWN BY	6/09
TRACED BY	
DESIGNED BY	
CHECKED BY	
NOTED BY	
ADD.14S2	

6/17/10	New Plan Sheet
DATE	REVISION
STATE OF HAWAII DEPARTMENT OF TRANSPORTATION HIGHWAYS DIVISION	
ROADWAY PLAN	
TEMPORARY KAPAA BYPASS ROAD RESURFACING	
Mile Post 0.07 to Mile Post 2.26	
Project No. 5600-02-10M	
Scale: 1" = 40'	Date: June 2010
SHEET No. 1 OF 3 SHEETS	

ADD.14S2