




FED. ROAD DIST. NO.	STATE	PROJ. NO.	FISCAL YEAR	SHEET NO.	TOTAL SHEETS
HAWAII	HAW.	5600-02-10M	2010	ADD.6	29

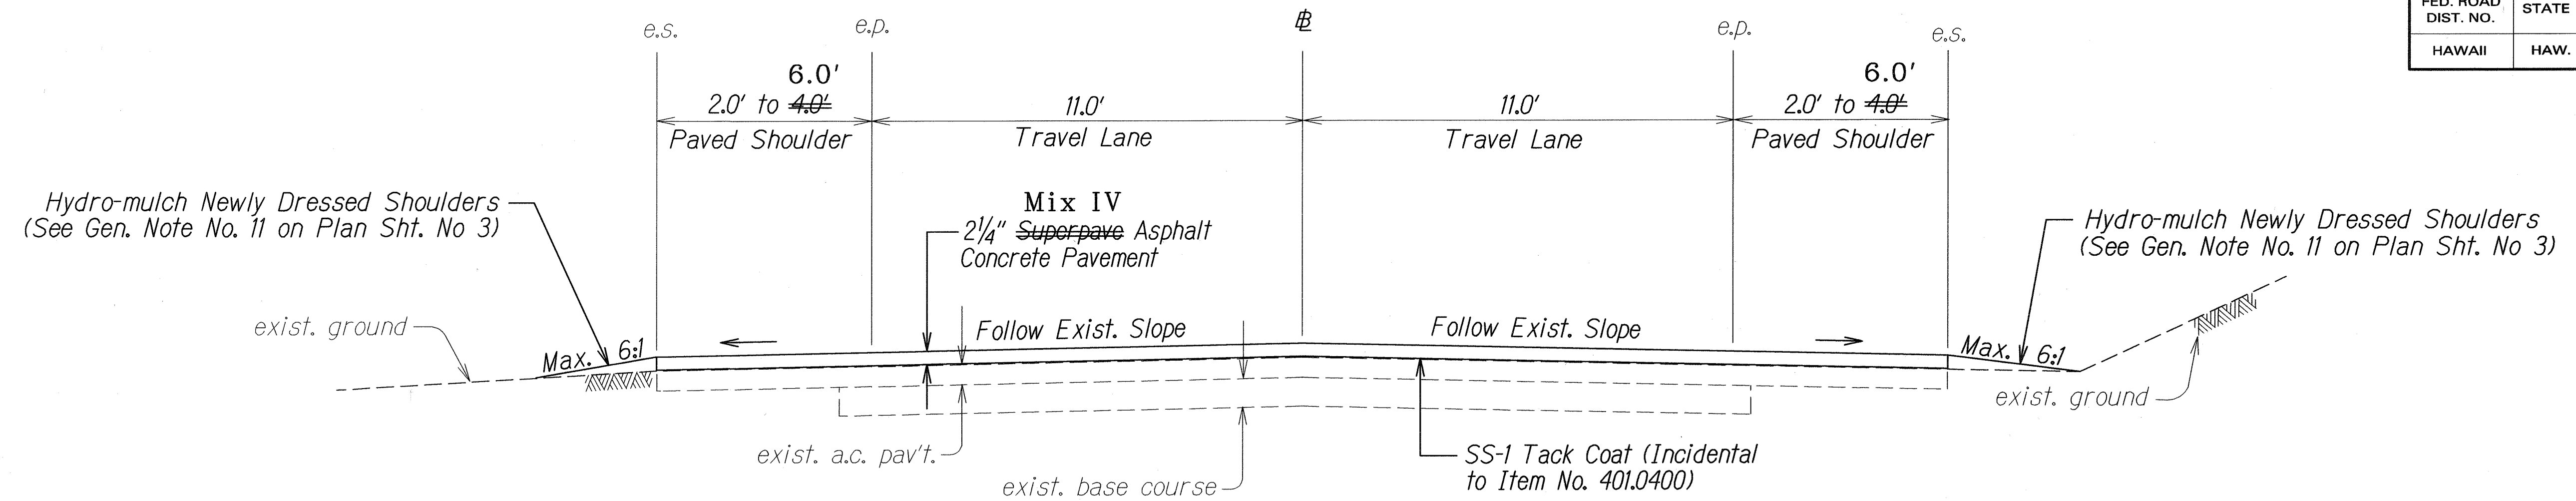

TYPICAL TANGENT SECTION

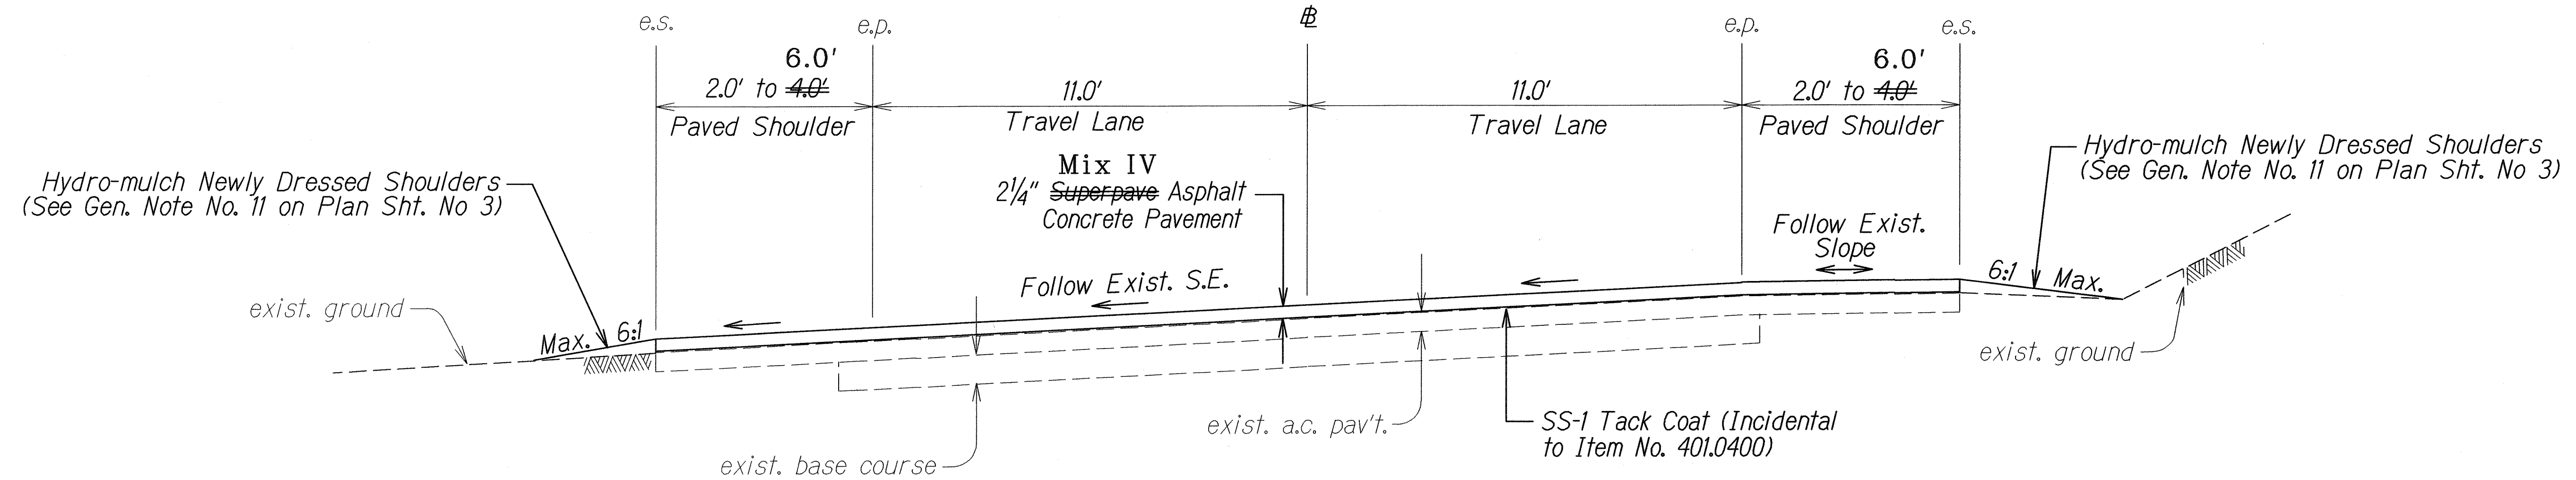

TYPICAL SUPERELEVATED SECTION

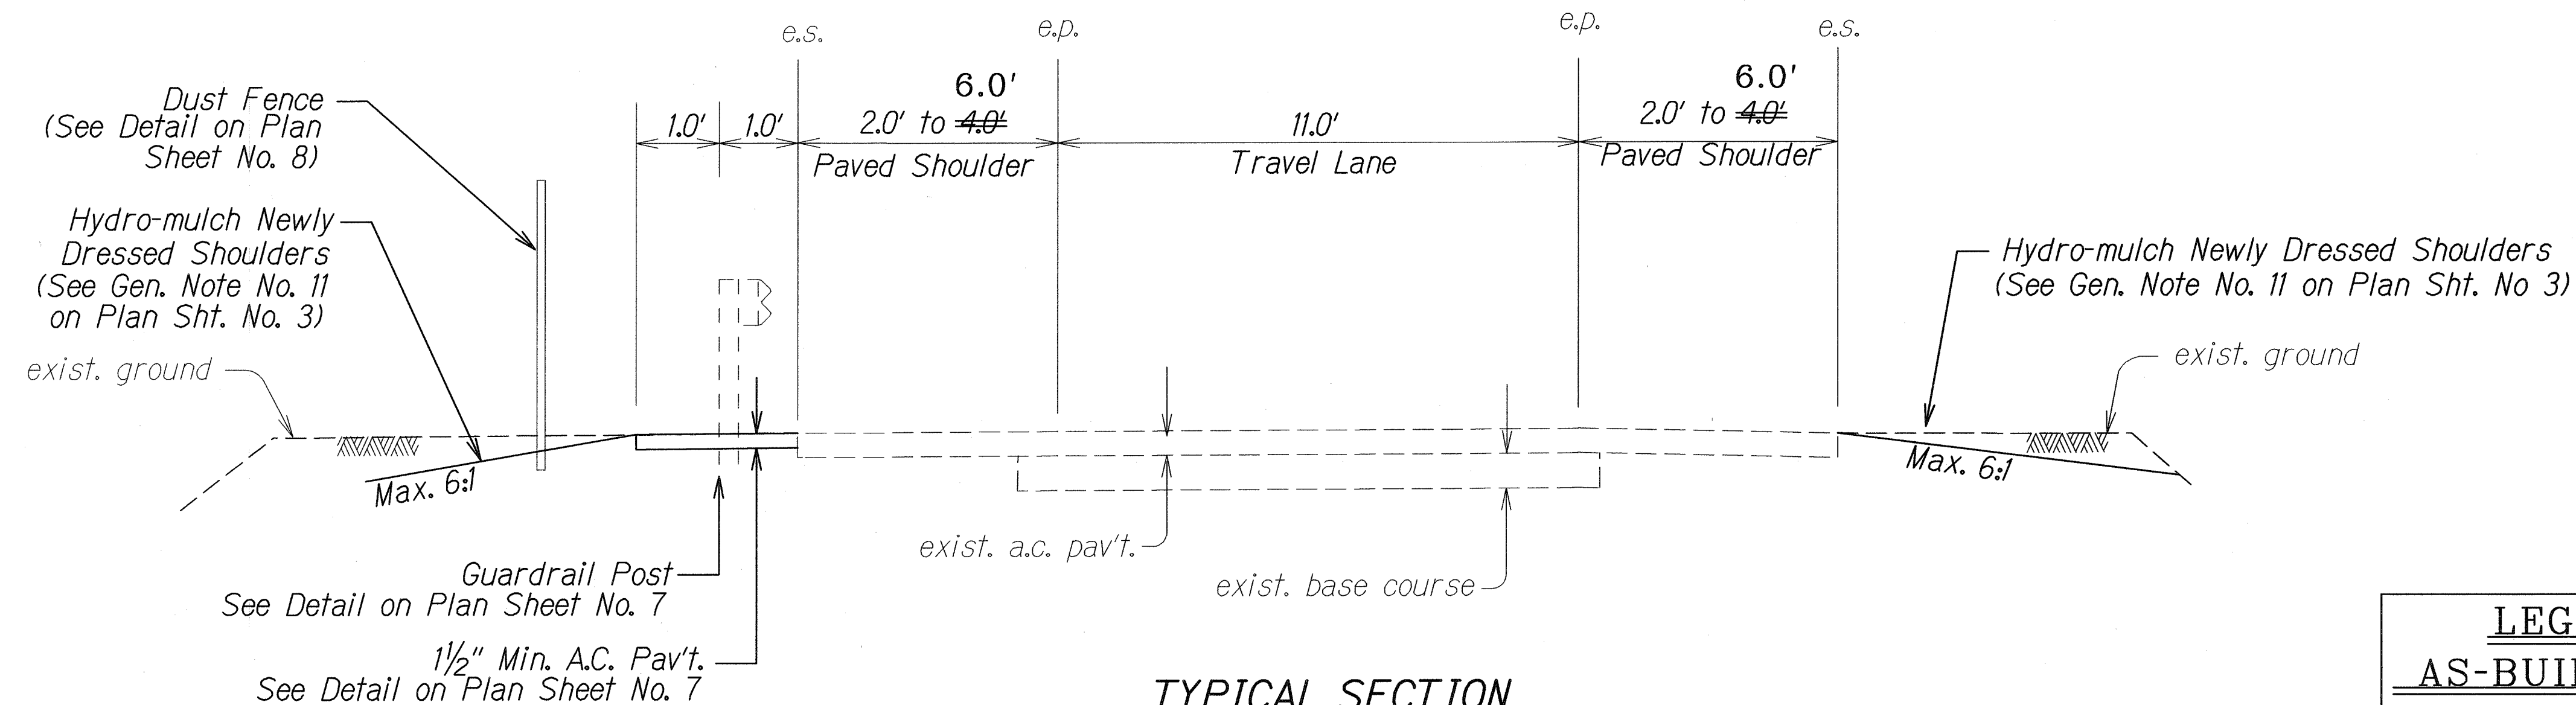

TYPICAL SECTION

GRADING OF LEFT SHOULDER @ # 39+50 to # 40+70
GRADING OF RIGHT SHOULDER @ # 38+00 to # 40+70
TEMPORARY KAPAA BYPASS ROAD EXTENSION

LEGEND FOR AS-BUILT POSTINGS	
	Squiggly line for as-built deletion
	Double line for as-built deletion
Roadway	Text for as-built posting


6/17/10	Replace Plan Sheet No. 6 with Plan Sheet No. ADD.6
DATE	REVISION
STATE OF HAWAII DEPARTMENT OF TRANSPORTATION HIGHWAYS DIVISION	
TYPICAL SECTIONS	
TEMPORARY KAPAA BYPASS ROAD RESURFACING	
Mile Post 0.07 to Mile Post 2.26	
Project No. 5600-02-10M	
Not to Scale	Date: June 2010
SHEET No. 1 OF 3 SHEETS	

"AS-BUILT"

ADD.6


ORIGINAL PLAN	DATE
DRAWN BY	12/09
TRACED BY	
CHECKED BY	
NOTED BY	
QUANTITIES BY	
CHECKED BY	
DATE	

FED. ROAD DIST. NO.	STATE	PROJ. NO.	FISCAL YEAR	SHEET NO.	TOTAL SHEETS
HAWAII	HAW.	5600-02-10M	2010	7	29

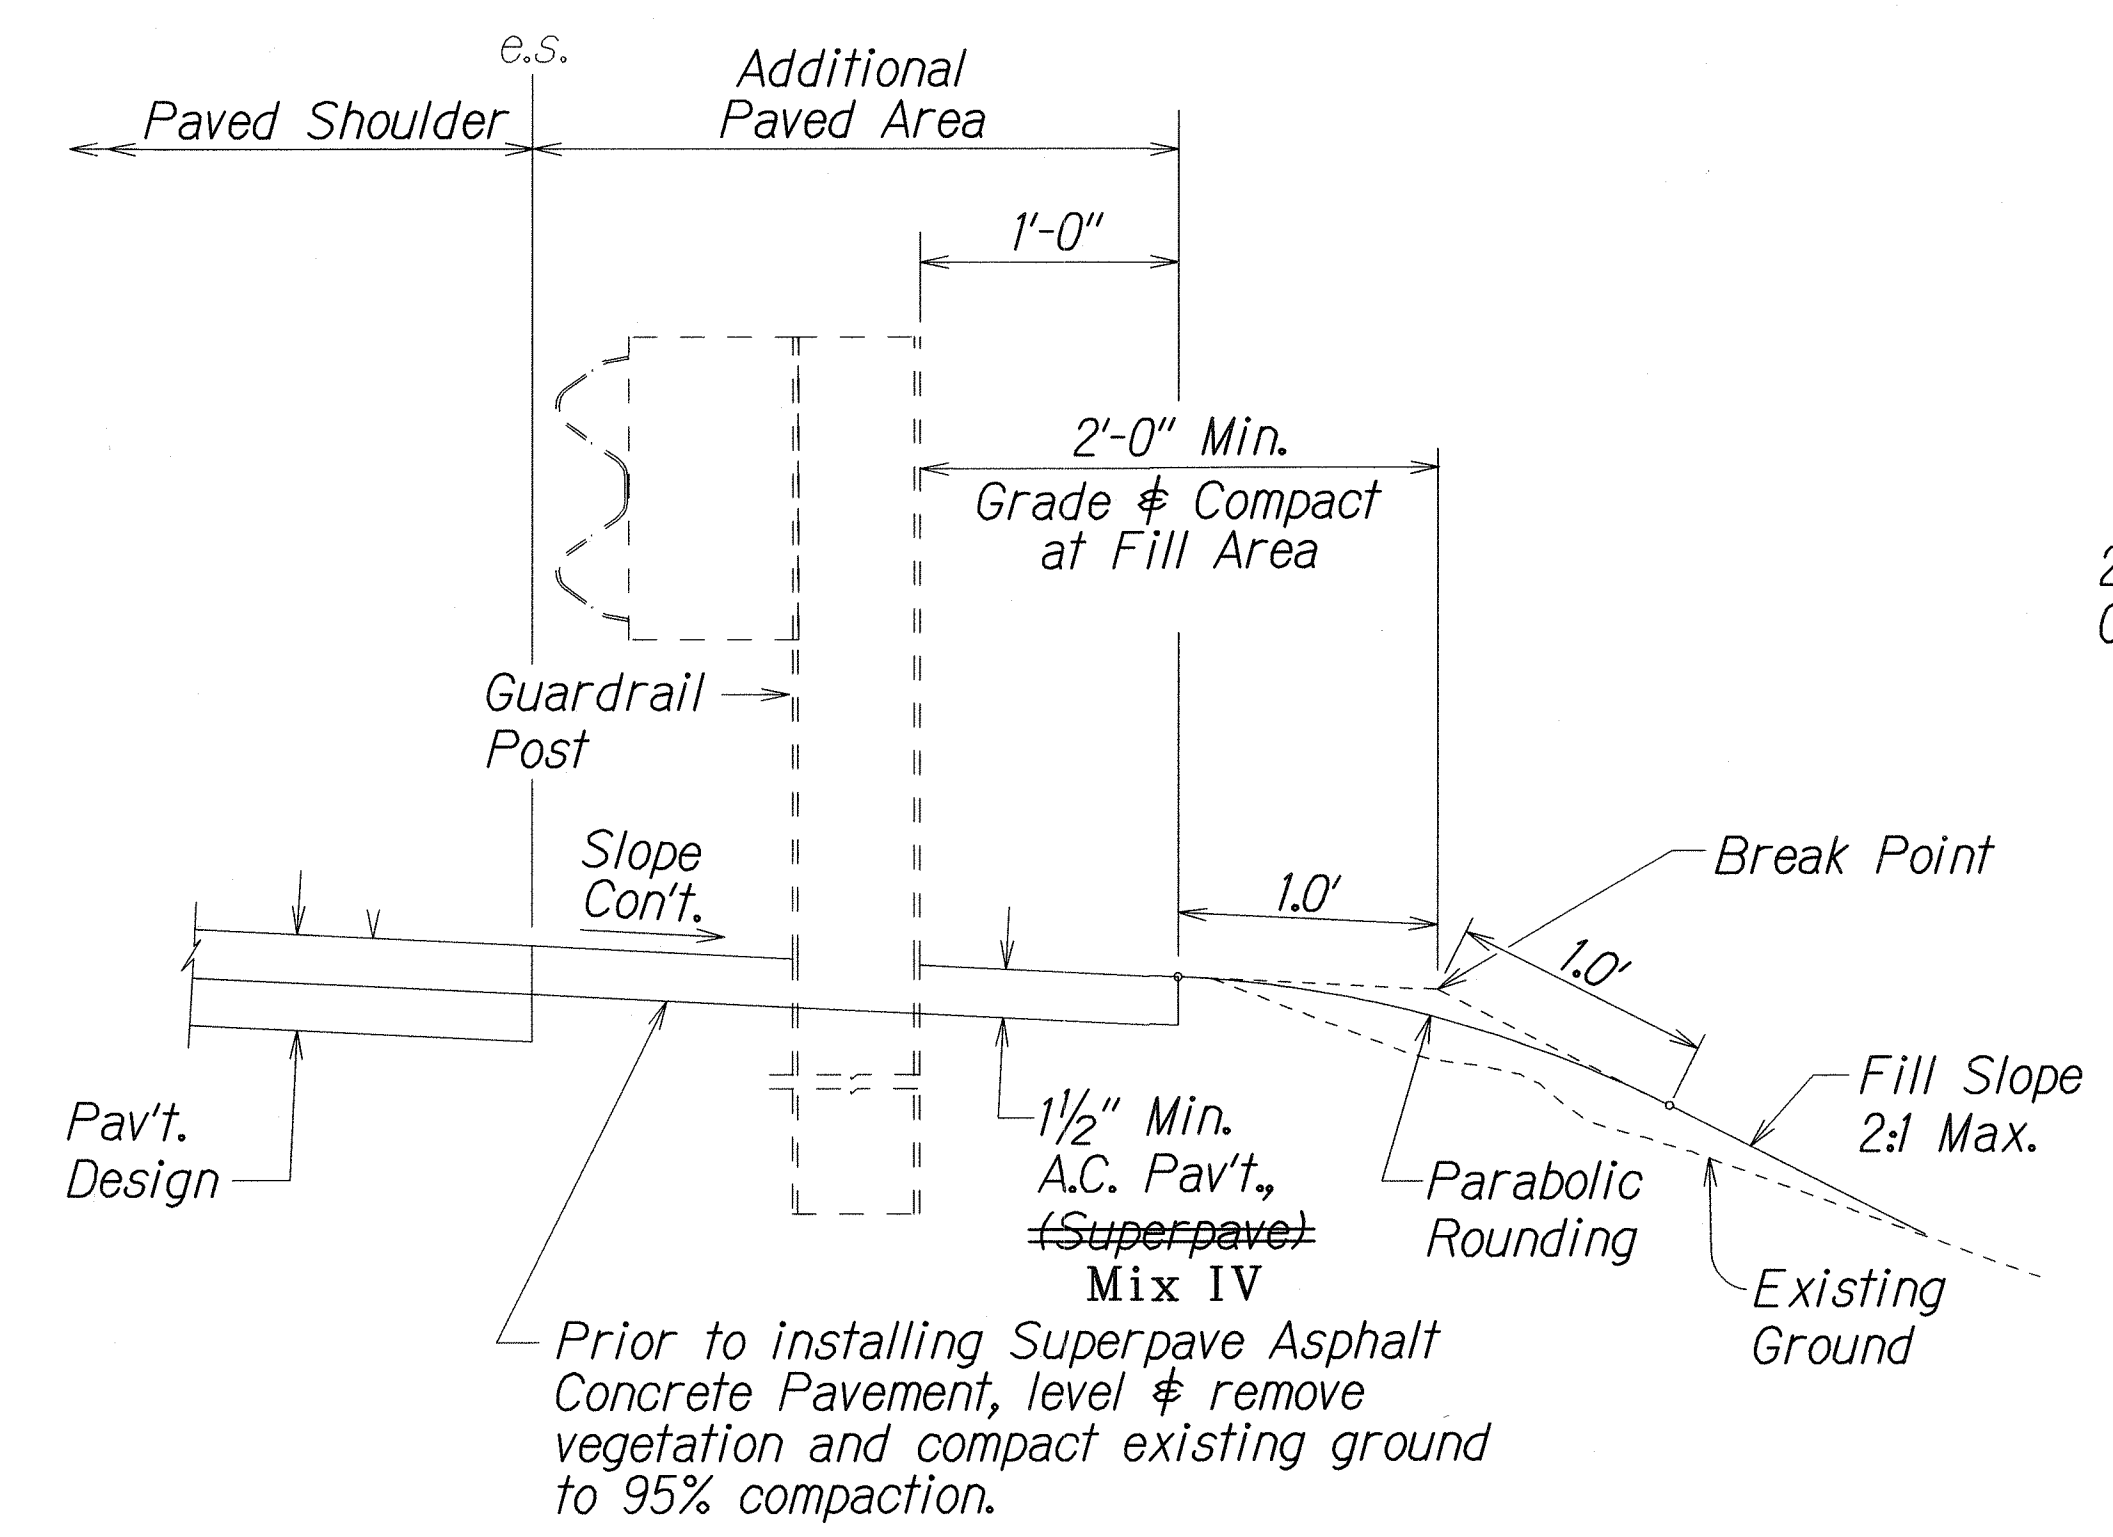


Note: 1.0 When standards for the fill slope area cannot be met, a site specific, engineer approved design may be used.

ELEVATION
TYPICAL ASPHALT PAVEMENT UNDER GUARDRAIL

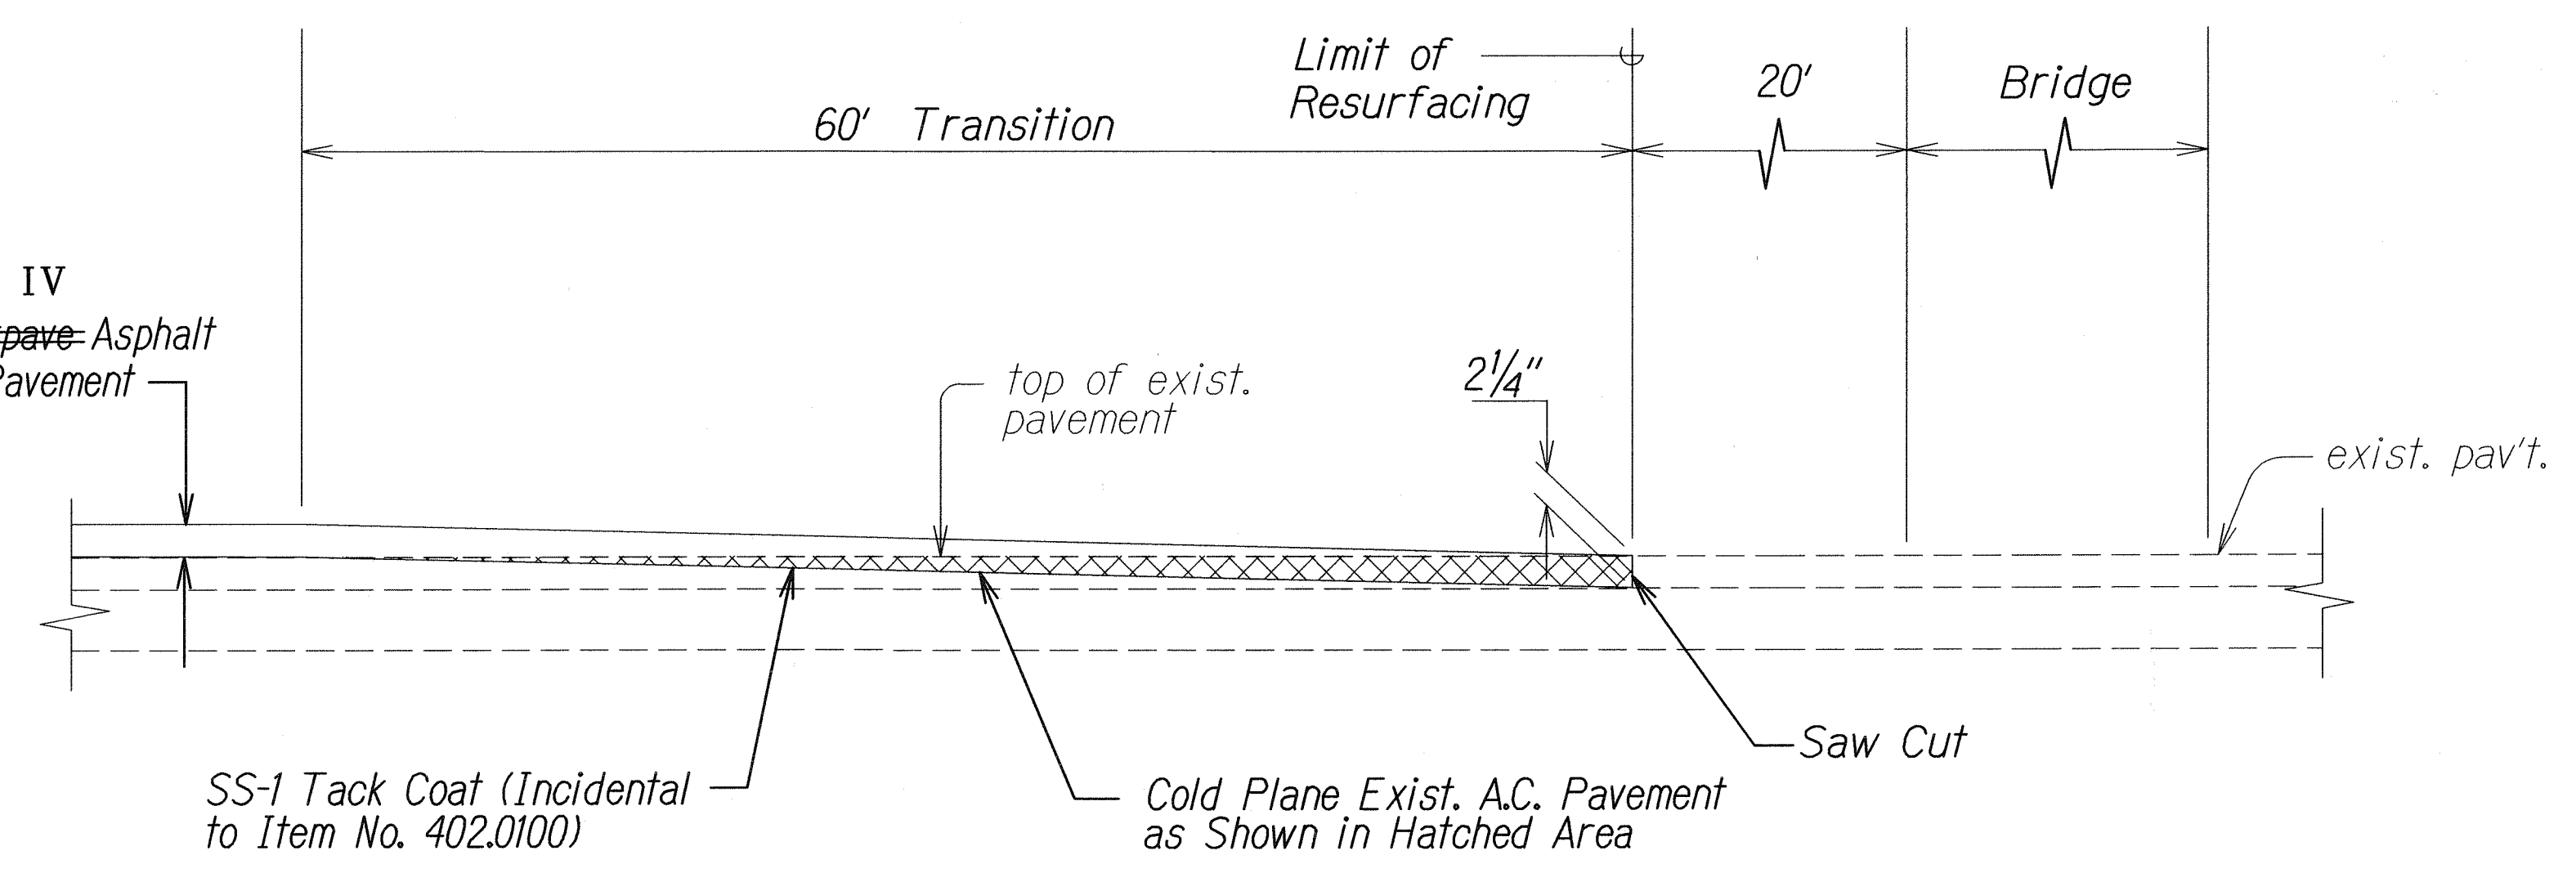


COLD PLANED TRANSITION TO EXISTING A.C. PAVEMENT
AT BRIDGE APPROACH
Not to Scale

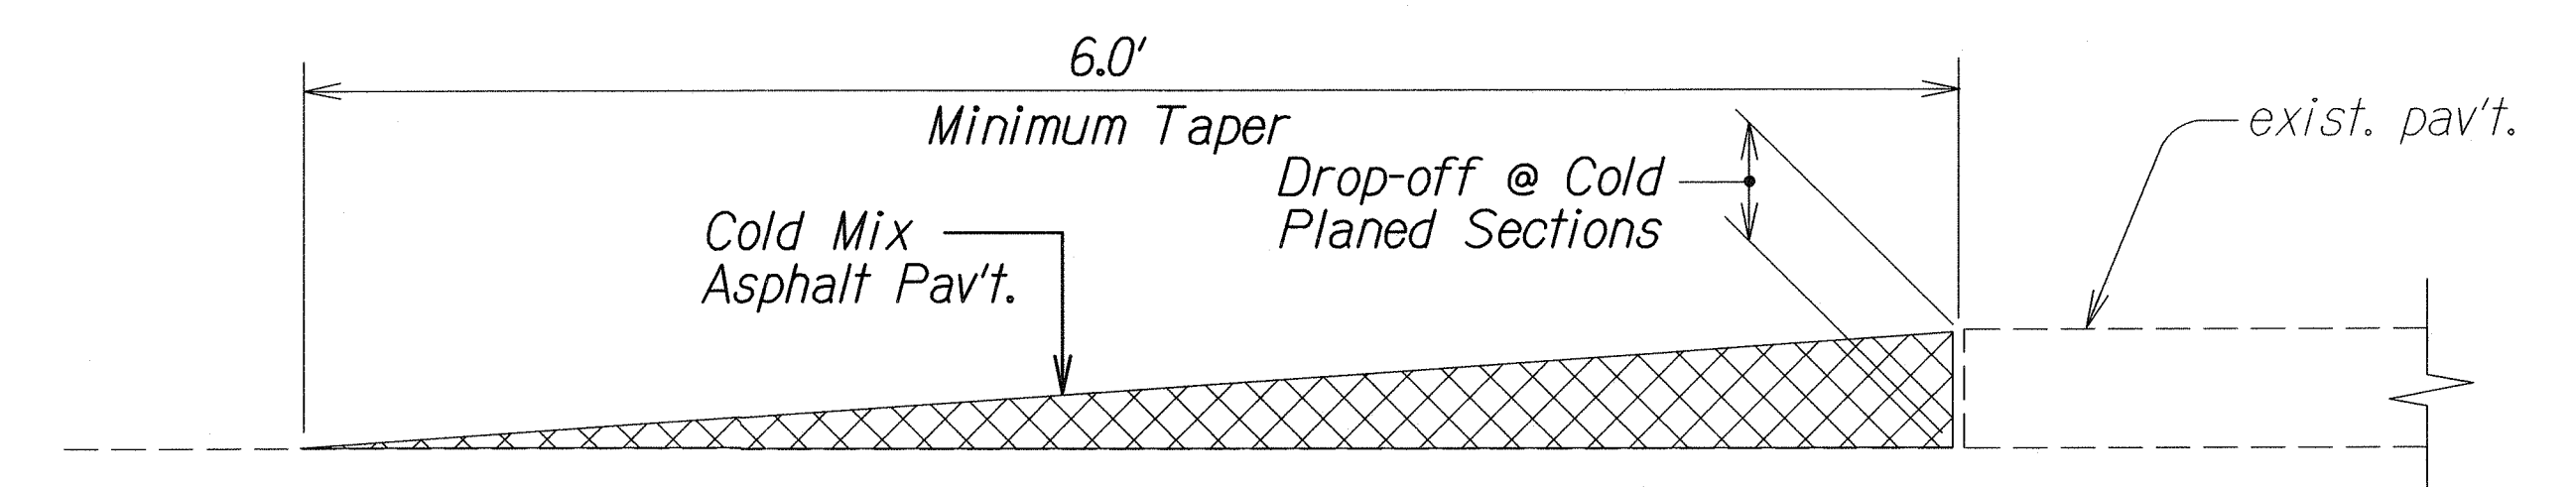


TEMPORARY TRANSITION AT
COLD PLANED AREAS
Not to Scale

Note: Contractor shall construct temporary pavement taper to prevent sharp pavement drop-offs at all cold planed sections. Prior to final Asphalt Pavement placement, temporary pavement taper shall be removed.

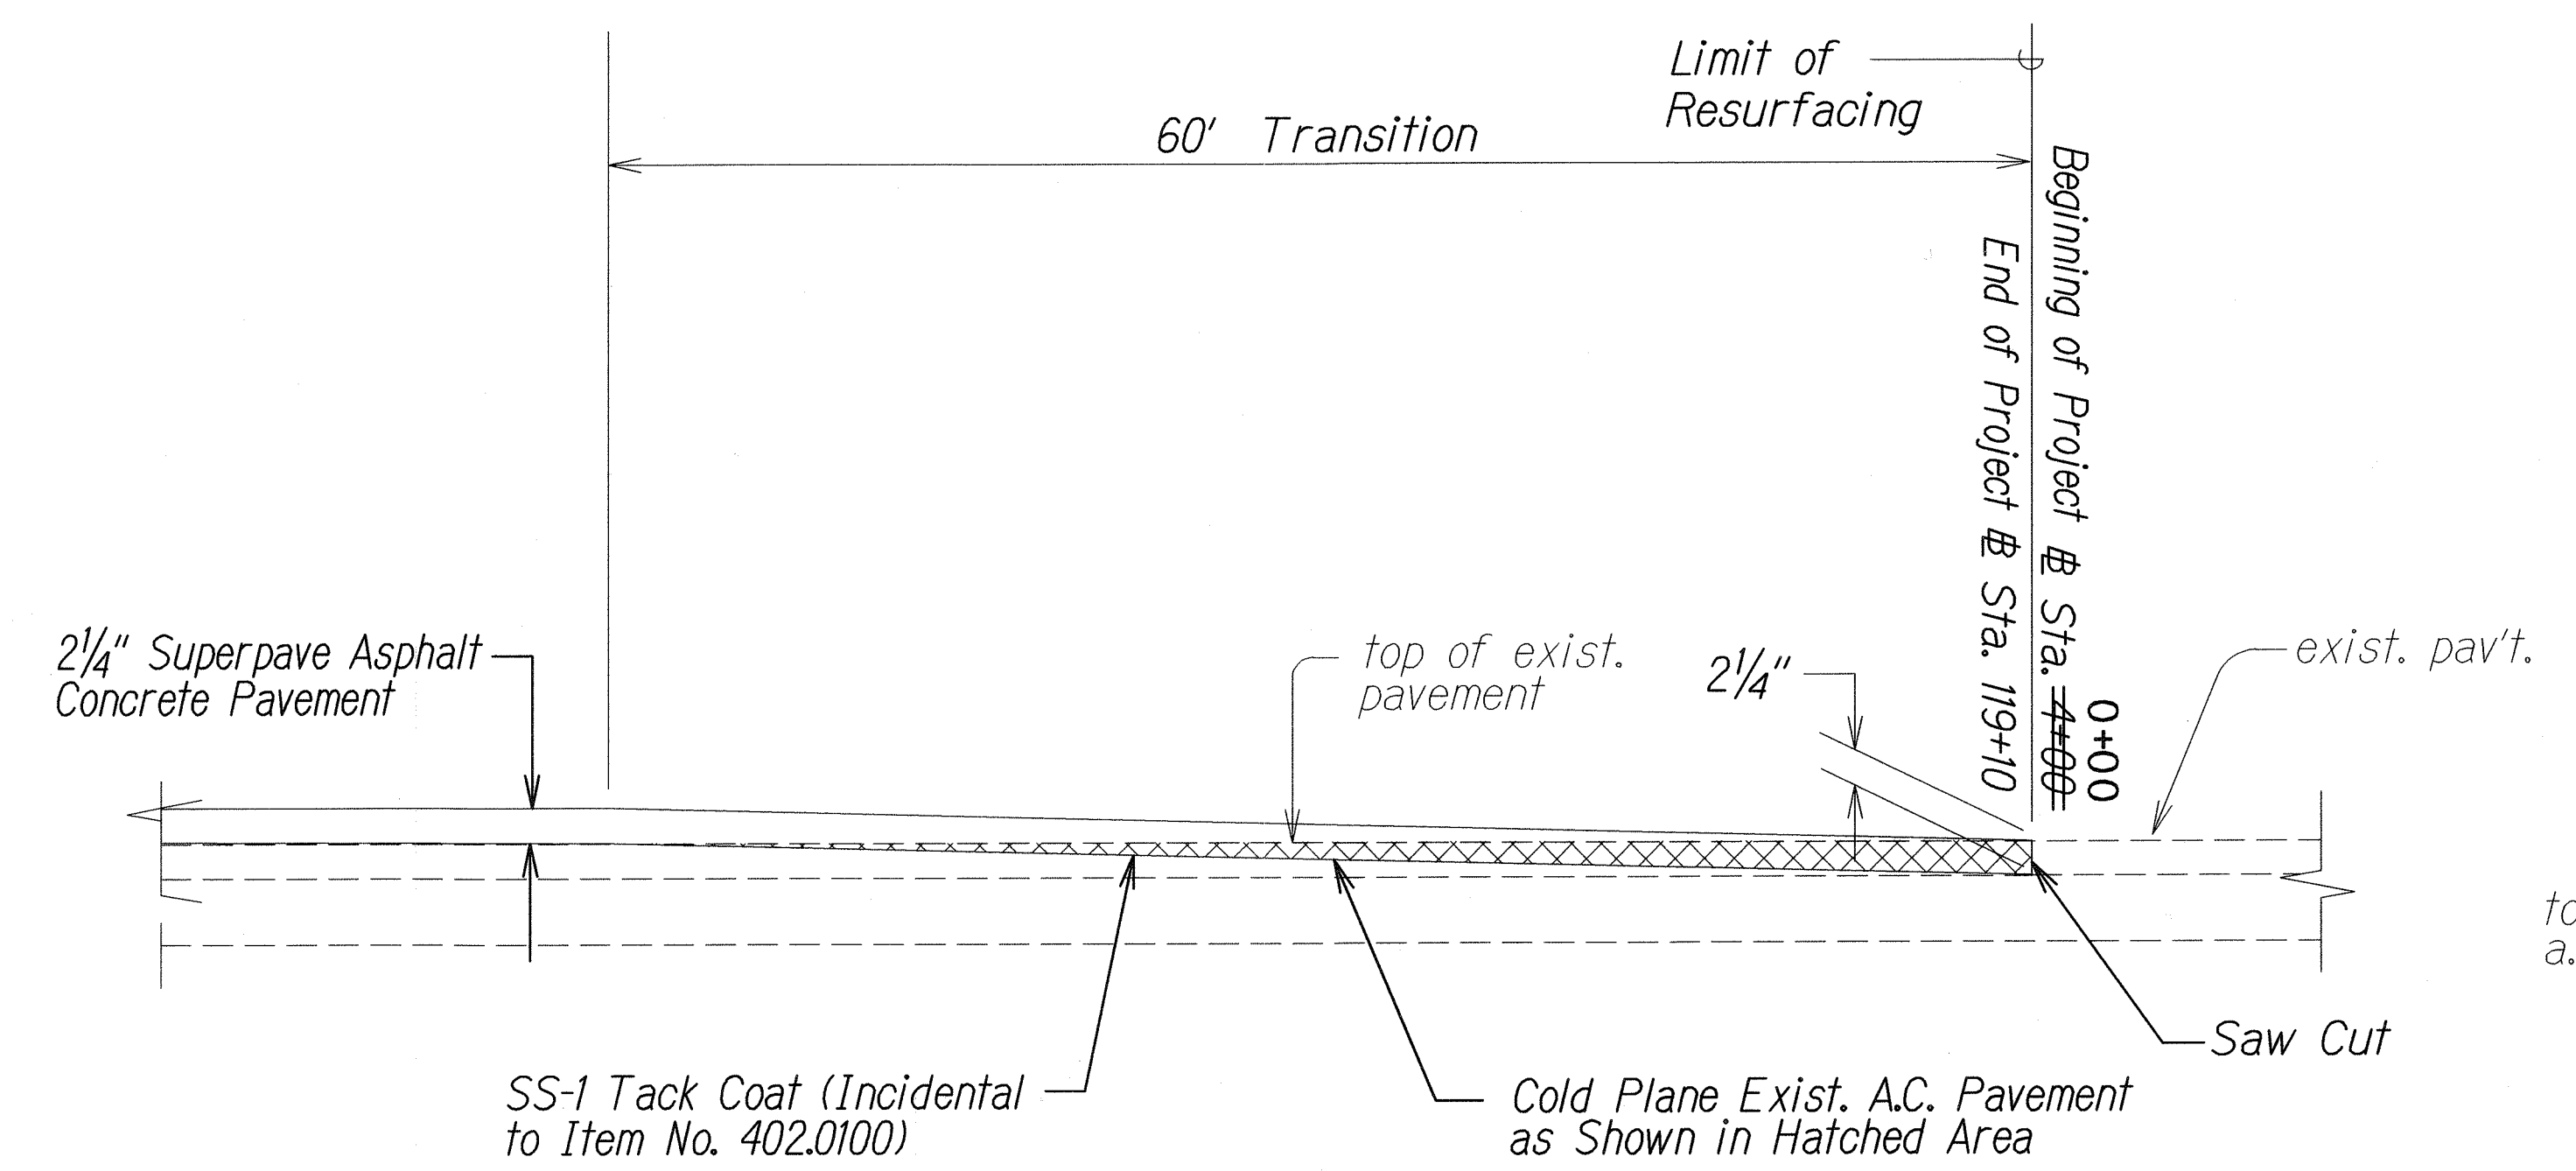

COLD PLANED TRANSITION TO EXISTING A.C. PAVEMENT
AT BEGINNING END OF PROJECT
Not to Scale

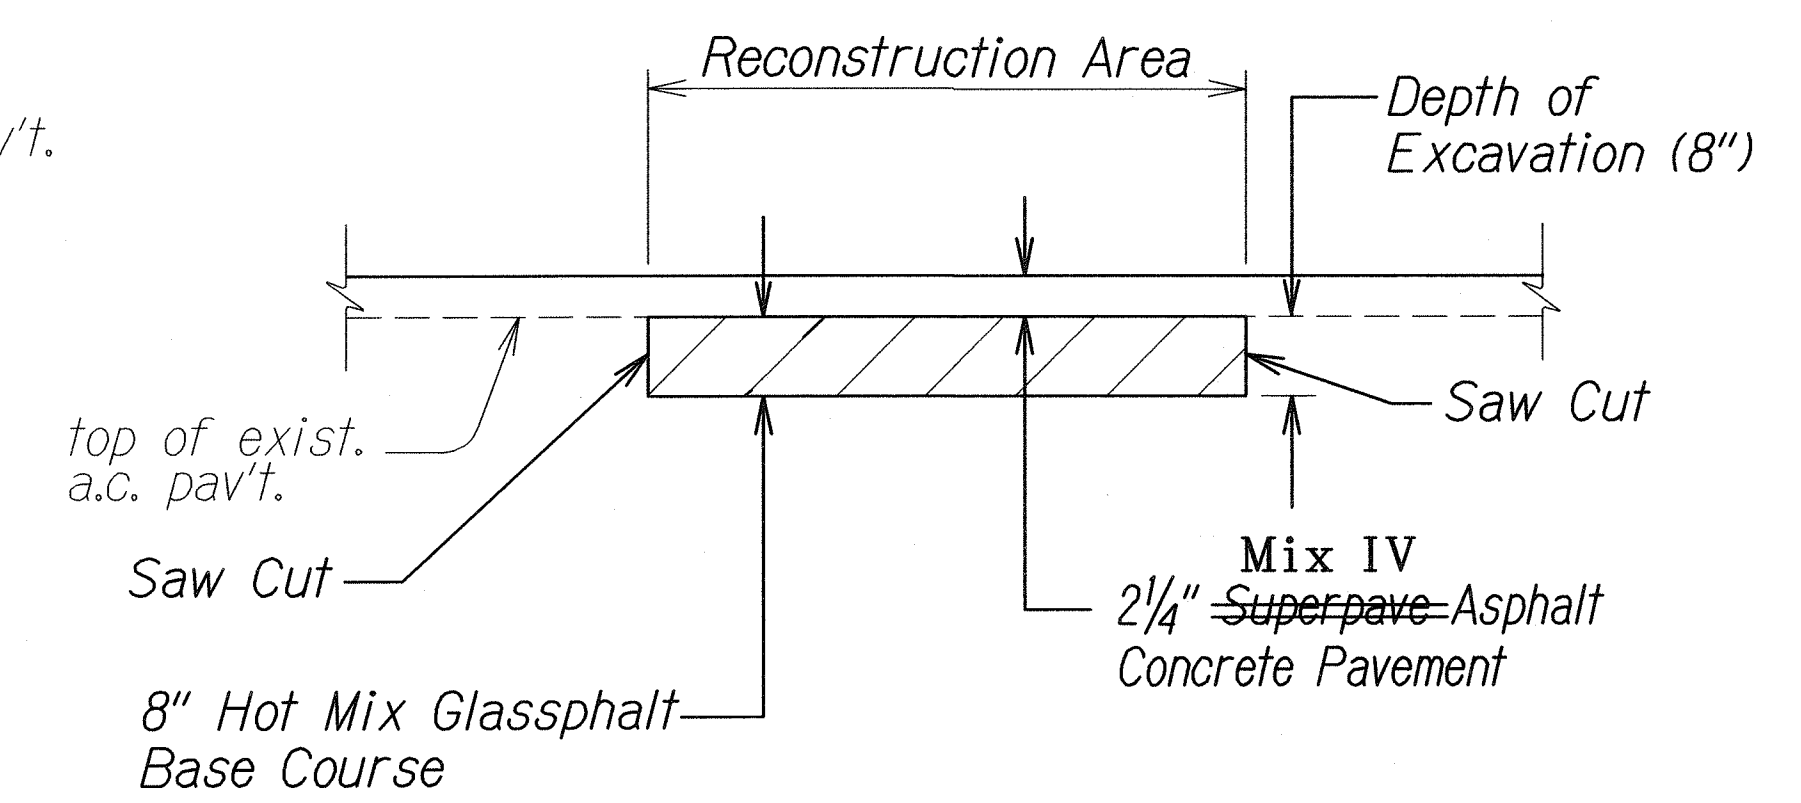

A.C. PAVEMENT RECONSTRUCTION DETAIL
Not to Scale

LEGEND FOR AS-BUILT POSTINGS	
	Squiggly line for as-built deletion
	Double line for as-built deletion
Roadway	Text for as-built posting

STATE OF HAWAII
DEPARTMENT OF TRANSPORTATION
HIGHWAYS DIVISION

TYPICAL SECTIONS
TEMPORARY KAPAA BYPASS ROAD RESURFACING
Mile Post 0.07 to Mile Post 2.26
Project No. 5600-02-10M
Not to Scale Date: Dec. 2009

ORIGINAL PLAN	DATE 12/09
SURVEY PLOTTED BY	
DRAWN BY	
TRACED BY	
CHECKED BY	
NOTED BY	
QUANTITIES BY	
CHECKED BY	

