



FED. ROAD DIST. NO.	STATE	PROJ. NO.	FISCAL YEAR	SHEET NO.	TOTAL SHEETS
HAWAII	HAW.	5600-01-10M	2010	6	12

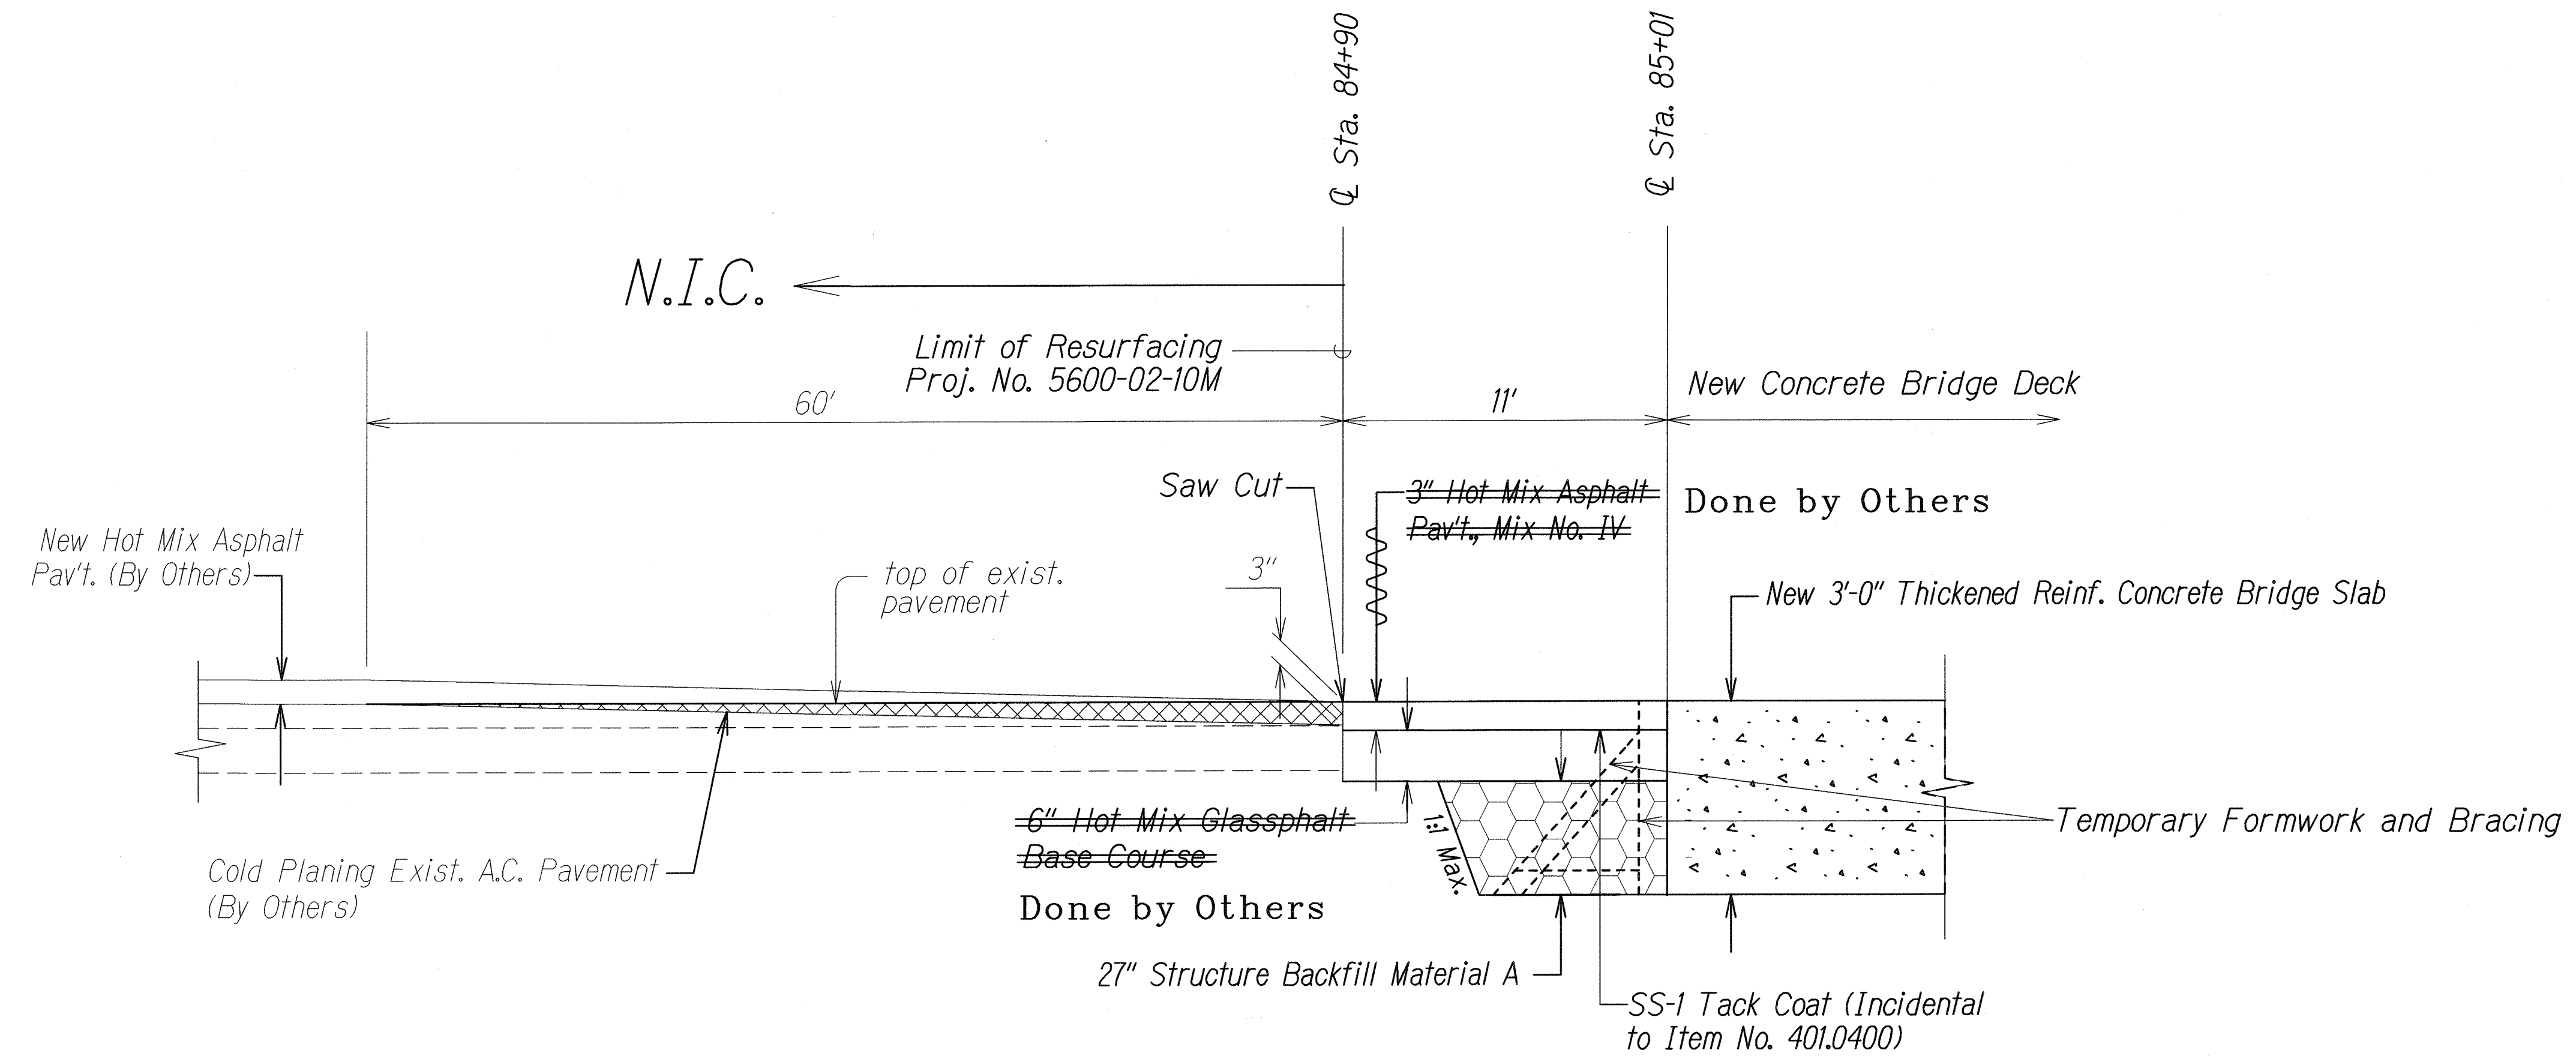

**STRUCTURAL SECTION AT NEW SLAB BRIDGE APPROACHES**  
 Not to Scale

NOTE: Similar condition at Hanalei end of new bridge.  
 Bridge deck end @ C Sta. 85+57 and limit  
 of resurfacing @ C Sta. 85+68.

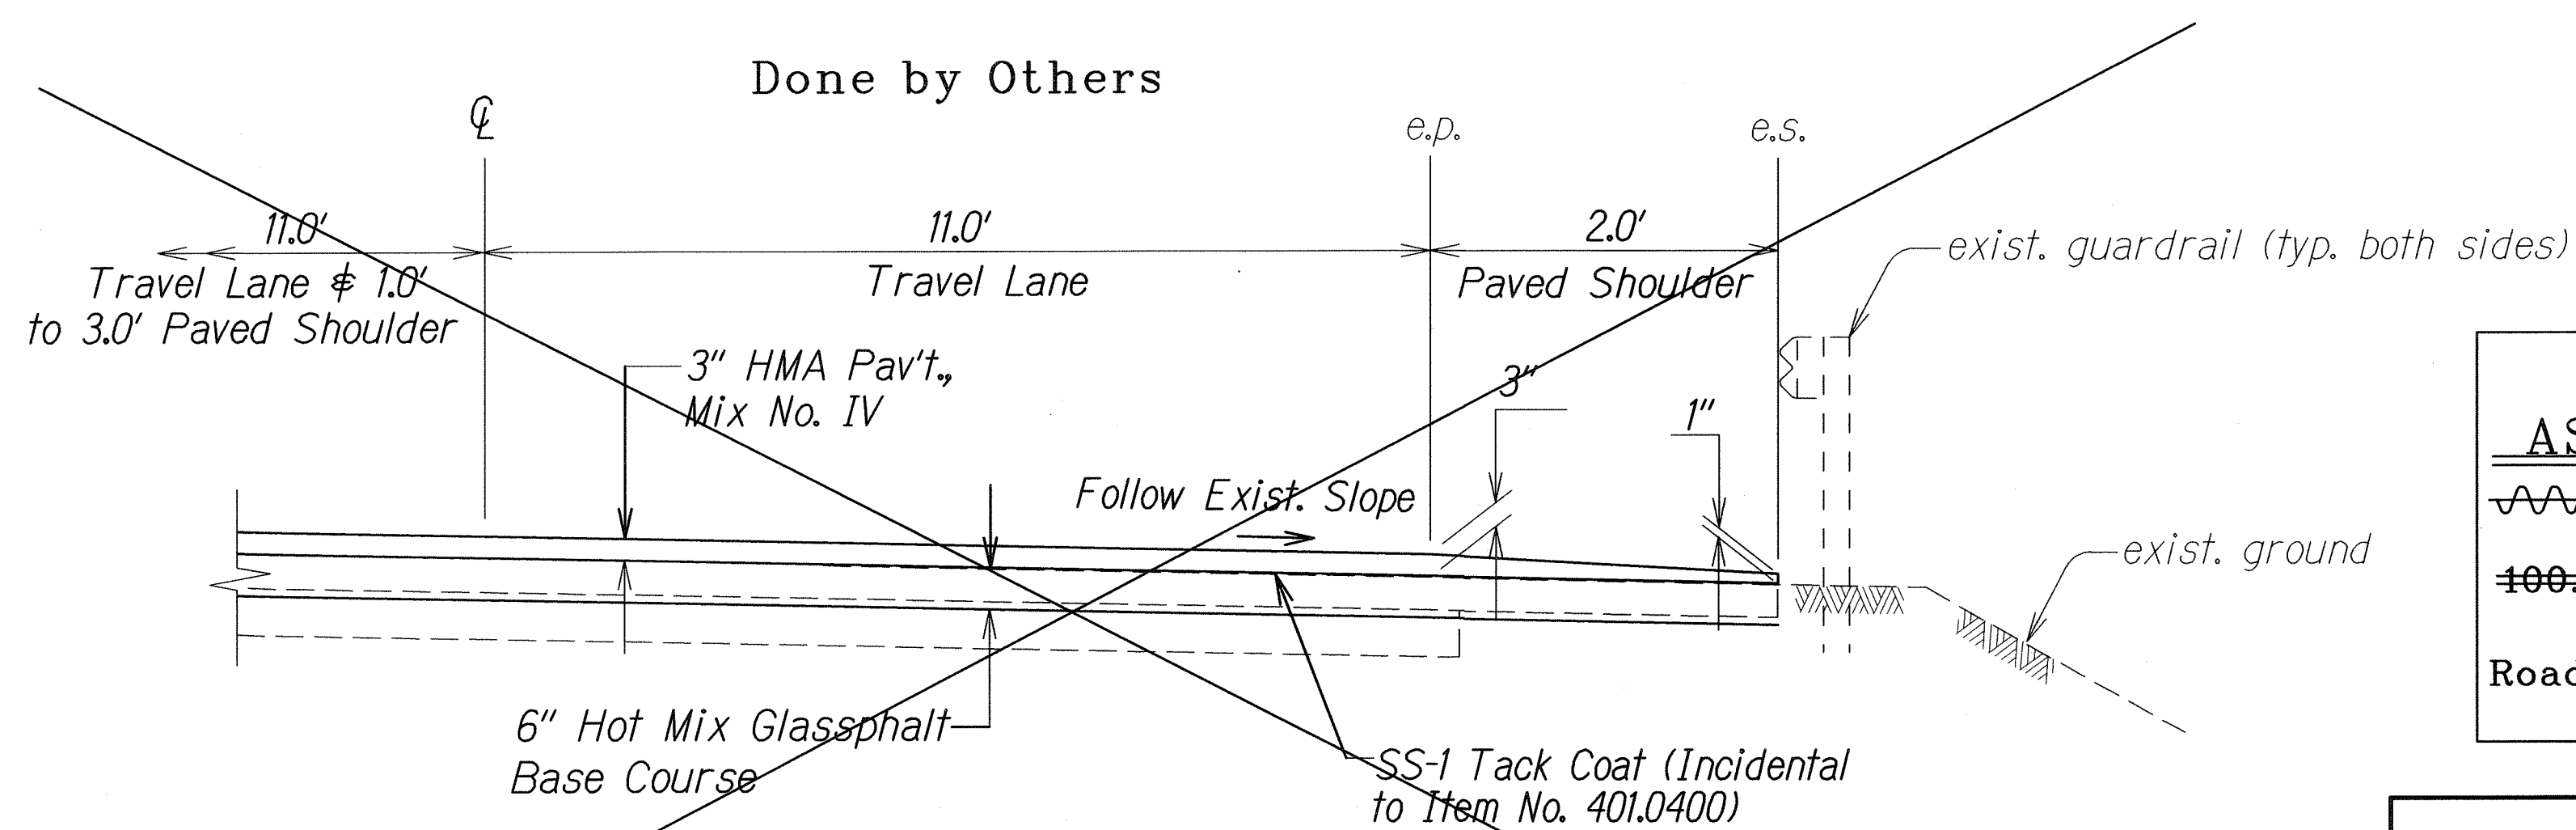

**TYPICAL SECTION**  
 C Sta. 84+90 to C Sta. 85+01  
 C Sta. 85+57 to C Sta. 85+68  
 Not to Scale

LEGEND FOR AS-BUILT POSTINGS	
	Squiggly line for as-built deletion
	Double line for as-built deletion
Roadway	Text for as-built posting

STATE OF HAWAII  
 DEPARTMENT OF TRANSPORTATION  
 HIGHWAYS DIVISION

**TYPICAL SECTIONS**

TEMPORARY KAPAA BYPASS ROAD  
 Repairs at Kainahola Stream Bridge  
 Project No. 5600-01-10M

Not to Scale Date: May 2010

ORIGINAL PLAN	SURVEY PLOTTED BY	DATE
NOTE BOOK	DRAWN BY	
REVISIONS	DESIGNED BY	
QUANTITIES BY	CHECKED BY	
NO.		