


FED. ROAD DIST. NO.	STATE	PROJ. NO.	FISCAL YEAR	SHEET NO.	TOTAL SHEETS
HAWAII	HAW.	HWY-M-ART18-01	2022	26	80

GENERAL NOTES:

- REFER TO MECHANICAL SHEETS FOR ALL HVAC, PLUMBING ITEMS BUT NOT LIMITED TO HVAC EQUIPMENT, PIPING, DUCTING, PIPING SUPPORTS AND CHILL WATER PIPING, AND CONNECTIONS.
- REFER TO ELECTRICAL SHEETS FOR ALL POWER, FIRE ALARM, IT, AND LIGHTING WORK.

LEGEND:

KEY PLAN:

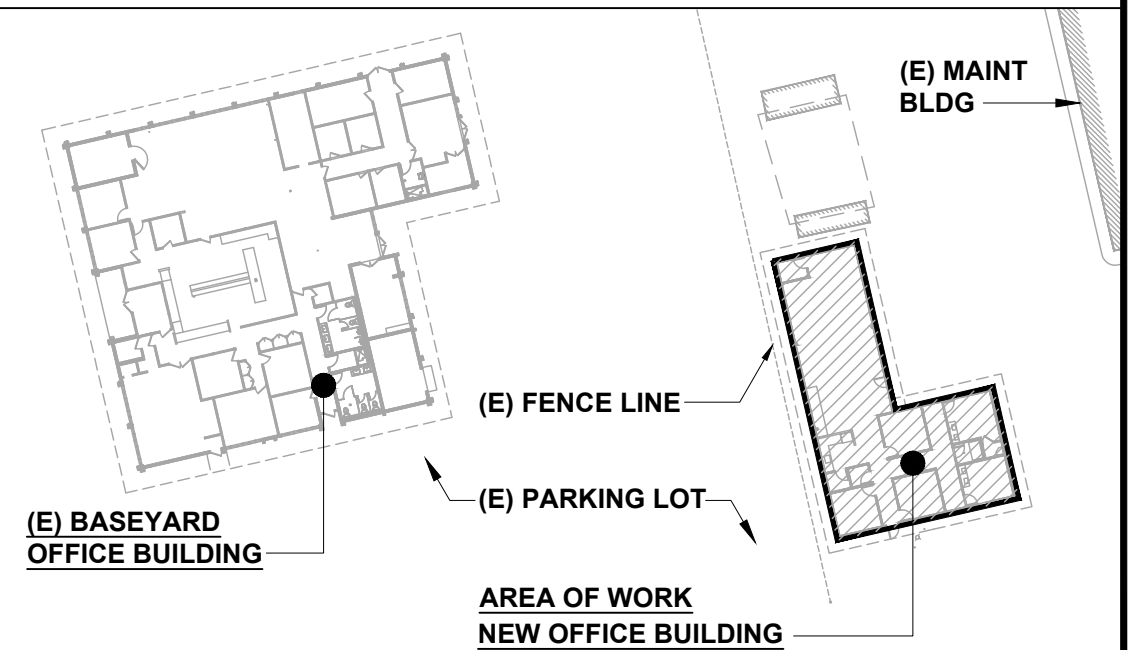

This work was prepared by me or under my supervision and construction of the project will be under my observation. Expiration date 04/30/24.


STATE OF HAWAII
DEPARTMENT OF TRANSPORTATION
HIGHWAYS DIVISION

BUILDING ELEVATIONS

MAUI DISTRICT BASEYARD
Project No. HWY-M-ART18.01


Scale: AS SHOWN Date: MAY 2022

SHEET No. A12 OF 80 SHEETS

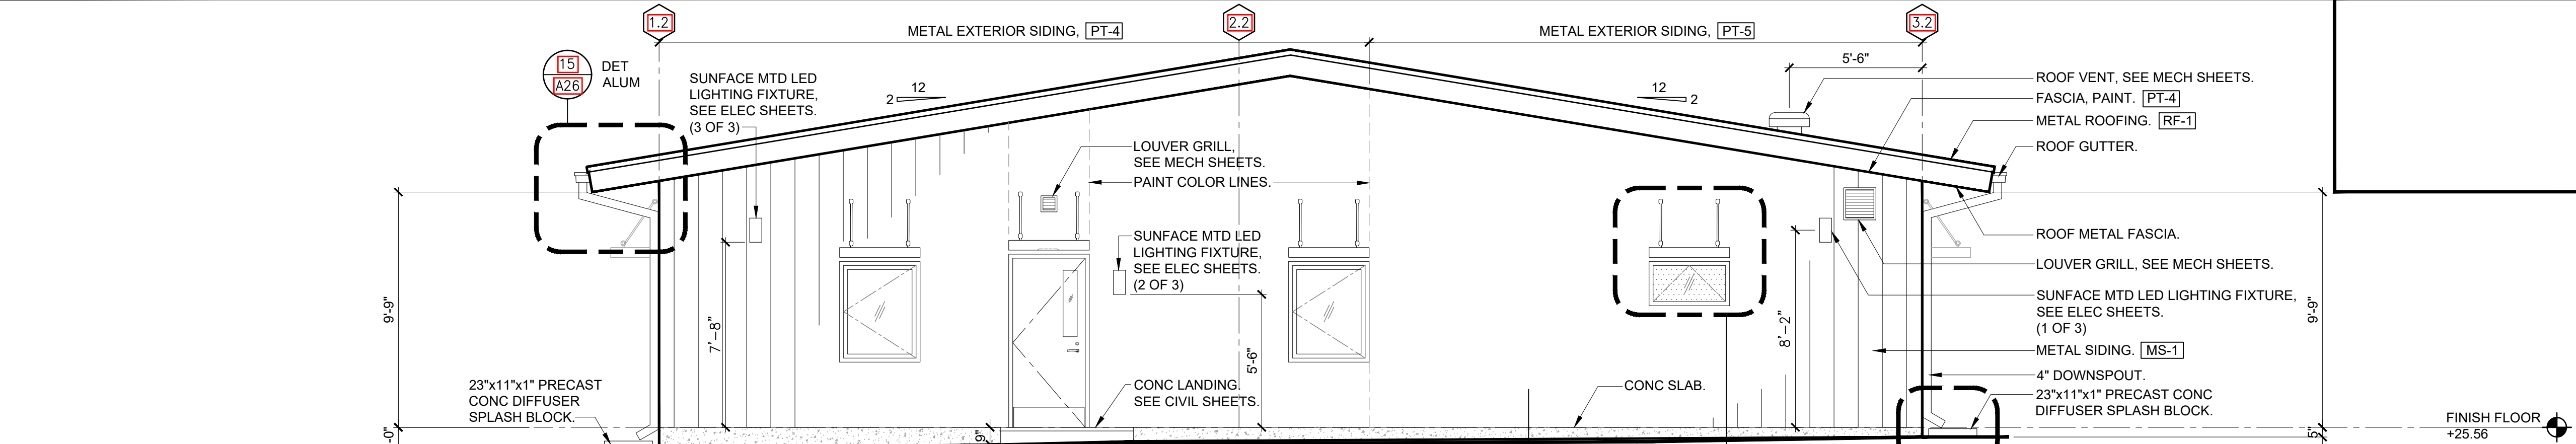


1 SOUTH ELEVATION - NEW OFFICE BUILDING

SCALE: 1/4" = 1'-0"

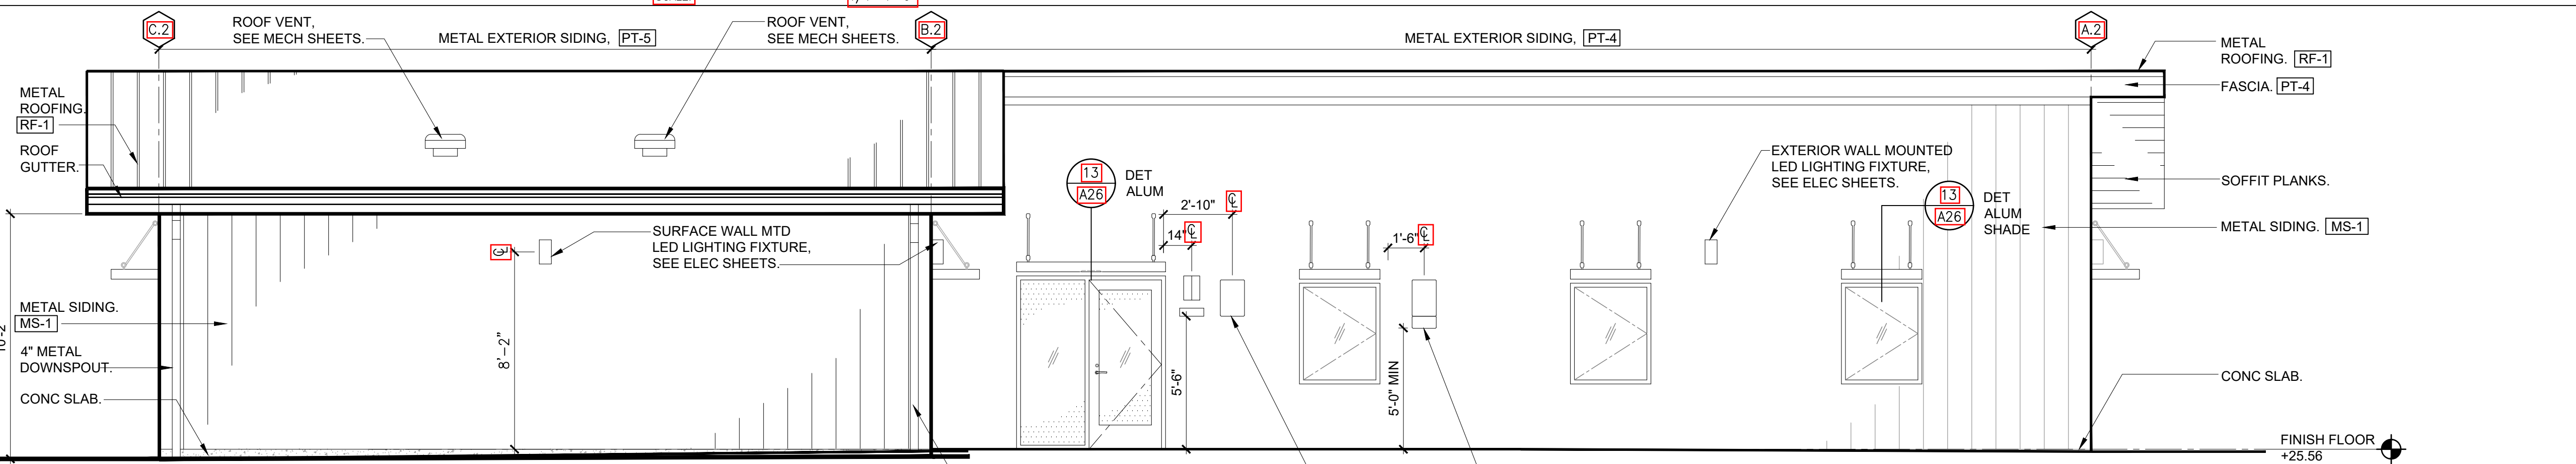


2 EAST ELEVATION - NEW OFFICE BUILDING

SCALE: 1/4" = 1'-0"

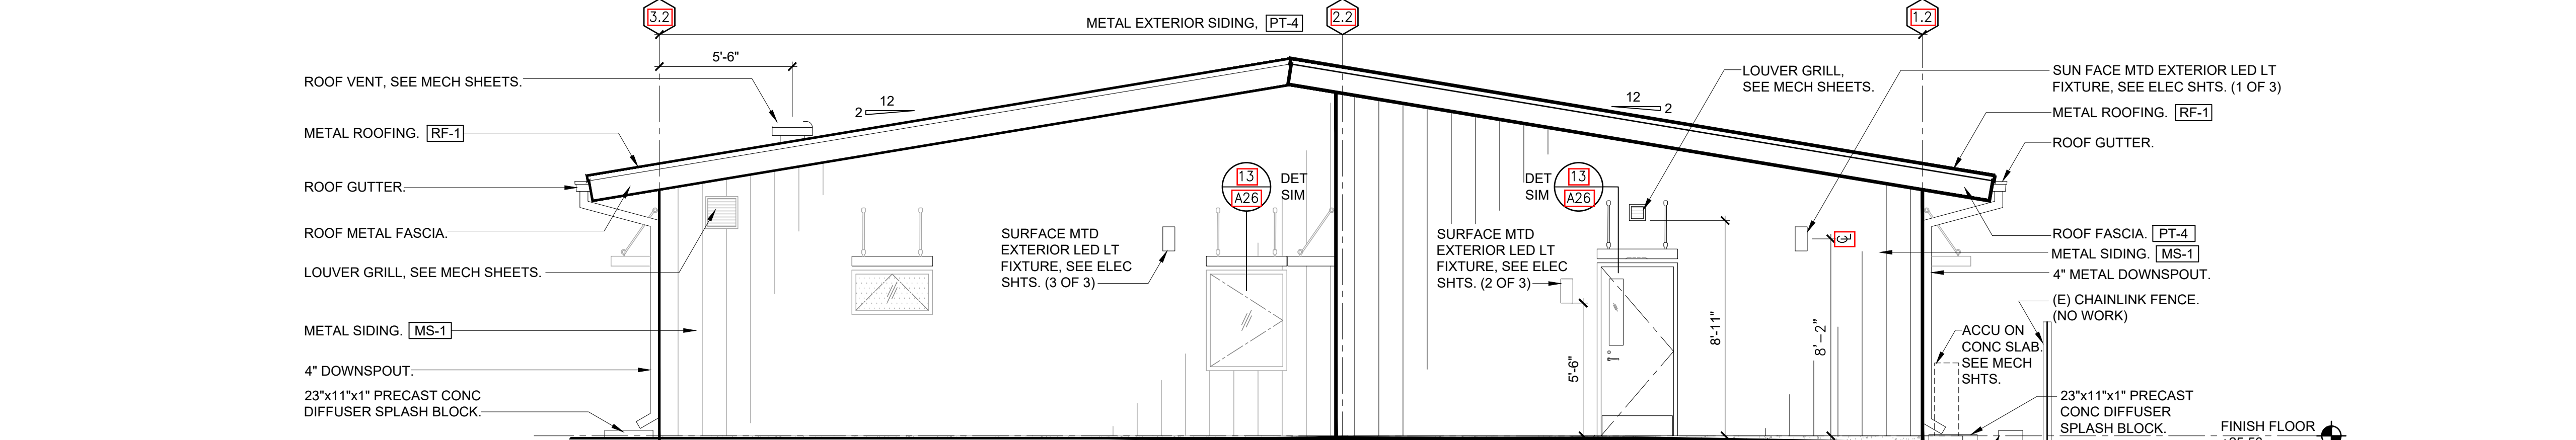

3 NORTH ELEVATION - NEW OFFICE BUILDING

SCALE: 1/4" = 1'-0"

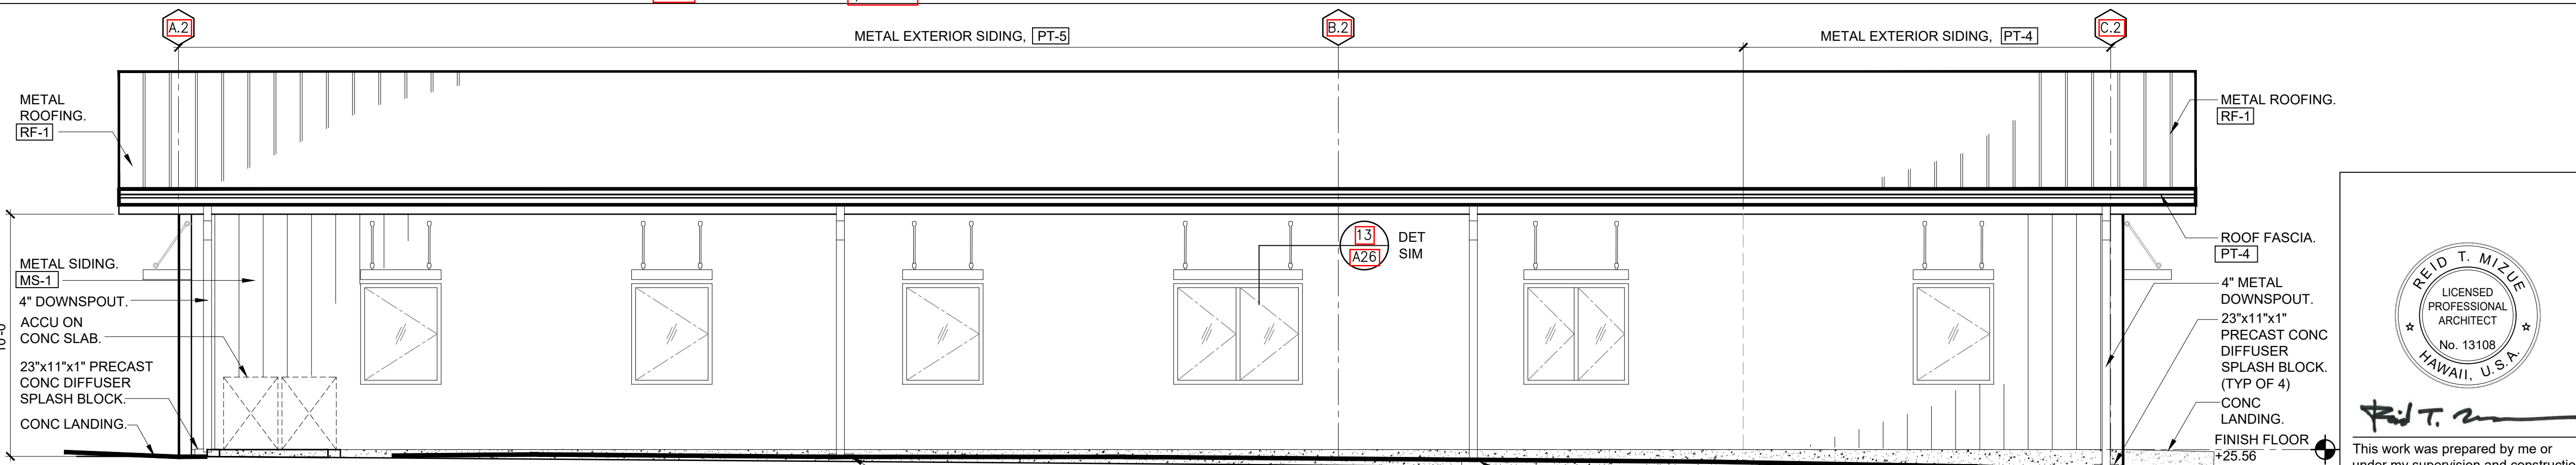

4 SOUTH ELEVATION - NEW OFFICE BUILDING

SCALE: 1/4" = 1'-0"

DATE	01/05/24
SURVEY PLOTTED BY	REID T. MIZUE
DRAWN BY	REID T. MIZUE
DESIGNED BY	REID T. MIZUE
CHECKED BY	REID T. MIZUE
NOTED BY	REID T. MIZUE
REVISION	NS