

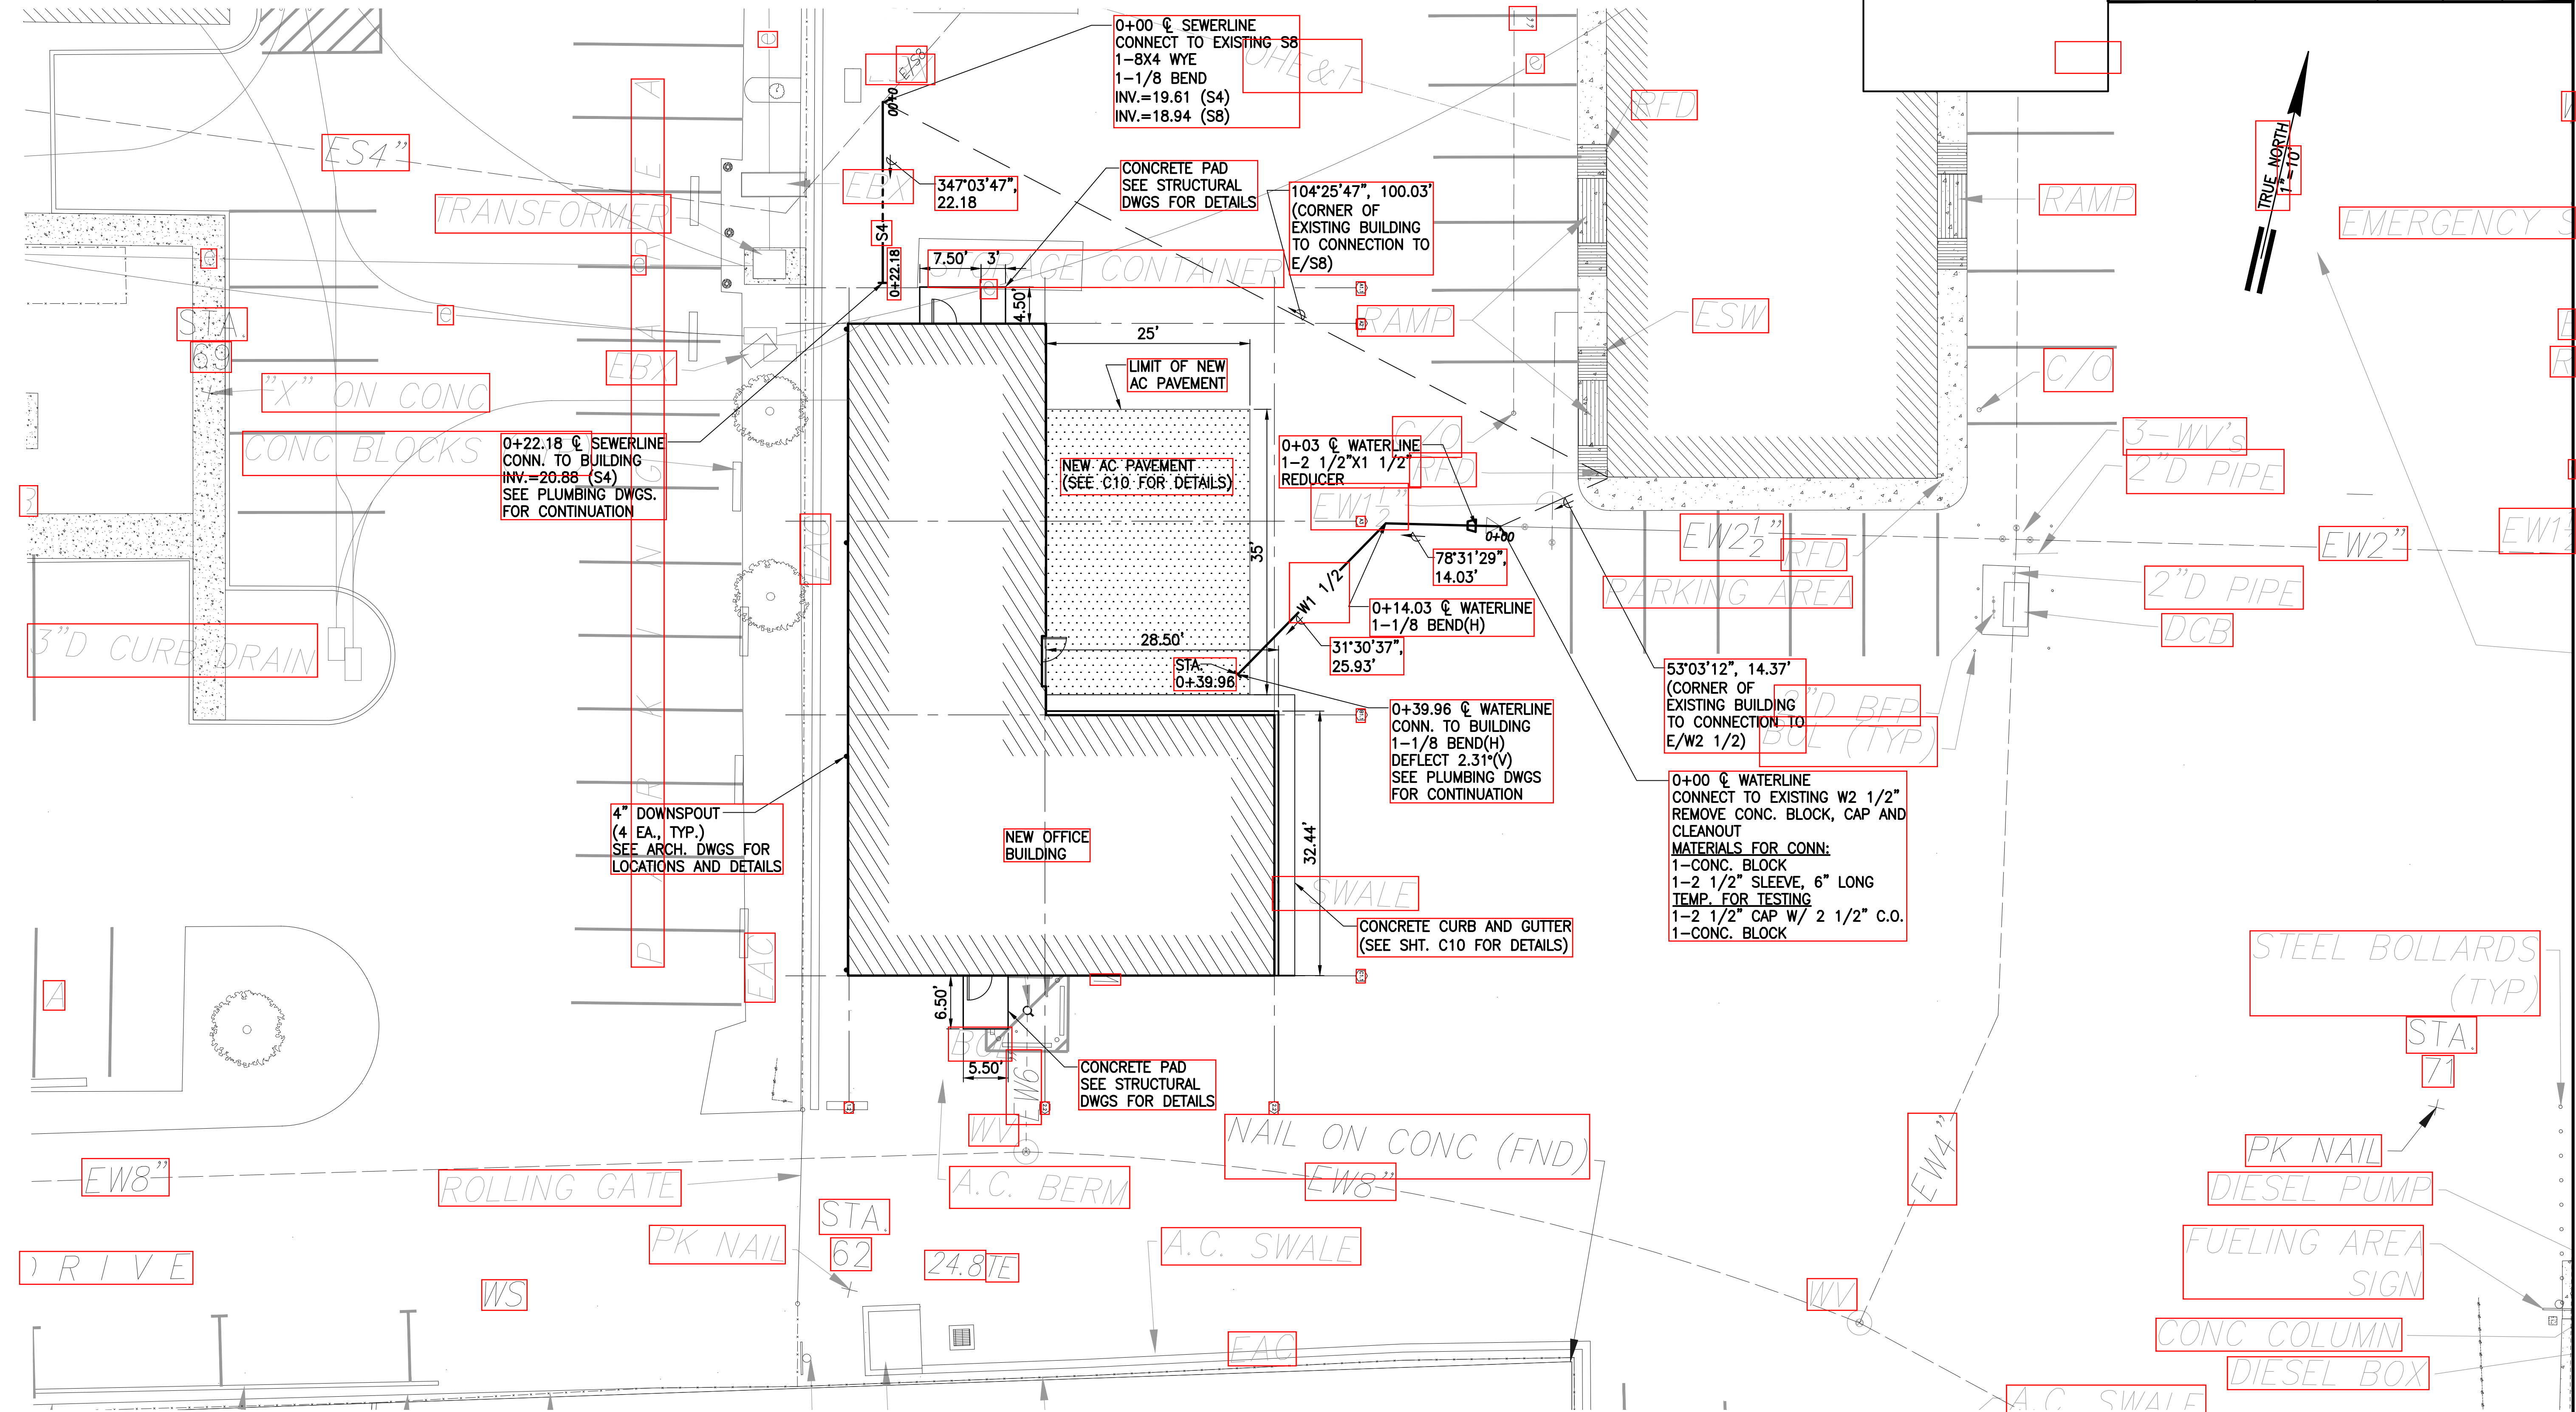


FED. ROAD DIST. NO.	STATE	PROJ. NO.	FISCAL YEAR	SHEET NO.	TOTAL SHEETS
HAWAII	HAW.	HWY-M-ART18-01	2022	9	80

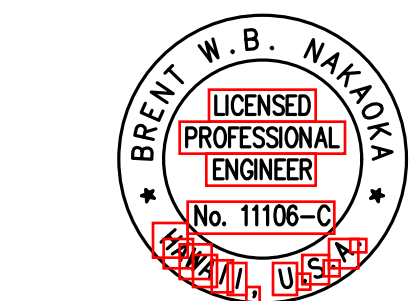

DATE	10/10/22
DESIGNED BY	BRAD ALI
DRAWN BY	BRAD ALI
CHECKED BY	BRAD ALI
NO.	1

SITE AND UTILITY PLAN
SCALE: 1" = 10'

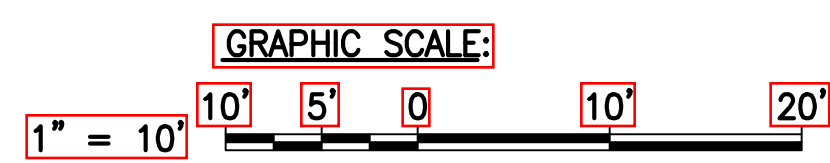

BRAD ALI
LICENSE EXPIRATION DATE: 04/30/2024

STATE OF HAWAII
DEPARTMENT OF TRANSPORTATION
HIGHWAYS DIVISION

SITE AND UTILITY PLAN

MAUI DISTRICT BASEYARD
Project No. HWY-M-ART18.01

Scale: AS SHOWN Date: MAY 2022

SHEET No. 06 OF 80 SHEETS