

"AS-BUILT" PLANS FOR

MAUI DISTRICT BASEYARD

PHASE II

KAHULUI, MAUI, HAWAII

FOR THE

STATE OF HAWAII
DEPARTMENT OF TRANSPORTATION

HIGHWAYS DIVISION

HONOLULU, HAWAII

PROJECT NO. HWY - M - 01 - 75

NISHIMURA & OKI ENGINEERS, INC.

LANGE, THOM & MOTONAGA INC.

ALBERT CHONG ASSOCIATES, INC.

STANLEY S. SHIMABUKURO & ASSOCIATES, INC.

STRUCTURAL ENGINEER

MECHANICAL ENGINEER

ELECTRICAL ENGINEER

CIVIL ENGINEER

ALL CHANGES MADE DURING CONSTRUCTION HAVE BEEN INCORPORATED ON THESE PLANS IN RED EXCEPT CHANGES IN THE ORIGINAL THEORETICAL QUANTITIES. FOR ACTUAL QUANTITIES, REFER TO PROJECT LEDGER AND/OR COMPUTATION BOOK.

RESIDENT ENGINEER

DATE

Plan Sht. Nos. 20S-1 & 21RS-1 are supplementary sheets to this project.

Total Sheet Count after "AS-BUILT" postings:
34 sheets

FED. ROAD DIST. NO.	STATE	PROJ. NO.	FISCAL YEAR	SHEET NO.	TOTAL SHEETS
HAWAII	HAW.	HWY-M-01-75	1977	1	32

INDEX TO DRAWINGS

PLAN SHT. NO.	SHEET NO.	DESCRIPTION
1	T-1	TITLE SHEET, INDEX TO DRAWINGS, LEGEND & APPROVALS
2	C-1	SITE GRADING & UTILITY PLAN
3	C-2	SECTIONS, TEST PIT LOGS, & MISCELLANEOUS DETAILS
		MAINTENANCE OFFICE & SHOP BLD'G.
4	A-1	FLOOR PLAN, ROOF PLAN, REFLECTED CEILING PLANS & SCHEDULES
5	A-2	EXTERIOR ELEVATIONS & BUILDING SECTIONS
6	A-3	DETAILED PLANS & INTERIOR ELEVATIONS
7	A-4	INTERIOR ELEVATIONS
		REPAIR SHOP BUILDING
8	A-5	FLOOR PLAN, ROOF PLAN, REFLECTED CEILING PLAN & SCHEDULES
9	A-6	EXTERIOR ELEVATIONS & BUILDING SECTIONS
10	A-7	DETAILED PLAN & INTERIOR ELEVATIONS
		REPAIR SHOP BUILDING, MAINTENANCE OFFICE & SHOP BLD'G.
11	A-8	INTERIOR ELEVATIONS, CEILING FRAMING PLAN & SECTIONS
12	A-9	BUILDING DETAIL SECTIONS
13	A-10	BUILDING DETAIL SECTIONS & MISCELLANEOUS DETAILS
14	A-11	MISCELLANEOUS DETAILS
15	A-12	DOOR & WINDOW DETAILS
16	A-13	DOOR DETAIL, MILL WORK & MISCELLANEOUS DETAILS
		SERVICE STATION BUILDING
17	A-14	FLOOR PLAN, ELEVATIONS, SECTIONS & DETAIL
18	A-15	TRUCK WASHING PAD
19	A-16	LOADING PLATFORM & RAMP AND ROCK BINS
20	S-1	FOUNDATION PLANS
21	S-2	FOUNDATION DETAILS
22	S-3	FOUNDATION PLAN, ROOF FRAMING PLAN, SECTIONS & DETAILS
23	M-1	FLOOR PLANS & DIAGRAMS
24	M-2	FLOOR PLANS
25	M-3	FLOOR PLANS, DETAILS & EQUIPMENT SCHEDULE
26	M-4	PIPING DIAGRAMS
27	M-5	PIPING DIAGRAMS
28	E-1	ELECTRICAL SITE PLAN, SYMBOLS & DETAILS
29	E-2	MAINTENANCE BUILDING PANEL SCHEDULE
30	E-3	REPAIR SHOP BUILDING PANEL SCHEDULE
31	E-4	SINGLE LINE DIAGRAM, SCHEDULE & SERVICE STATION PLAN & DETAIL
32	B-1	SOIL EROSION CONTROL PLAN

LEGEND

	CONCRETE		DENOTES DETAIL
	CONCRETE MASONRY UNIT		DENOTES SHT. NO.
	WOOD		DENOTES WINDOW
	FILL OR ACOUSTIC		DENOTES LOCATION
	HARD TILE		DENOTES DOOR
			DENOTES LOCATION

APPROVED BY

for R. Higashionna
DIRECTOR, DEPARTMENT OF TRANSPORTATION
STATE OF HAWAII

Thom Lange
EXECUTIVE OFFICER, ENVIRONMENTAL HEALTH DIVISION
STATE OF HAWAII


Stanley S. Shimabukuro
FIRE MARSHALL

8/2/77
DATE


1/21/77
DATE

2-1-77
DATE

DATE

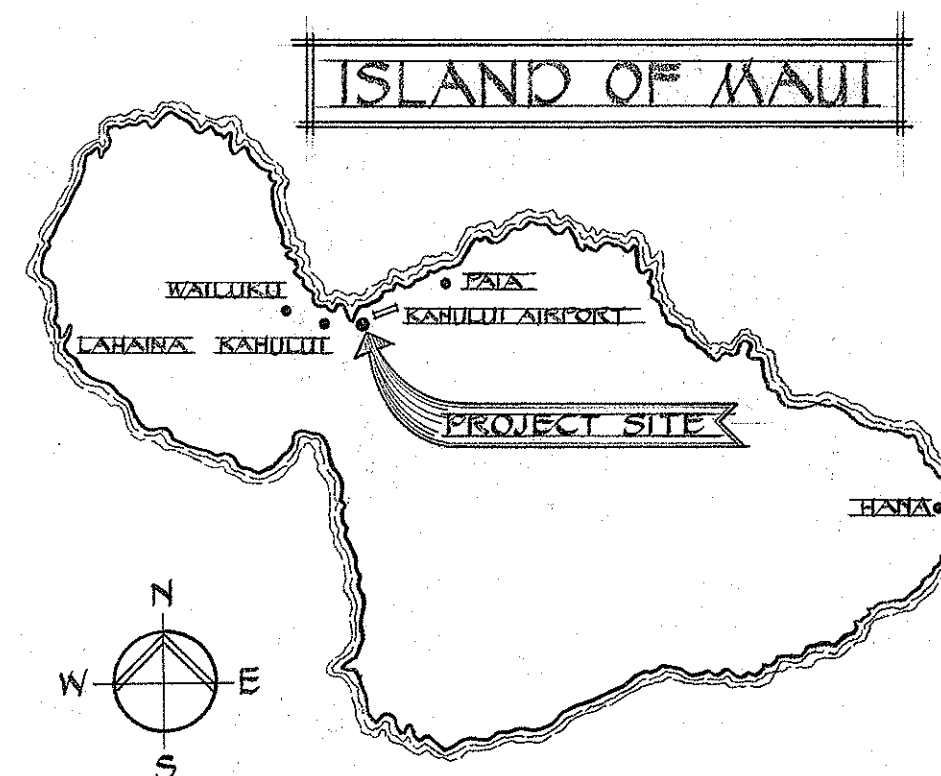

LOCATION MAP

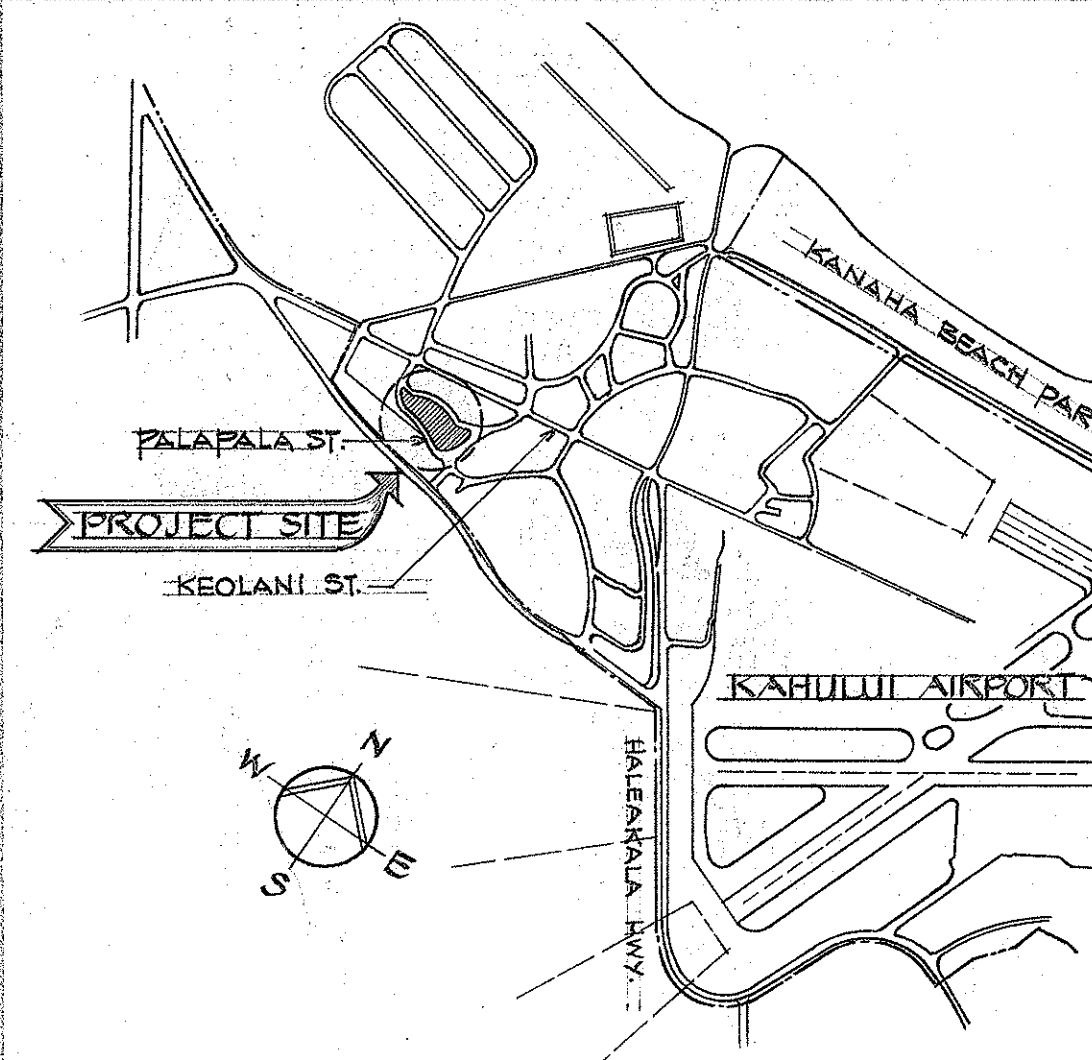

VICINITY MAP

STATE OF HAWAII DEPARTMENT OF TRANSPORTATION HIGHWAYS DIVISION
TITLE SHEET, INDEX TO DRAWINGS, LOCATION MAP, VICINITY MAP, LEGEND & APPROVALS
MAUI DISTRICT BASEYARD PHASE II
KAHULUI MAUI HAWAII
PROJ. NO. HWY - M - 01 - 75
NISHIMURA & OKI ENGINEERS, INC. JAN. 1977
SHEET NO. 1 OF 1 SHEETS

NISHIMURA & OKI ENGINEERS, INC. DESIGNED BY
H. IWAI P.S. & E. BY
548-5812 PHONE
OCT, 1977 DATE

SURVEY PLOTTED BY	DATE
PLAN	
DESIGNED BY	
TRACED BY	
NOTE BOOK	
QUANTITIES BY	
CHECKED BY	