

NISHIMURA, OKI & SANTO INC.
DESIGNED BY

H. IWAI
P.S. & E

548-5812
PHONE NO.

APRIL 1981
DATE

"AS-BUILT" PLANS FOR

MAUI DISTRICT BASEYARD PHASE III

KAHULUI MAUI HAWAII

FOR THE

STATE OF HAWAII

DEPARTMENT OF TRANSPORTATION

HIGHWAYS DIVISION

HONOLULU, HAWAII

PROJECT NO. LT-M-02-79

ALL CHANGES MADE DURING CONSTRUCTION HAVE BEEN INCORPORATED ON THESE PLANS IN RED EXCEPT CHANGES IN THE ORIGINAL THEORETICAL QUANTITIES. FOR ACTUAL QUANTITIES, REFER TO PROJECT LEDGER AND/OR COMPUTATION BOOK.

Spring D. Baker
RESIDENT ENGINEER

11/30/82
DATE

NISHIMURA, OKI & SANTO INC. STRUCTURAL ENGINEER

KENNETH THOM ASSOCIATES LTD. MECHANICAL ENGINEER

ALBERT CHONG ASSOCIATES, INC. ELECTRICAL ENGINEER

STANLEY S. SHIMABUKURO & ASSOCIATES INC. CIVIL ENGINEER

INDEX TO DRAWINGS

SHT. NO.	DESCRIPTION
T-1	TITLE SHEET
C-1	SITENWORK, GRADING, PAVING PLANS & NOTES
C-2	SITENWORK SECTIONS, DETAILS & LOG OF TESTED PITS.
A-1	DETAIL FLOOR PLAN & INTERIOR ELEVATION - MATERIAL TESTING AREA
A-2	INTERIOR ELEVATIONS - MATERIAL TESTING AREA
A-3	REFLECTED CEILING PLAN & DETAILS - MATERIAL TESTING AREA
A-4	CASEWORK DETAILS
A-5	CASEWORK DETAILS
A-6	DOOR & WINDOW SCHEDULE; DETAILS
A-7	ROLL-UP DOOR LOCATION PLAN & DETAILS
A-8	FLOOR & FOUNDATION PLAN; CROSS SECTION - TRUCK SHED
A-9	EXTERIOR ELEVATIONS & ROOF PLAN - TRUCK SHED
A-10	FOUNDATION DETAILS & GENERAL NOTES
M-1	DETAIL PLUMBING FLOOR PLAN - MATERIAL TESTING AREA
M-2	DETAIL AIR CONDITIONING FLOOR PLAN - MATERIAL TESTING AREA
M-3	AIR CONDITIONING & VENTILATION DETAILS
M-2A	AIR CONDITIONING "AS-BUILT" PLANS
E-1	ELECTRICAL SITE PLAN; ELECTRICAL SYMBOLS
E-2	ELECTRICAL FLOOR PLAN
E-3	NIGHT LIGHT CONTROL DIAGRAM & LUMINAIRE SCHEDULE
E-4	TRUCK SHED ELECTRICAL PLAN


APPROVED BY:

Ryohieki Higashionna
DIRECTOR, DEPARTMENT OF TRANSPORTATION
STATE OF HAWAII


4/7/81
DATE

John
EXECUTIVE OFFICER, ENVIRONMENTAL HEALTH DIVISION
STATE OF HAWAII

4/02/81
DATE

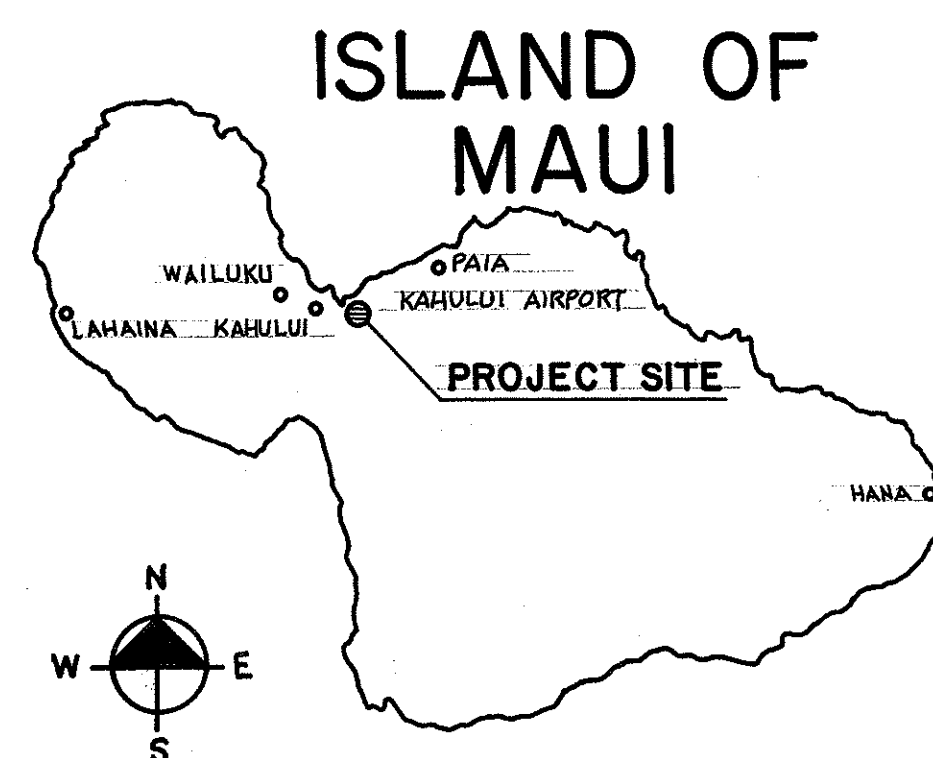

LOCATION MAP

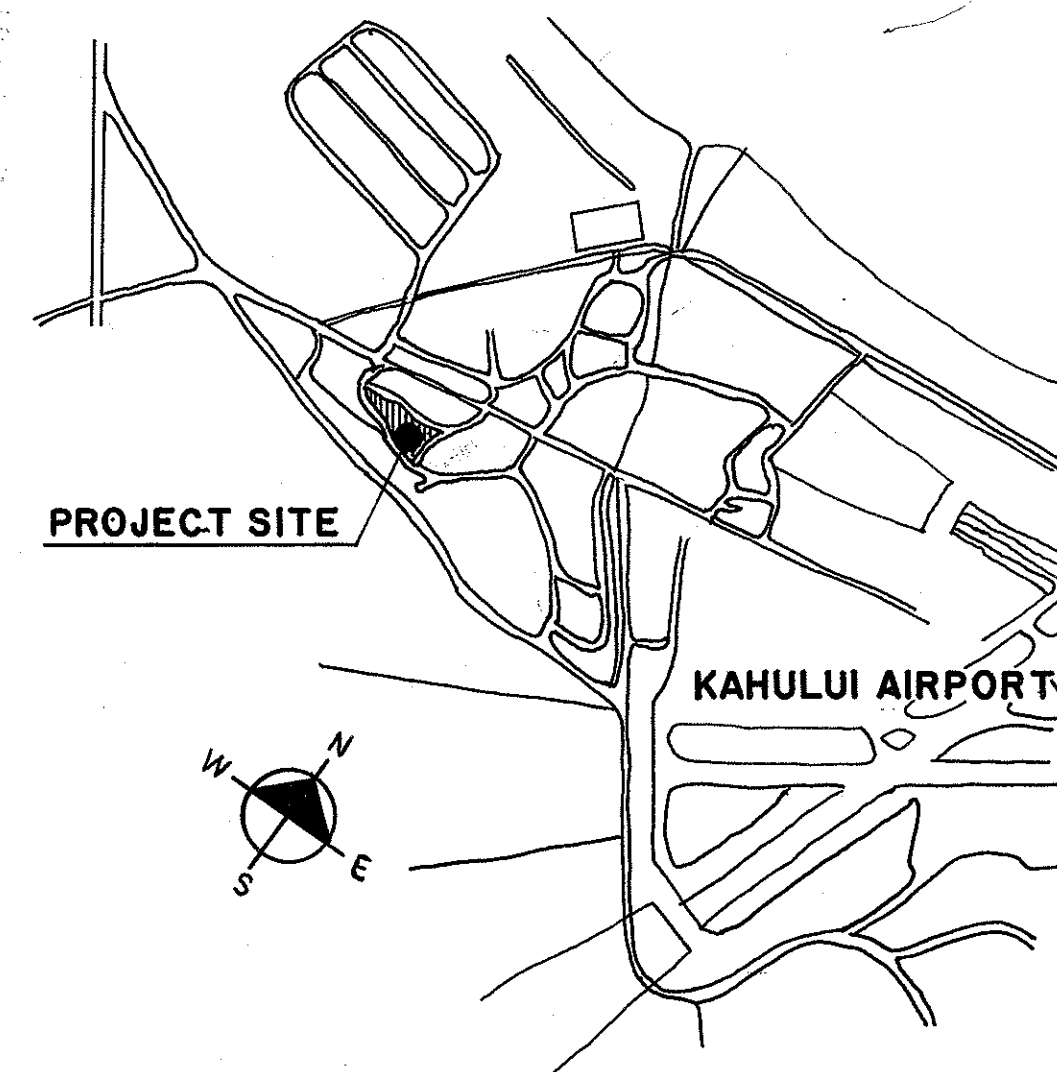

VICINITY MAP

TOTAL SHEET COUNT AFTER "AS-BUILT" POSTINGS: 21 SHEETS

STATE OF HAWAII
DEPARTMENT OF TRANSPORTATION
HIGHWAYS DIVISION

TITLE SHEET & INDEX TO DRAWINGS

MAUI DISTRICT BASEYARD
PHASE III

KAHULUI MAUI HAWAII

PROJECT NO: LT-M-02-79

NISHIMURA, OKI & SANTO INC. APRIL, 1981

SHEET NO. T-1 OF 1 SHEETS