


FED. ROAD DIST. NO.	STATE	PROJ. NO.	FISCAL YEAR	SHEET NO.	TOTAL SHEETS
MAUI	HAW.	HWY-M-04-98M	1998	2	9

GENERAL NOTES

1. VERIFY ALL DIMENSIONS AND ACTUAL CONDITIONS ON SITE PRIOR TO THE SUBMITTAL OF ANY BID, OR INITIATION OF ANY WORK. IMMEDIATELY NOTIFY THE ENGINEER OF ANY DISCREPANCIES PRIOR TO SUBMITTAL OF BID.
2. CAUTION SHALL BE EXERCISED SO THAT EXISTING AREAS TO REMAIN SHALL NOT BE DAMAGED. THE CONTRACTOR SHALL BE RESPONSIBLE FOR ANY AND ALL CORRECTIVE WORK REQUIRED TO RESTORE ALL DAMAGED ITEMS TO THEIR ORIGINAL OR NEW CONDITION AS OCCURS.
3. ALL UNUSABLE DEBRIS AND WASTE SHALL BE HAULED AWAY TO AN APPROPRIATE OFF-SITE DUMP AREA. DURING LOADING OPERATIONS, DEBRIS AND WASTE MATERIALS SHALL BE WATERED DOWN TO ALLAY DUST.
4. ALL DIMENSIONS ARE APPROXIMATE AND SHOULD NOT BE CONSTRUED AS EXACT.
5. PATCH ALL SURFACES AFFECTED BY SELECTIVE DEMOLITION TO MATCH EXISTING AND/OR NEW ADJACENT CONDITIONS.
6. ALL NEW RENOVATION WORK SHALL BE PRIMED AND PAINTED TO MATCH COLORS OF EXISTING ADJACENT SURFACES. CONTRACTOR SHALL SUBMIT COLOR SAMPLES TO THE ENGINEER FOR APPROVAL BEFORE INITIATION OF ANY AND ALL WORK.
7. THIS PROJECT SHALL CONFORM TO ADA ACCESSIBILITY GUIDELINES AND STANDARDS.
8. BUILDING & ADJOINING ROOMS WILL BE OCCUPIED DURING NORMAL WORK HOURS. ENSURE A/C & VENTILATION SYSTEM WILL BE IN OPERATION AND NOT BE CONTAMINATED BY CONSTRUCTION DUST, ASBESTOS-SUSPECT DUST OR NOXIOUS PAINT FUMES.
- ~~9. ALL SUSPECT ASBESTOS-CONTAINING MATERIAL SHALL BE DISPOSED OF IN ACCORDANCE WITH APPLICABLE LAWS, RULES, AND REGULATIONS.~~
10. THE CONTRACTOR SHALL BE RESPONSIBLE IN OBTAINING THE NECESSARY PERMITS & APPROVALS AND MAKE THE NECESSARY NOTIFICATIONS AS REQUIRED BY THE APPROPRIATE AGENCY.
- ~~11. PRIOR TO THE NOTICE TO PROCEED FOR CONSTRUCTION, NO LATER THAN 20 WORKING DAYS BEFORE THE ACTUAL COMMENCEMENT OF ANY ON-SITE CONSTRUCTION ACTIVITY, A WRITTEN NOTIFICATION OF THE PROPOSED ASBESTOS ABATEMENT WORK SHALL BE SENT TO THE STATE OF HAWAII, DEPARTMENT OF HEALTH, AND TO OTHER GOVERNMENT AGENCIES RESPONSIBLE FOR OCCUPATIONAL HEALTH AND SAFETY, HAZARDOUS WASTE DISPOSAL, AND AUTHORITIES RESPONSIBLE FOR THE ENFORCEMENT OF THE NATIONAL EMISSION STANDARD FOR ASBESTOS.~~
12. PRIOR TO THE NOTICE TO PROCEED FOR CONSTRUCTION, A PRE-CONSTRUCTION MEETING WILL BE HELD WITH THE CONTRACTOR. IN THE MEETING THE CONTRACTOR SHALL DISCLOSE AND IDENTIFY ALL CONTROL AND RESTRICTED AREAS, DESIGNATED HAULING ROUTES WITHIN THE BUILDING, LOADING AND UNLOADING AREAS, ASBESTOS STAGING AREAS, HOURS OF WORK, AND ADDRESS ALL CONCERNS TO INSURE THE PROPER AND SAFE EXECUTION OF WORK.
13. THE CONTRACTOR'S ATTENTION IS DIRECTED TO THE FOLLOWING SECTIONS OF THE SPECIAL PROVISIONS:
SUBSECTION 107.13 - PUBLIC CONVENIENCE AND SAFETY;
SUBSECTION 107.21 - CONTRACTOR'S RESPONSIBILITY FOR UTILITY PROPERTY AND SERVICES.
14. AT THE END OF EACH DAY'S WORK, THE CONTRACTOR SHALL REMOVE ALL EQUIPMENT AND OTHER OBSTRUCTIONS TO PERMIT FREE AND SAFE PASSAGE OF PUBLIC TRAFFIC.
15. THE CONTRACTOR, AT HIS/HER EXPENSE, SHALL KEEP THE PROJECT AREA AND SURROUNDING AREA FREE OF DUST NUISANCE. THE WORK SHALL BE IN CONFORMANCE WITH APPLICABLE AIR POLLUTION CONTROL STANDARDS AND REGULATIONS OF THE STATE DEPARTMENT OF HEALTH AND THE COUNTY OF MAUI CODE.
16. THE CONTRACTOR SHALL DESIGNATE A CONTACT PERSON TO HANDLE AND ADDRESS INQUIRIES AND/OR COMPLAINTS REGARDING FUGITIVE DUST.

ORIGINAL PLAN	SURVEY PLOTTED BY	DATE
NOTE BOOK	DESIGNED BY	
	QUANTITIES BY	
	CHECKED BY	

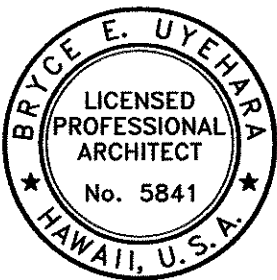

THIS WORK WAS PREPARED BY
ME
DATE: 5/28/98

STATE OF HAWAII
DEPARTMENT OF TRANSPORTATION
HIGHWAYS DIVISION
I-2
GENERAL NOTES
MAUI DISTRICT
ADMINISTRATION BUILDING
GENERAL OFFICE RENOVATION
PROJECT NO. HWY-M-04-98M
SCALE: AS NOTED
DATE: 5/28/98

DATE	REVISION	APP'D.	SHEET No. 2 OF 2 SHEETS
------	----------	--------	-------------------------

"AS-BUILT"