

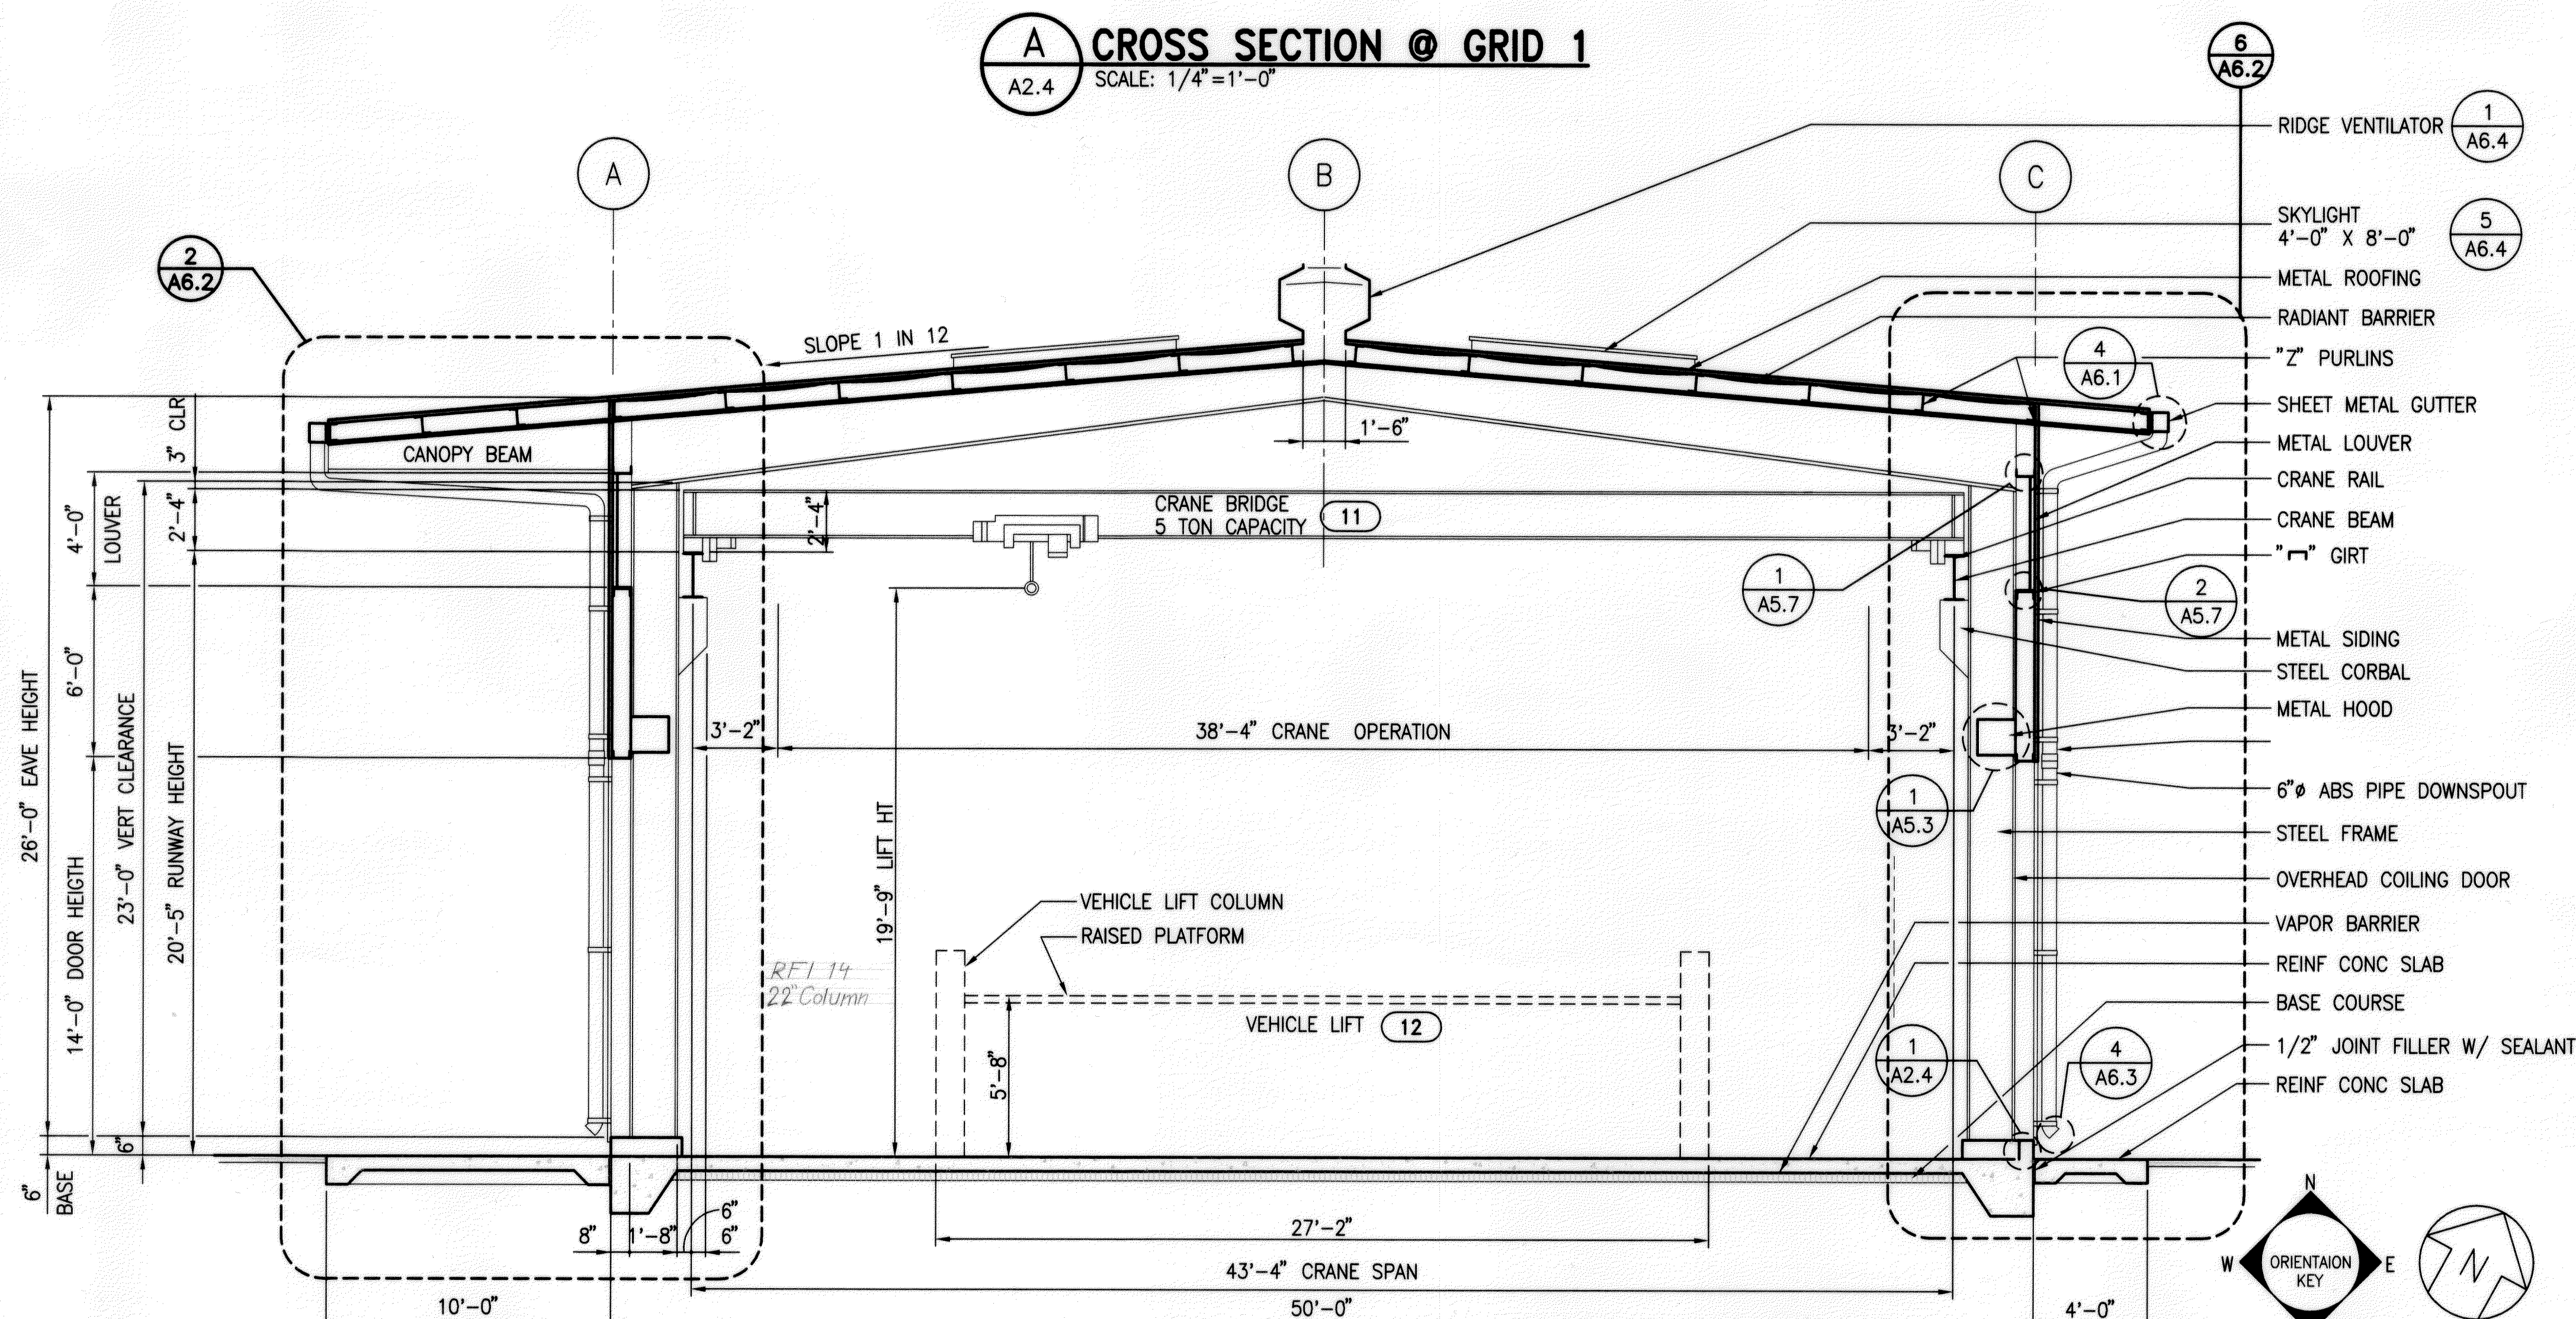
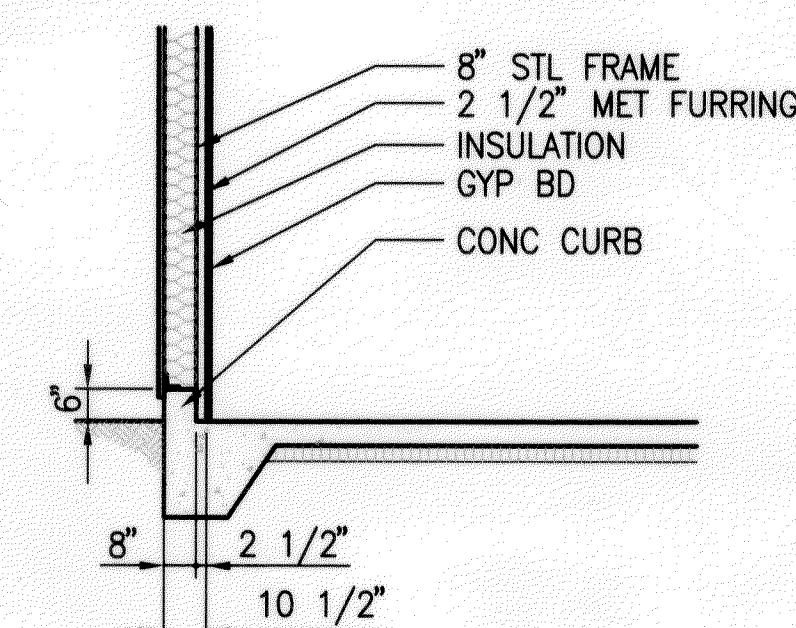


| FED. ROAD DIST. NO. | STATE | PROJ. NO.   | FISCAL YEAR | SHEET NO. | TOTAL SHEETS |
|---------------------|-------|-------------|-------------|-----------|--------------|
| HAWAII              | HAW.  | HWY-M-05-98 | 2002        | 36        | 99           |

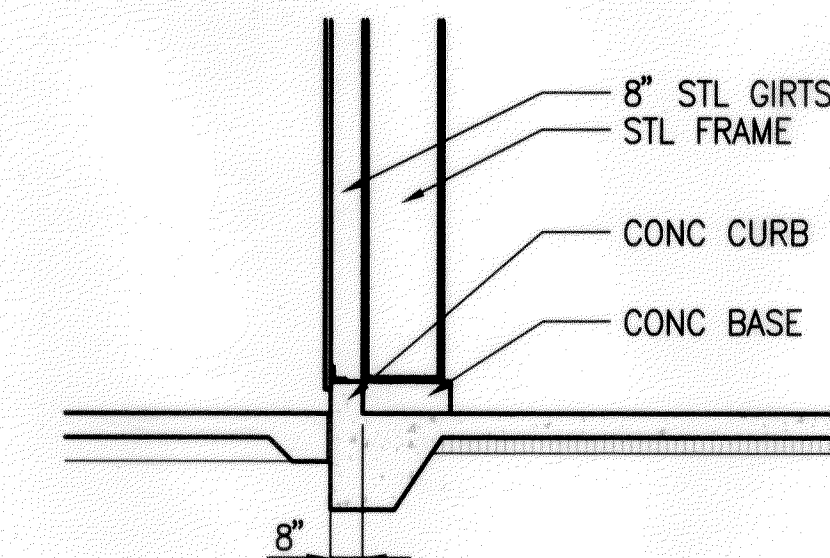



|                   |      |
|-------------------|------|
| SURVEY PLOTTED BY | DATE |
| DRAWN BY          |      |
| DESIGNED BY       |      |
| CHECKED BY        |      |
| ORIGINAL PLAN     |      |
| NOTEBOOK          |      |
| No.               |      |

03/23/00 M:\DWG\6143-01 ARCH  
 10:01  
 6143A19.DWG

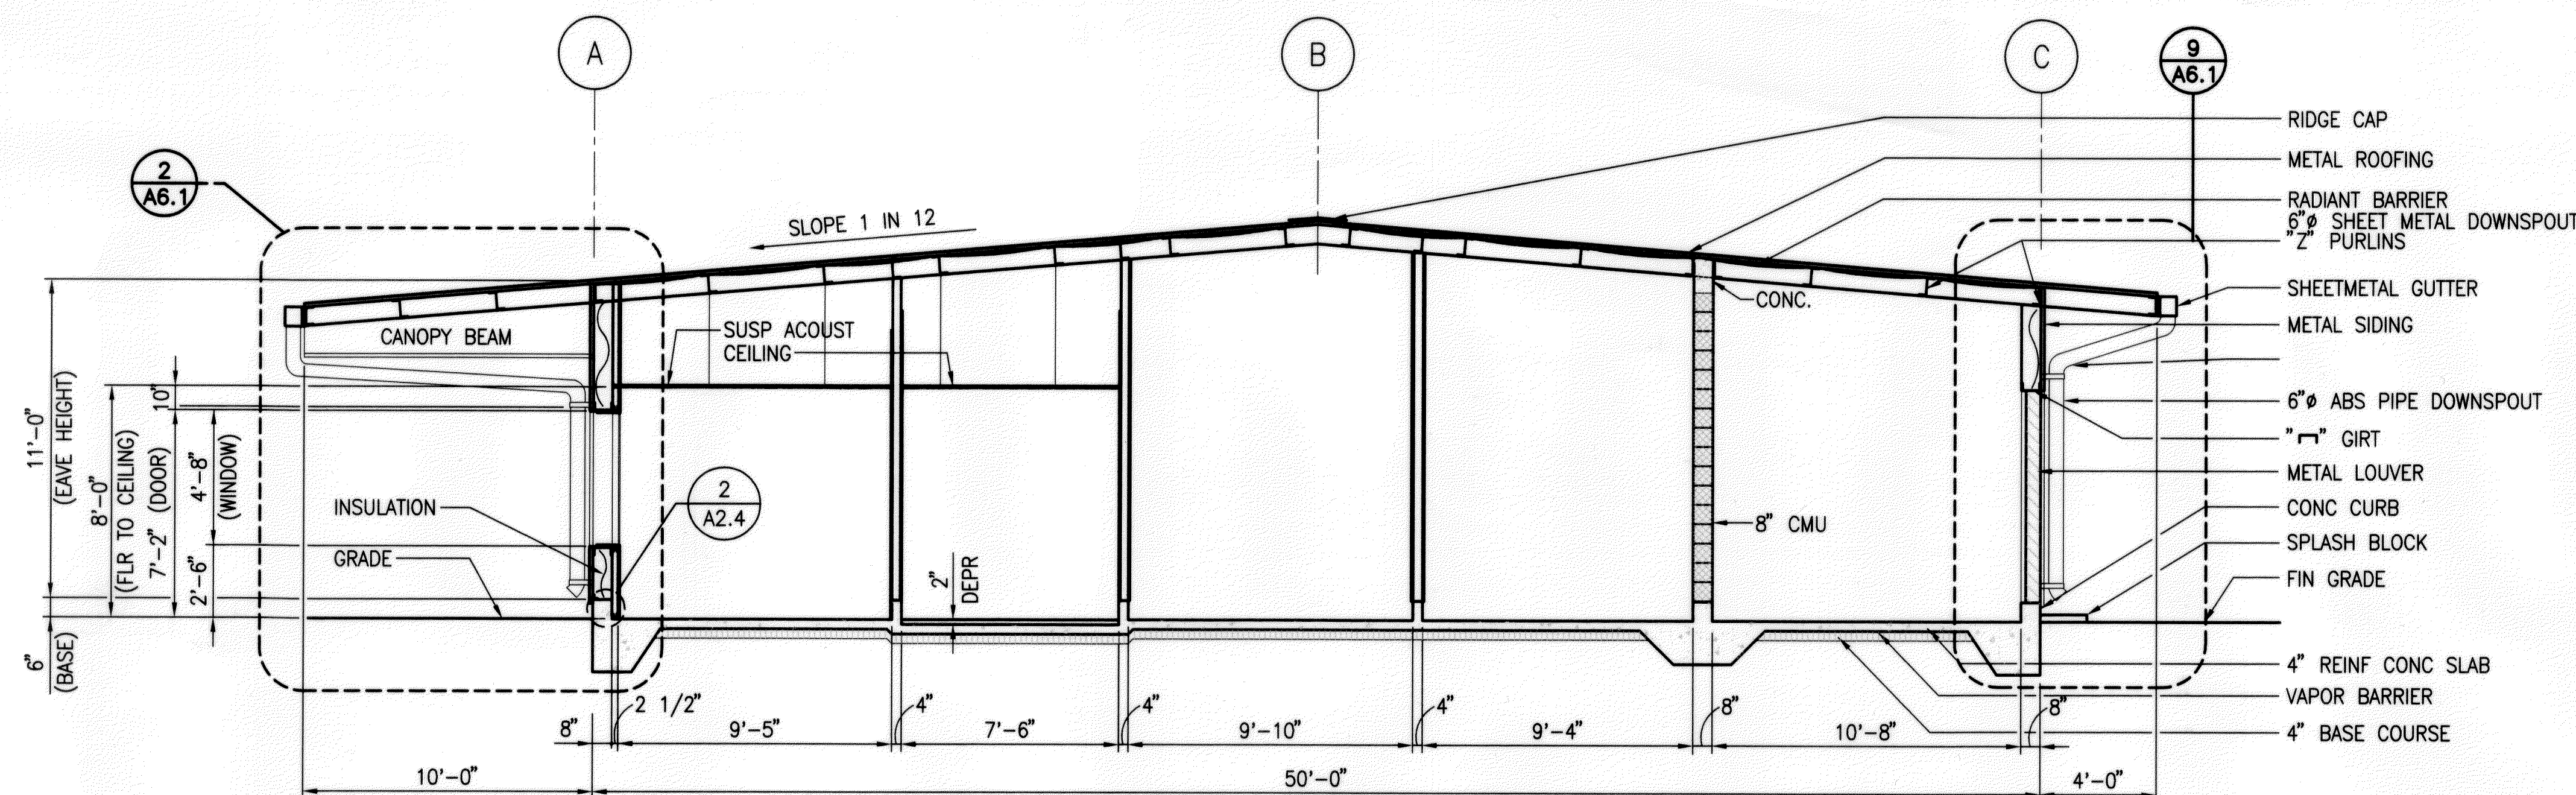

THIS WORK WAS PREPARED BY  
 ME OR UNDER MY SUPERVISION

*Walter Leu*

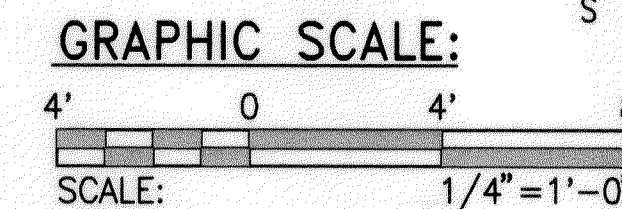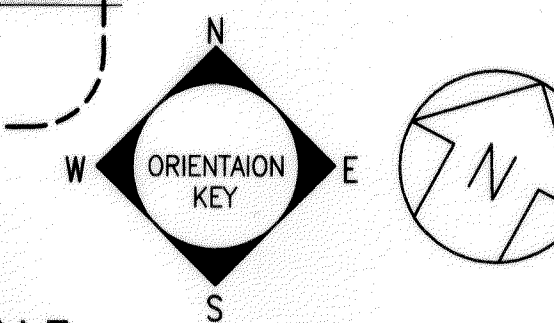

MAINTENANCE BUILDING

STATE OF HAWAII

DEPARTMENT OF TRANSPORTATION

HIGHWAYS DIVISION

CROSS SECTIONS

MOLOKAI BASEYARD

MOLOKAI INDUSTRIAL PARK

Project No. HWY-M-05-98

Scale: As Noted

Date: SEPT. 13, 2001

SHEET No. A2.4 OF A2.6 SHEETS

"AS-BUILT"