




FED. ROAD DIST. NO.	STATE	PROJ. NO.	FISCAL YEAR	SHEET NO.	TOTAL SHEETS
HAWAII	HAW.	HWY-M-05-98	2002	45	99

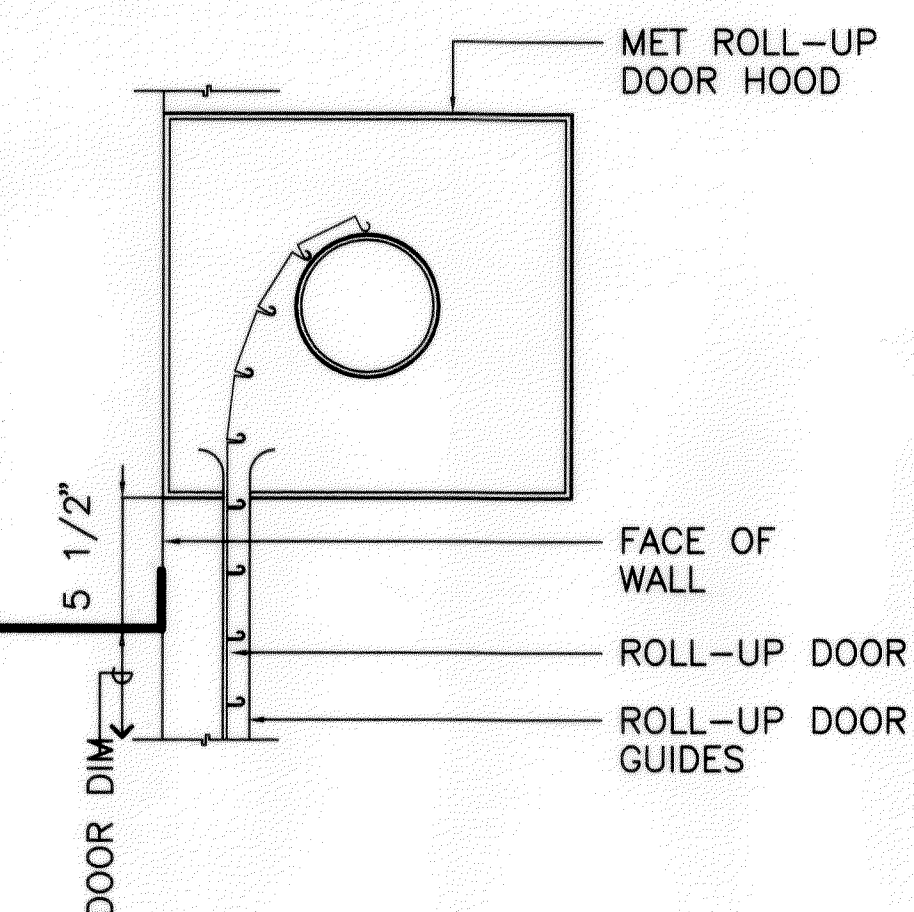


1 HEAD
A5.3 SCALE: 1 1/2"=1'-0"

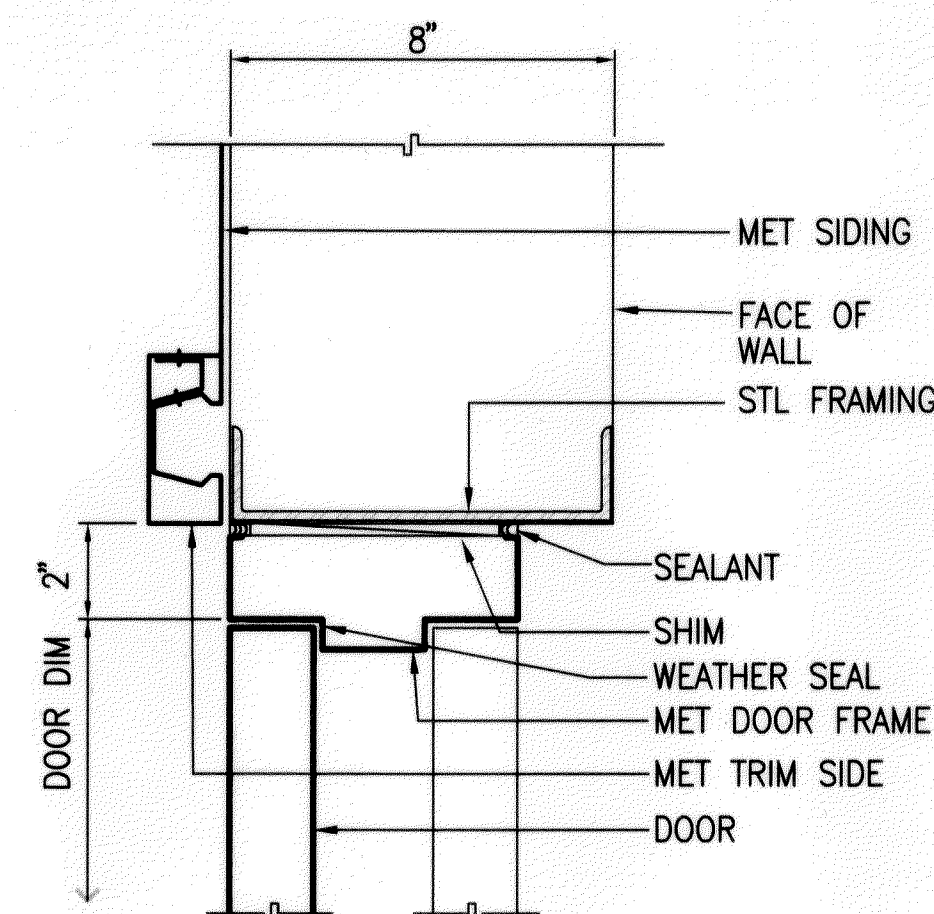


4 JAMB
A5.3 SCALE: 3"=1'-0"

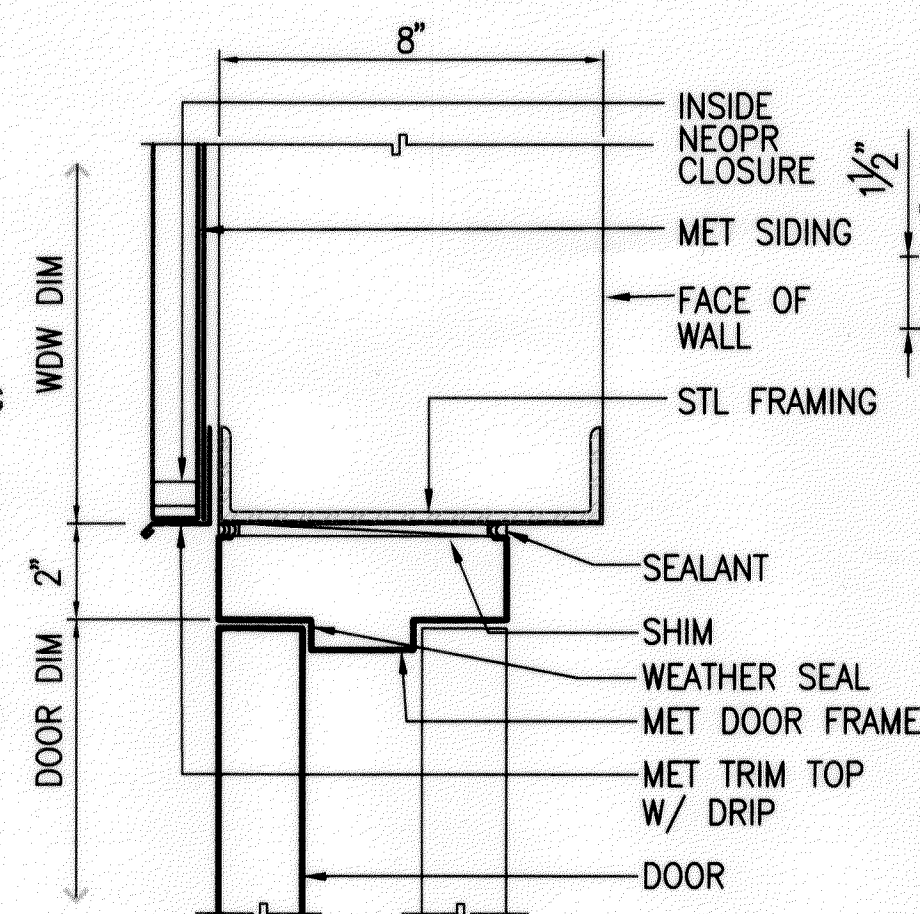


7 HEAD
A5.3 SCALE: 3"=1'-0"

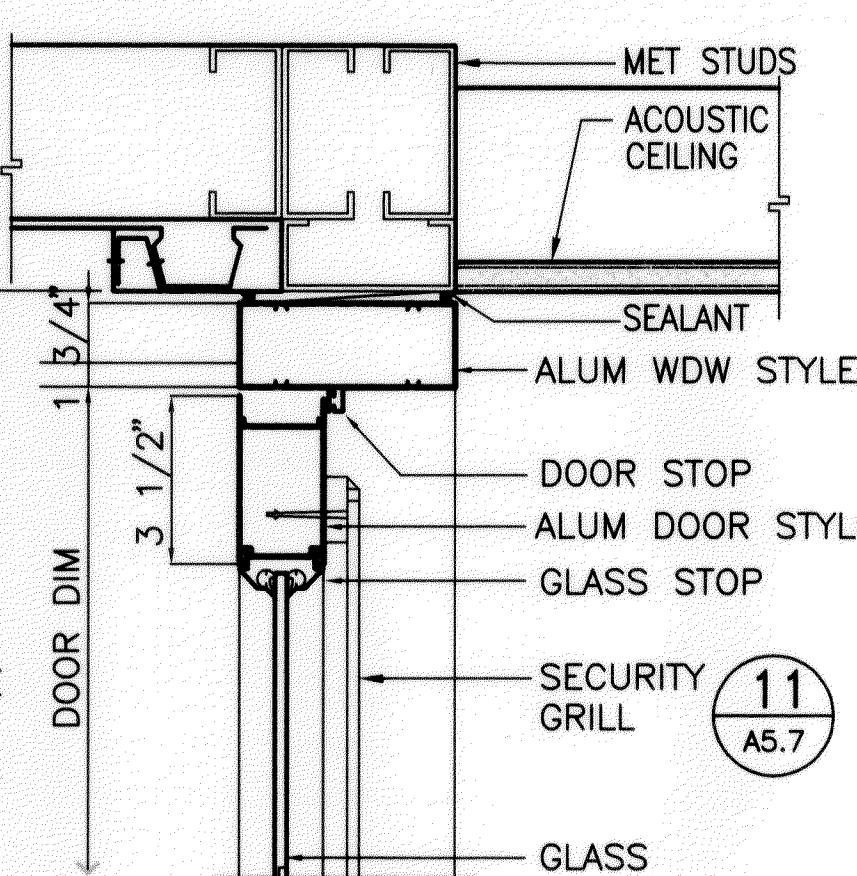


10 HEAD
A5.3 SCALE: 3"=1'-0"

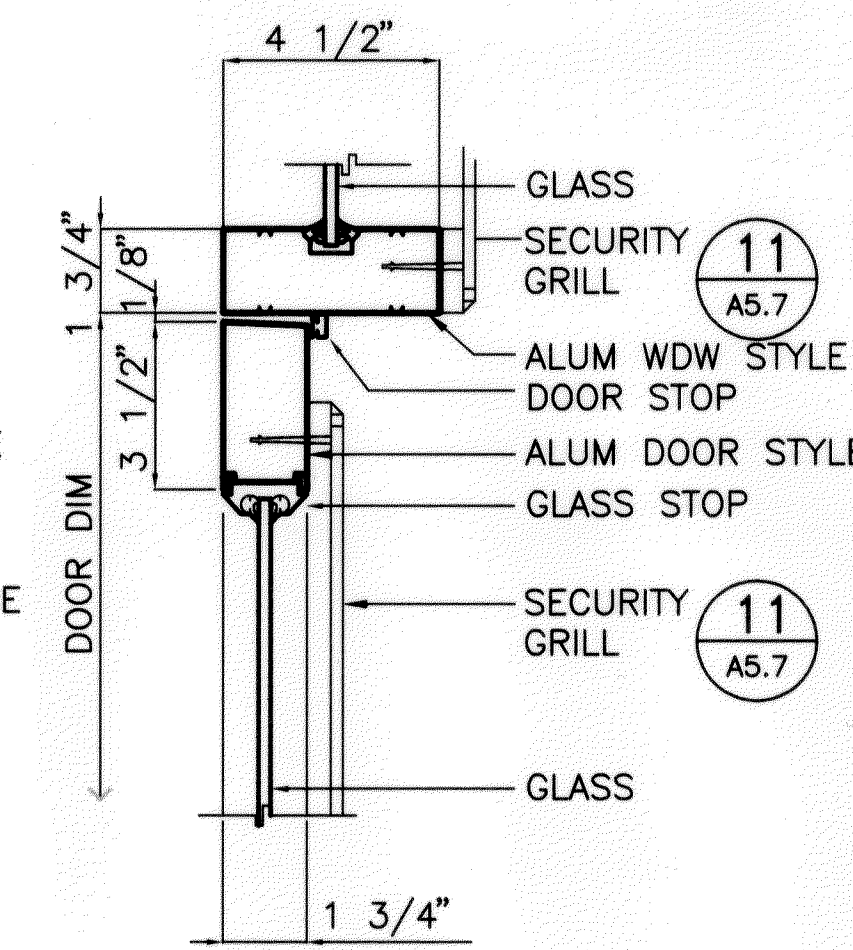


14 JAMB
A5.3 SCALE: 3"=1'-0"

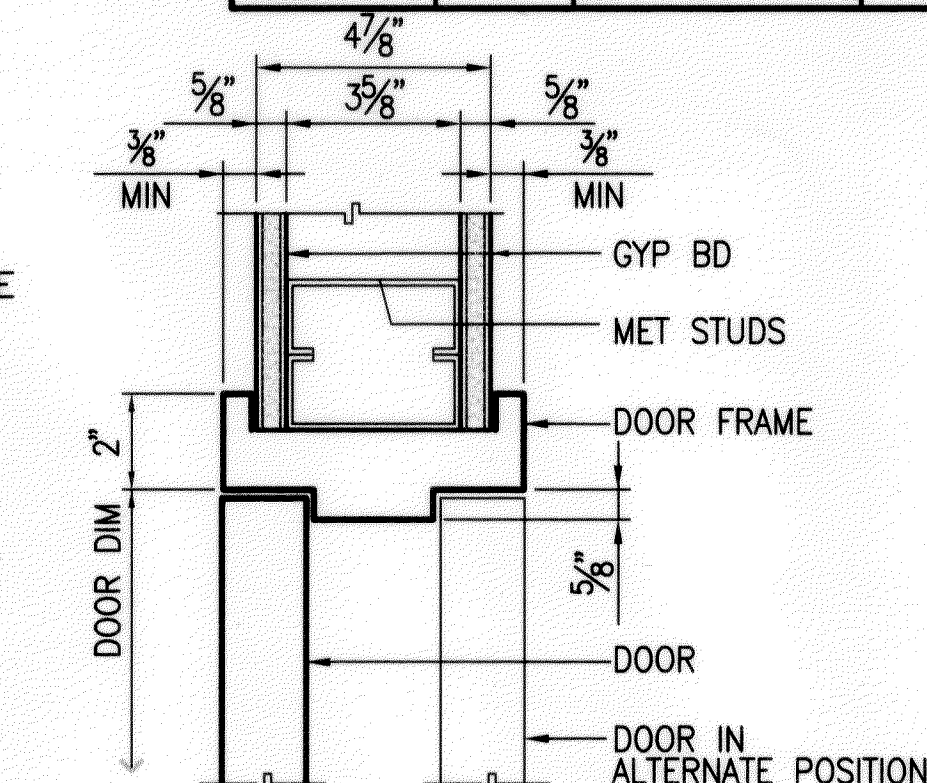


17 HEAD/JAMB
A5.3 SCALE: 3"=1'-0"

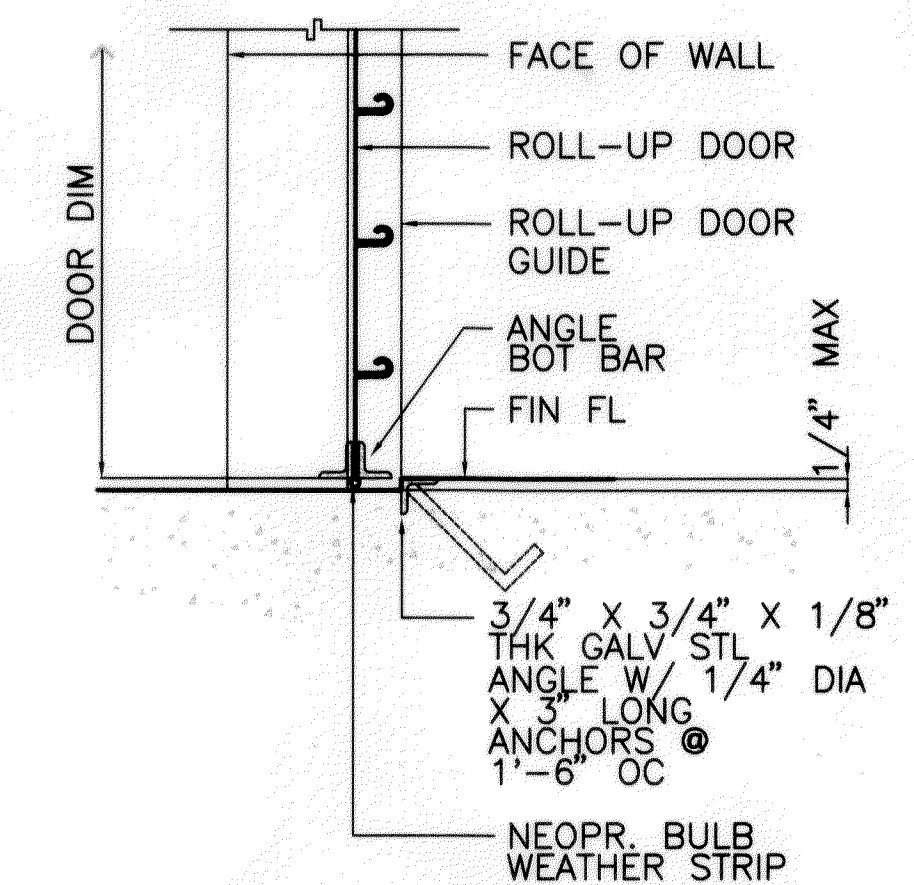


2 THRESHOLD
A5.3 SCALE: 3"=1'-0"

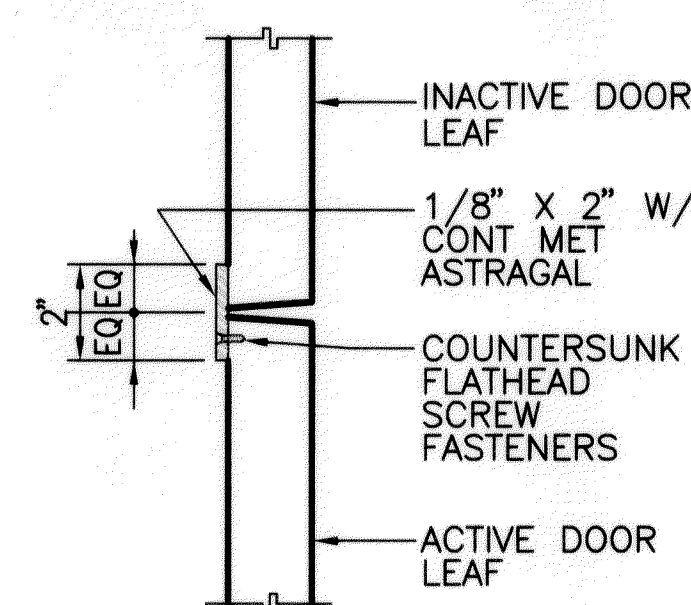


5 ASTRAGAL
A5.3 SCALE: 3"=1'-0"

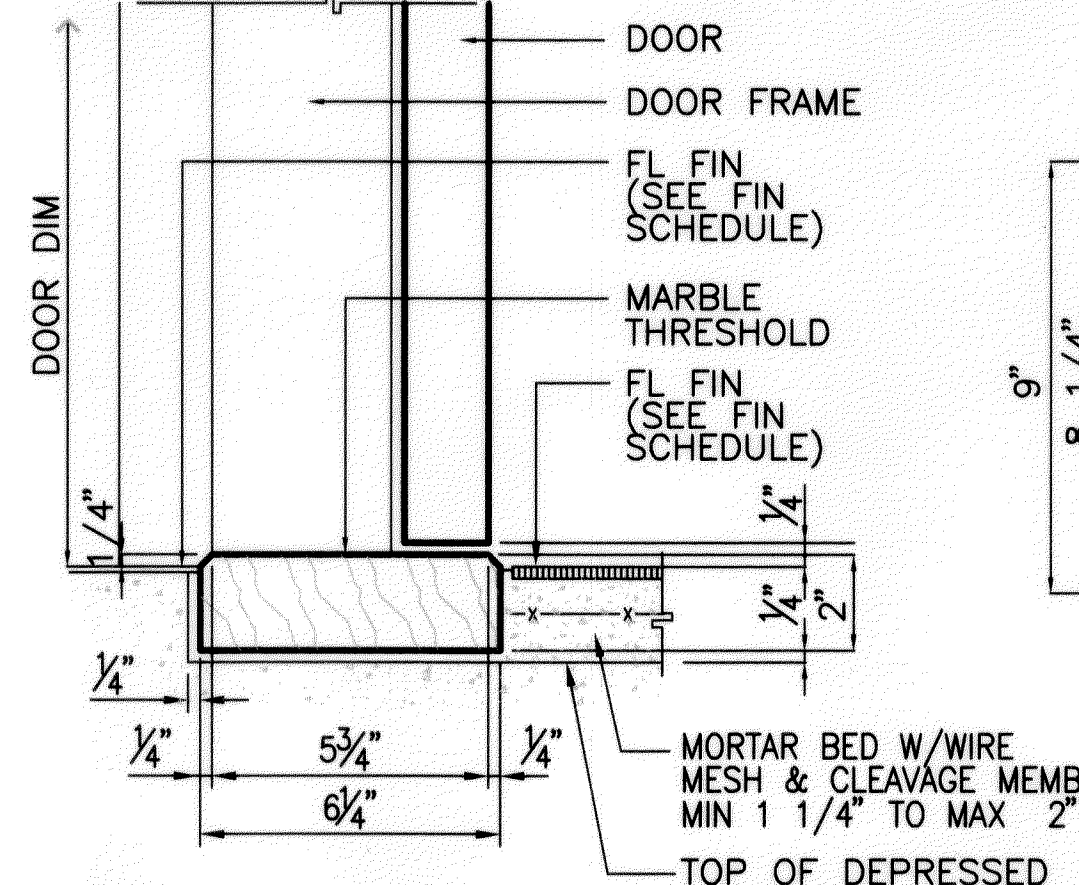


8 THRESHOLD
A5.3 SCALE: 3"=1'-0"

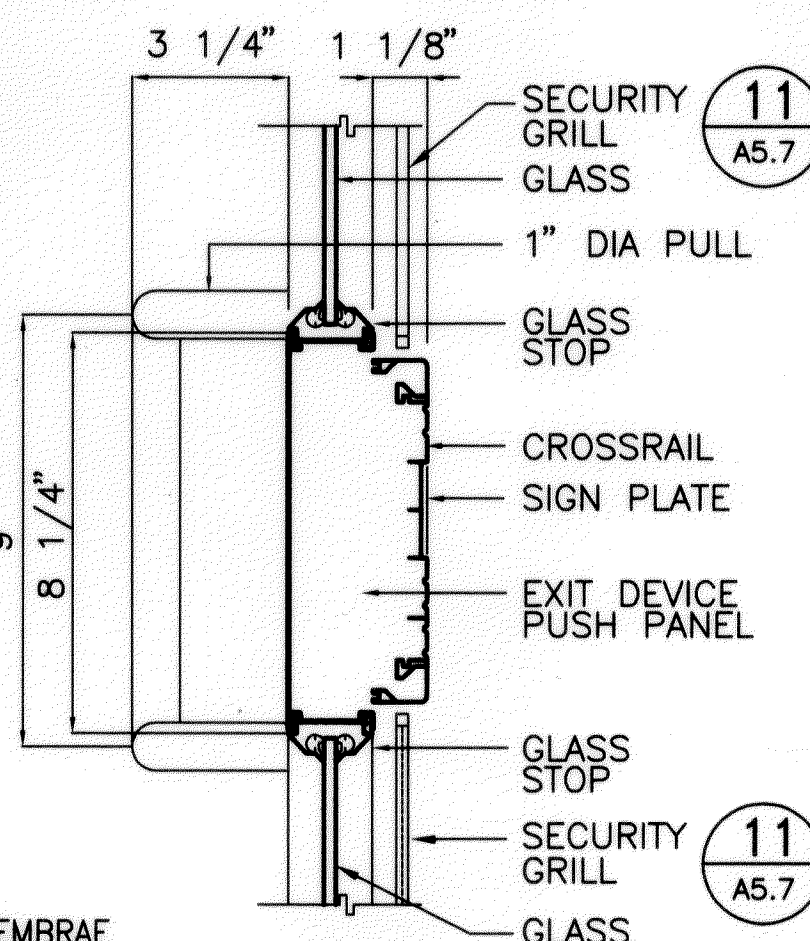

11 CROSS RAIL
A5.3 SCALE: 3"=1'-0"



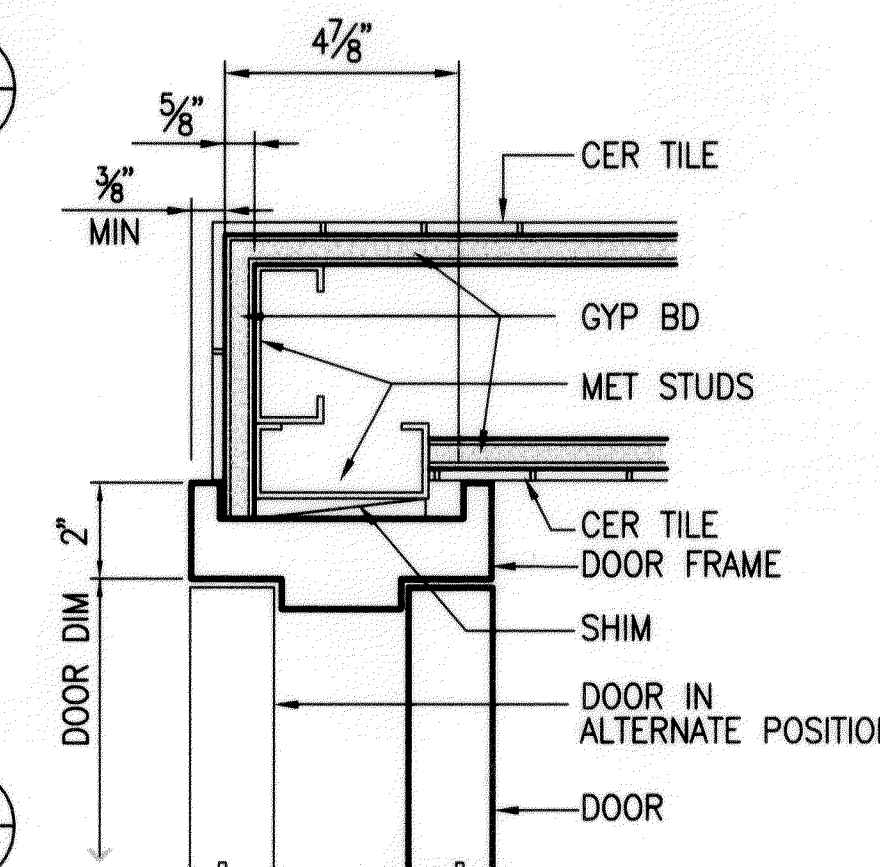


15 JAMB
A5.3 SCALE: 3"=1'-0"

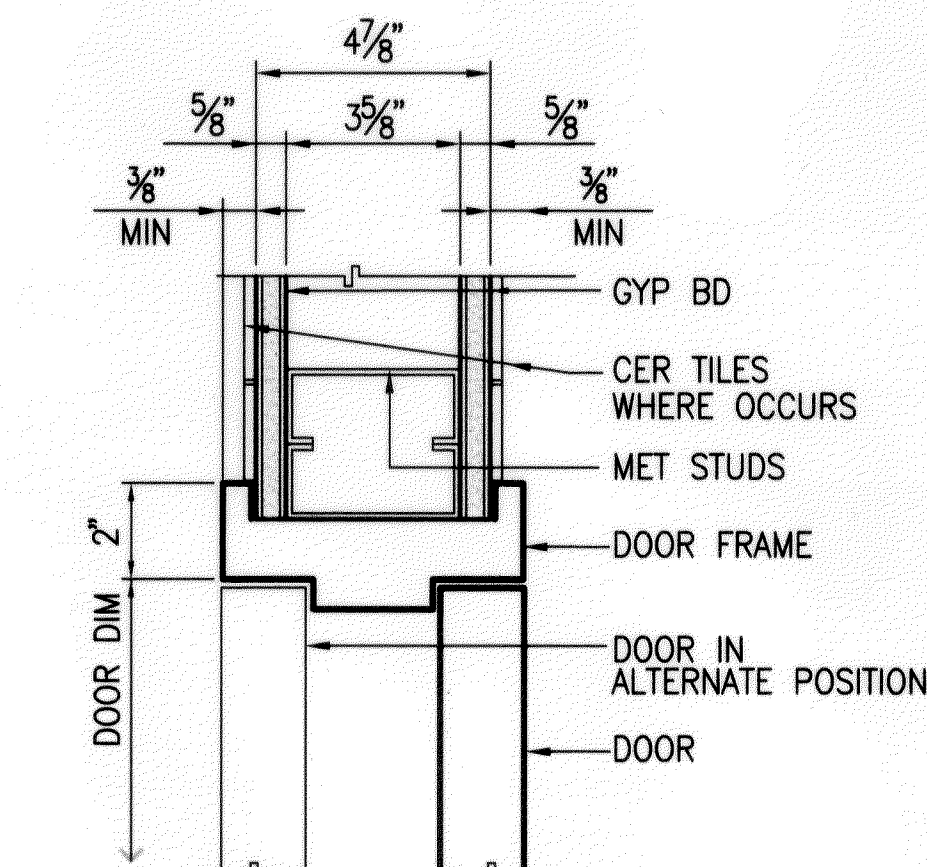


18 HEAD/JAMB
A5.3 SCALE: 3"=1'-0"


GRAPHIC SCALES:

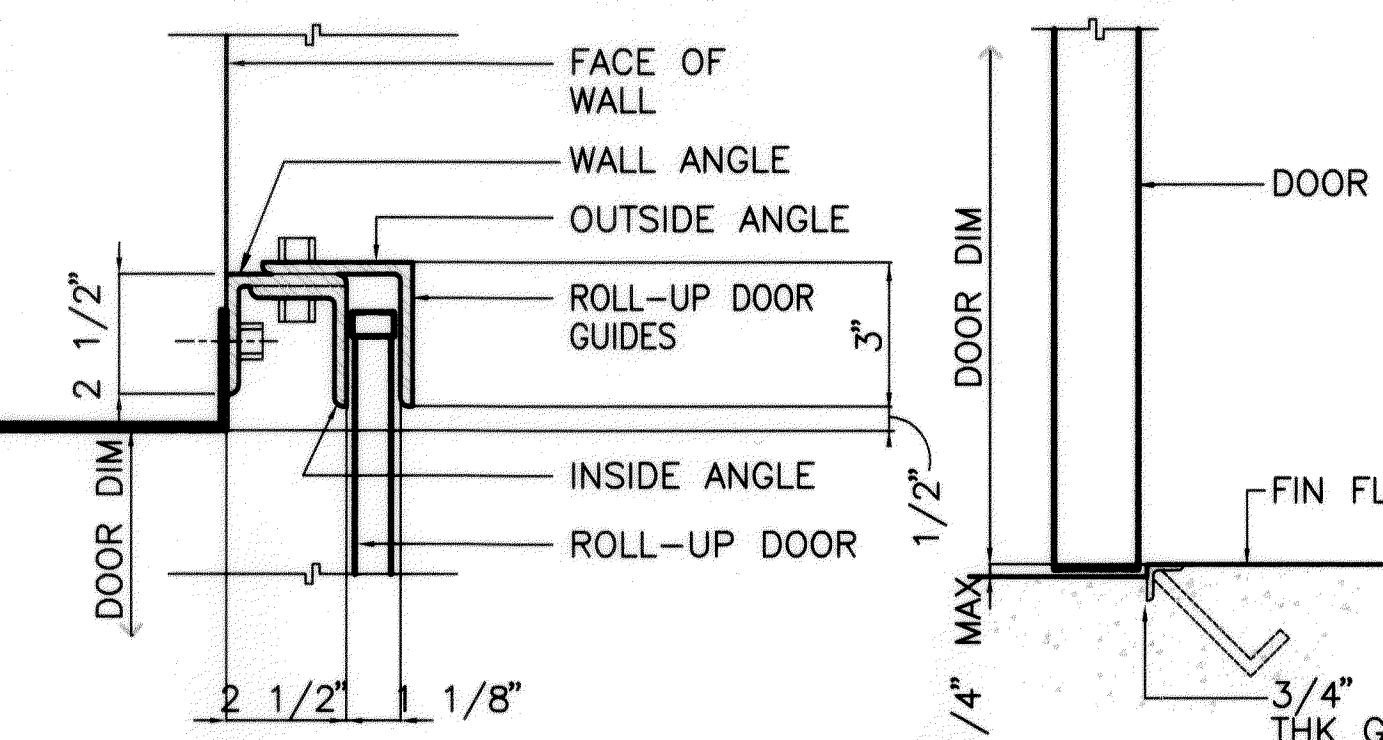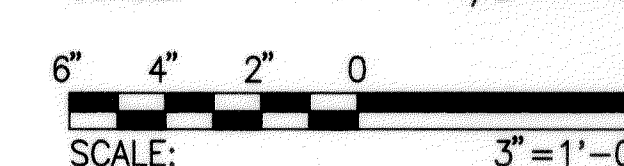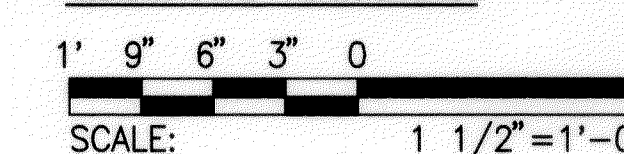


3 JAMB
A5.3 SCALE: 3"=1'-0"

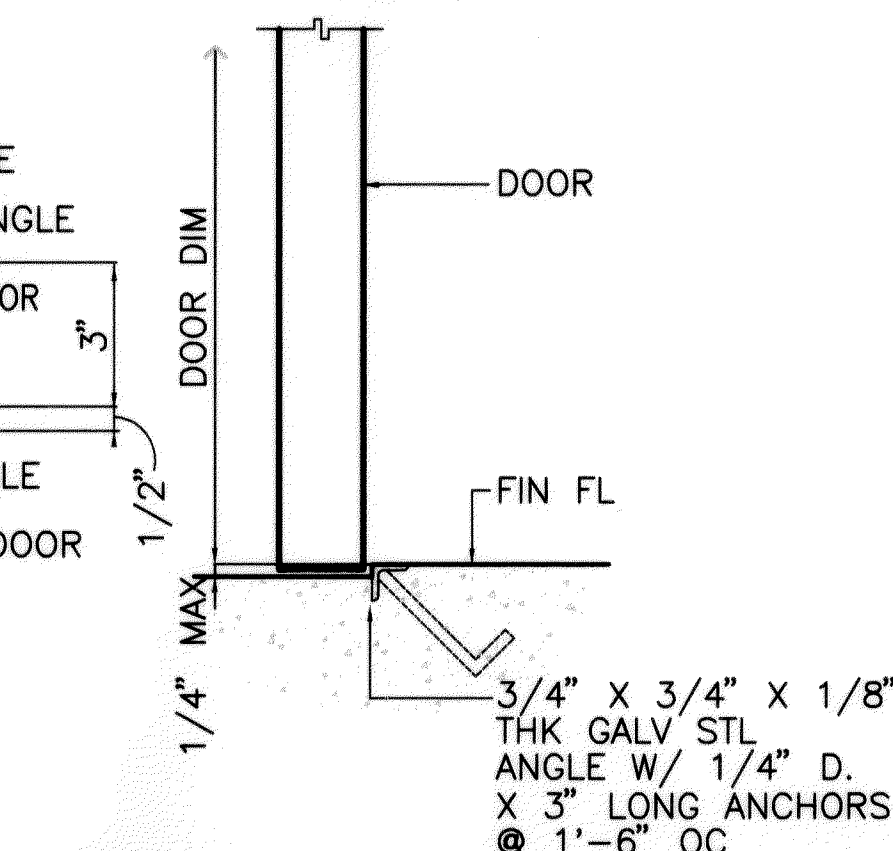


6 THRESHOLD
A5.3 SCALE: 3"=1'-0"

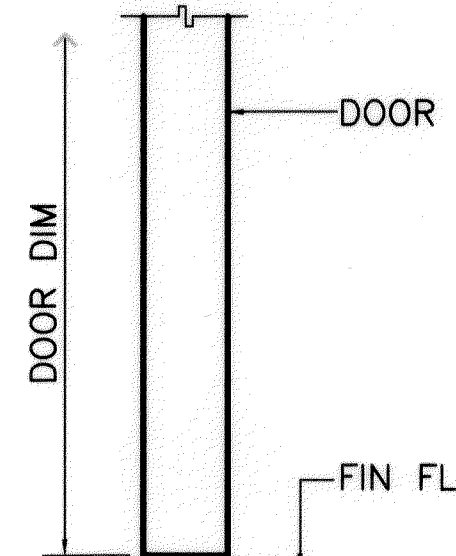


9 THRESHOLD
A5.3 SCALE: 3"=1'-0"

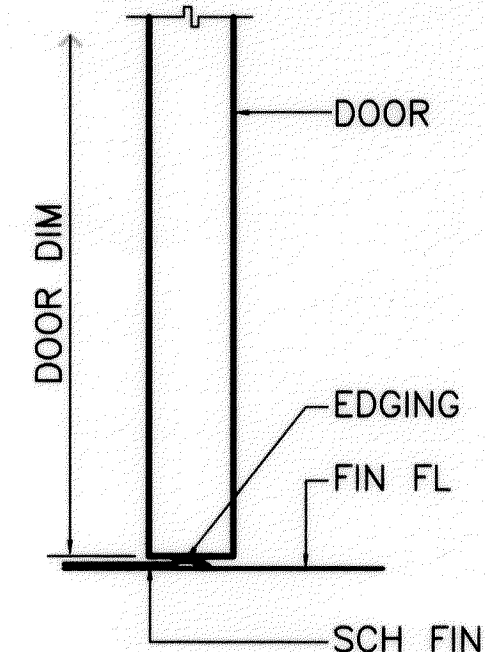

12 THRESHOLD
A5.3 SCALE: 3"=1'-0"

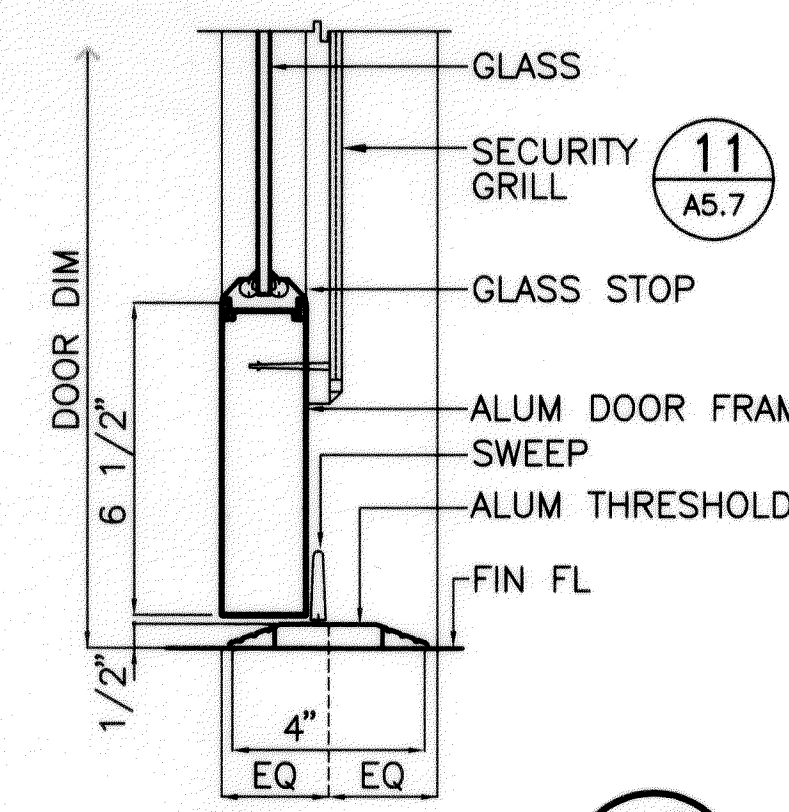

13 THRESHOLD
A5.3 SCALE: 3"=1'-0"

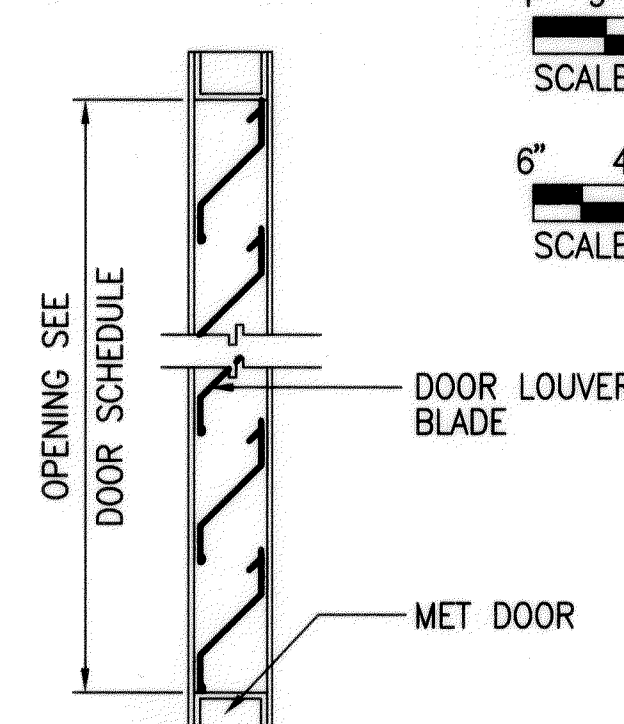

16 MET DOOR LOUVER
A5.3 SCALE: 3"=1'-0"

THIS WORK WAS PREPARED BY ME OR UNDER MY SUPERVISION

Walter Leu



COMMON SCHEDULES

STATE OF HAWAII
DEPARTMENT OF TRANSPORTATION
HIGHWAYS DIVISION
DOOR DETAILS




MOLOKAI BASEYARD
MOLOKAI INDUSTRIAL PARK
Project No. HWY-M-05-98

Scale: As Noted Date: SEPT. 13, 2001


SHEET No. A5.3 OF A5.8 SHEETS

SURVEY PLOTTED BY	DATE
DESIGNED BY	
QUANTITIES BY	
CHECKED BY	
61.4.3A.35.DWG	04/03/00 DOORIVE
08:57	


FED. ROAD DIST. NO.	STATE	PROJ. NO.	FISCAL YEAR	SHEET NO.	TOTAL SHEETS
HAWAII	HAW.	HWY-M-05-98	2002	46	99

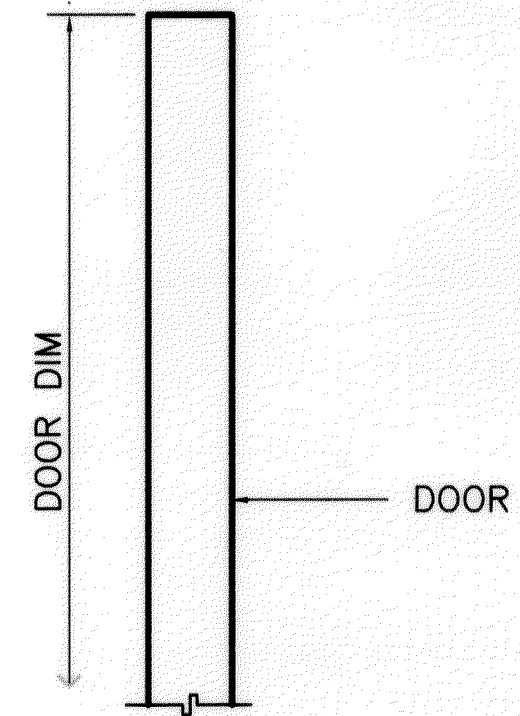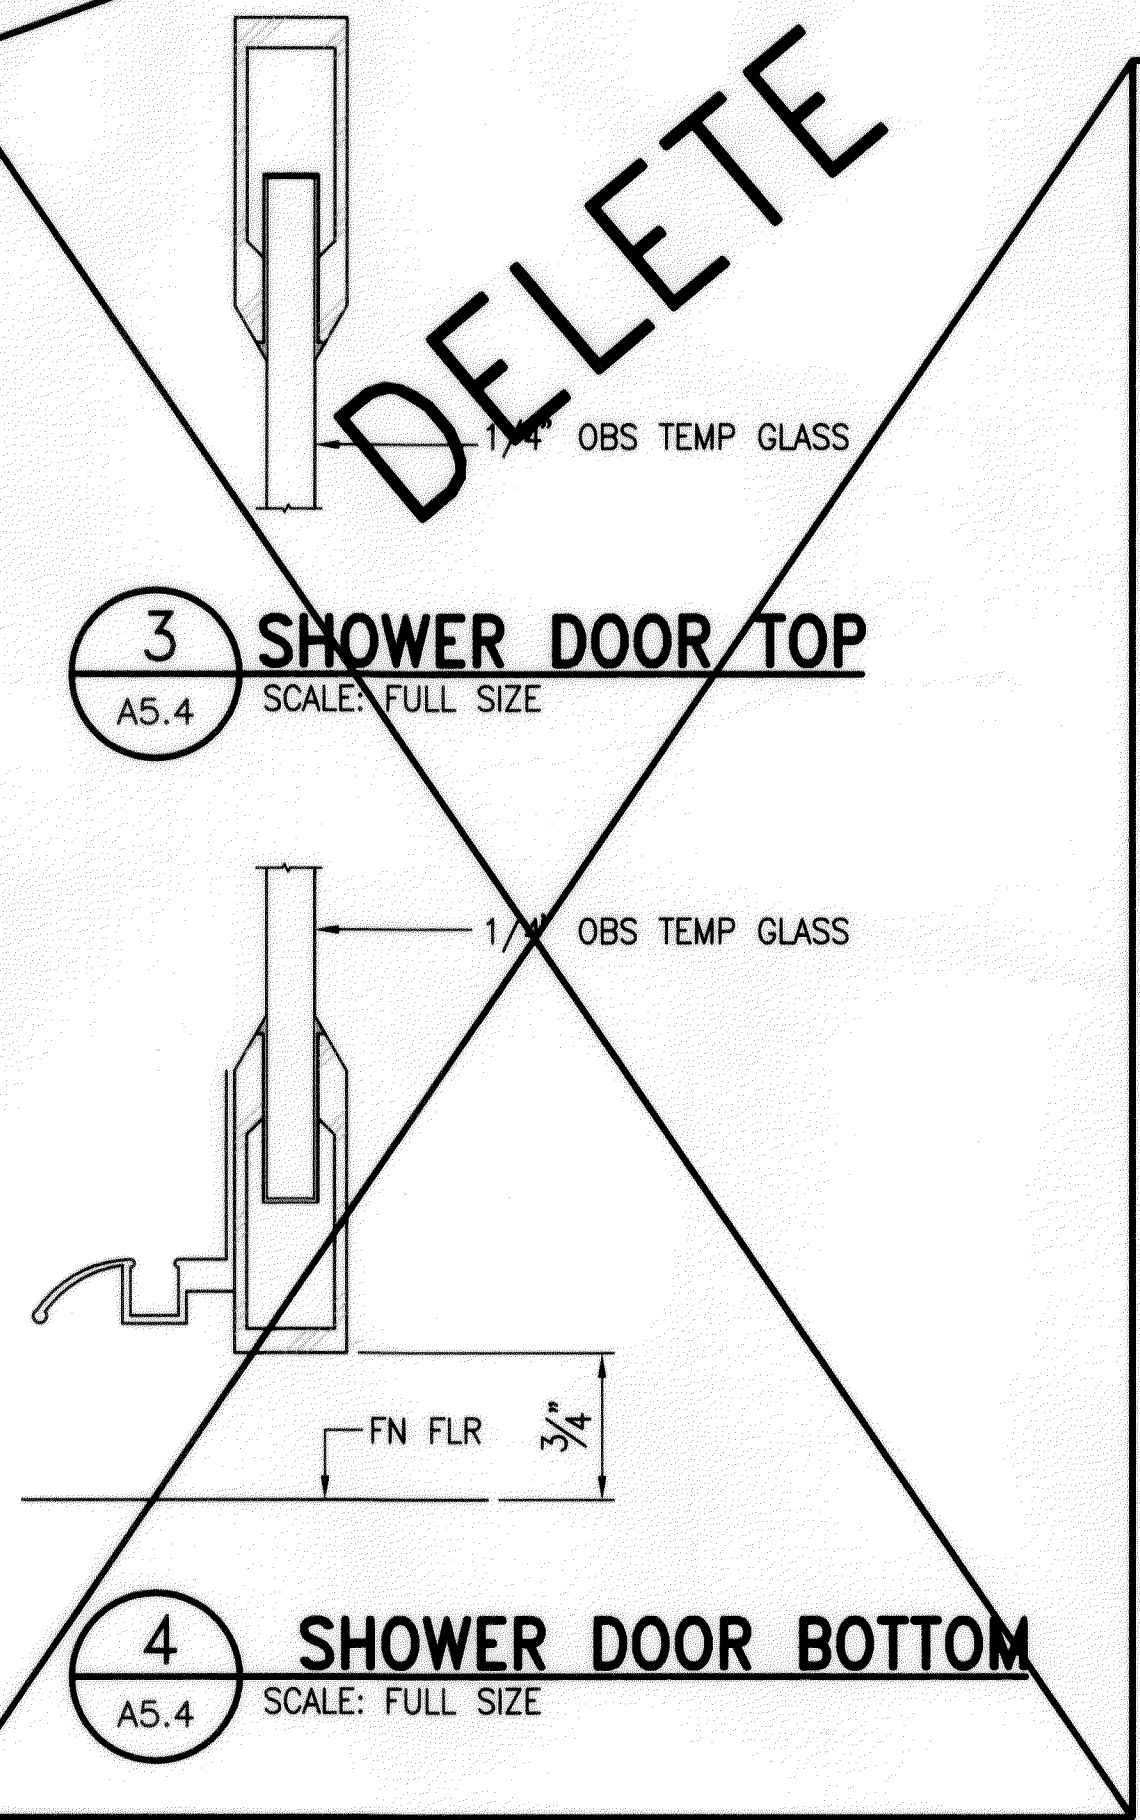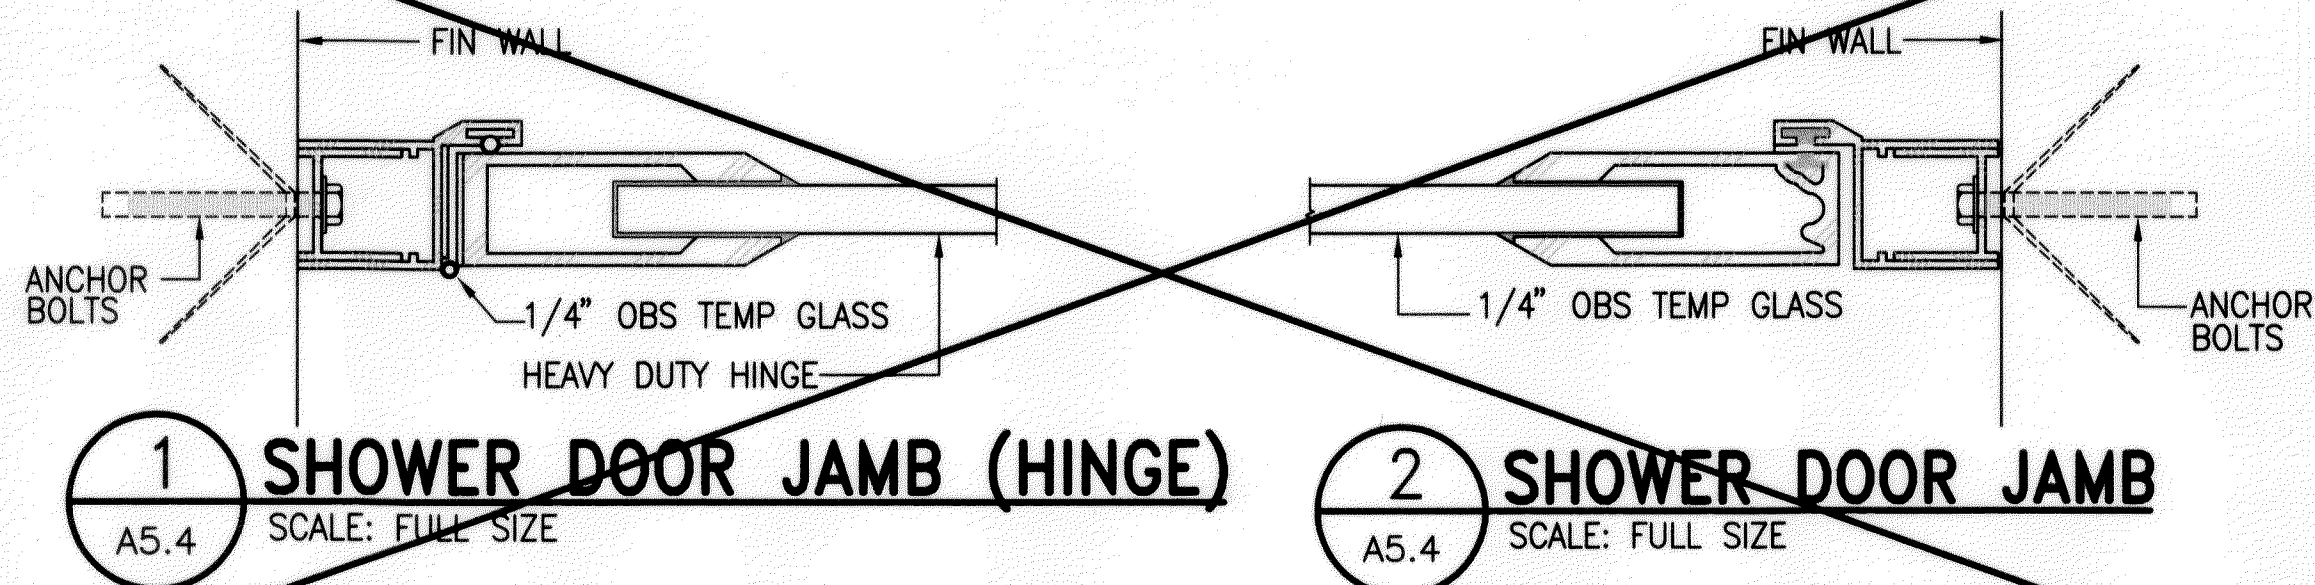


5 HEAD
A5.4 SCALE: 3"=1'-0"

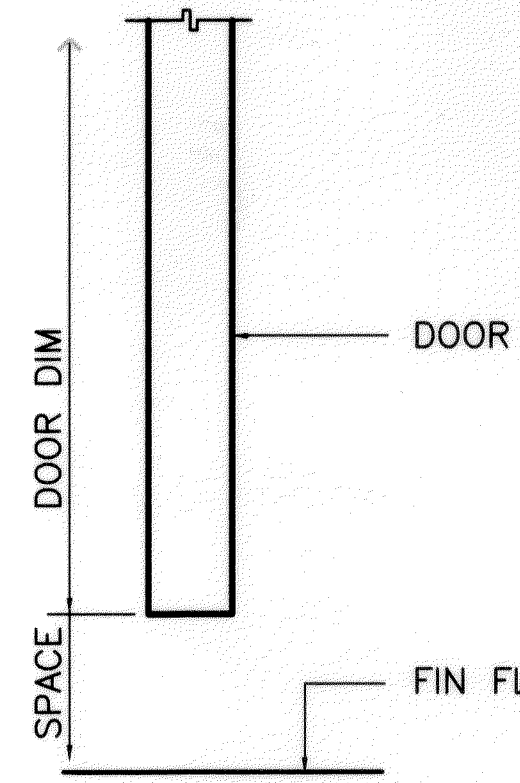


6 THRESHOLD
A5.4 SCALE: 3"=1'-0"

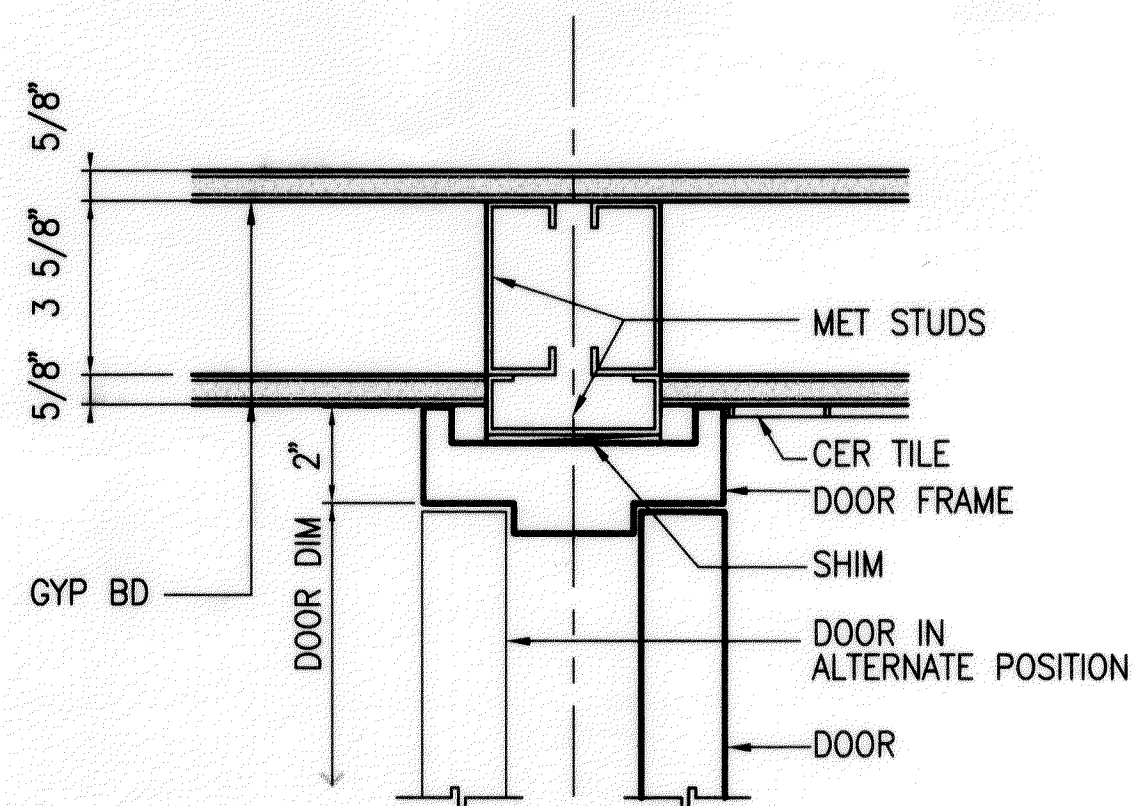

7 JAMB
A5.4 SCALE: 3"=1'-0"

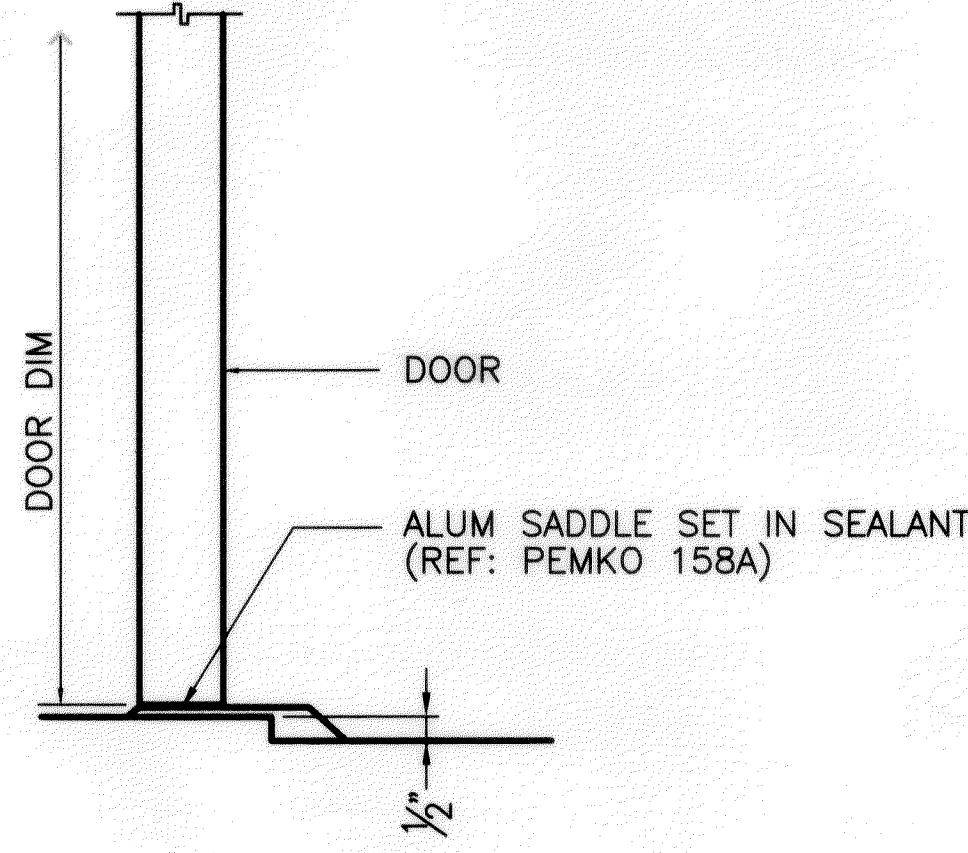

8 THRESHOLD
A5.4 SCALE: 3"=1'-0"

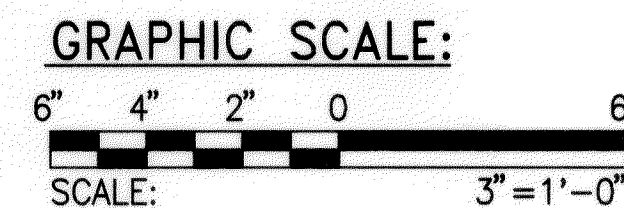

THIS WORK WAS PREPARED BY
ME OR UNDER MY SUPERVISION
Walter Leu

COMMON SCHEDULES

STATE OF HAWAII
DEPARTMENT OF TRANSPORTATION
HIGHWAYS DIVISION
DOOR DETAILS

MOLOKAI BASEYARD
MOLOKAI INDUSTRIAL PARK
Project No. HWY-M-05-98
Scale: As Noted Date: SEPT. 13, 2001
SHEET No. A5.4 OF A5.8 SHEETS

SURVEY PLOTTED BY	DATE
DRAWN BY	
DESIGNED BY	
QUANTITIES BY	
CHECKED BY	

6143A34.DWG 04/03/00 M\6143-01\ARCH 08:56