
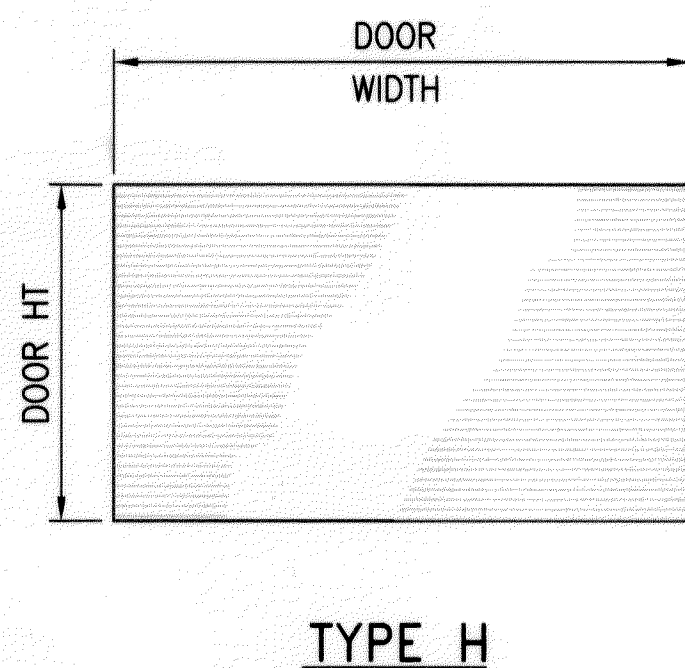
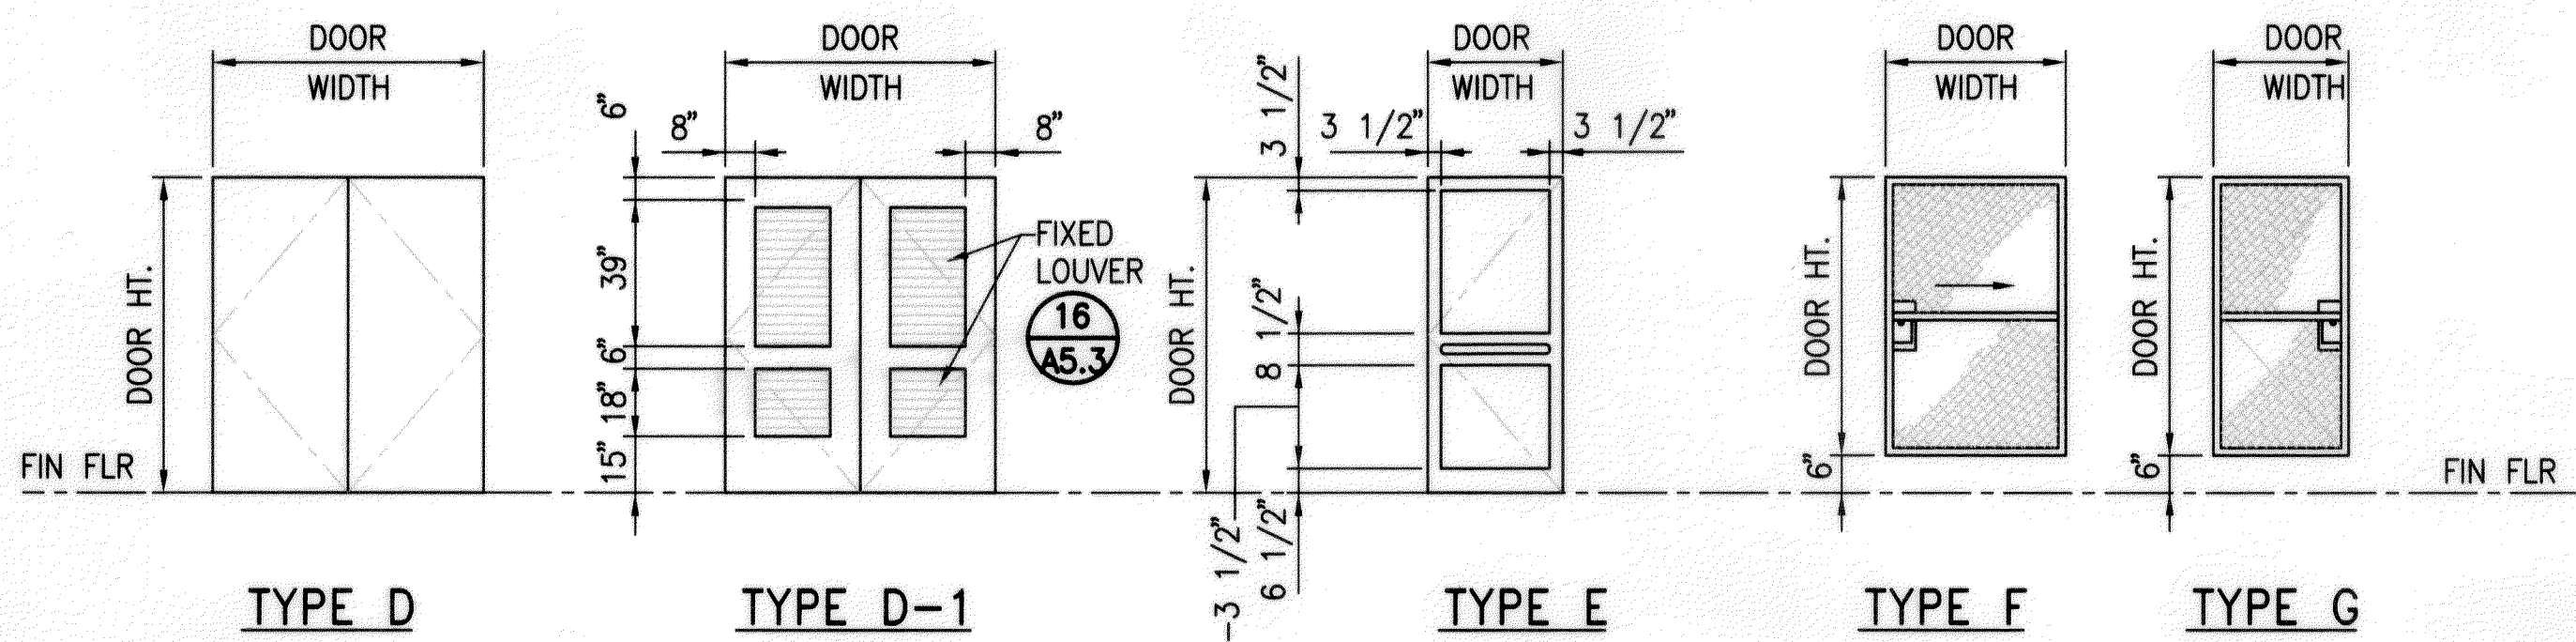


DOOR SCHEDULE														
	DOOR				FRAME									
BLDG.	NO.	SIZE (W X H)	TYPE	MATERIAL	MATERIAL	HEAD	JAMB	THRES.	TRANS.	GLASS	ASTRA.	HDW.	FIRE ASSEM.	REMARKS
OFFICE BUILDING	1	3'-0" x 7'-0"	E	AL	AL	10/A5.3	14/A5.3	13/A5.3	-	1/4" TINT TEMP	-	02	-	SEC GRILL
	2	3'-0" x 7'-0"	A-2	WD	STL	17/A5.3	17/A5.3	9/A5.3	-	1/4" TINT TEMP	-	08	-	
	3	3'-0" x 7'-0"	A-2	WD	STL	17/A5.3	17/A5.3	9/A5.3	-	1/4" TINT TEMP	-	08	-	
	4	3'-0" x 7'-0"	A-2	WD	STL	17/A5.3	17/A5.3	9/A5.3	-	1/4" TINT TEMP	-	08	-	
	5	3'-0" x 7'-0"	A-2	WD	STL	17/A5.3	18/A5.3	8/A5.3	-	1/4" TINT TEMP	-	09	-	OPP JAMB 7/A5.4
	6	3'-0" x 5'-0"	C	WD	STL	5/A5.4	15/A5.3	6/A5.4	-	-	-	10	-	
	7	3'-0" x 7'-0"	A	WD	STL	17/A5.3	17/A5.3	12/A5.3	-	-	-	11	-	
	8	3'-0" x 5'-0"	C	WD	STL	5/A5.4	15/A5.3	6/A5.4	-	-	-	10	-	
	9	3'-0" x 7'-0"	A-2	WD	STL	17/A5.3	18/A5.3	8/A5.3	-	1/4" TINT TEMP	-	09	-	OPP JAMB 7/A5.4
	10	3'-0" x 7'-0"	A	STL	STL	7/A5.3	4/A5.3	6/A5.3	-	-	-	07	-	
MAINTENANCE BUILDING	1	3'-0" x 7'-0"	A-1	STL	STL	7/A5.3	4/A5.3	6/A5.3	-	-	-	04	-	
	2	6'-0" x 7'-0"	D-1	STL	STL	7/A5.3	4/A5.3	6/A5.3	-	-	5/A5.3	03	-	
	3	14'-0" x 14'-0"	H	STL	STL	1/A5.3	3/A5.3	2/A5.3	-	-	-	01	-	
	4	14'-0" x 14'-0"	H	STL	STL	1/A5.3	3/A5.3	2/A5.3	-	-	-	01	-	
	5	14'-0" x 14'-0"	H	STL	STL	1/A5.3	3/A5.3	2/A5.3	-	-	-	01	-	
	6	14'-0" x 14'-0"	H	STL	STL	1/A5.3	3/A5.3	2/A5.3	-	-	-	01	-	
	7	3'-0" x 7'-0"	A	STL	STL	7/A5.3	4/A5.3	6/A5.3	-	-	-	07	-	
	8	3'-0" x 7'-0"	A	STL	STL	7/A5.3	4/A5.3	6/A5.3	-	-	-	07	-	
	9	14'-0" x 14'-0"	H	STL	STL	1/A5.3	3/A5.3	2/A5.3	-	-	-	01	-	
	10	14'-0" x 14'-0"	H	STL	STL	1/A5.3	3/A5.3	2/A5.3	-	-	-	01	-	
	11	14'-0" x 14'-0"	H	STL	STL	1/A5.3	3/A5.3	2/A5.3	-	-	-	01	-	
	12	14'-0" x 14'-0"	H	STL	STL	1/A5.3	3/A5.3	2/A5.3	-	-	-	01	-	
	13	3'-0" x 7'-0"	A	STL	STL	7/A5.3	4/A5.3	6/A5.3	-	-	-	07	-	
	14	3'-0" x 7'-0"	A	STL	STL	17/A5.3	17/A5.3	12/A5.3	-	-	-	08	-	
	15	3'-0" x 7'-0"	A	STL	STL	17/A5.3	18/A5.3	8/A5.3	-	-	-	10	-	
	16	3'-0" x 7'-0"	A	STL	STL	17/A5.3	17/A5.3	9/A5.3	-	-	-	11	-	
	17	3'-0" x 7'-0"	G	WIRE MESH	STL	3/A7.2	-	3/A7.2	-	-	-	12	-	PART OF WIRE MESH PARTITION
	18	4'-0" x 7'-0"	F	WIRE MESH	STL	1/A7.2	-	1/A7.2	-	-	-	12	-	PART OF WIRE MESH PARTITION
STORAGE BUILDING AND SHED	1	3'-0" x 7'-0"	A	STL	STL	7/A5.3	4/A5.3	6/A5.3	-	-	-	06	-	
	2	3'-0" x 7'-0"	A	STL	STL	7/A5.3	4/A5.3	6/A5.3	-	-	-	06	-	
	3	3'-0" x 7'-0"	A	STL	STL	7/A5.3	4/A5.3	8/A5.4	-	-	-	06	-	
	4	6'-0" x 7'-0"	D	STL	STL	7/A5.3	4/A5.3	6/A5.3	-	-	5/A5.3	05	-	

NOTE:
DOORS LOCKSETS TO HAVE EASY TO GRASP LATCH HANDLES WHERE REQUIRED FOR HANDICAP ACCESS. (SEE SPECIFICATIONS)

FED. ROAD DIST. NO.	STATE	PROJ. NO.	FISCAL YEAR	SHEET NO.	TOTAL SHEETS
HAWAII	HAW.	HWY-M-05-98	2002	44	99

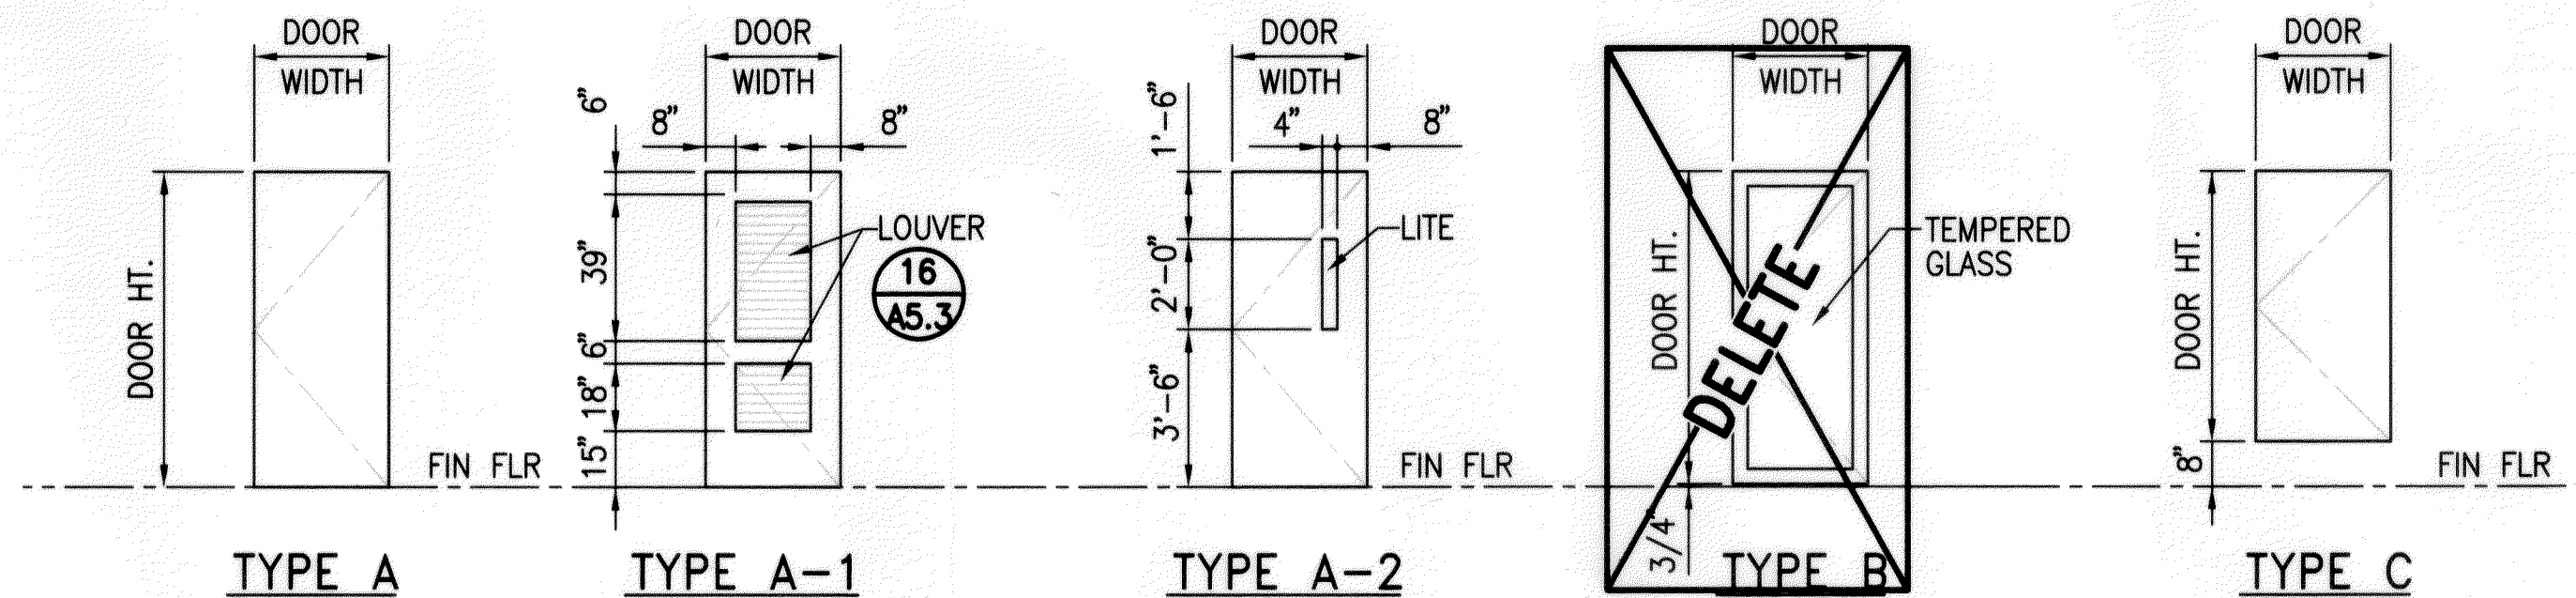

1 DOOR TYPE
A5.2 SCALE: 1/4" = 1'-0"



THIS WORK WAS PREPARED BY ME OR UNDER MY SUPERVISION

Walter L. Lu

GRAPHIC SCALE:
4' 0 4' 8'
SCALE: 1/4" = 1'-0"

COMMON SCHEDULES

STATE OF HAWAII
DEPARTMENT OF TRANSPORTATION
HIGHWAYS DIVISION

DOOR SCHEDULE & TYPES

MOLOKAI BASEYARD
MOLOKAI INDUSTRIAL PARK
Project No. HWY-M-05-98

Scale: As Noted Date: SEPT. 13, 2001

SHEET No. A5.2 OF A5.8 SHEETS