




FED. ROAD DIST. NO.	STATE	PROJ. NO.	FISCAL YEAR	SHEET NO.	TOTAL SHEETS
HAWAII	HAW.	HWY-M-05-98	2002	35	99

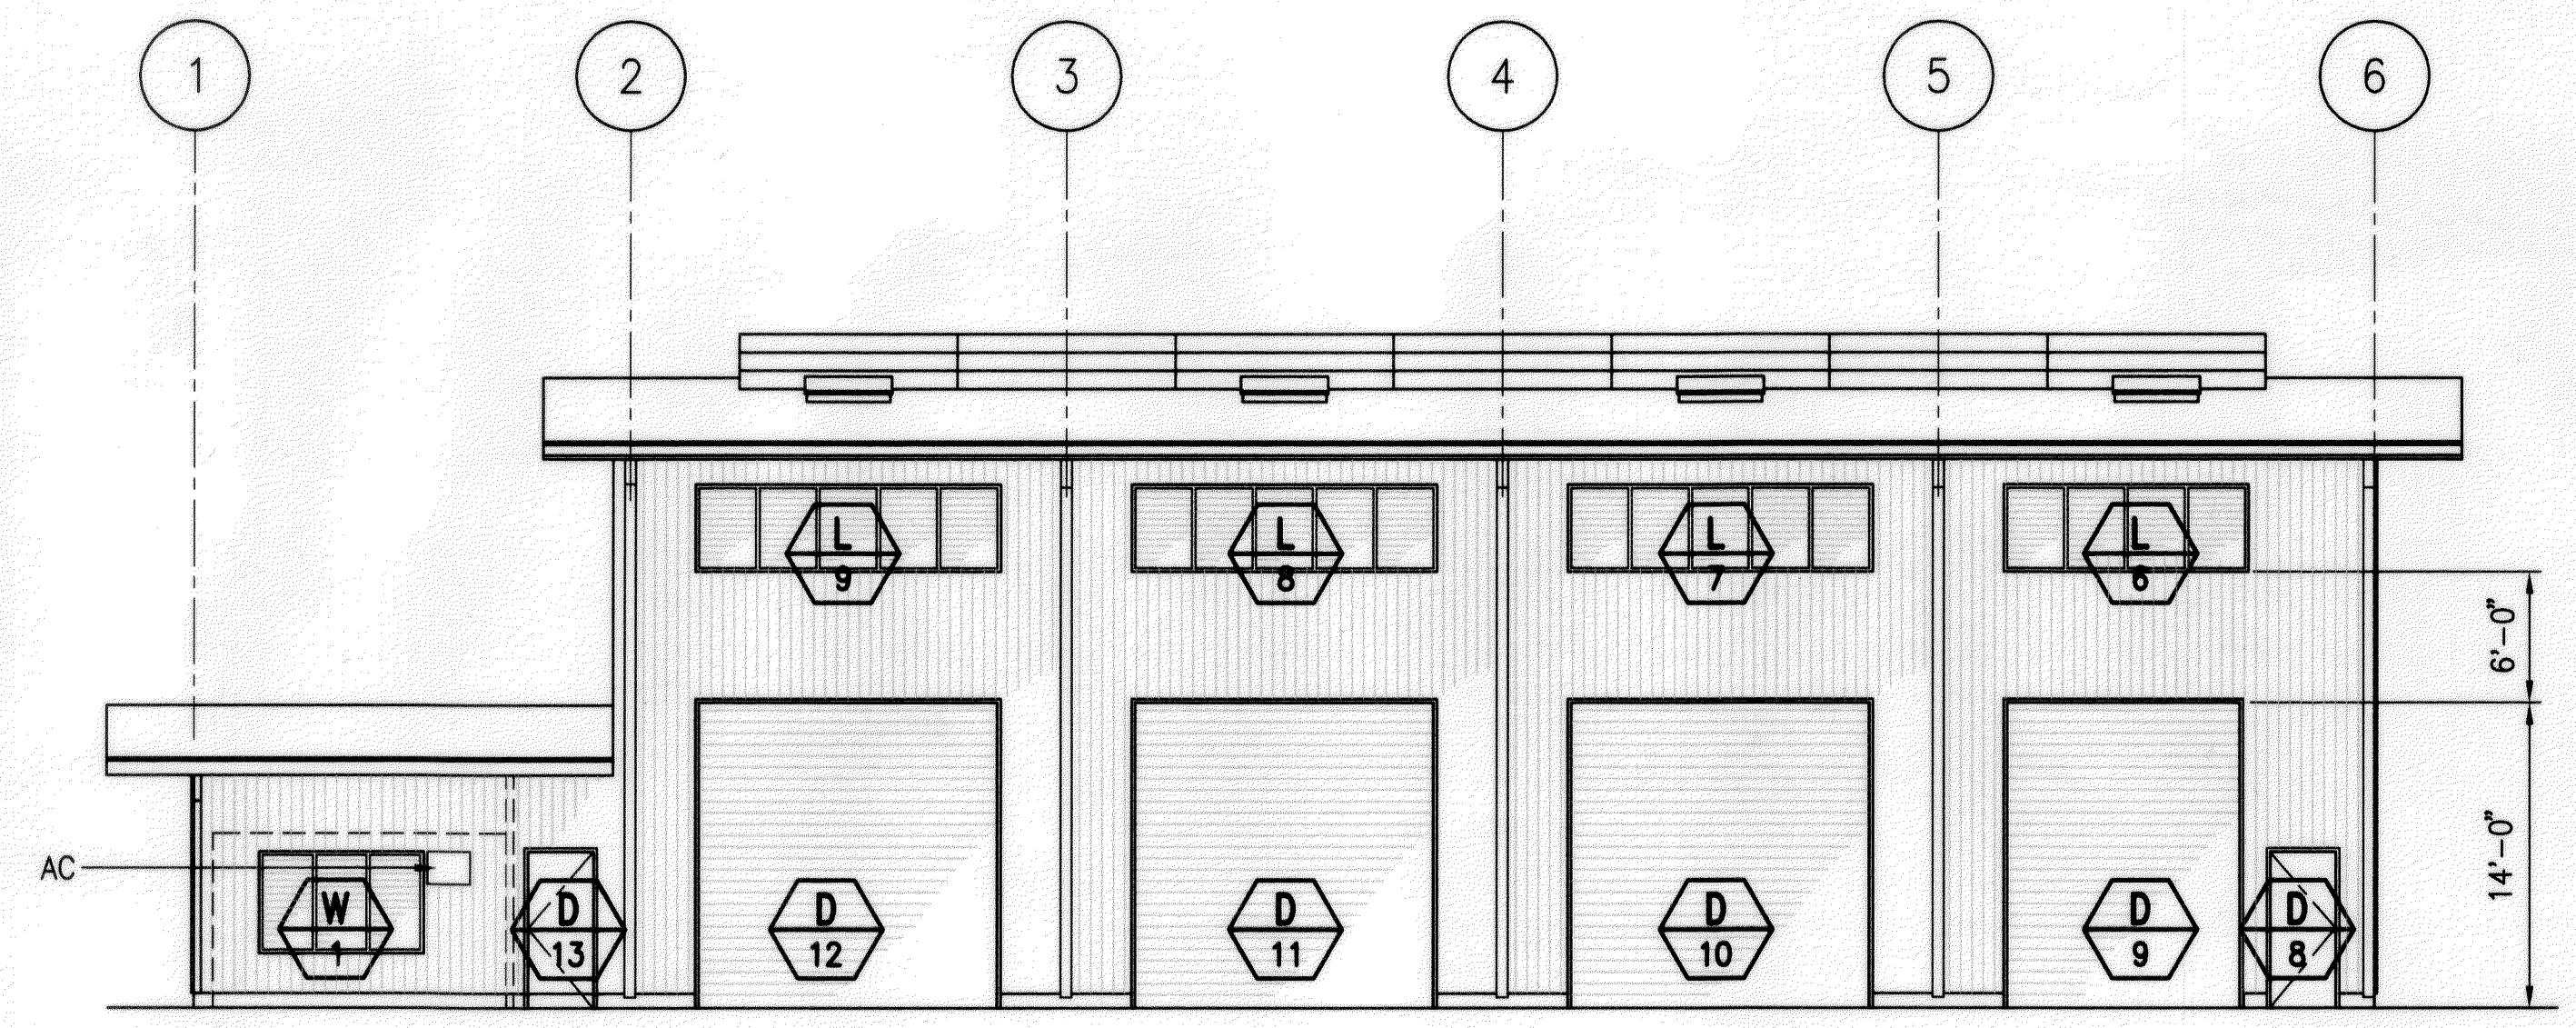


WEST ELEVATION
SCALE: 1/8"=1'-0"

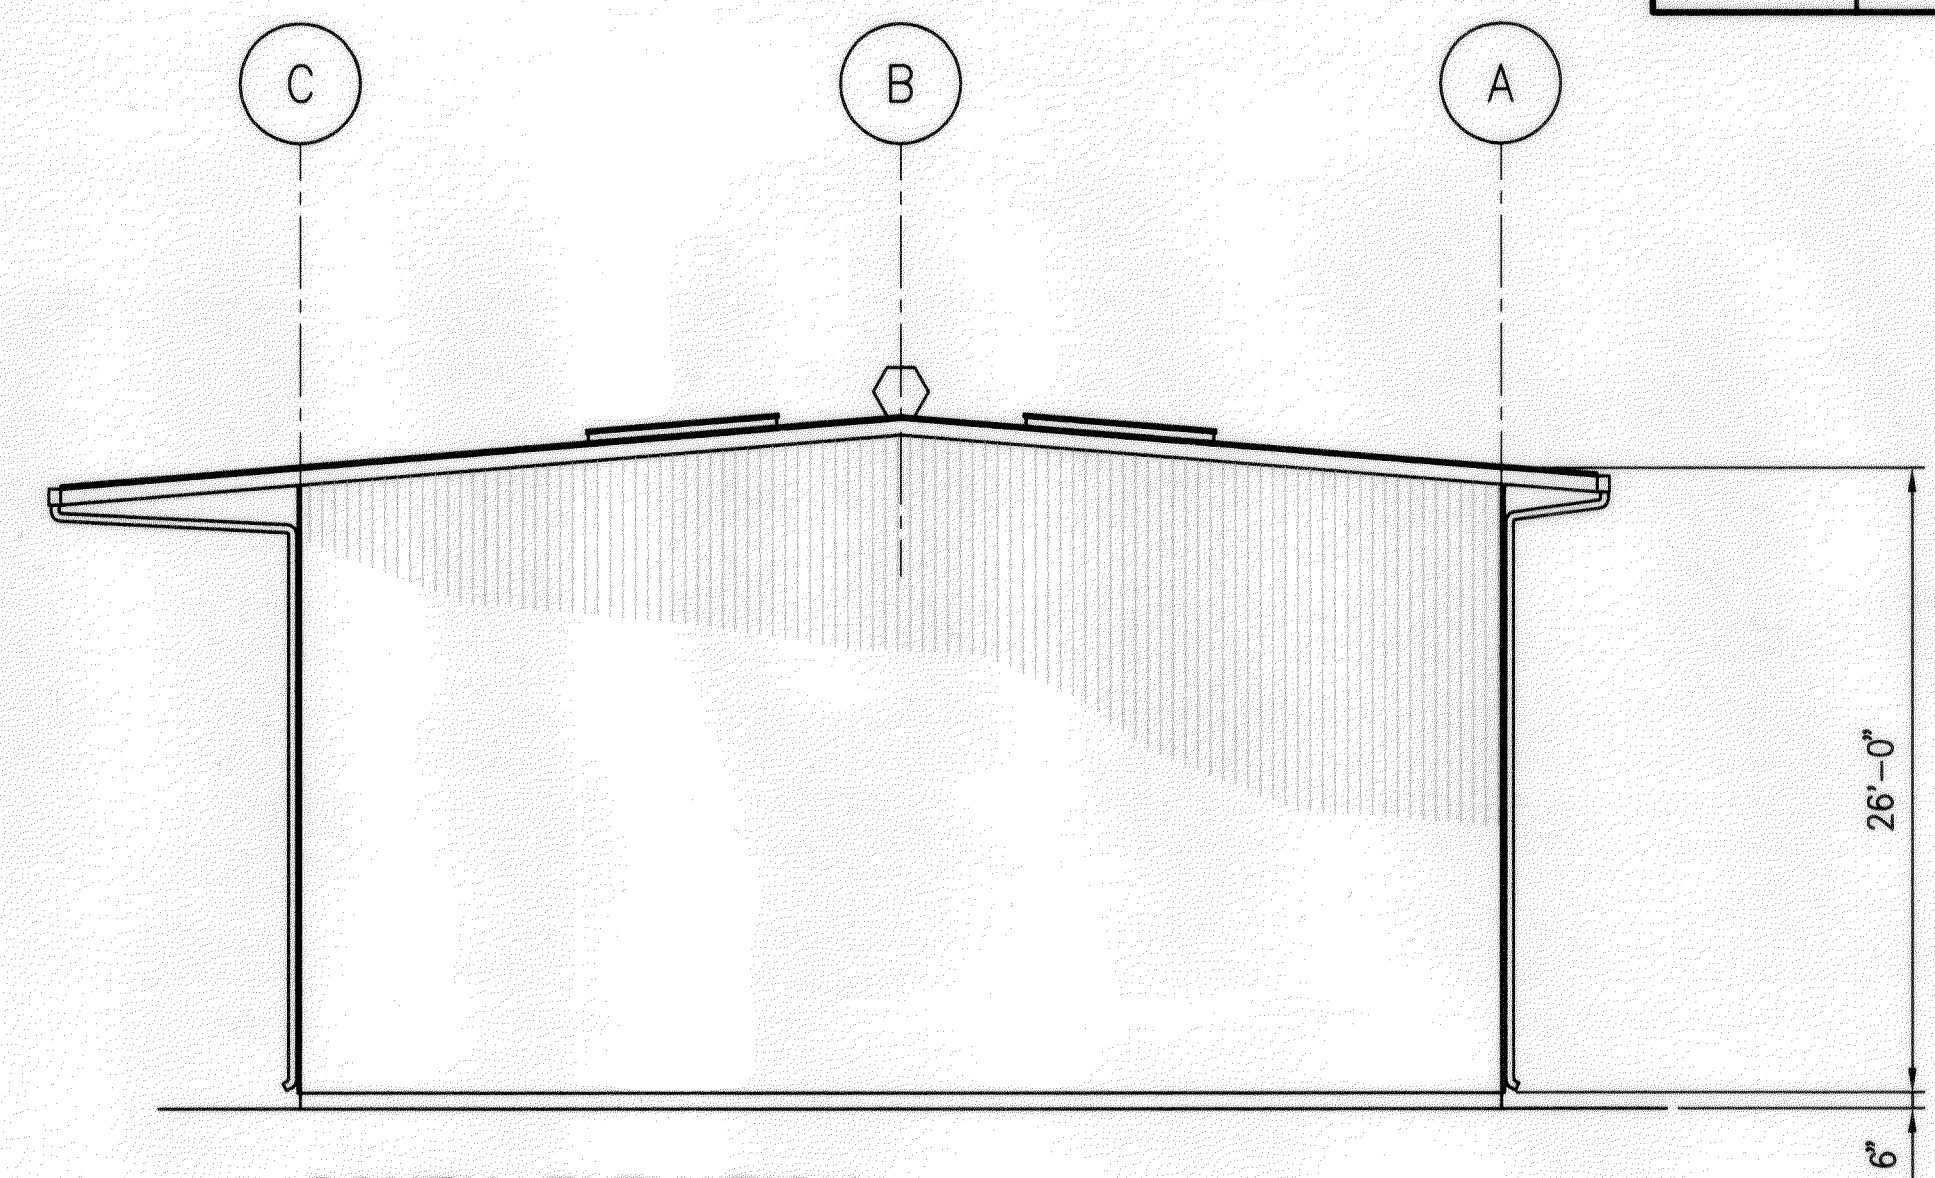

SOUTH ELEVATION
SCALE: 1/8"=1'-0"

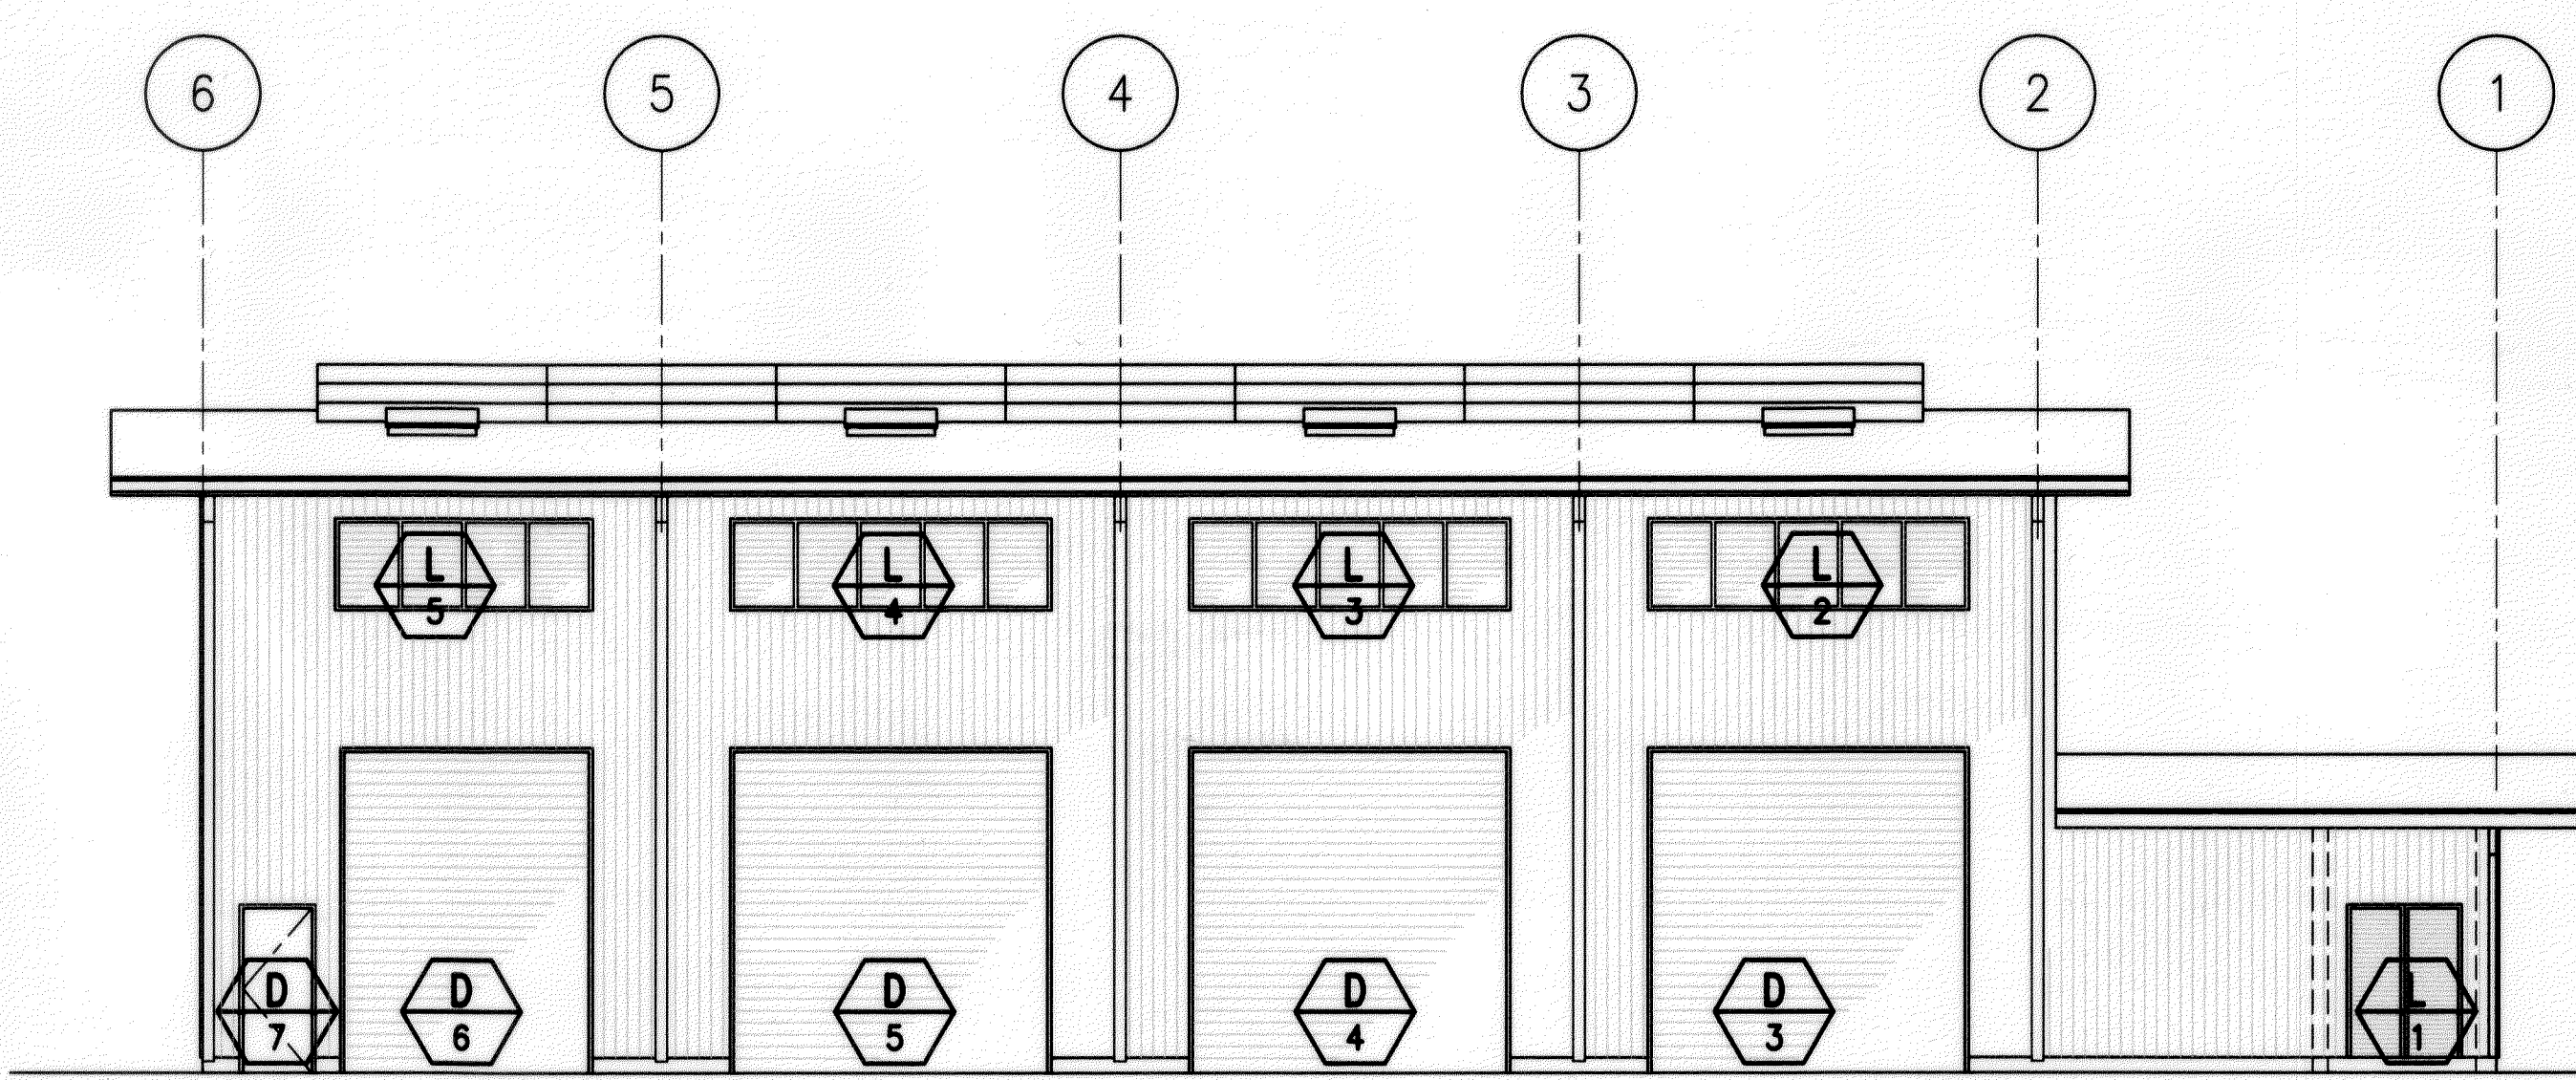


EAST ELEVATION
SCALE: 1/8"=1'-0"

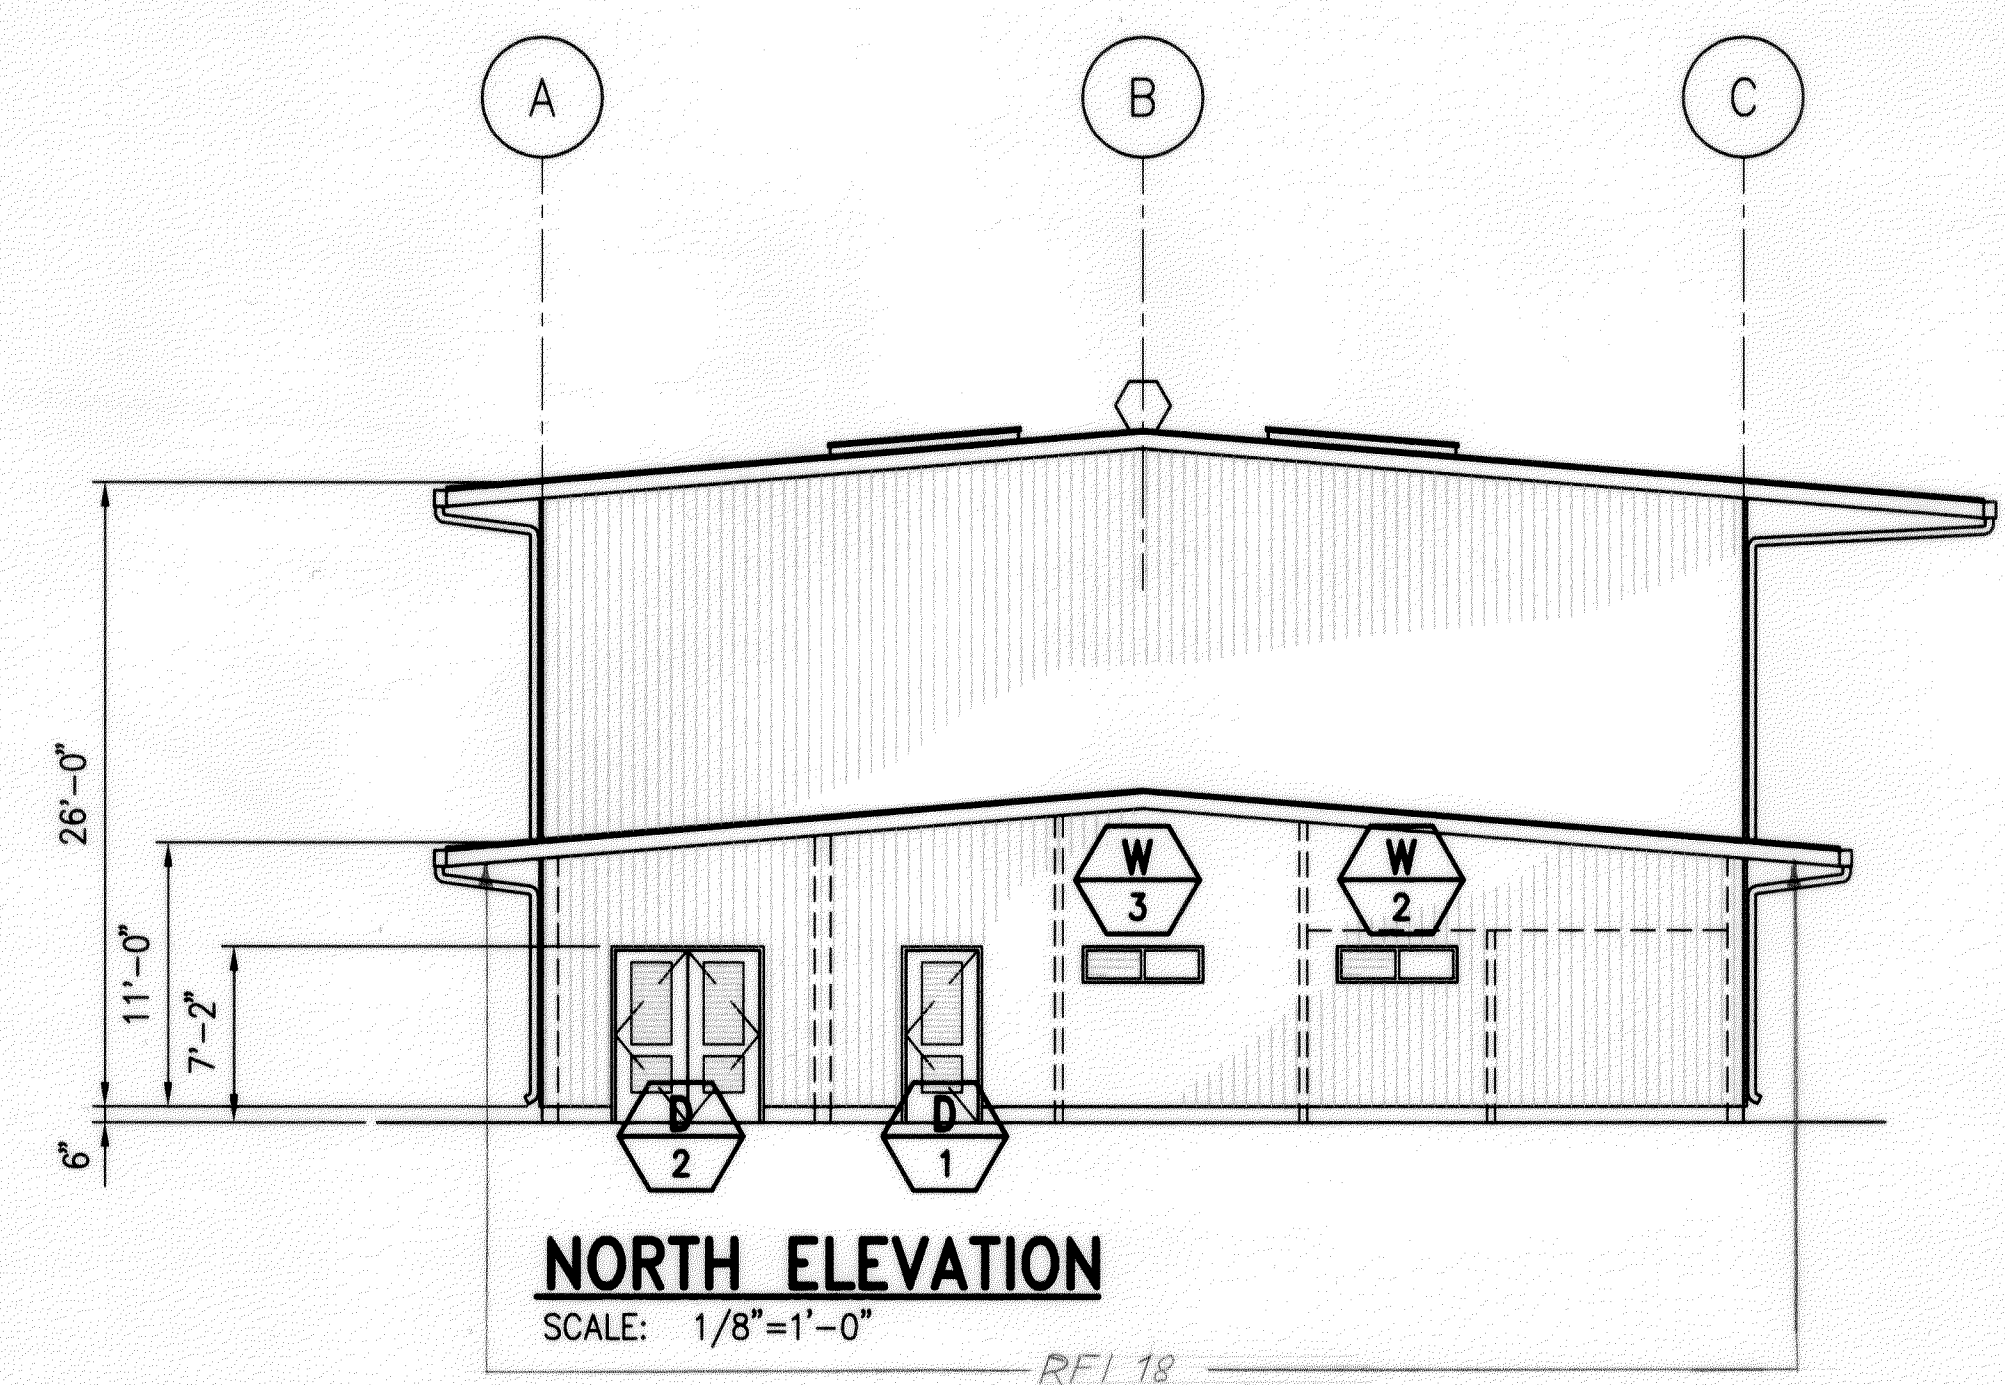

NORTH ELEVATION
SCALE: 1/8"=1'-0"

SURVEY PLOTTED BY	DATE
DRAWN BY	
DESIGNED BY	
QUANTITIES BY	
CHECKED BY	

6143A12.DWG 03/23/00 M\DWG\6143-01 ARCH 09:42

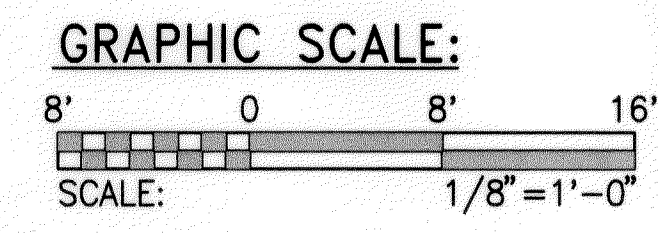

THIS WORK WAS PREPARED BY
ME OR UNDER MY SUPERVISION
Walter Leu

MAINTENANCE BUILDING

STATE OF HAWAII
DEPARTMENT OF TRANSPORTATION
HIGHWAYS DIVISION
EXTERIOR ELEVATIONS

**MOLOKAI BASEYARD
MOLOKAI INDUSTRIAL PARK**
Project No. HWY-M-05-98

Scale: As Noted Date: SEPT. 13, 2001

SHEET No. A2.3 OF A2.6 SHEETS

"AS-BUILT"