




FED. ROAD DIST. NO.	STATE	PROJ. NO.	FISCAL YEAR	SHEET NO.	TOTAL SHEETS
HAWAII	HAW.	HWY-M-05-98	2002	39	99

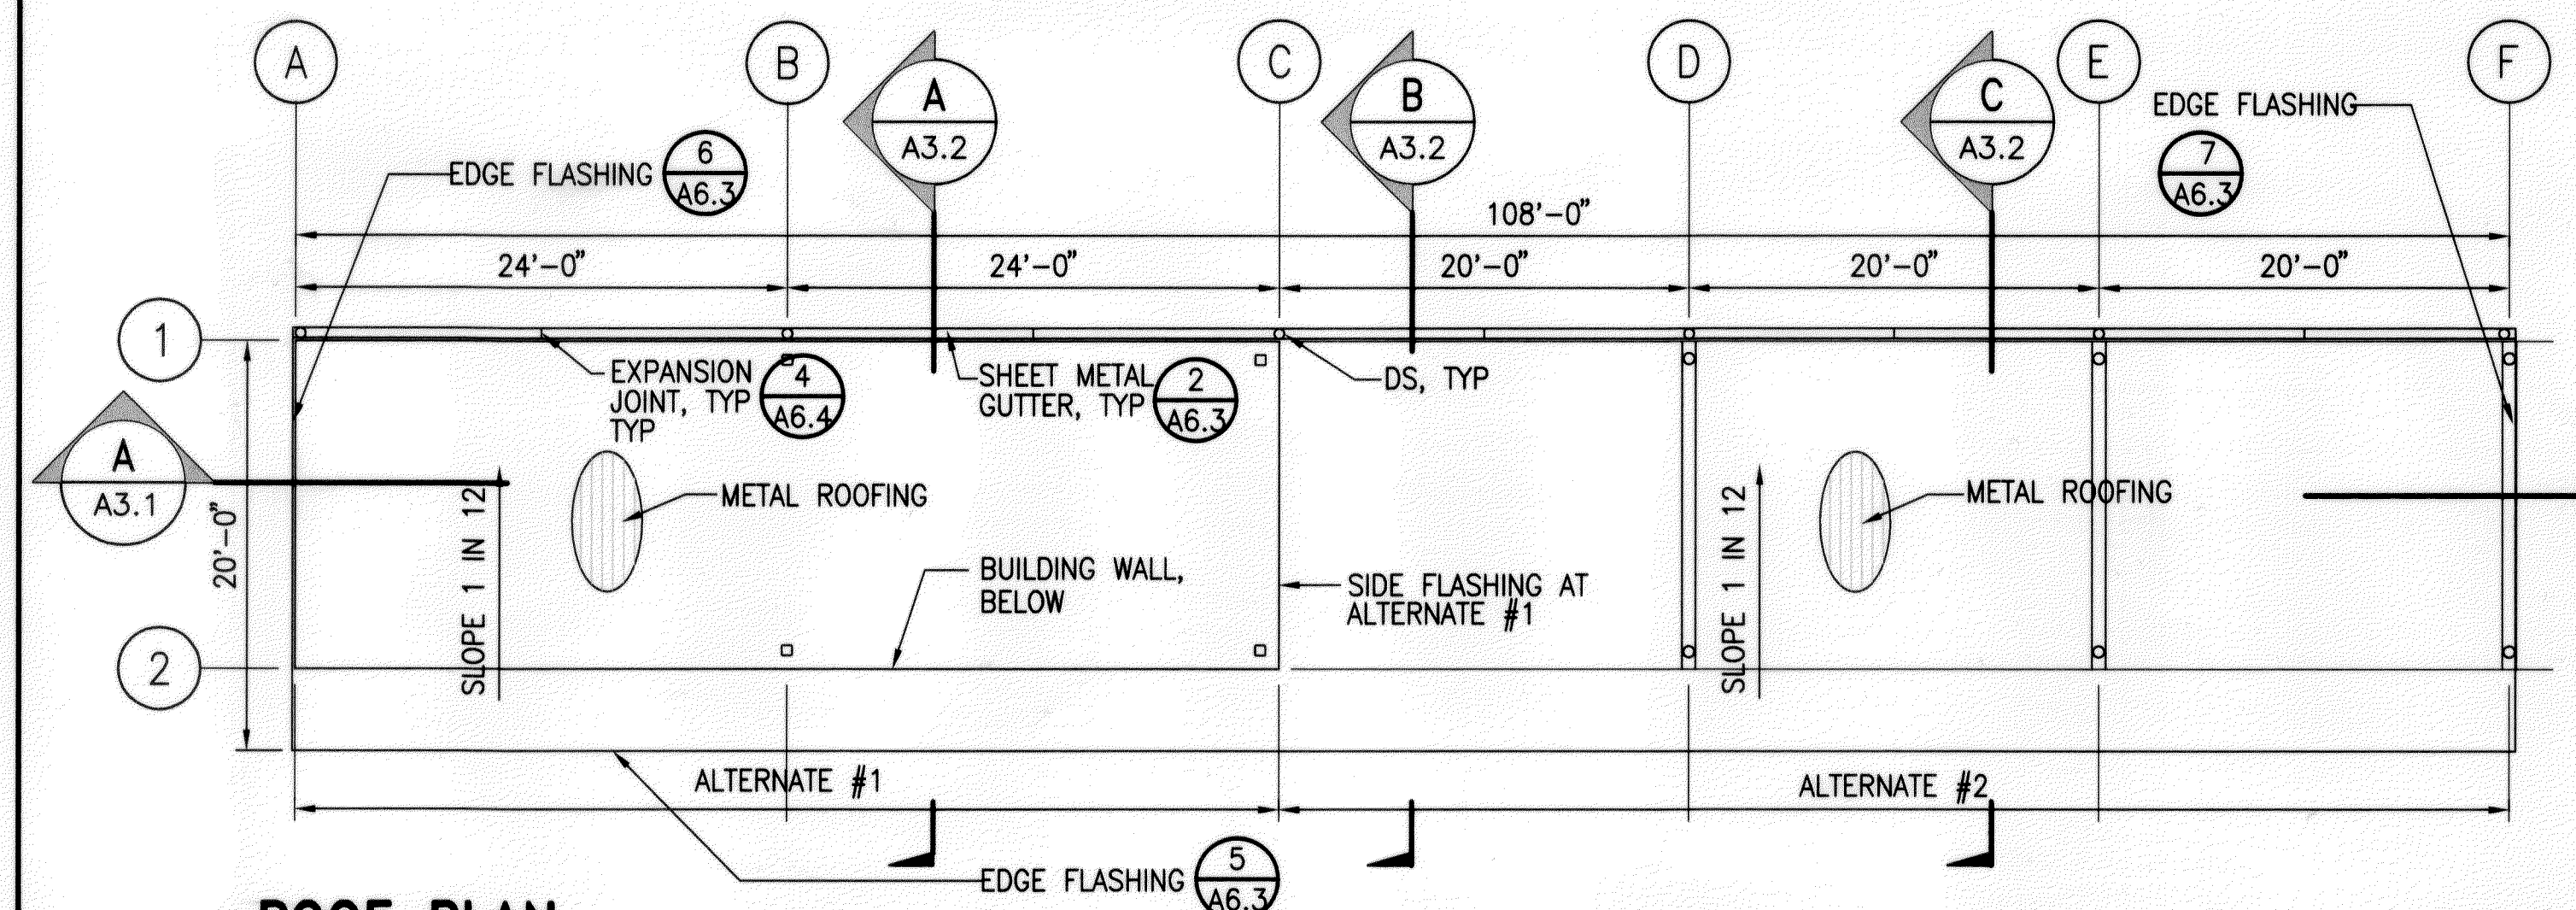


ROOF PLAN
SCALE: 1/8"=1'-0"

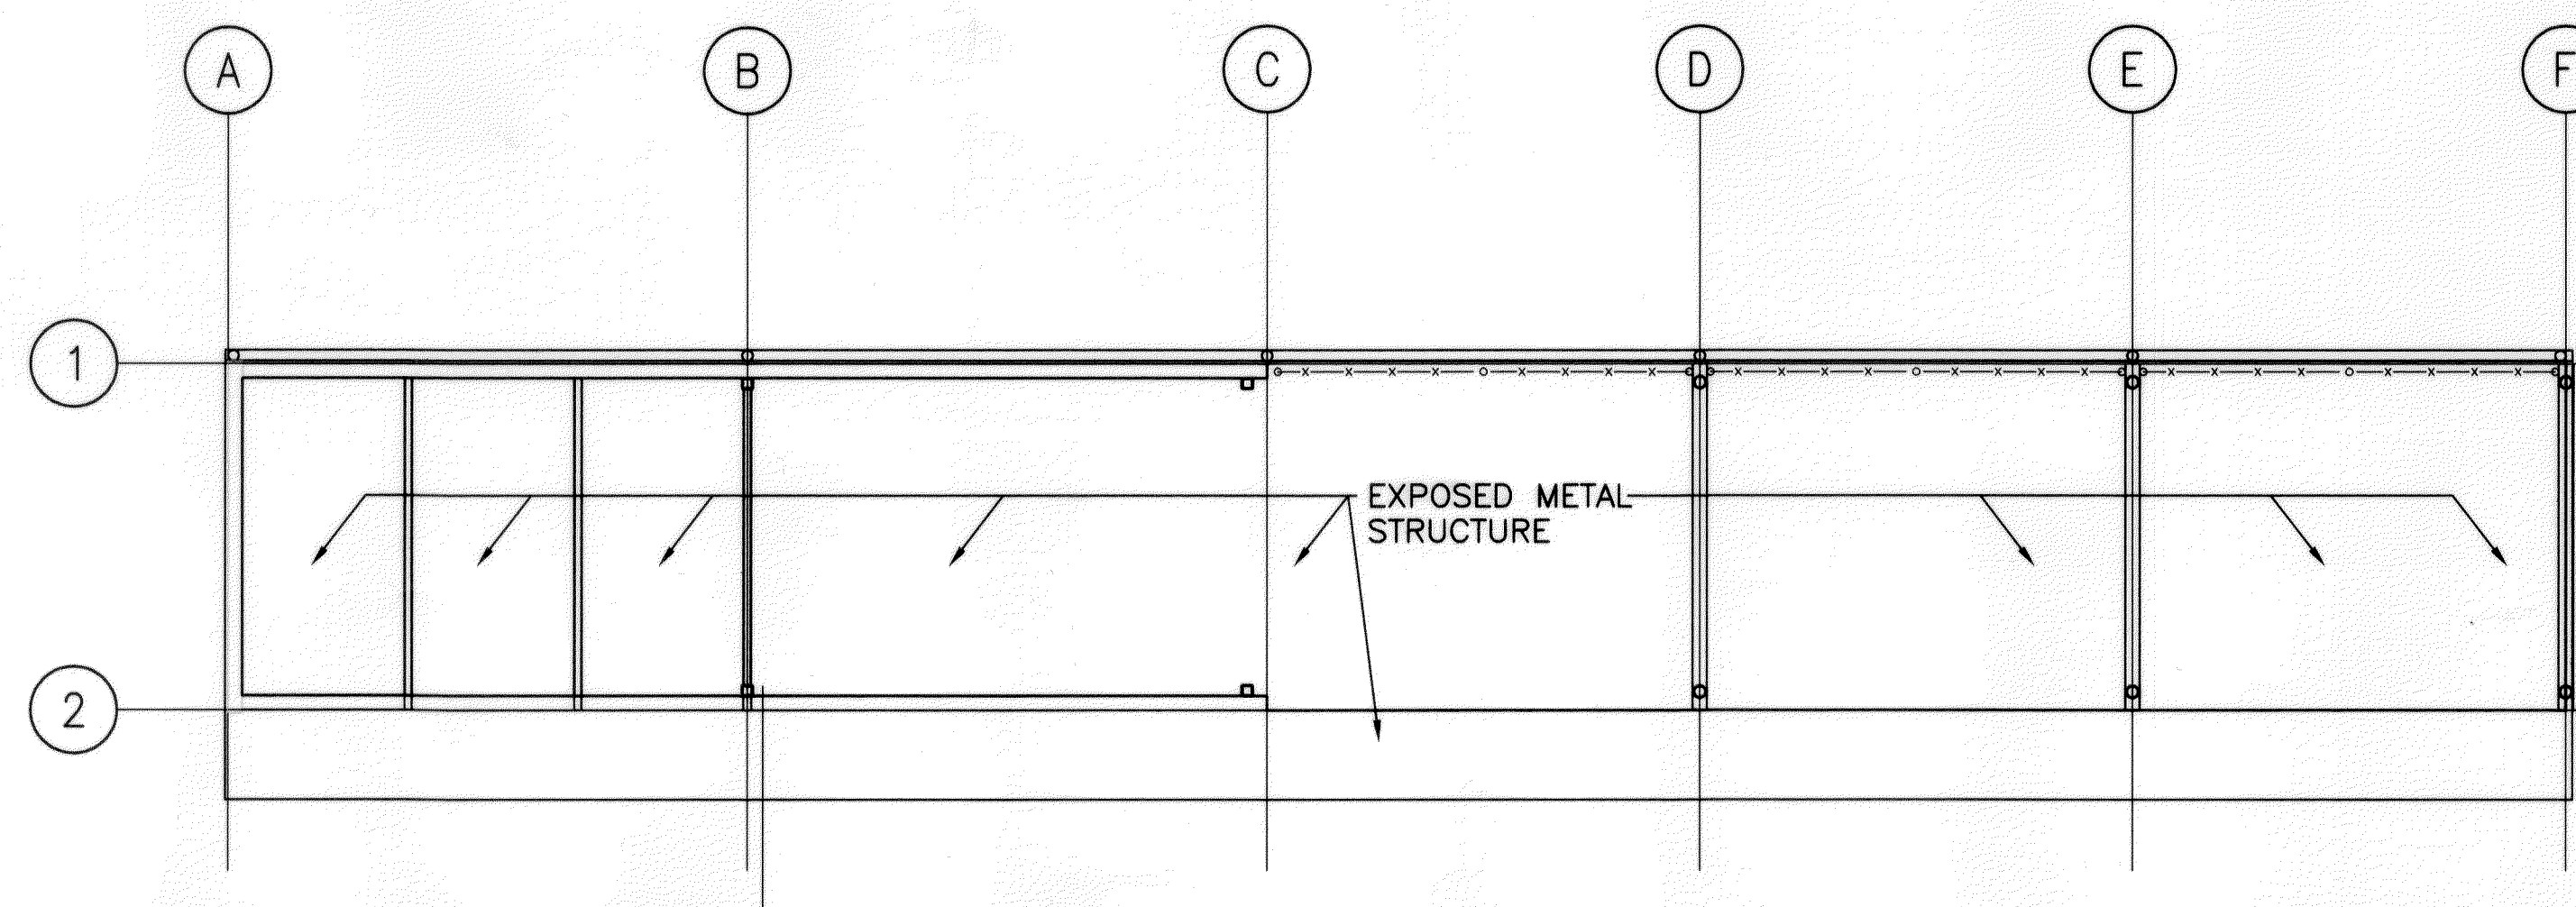


REFLECTED CEILING PLAN
SCALE: 1/8"=1'-0"

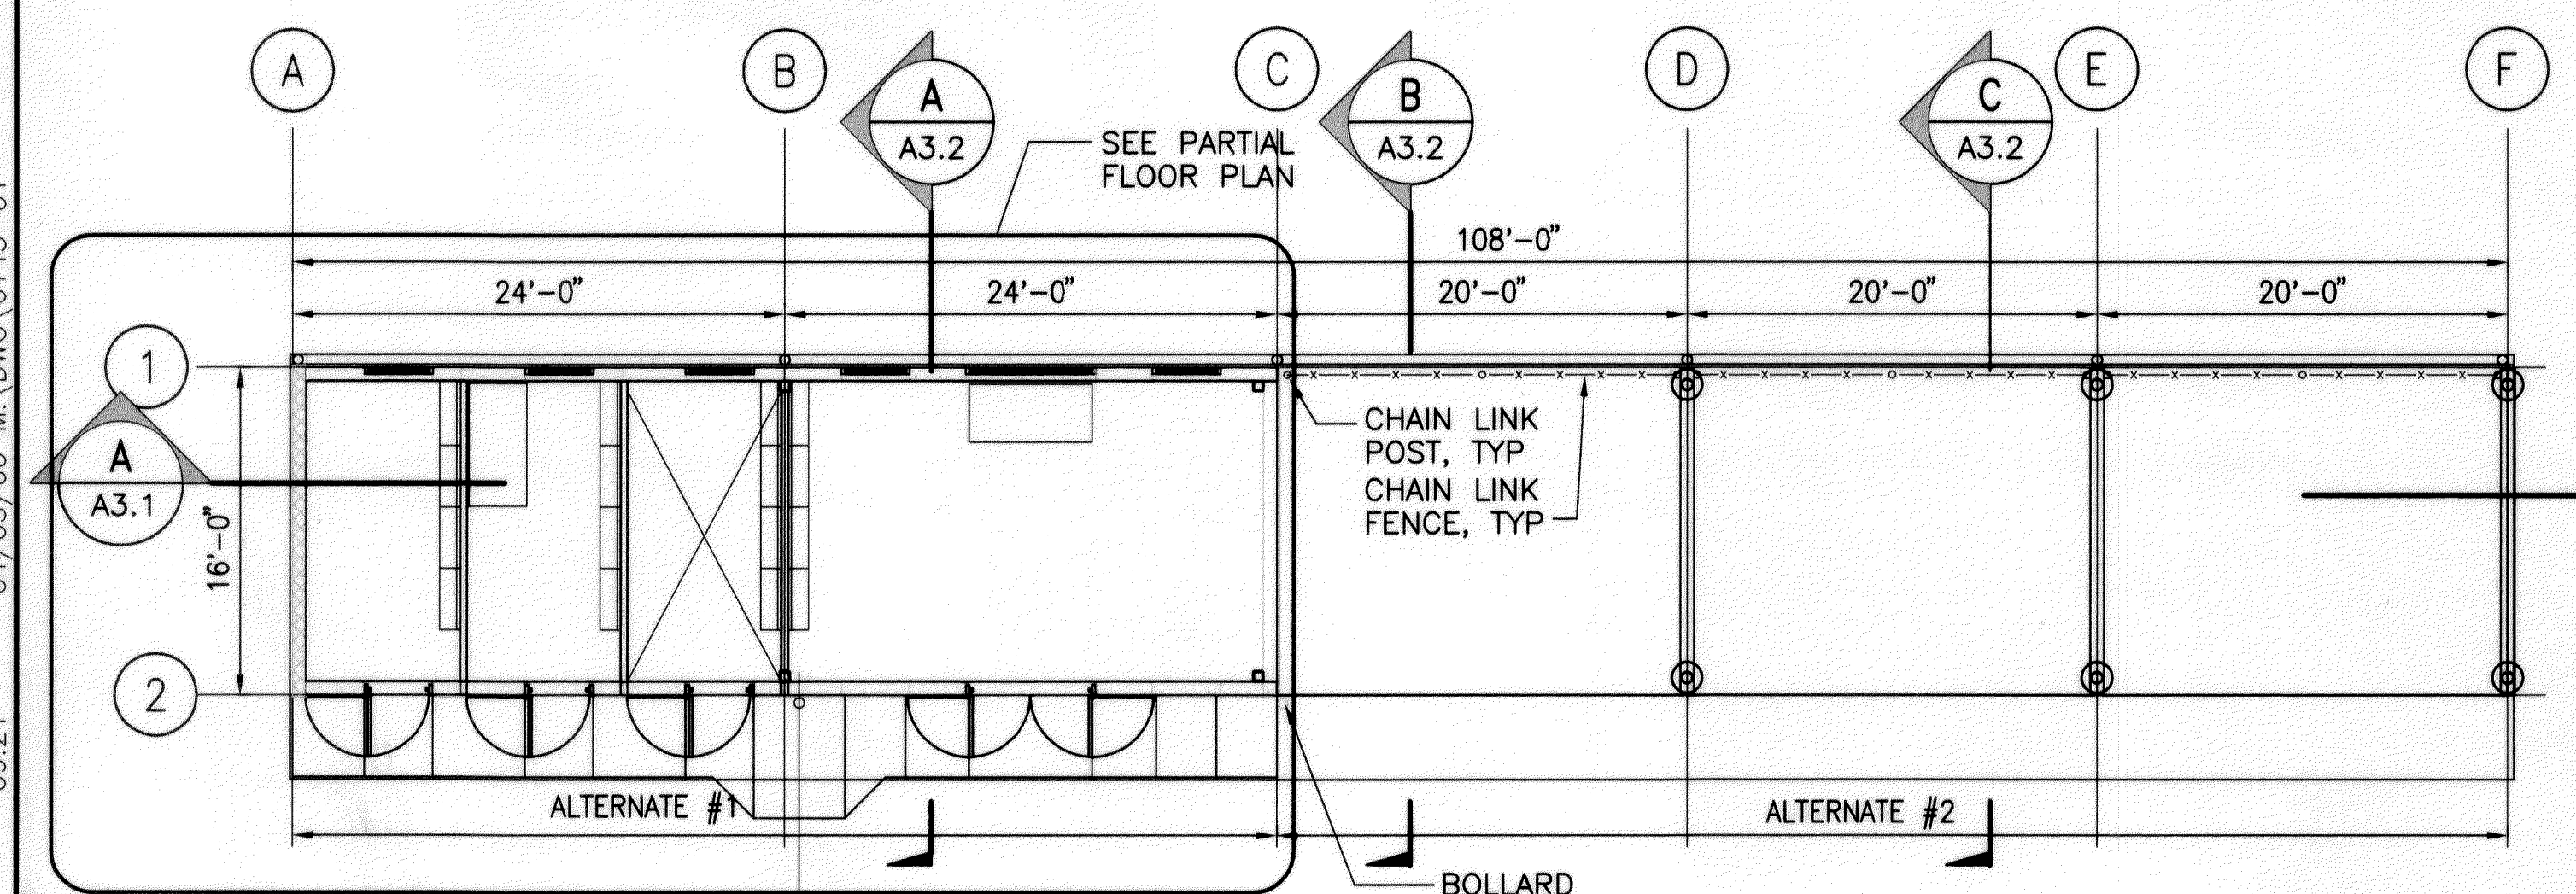



FLOOR PLAN
SCALE: 1/8"=1'-0"

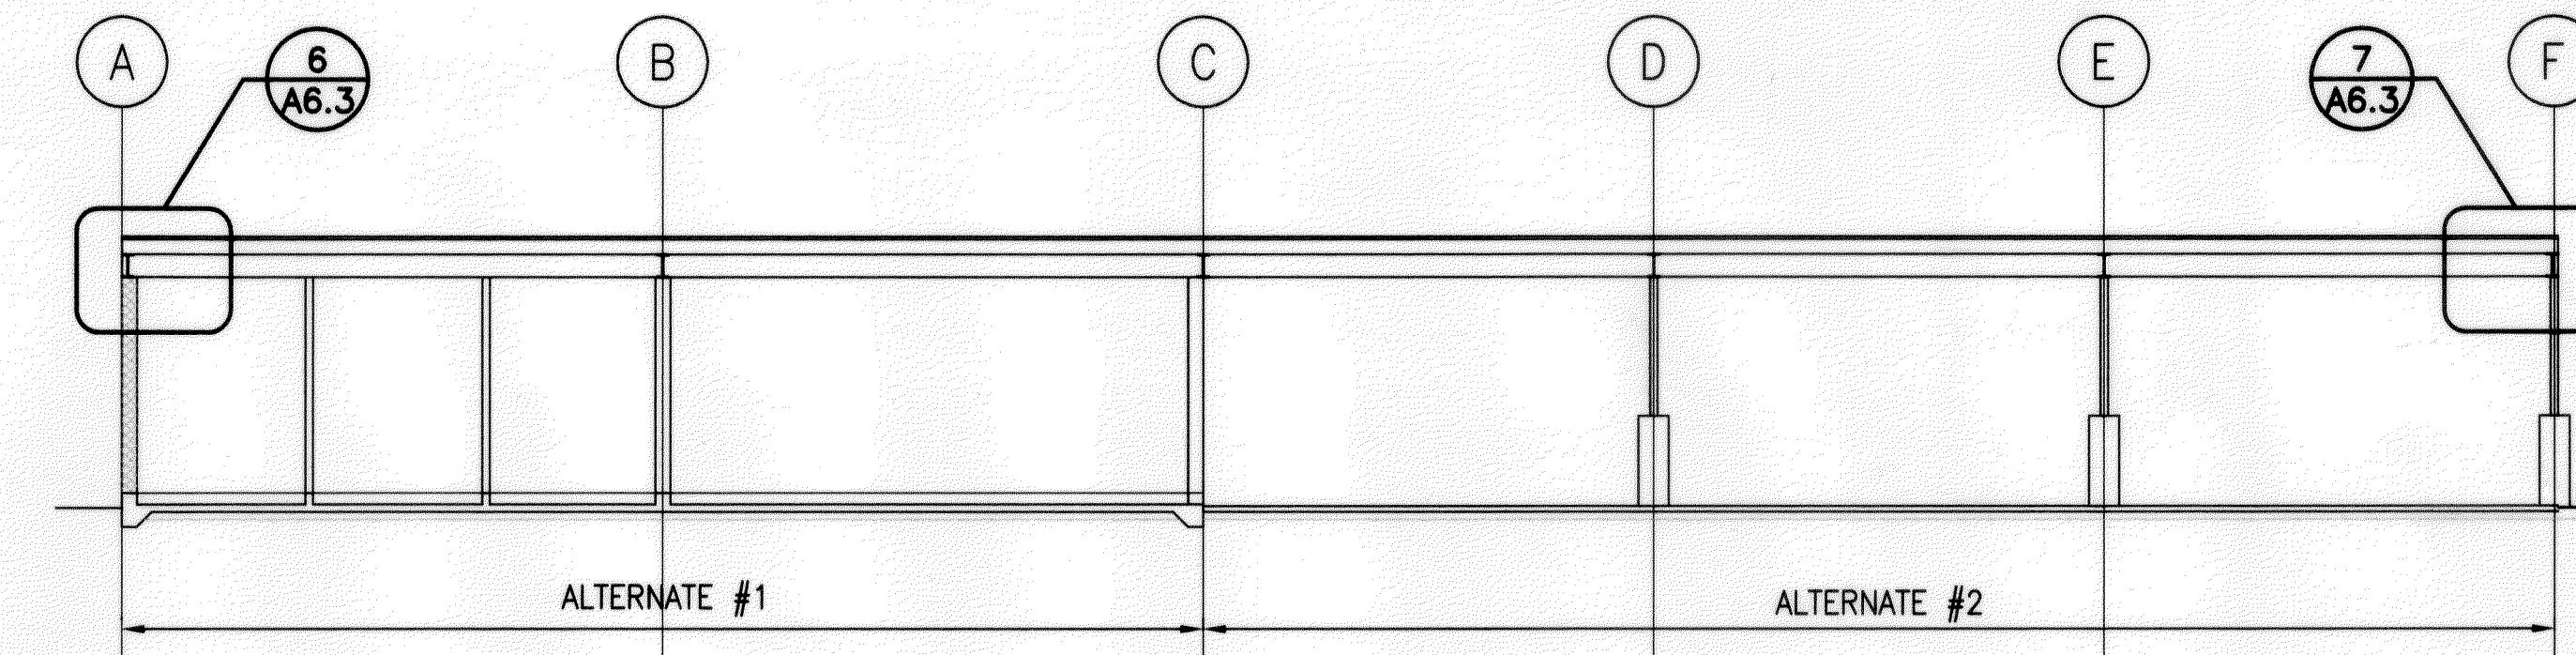

A LONGITUDINAL SECTION
SCALE: 1/8"=1'-0"


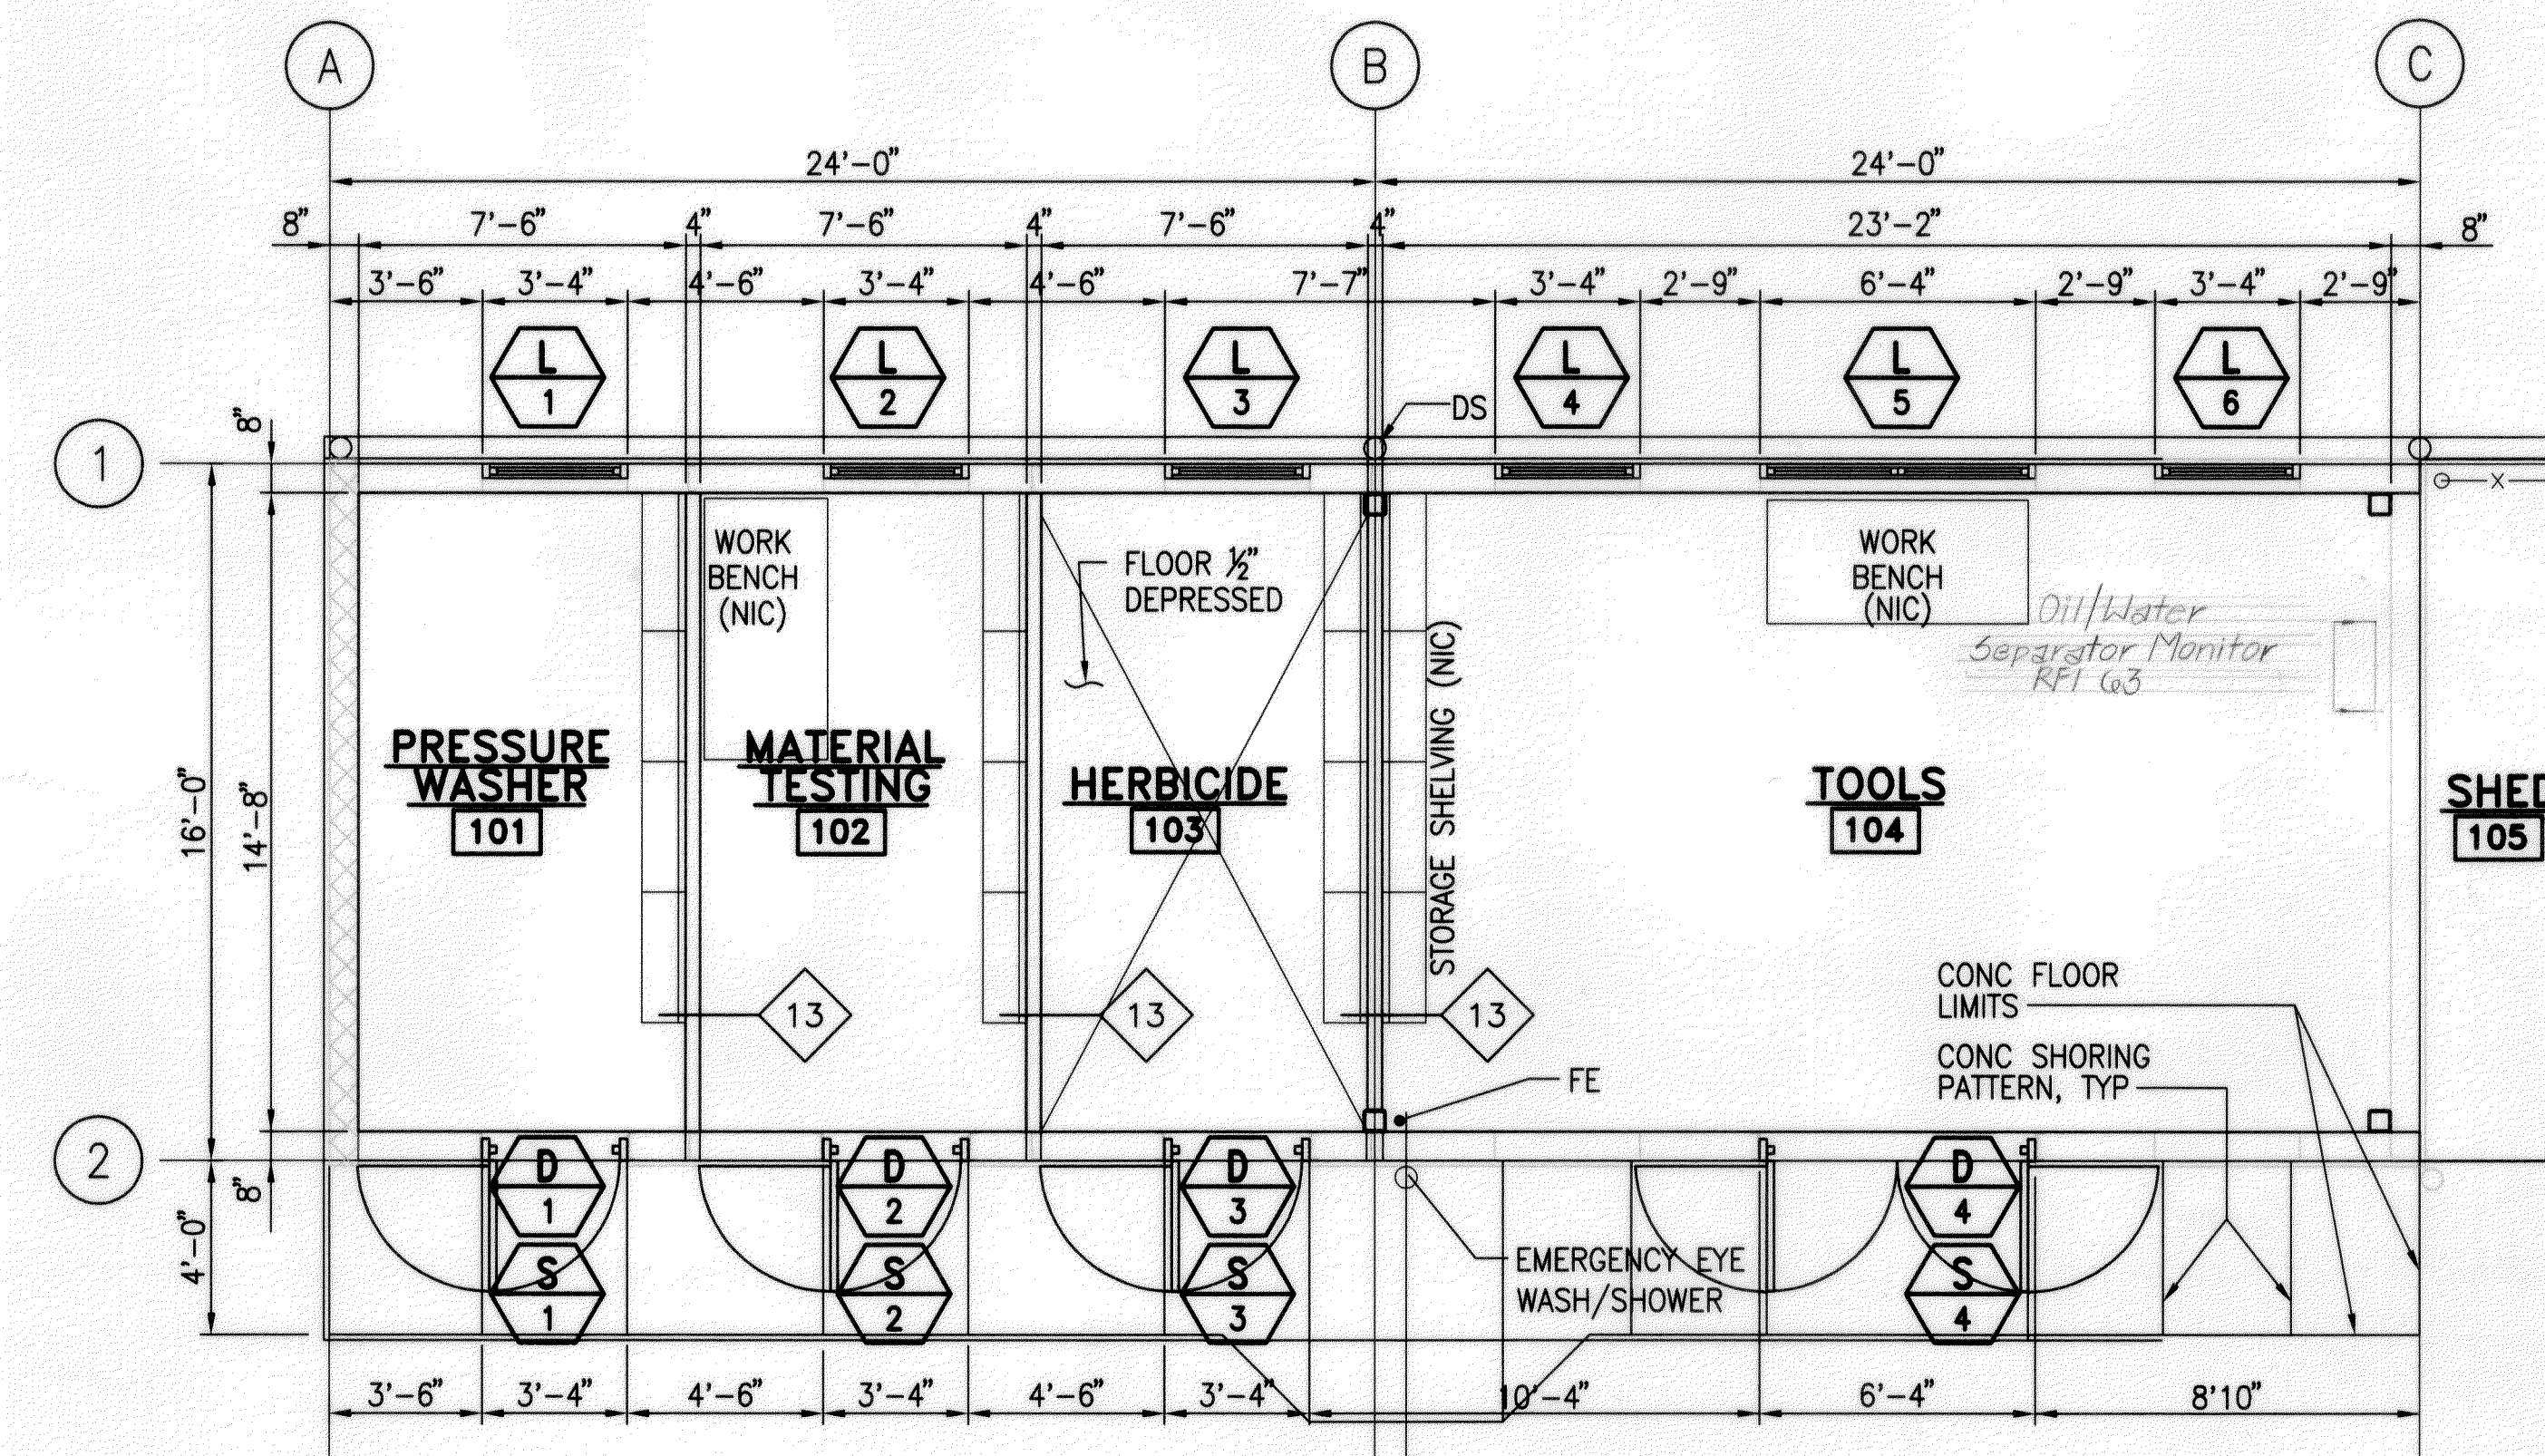


PARTIAL FLOOR PLAN
SCALE: 1/4"=1'-0"

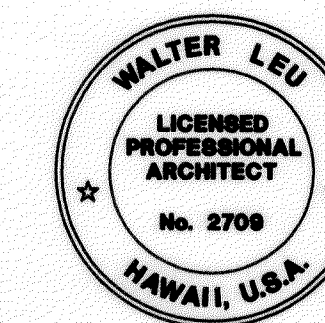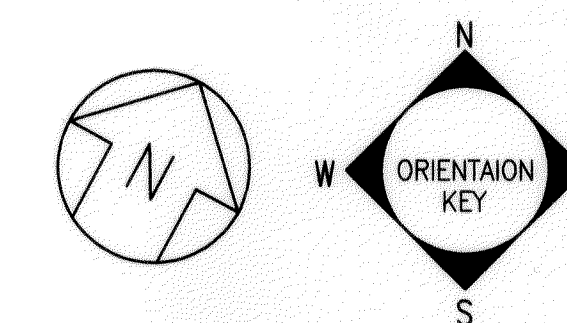

THIS WORK WAS PREPARED BY
ME OR UNDER MY SUPERVISION
Walter Leu

GRAPHIC SCALE:

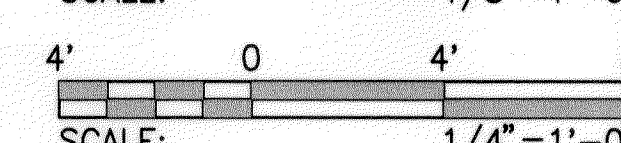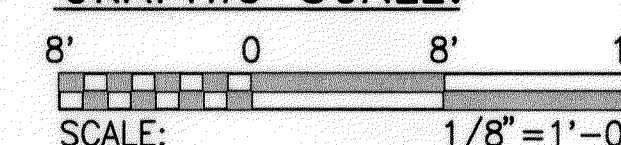

STORAGE BLDG/STORAGE SHED

STATE OF HAWAII
DEPARTMENT OF TRANSPORTATION
HIGHWAYS DIVISION

FLOOR, ROOF, PARTIAL FLOOR, REFLECTED CEILING PLANS & LOGITUDINAL SECTION

MOLOKAI BASEYARD
MOLOKAI INDUSTRIAL PARK
Project No. HWY-M-05-98

Scale: As Noted Date: SEPT. 13, 2001

SHEET No. A3.1 OF A3.3 SHEETS

"AS-BUILT"