




FED. ROAD DIST. NO.	STATE	PROJ. NO.	FISCAL YEAR	SHEET NO.	TOTAL SHEETS
HAWAII	HAW.	HWY-M-05-98	2002	69	99

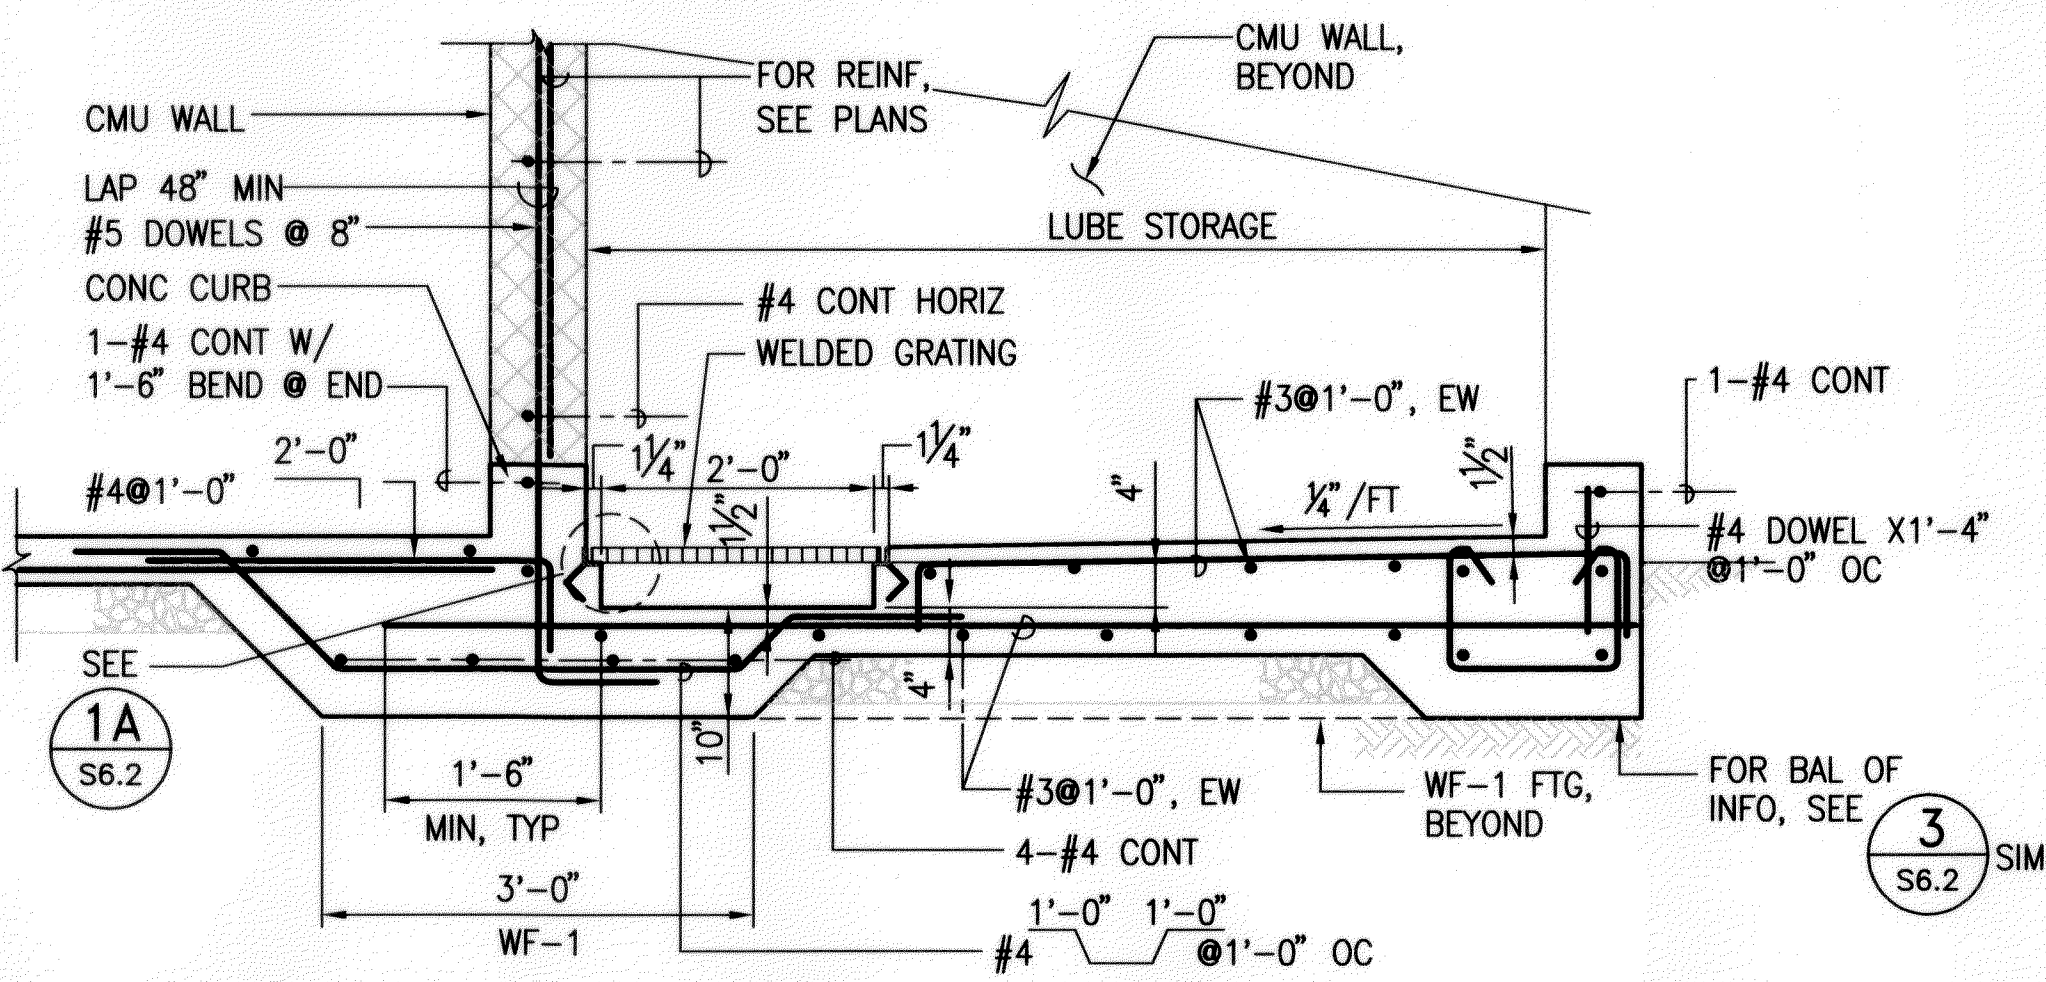



1 SECTION
S6.2 SCALE: 3/4"=1'-0"

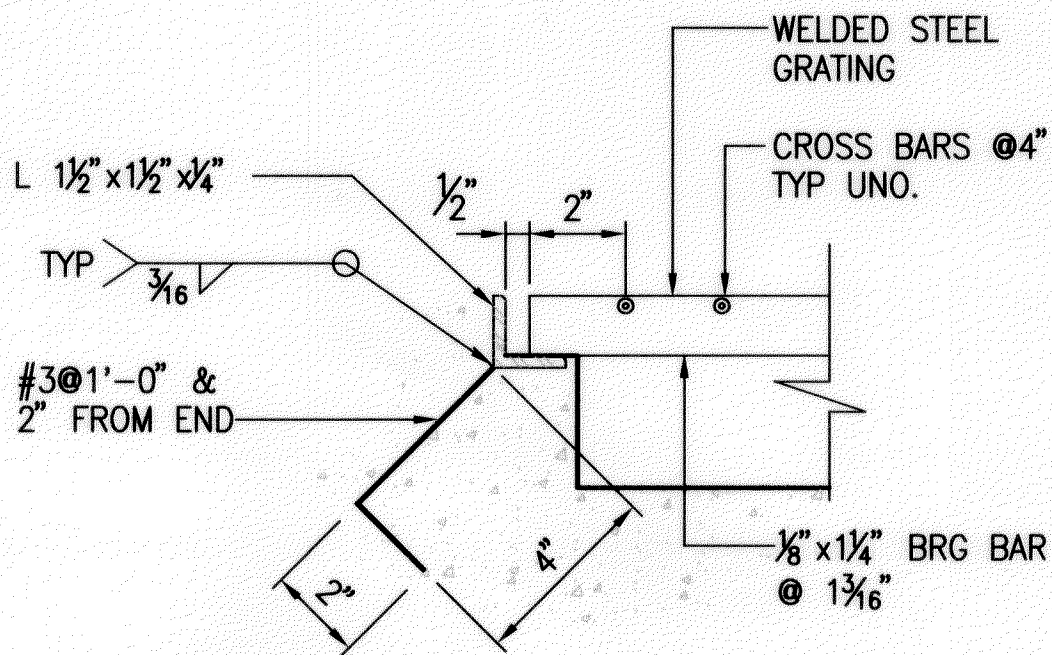


1A DETAIL
S6.2 SCALE: 3"=1'-0"

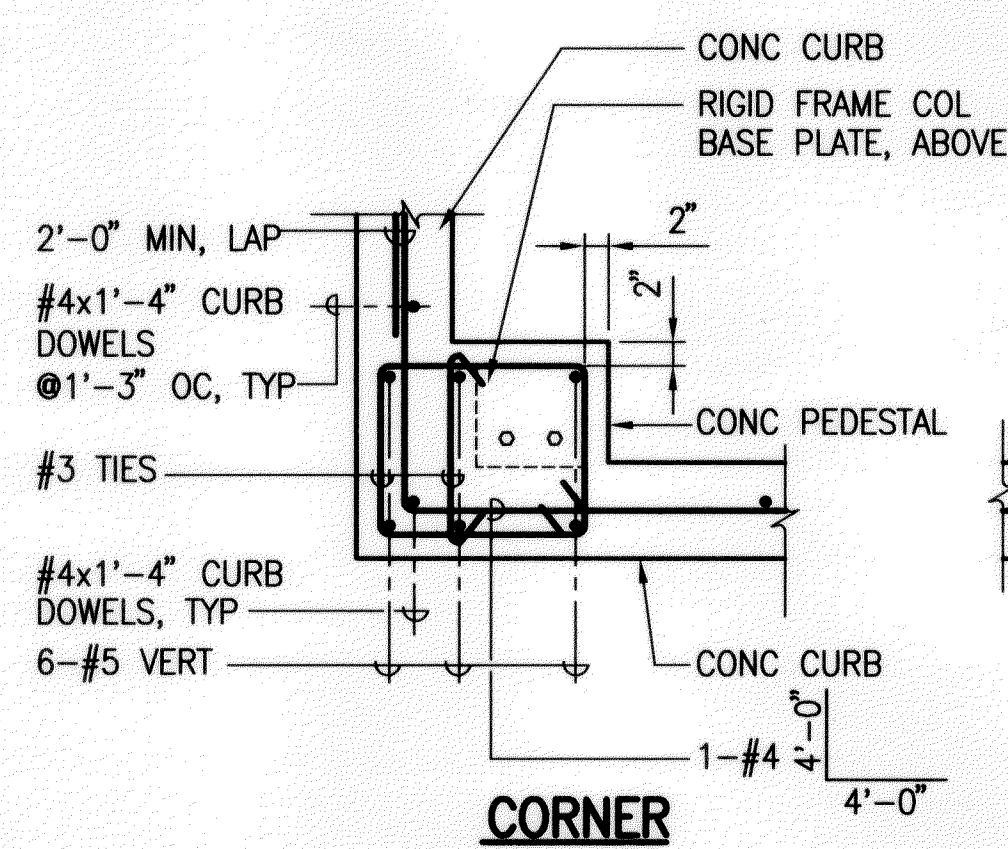


2 SECTION
S6.2 SCALE: 3/4"=1'-0"

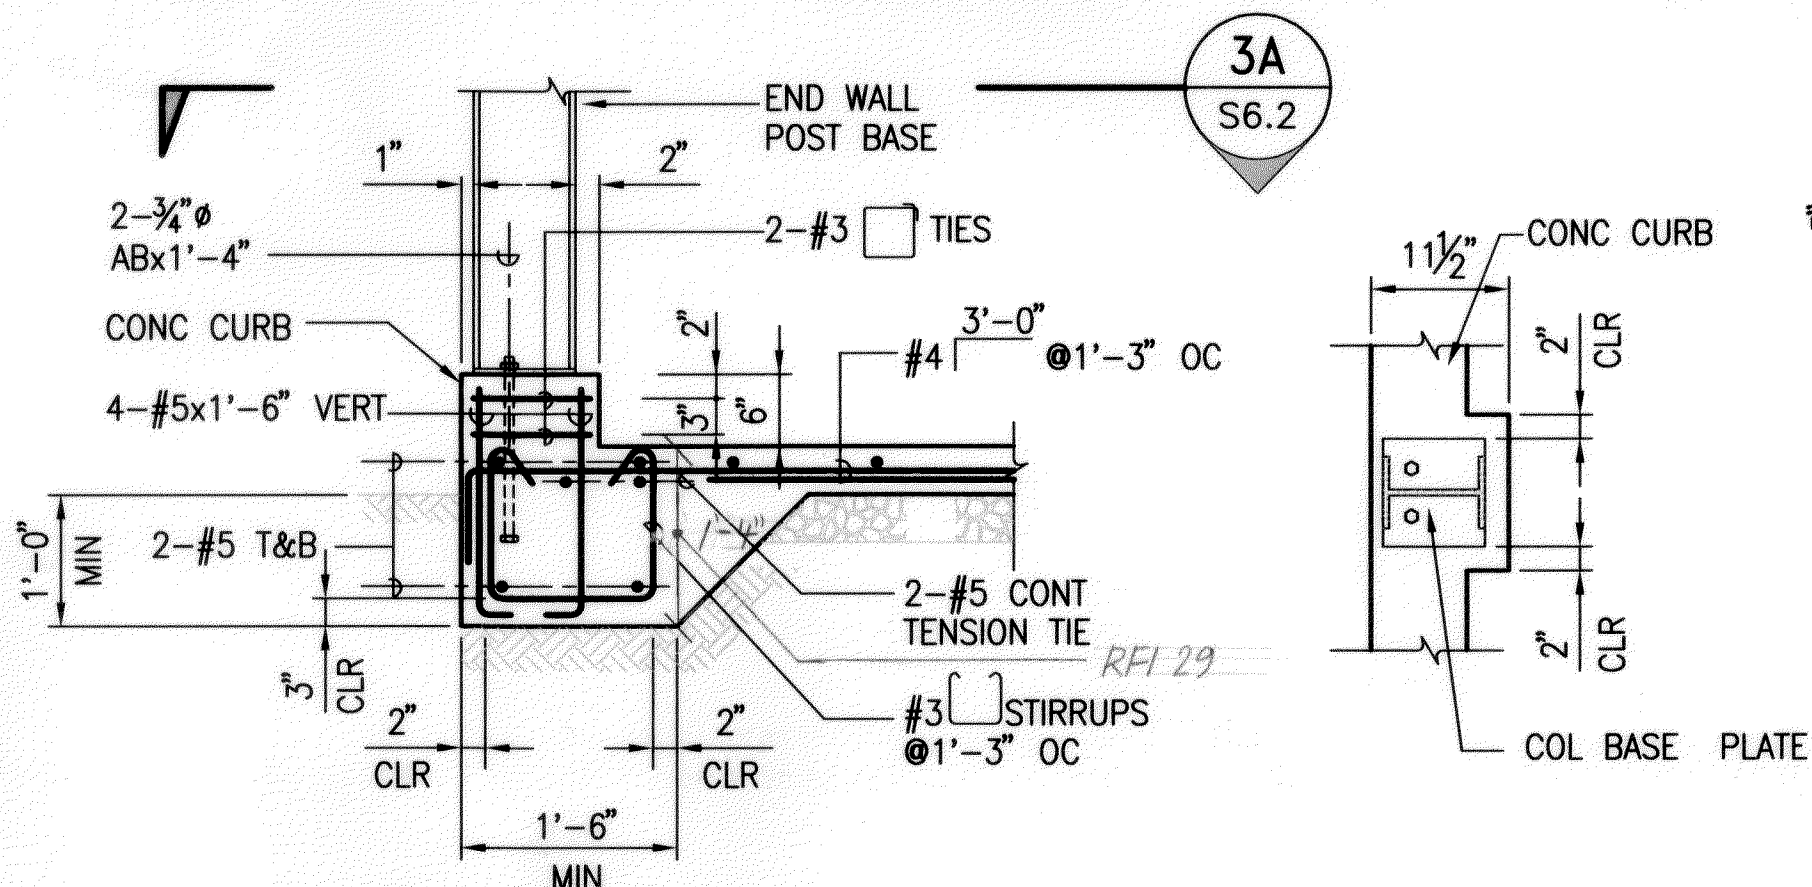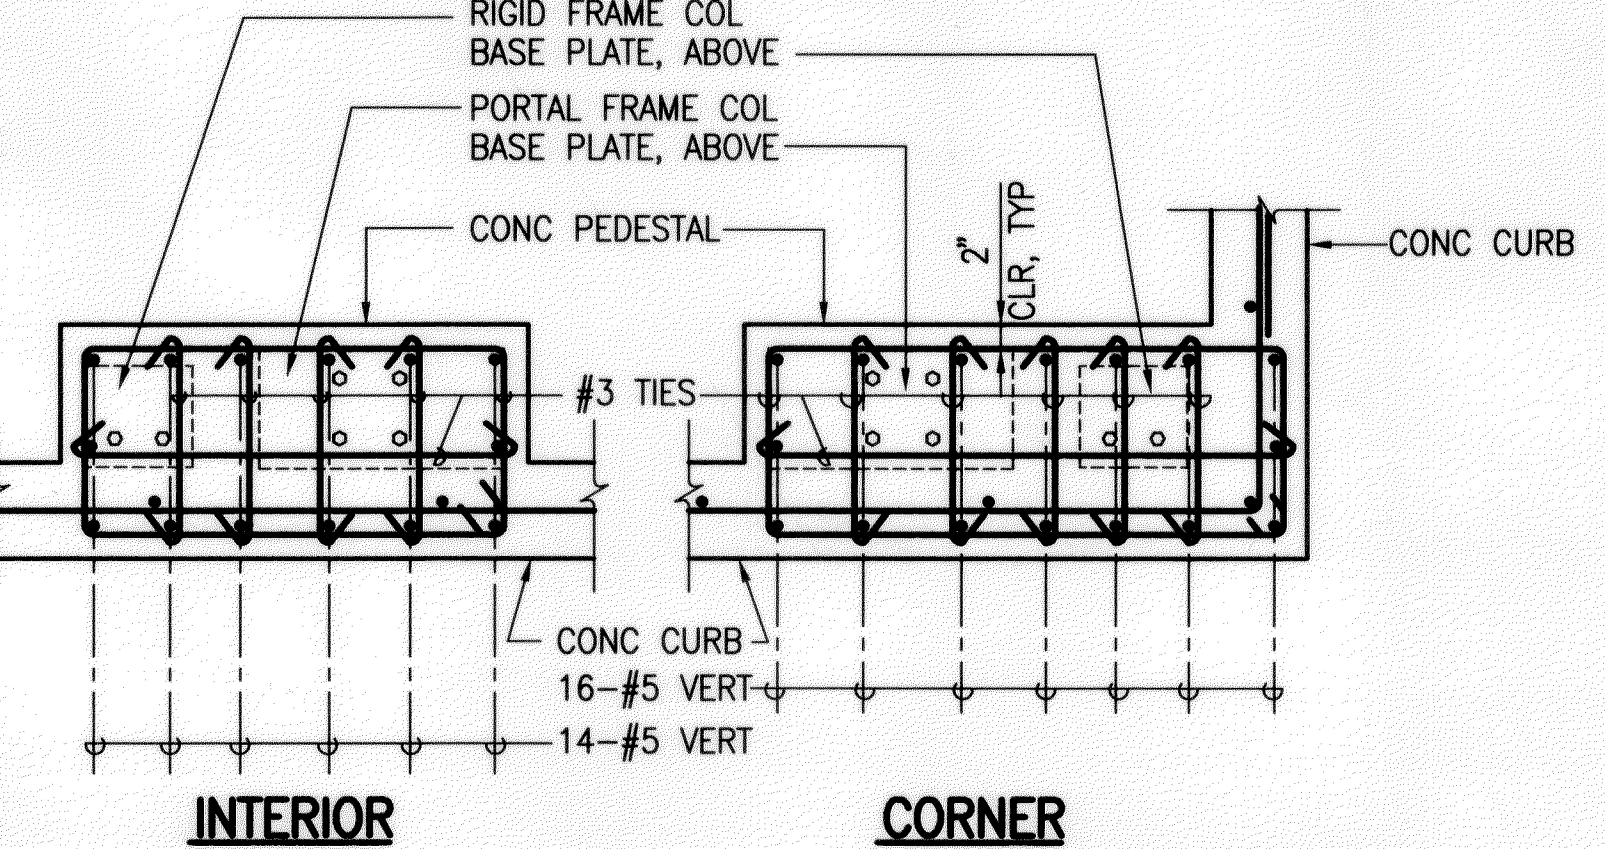


3 SECTION
S6.2 SCALE: 3/4"=1'-0"

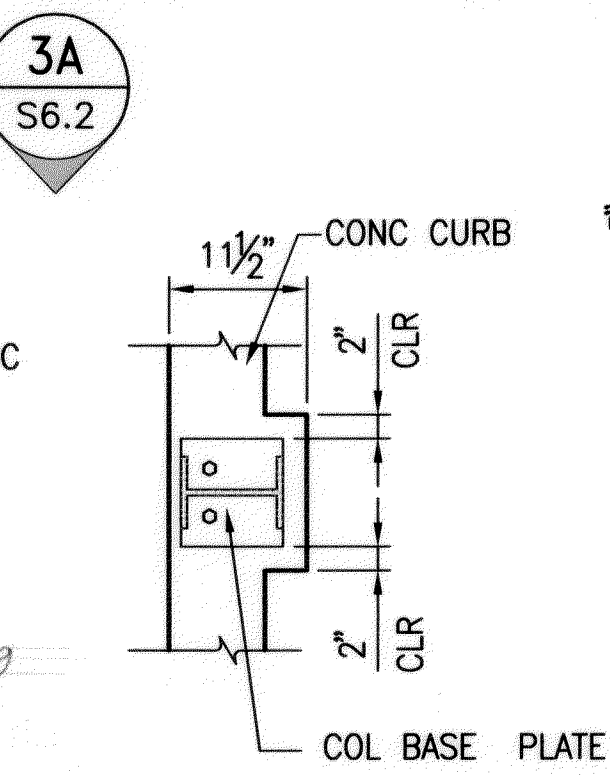


3A PLAN
S6.2 SCALE: 3/4"=1'-0"

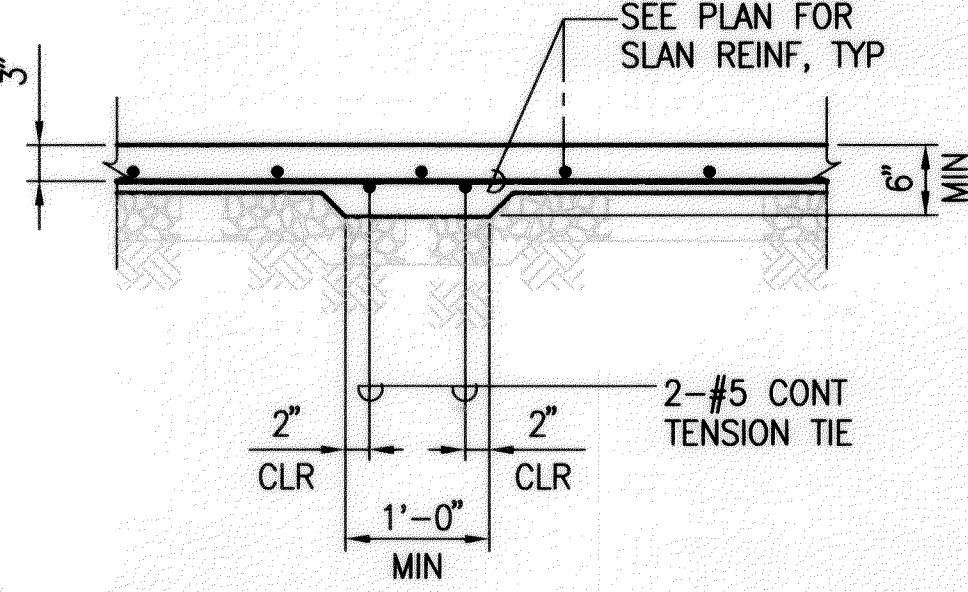

4 SECTION TIE BEAM
S6.2 SCALE: 3/4"=1'-0"

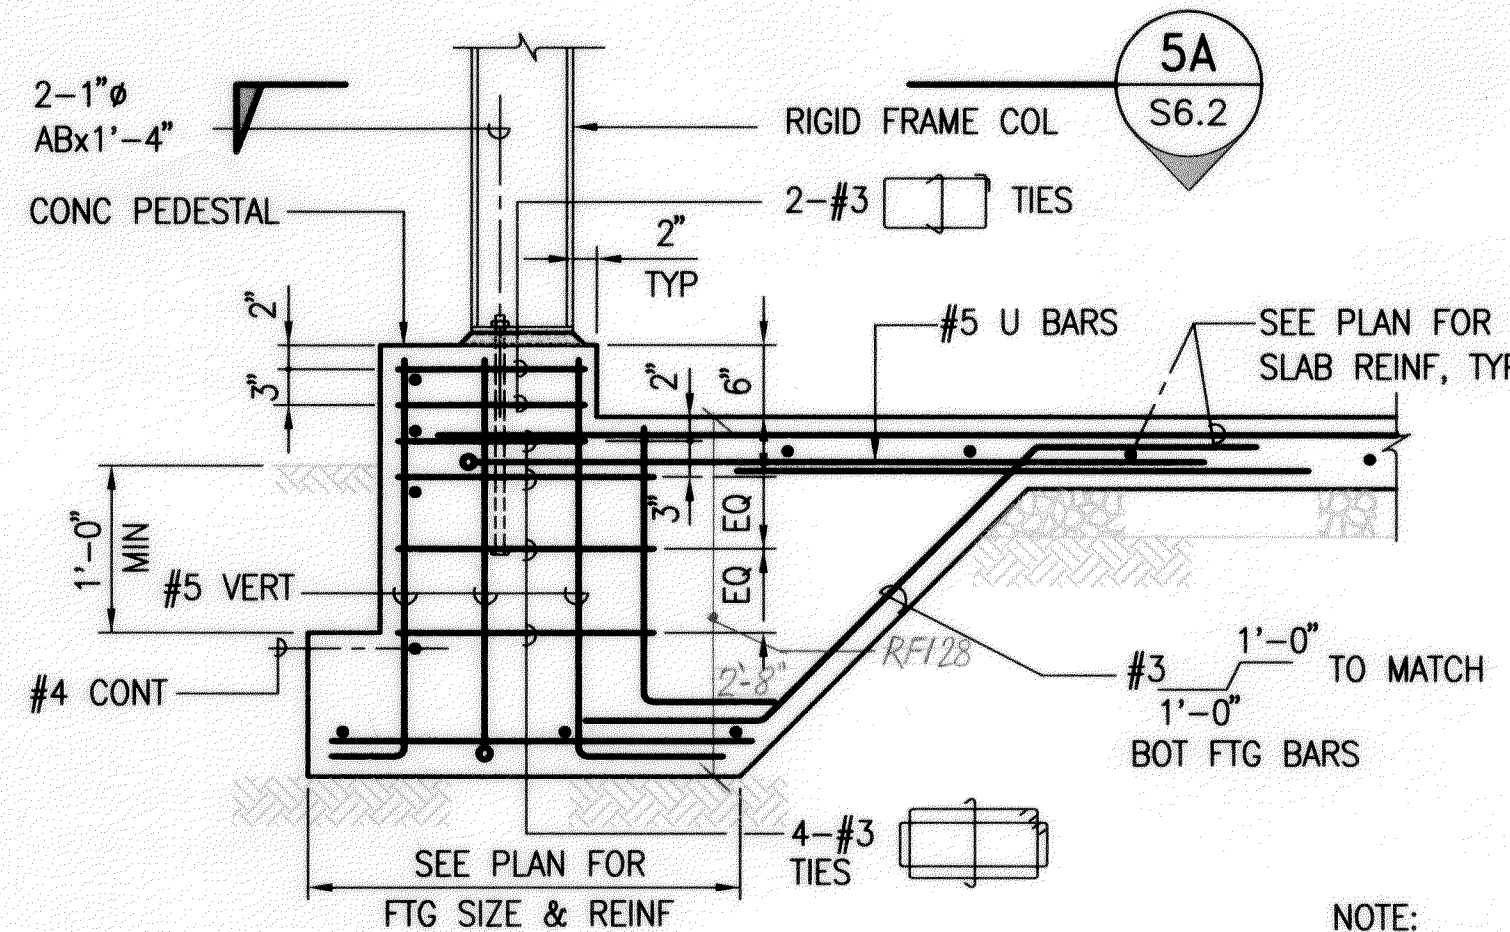


5 SECTION
S6.2 SCALE: 3/4"=1'-0"

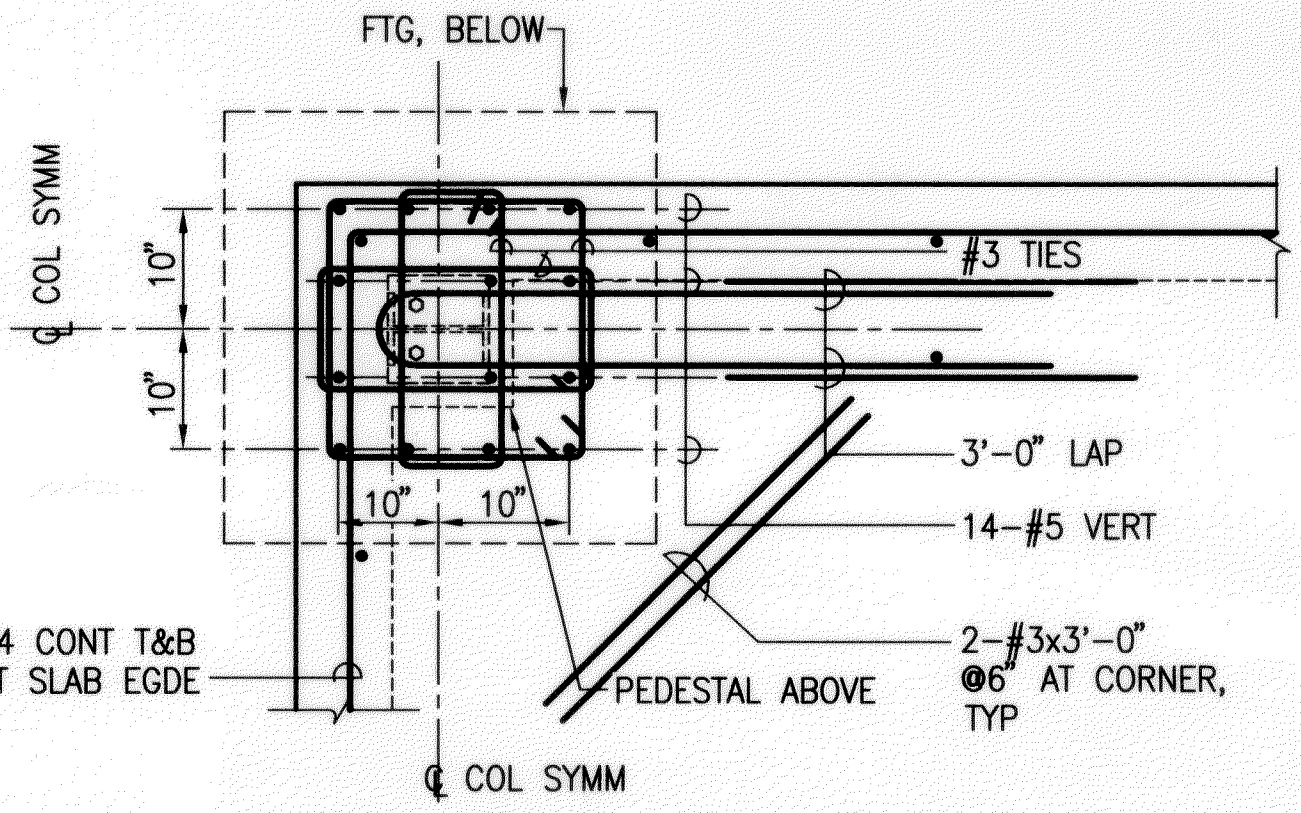


5A DETAIL PLAN
S6.2 SCALE: 3/4"=1'-0"



NOTE:
SLAB REINF NOT SHOWN
FOR CLARITY.

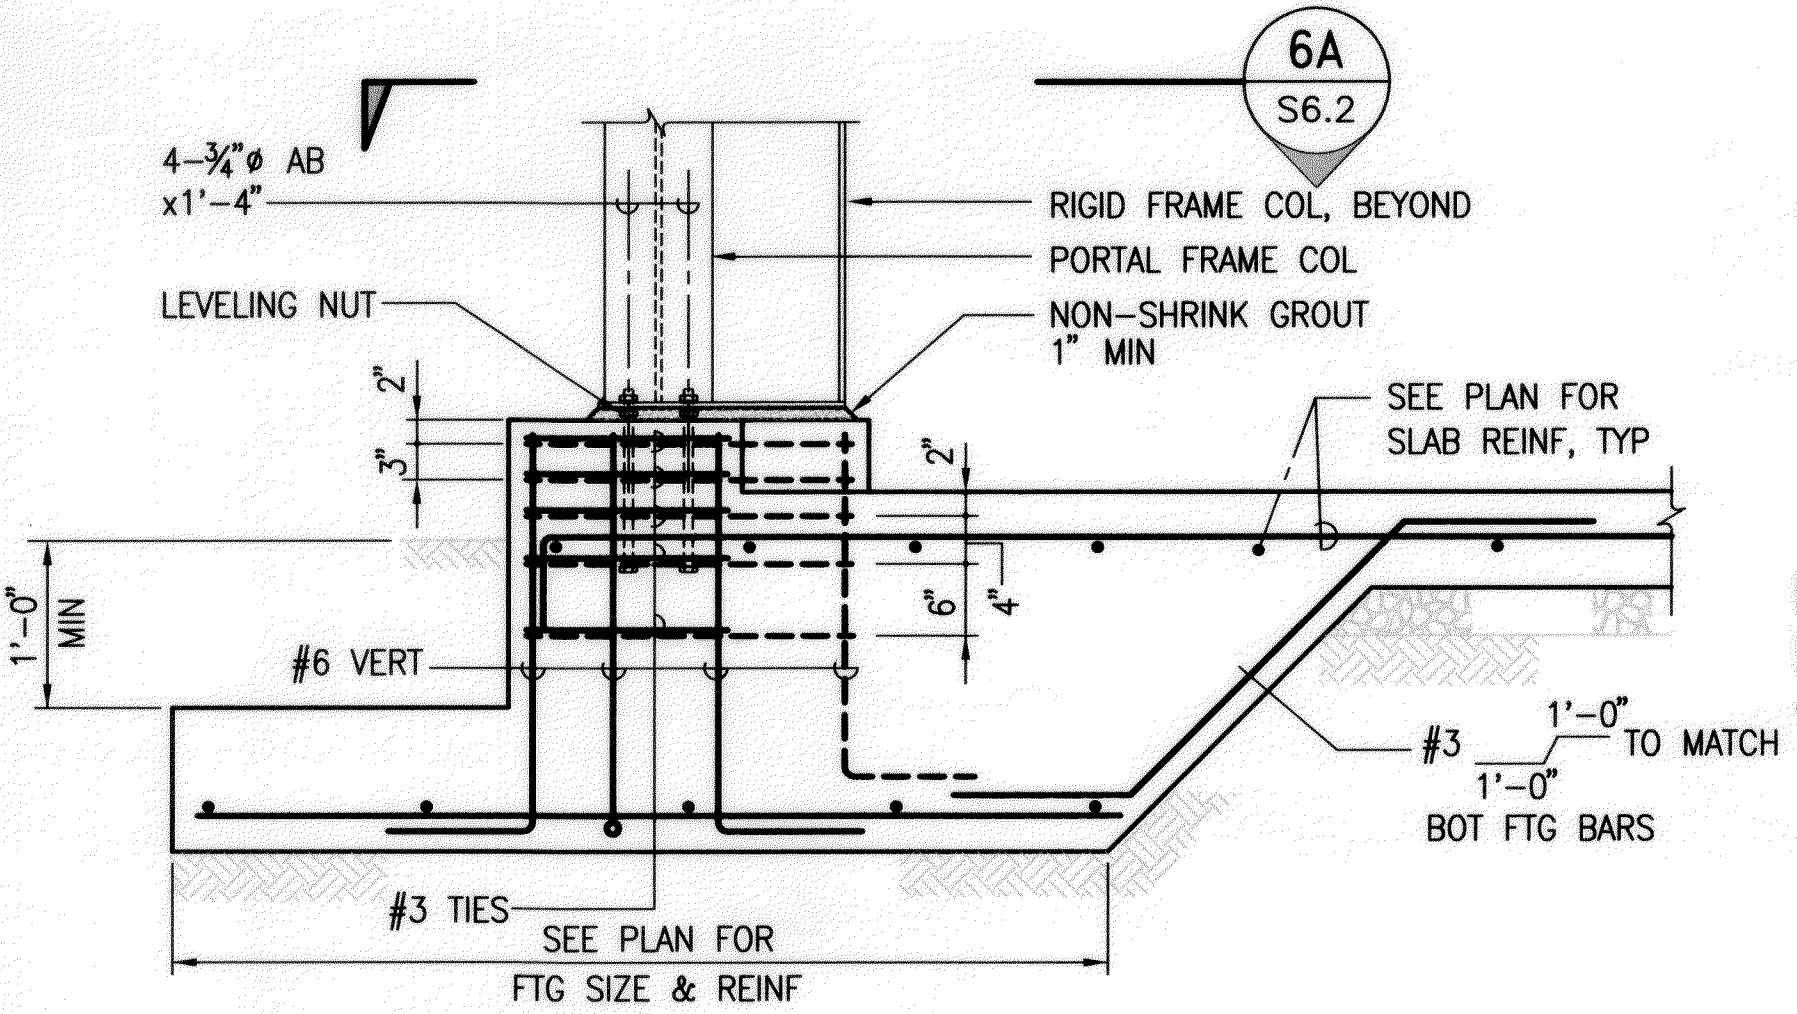

6 SECTION
S6.2 SCALE: 3/4"=1'-0"

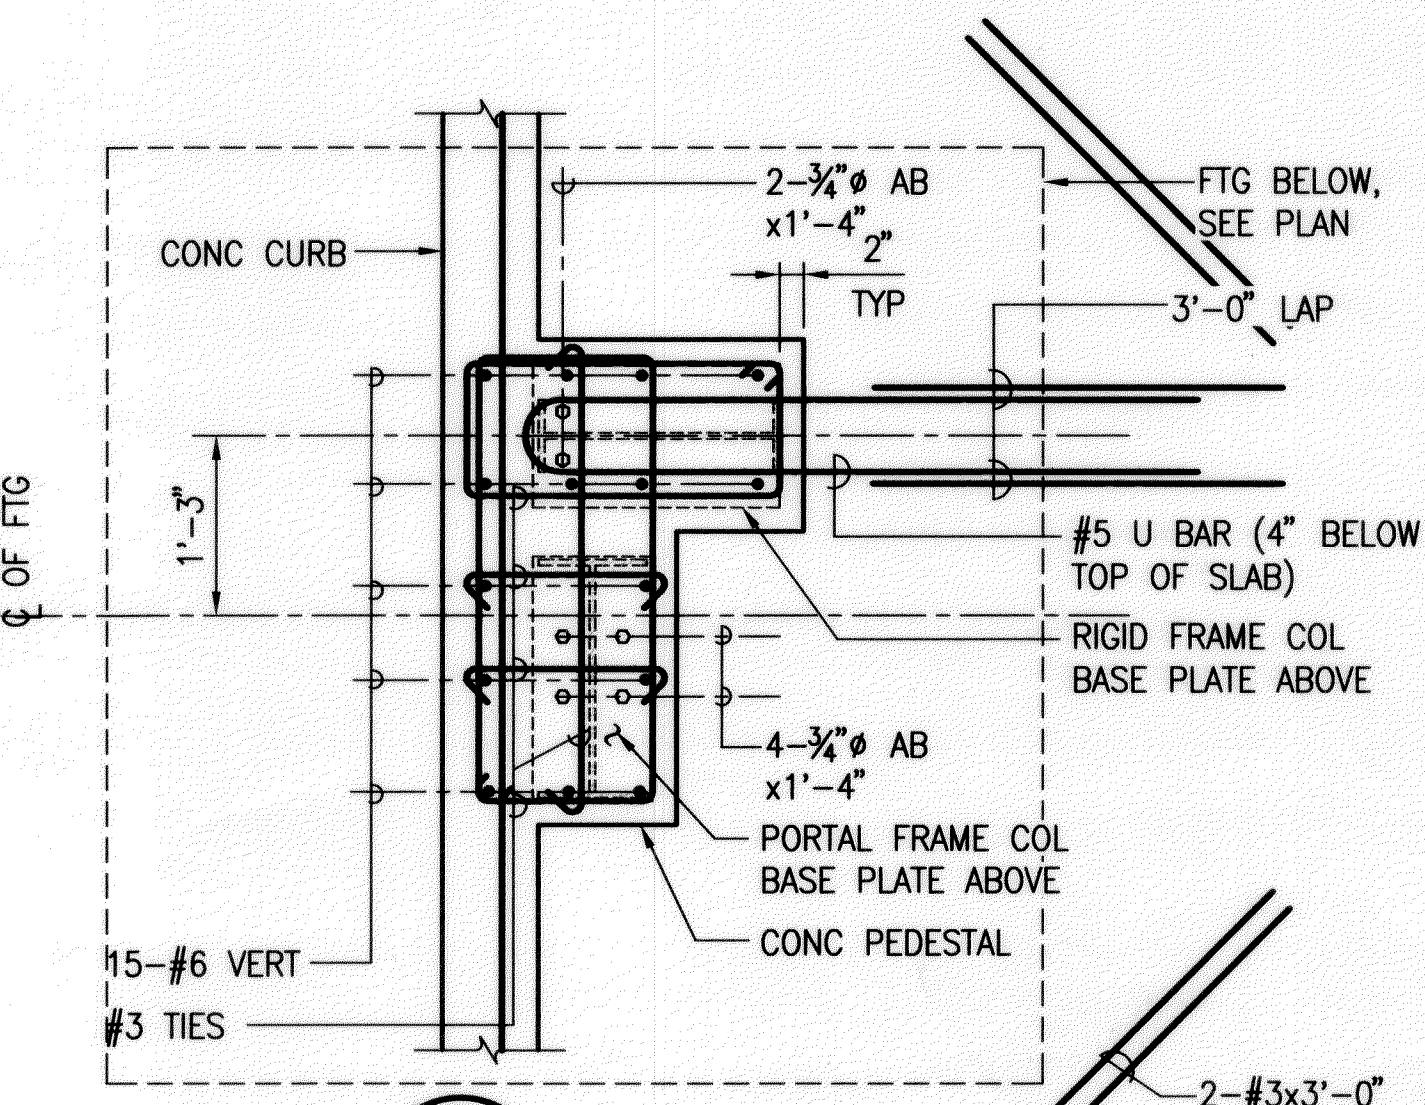

6A DETAIL PLAN
S6.2 SCALE: 3/4"=1'-0"

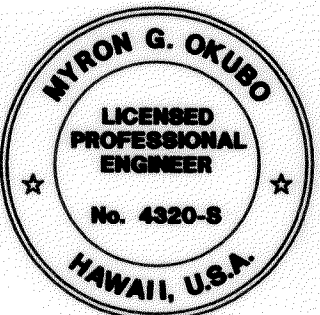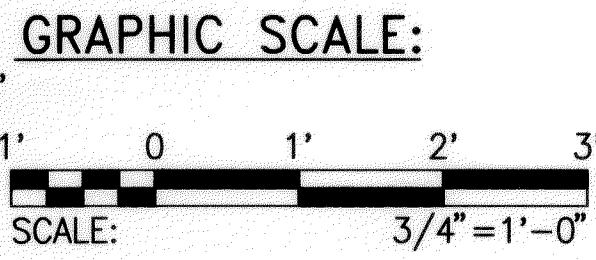

THIS WORK WAS PREPARED BY
ME OR UNDER MY SUPERVISION

Myron Okubo

TYPICAL INSTALLATION

STATE OF HAWAII
DEPARTMENT OF TRANSPORTATION
HIGHWAYS DIVISION
FOUNDATION DETAILS

MOLOKAI BASEYARD
MOLOKAI INDUSTRIAL PARK
Project No. HWY-M-05-98
Scale: As Noted Date: SEPT. 13, 2001
SHEET No. S6.2 OF S6.2 SHEETS

THIS WORK WAS PREPARED BY
ME OR UNDER MY SUPERVISION

Myron Okubo

SURVEY PLOTTED BY	DATE
DESIGNED BY	
TRACED BY	
NOTED BY	
CHECKED BY	
QUANTITIES BY	
NO.	

04/03/00 M:\DWG\6143-01\STRUCT 6143520.DWG 08:29

"AS-BUILT"