



FED. ROAD DIST. NO.	STATE	FED. AID PROJ. NO.	FISCAL YEAR	SHEET NO.	TOTAL SHEETS
HAWAII	HAW.	HWY-M-05-98	2002	73	99

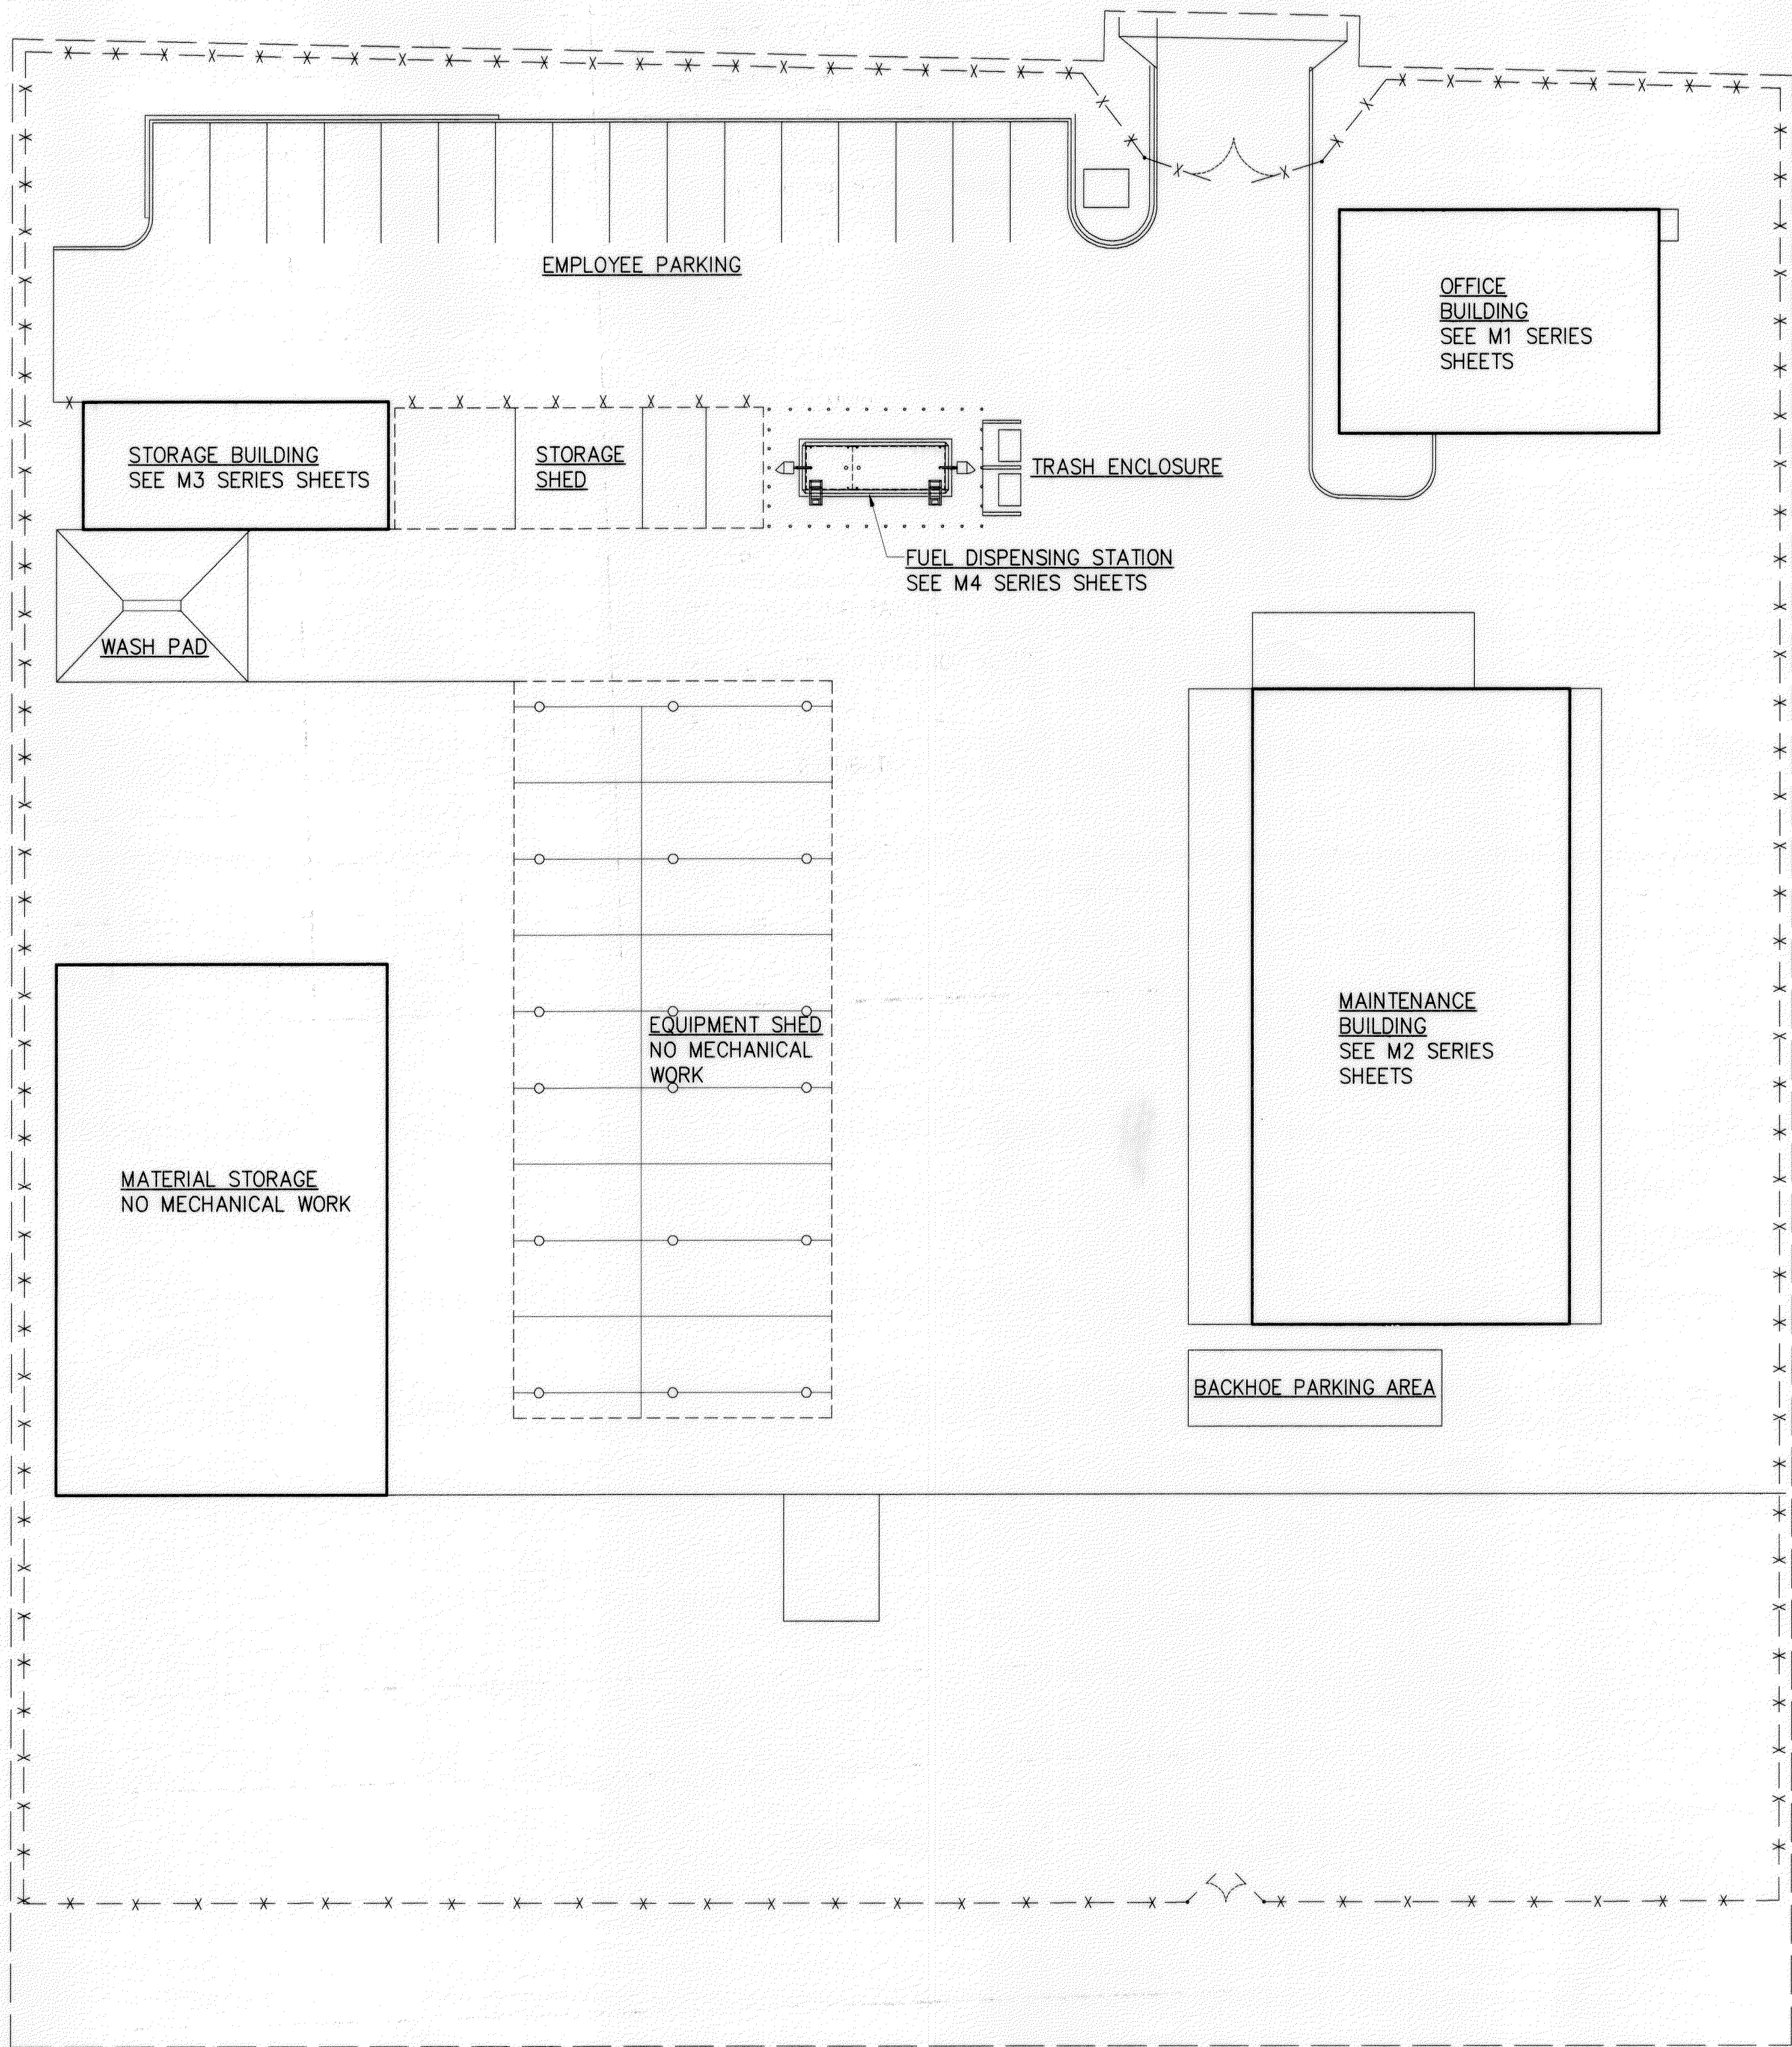


ORIGINAL PLAN	SURVEY PLOTTED BY	DATE
	DRAWN BY	
	TRACED BY	
	NOTED BY	
NOTEBOOK	QUANTITIES BY	
	CHECKED BY	
	No.	

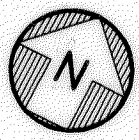

MECHANICAL SITE PLAN
SCALE: 1" = 20'

GRAPHIC SCALE

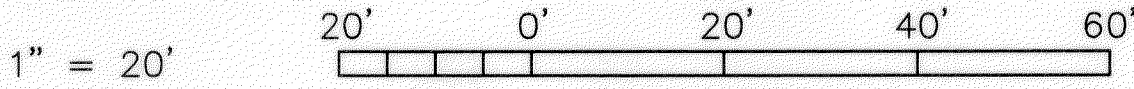

THIS WORK WAS PREPARED BY
ME OR UNDER MY SUPERVISION
[Signature]

STATE OF HAWAII
DEPARTMENT OF TRANSPORTATION
HIGHWAYS DIVISION

MECHANICAL SITE PLAN

MOLOKAI BASEYARD
MOLOKAI INDUSTRIAL PARK
Project No. HWY-M-05-98

Scale: As Noted Date: SEPT 13, 2001

SHEET No. 73 OF 99 SHEETS

MECHANICAL SITE PLAN