
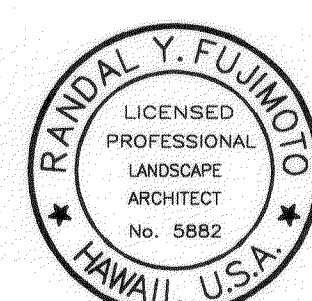


FED. ROAD DIST. NO.	STATE	FED. AID PROJ. NO.	FISCAL YEAR	SHEET NO.	TOTAL SHEETS
HAWAII	HAW.	HWY-M-05-98	2002	25	99

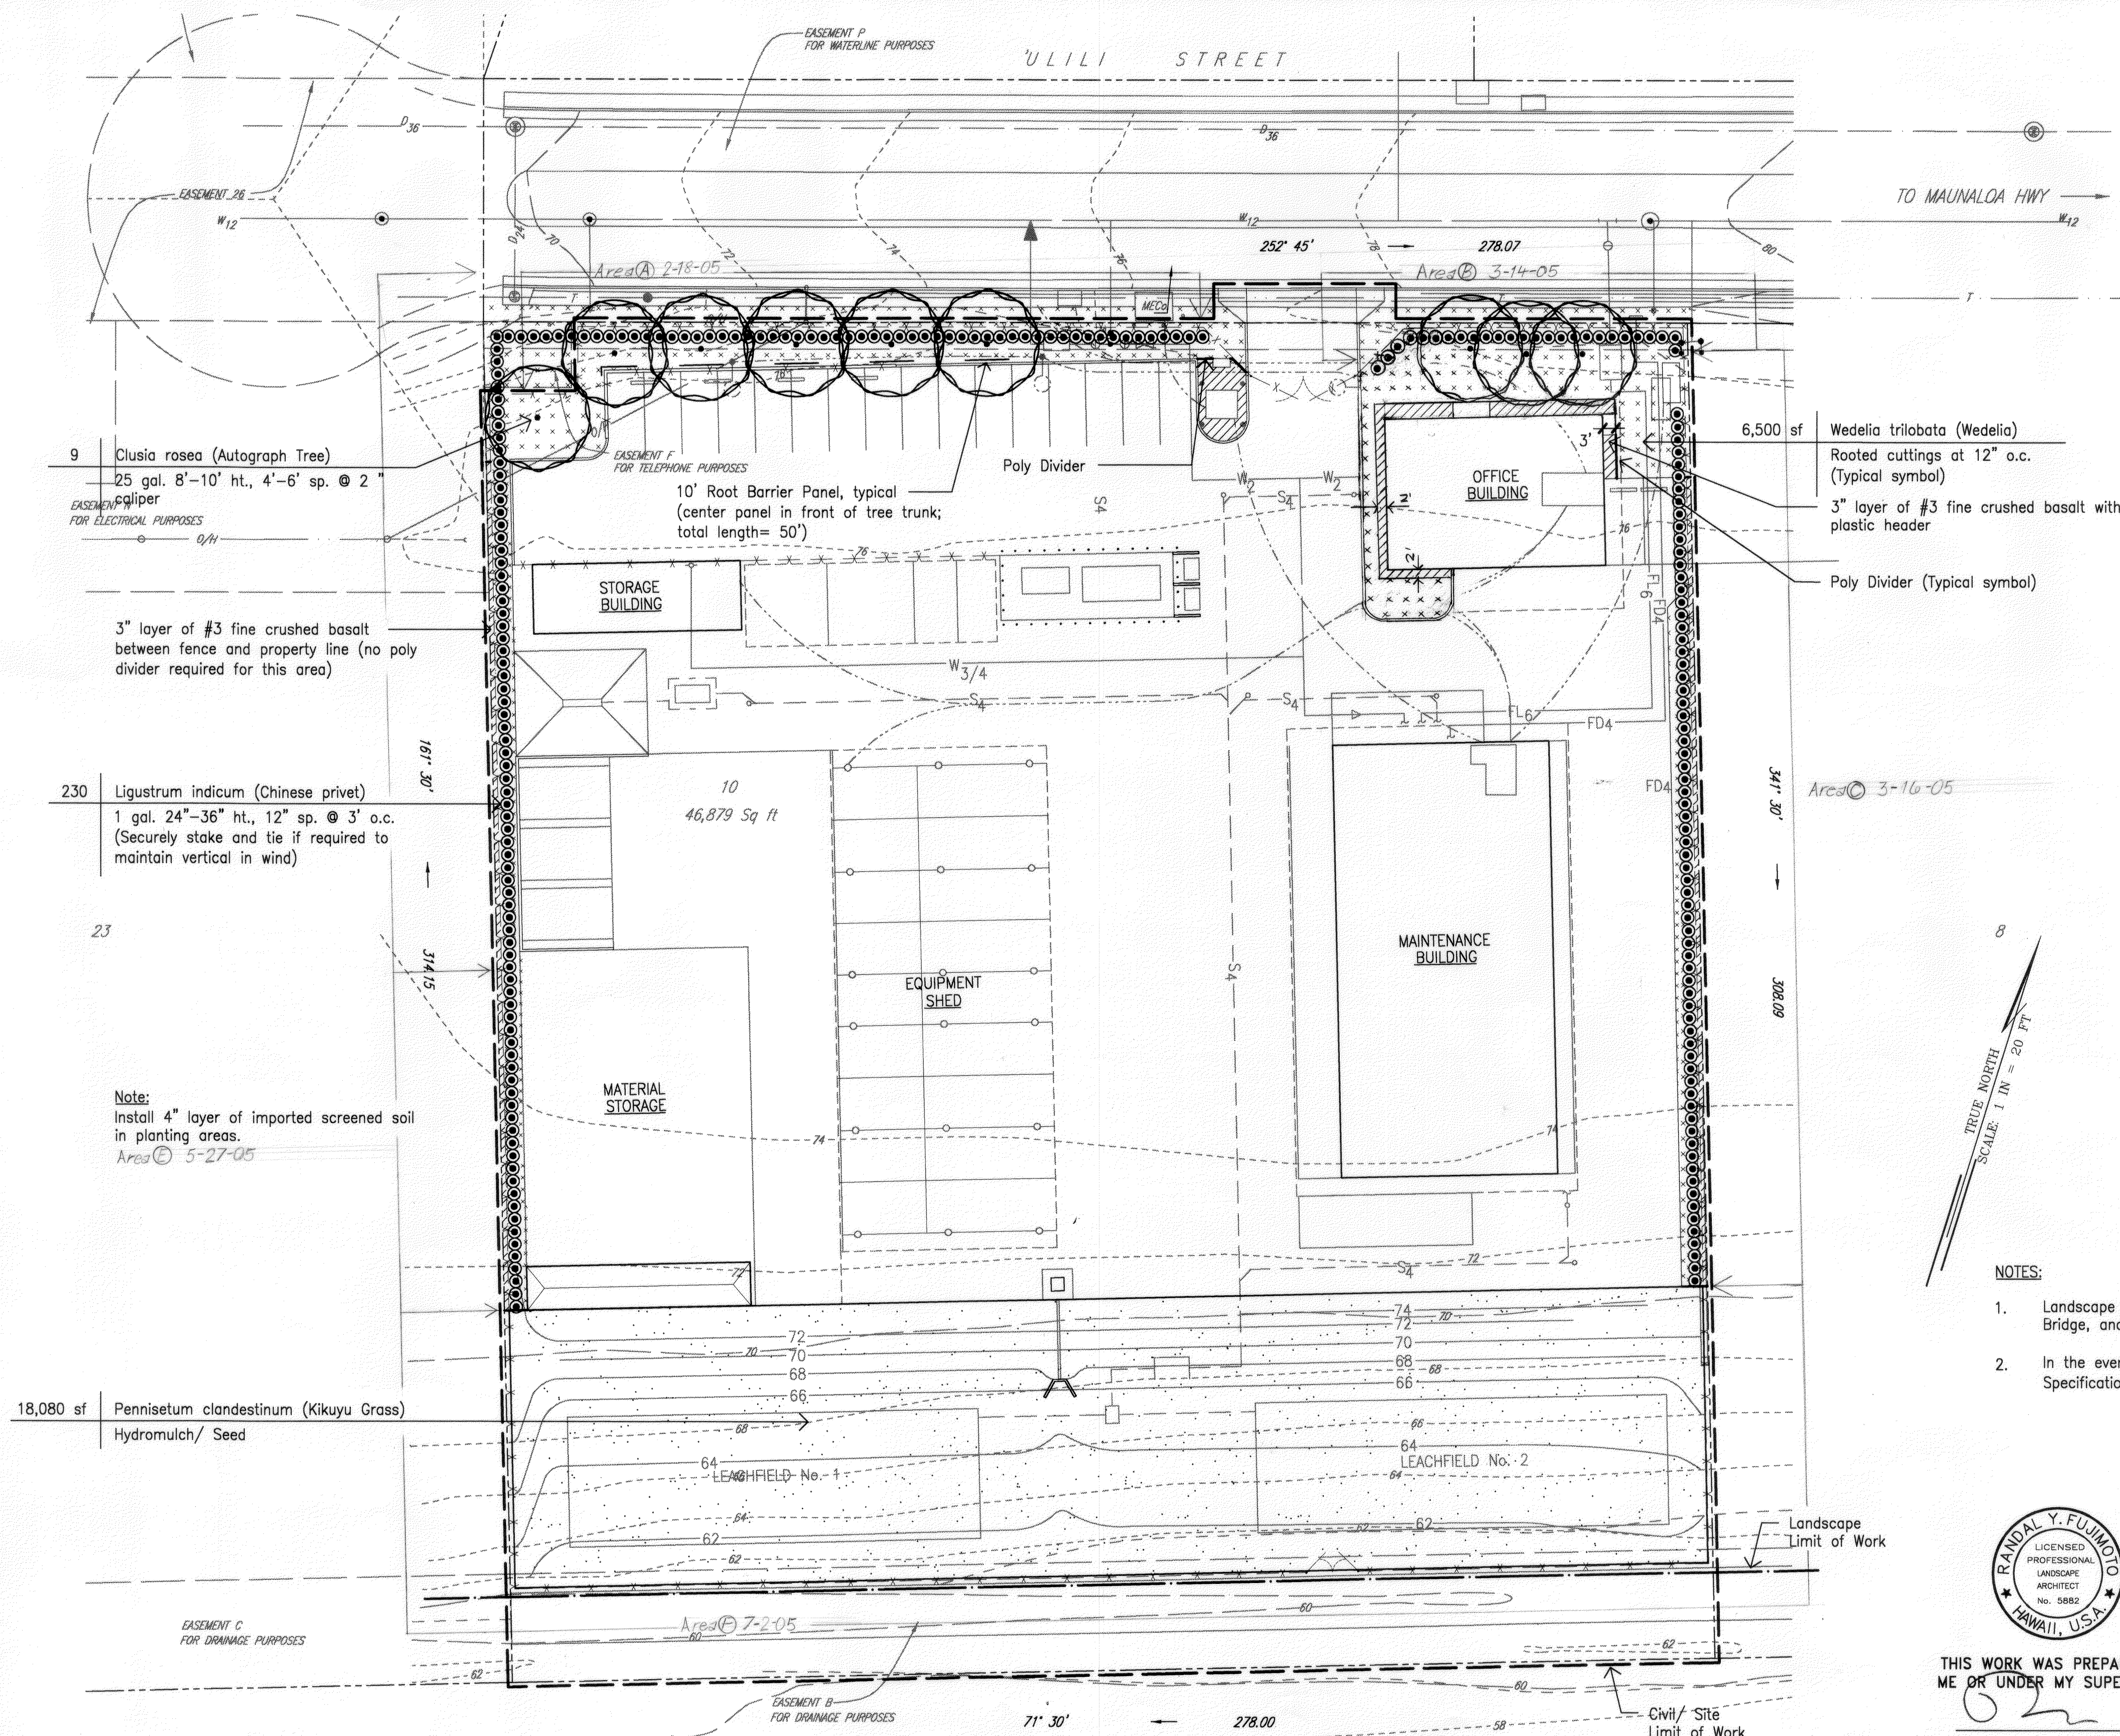

THIS WORK WAS PREPARED BY ME OR UNDER MY SUPERVISION

62

- NOTES:
- Landscape planting shall conform to Hawaii "Standard Specifications" for Road, Bridge, and Public Works Construction, 1994.
 - In the event there is a discrepancy between the drawing and "Standard Specifications", the specifications shall prevail.

DATE	REVISION
	STATE OF HAWAII DEPARTMENT OF TRANSPORTATION HIGHWAYS DIVISION PLANTING PLAN MOLOKAI BASE YARD MOLOKAI INDUSTRIAL PARK Project No. HWY-M-05-98 TMK: 2-5-2-31: LOTS 9 & 10 Scale: As Noted Date: September 13, 2001
SHEET No. L-2 OF L-4 SHEETS	

SURVEY PLOTTED BY	HONOLULU
DRAWN BY	DS
DESIGNED BY	RT
QUANTITIES BY	RT
CHECKED BY	RT
No.	

"AS-BUILT"