


FED. ROAD DIST. NO.	STATE	FED. AID PROJ. NO.	FISCAL YEAR	SHEET NO.	TOTAL SHEETS
HAWAII	HAW.	HWY-M-05-98	2002	7	99

LEGEND

	PROJECT LIMIT
	PROPERTY LINE
	NEW CHAIN LINK FENCE
	NEW BUILDING
	NEW CONCRETE SLAB
	COMPACTED BASE COURSE SURFACE
	LANDSCAPED AREA
	COVERED PARKING OR NEW BUILDING (DEDUCTIVE ALTERNATIVE)
	ROOF LINE ABOVE

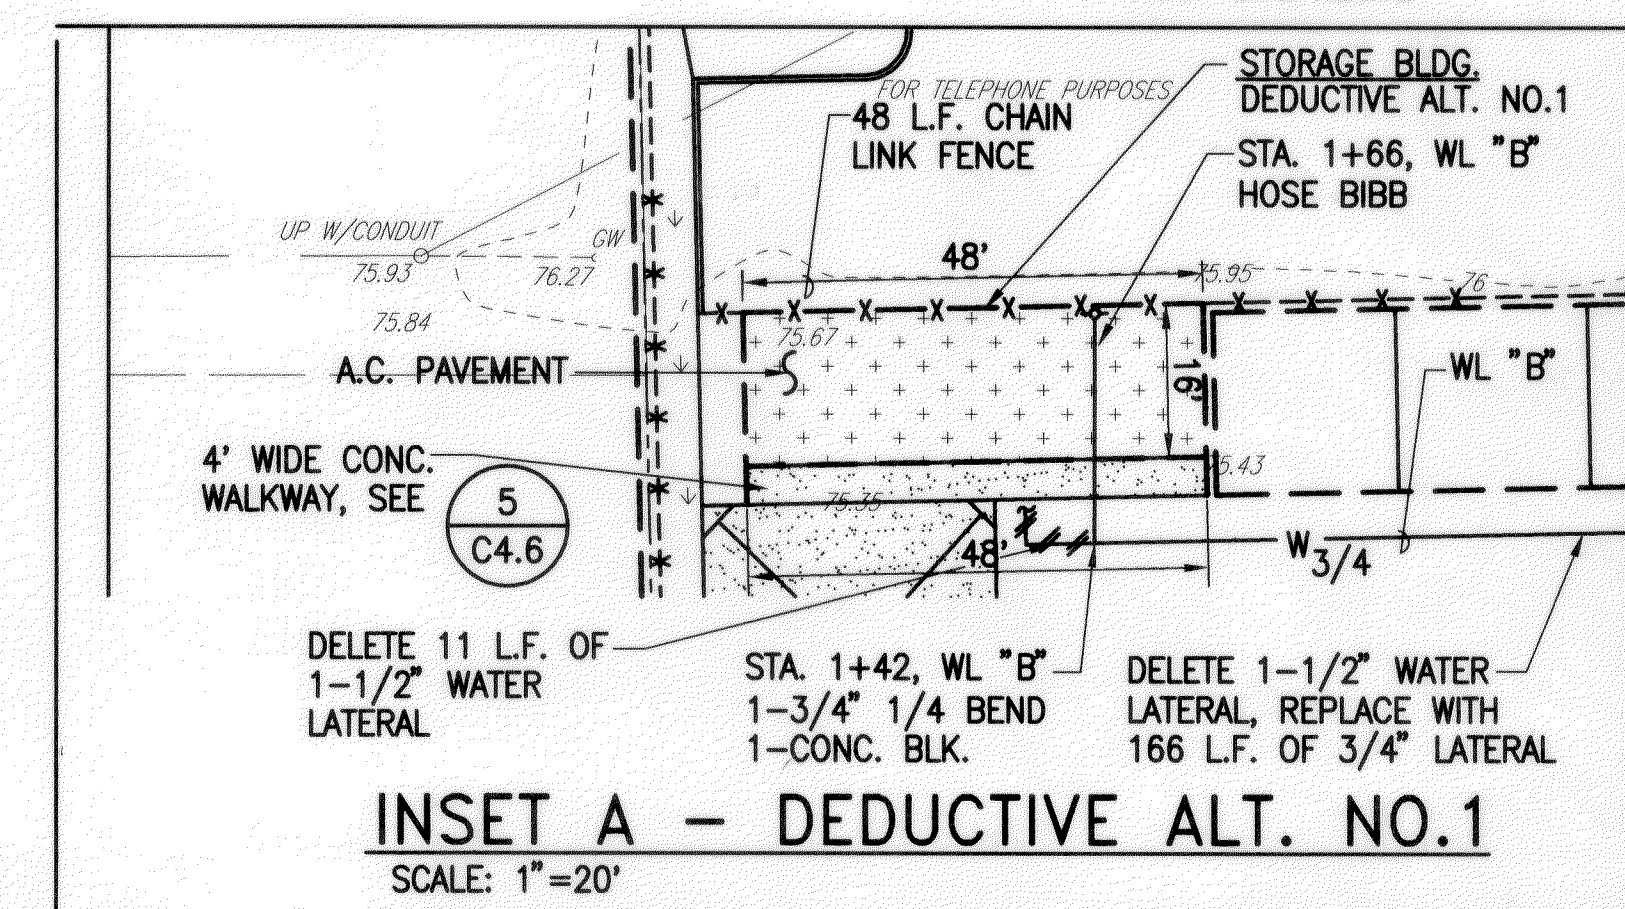

NOTES

1. DEDUCTIVE ALTERNATIVE NO. 1 CONSISTS OF DELETING THE STORAGE BUILDING AS SHOWN ON THE PLANS. SEE ARCHITECTURAL DRAWINGS FOR DETAILS. THE DEDUCTION OF THE STORAGE BUILDING REQUIRES ADDITION OF A.C. PAVEMENT AT THE BUILDING LOCATION, PORTION OF THE 6' HIGH CHAIN LINK FENCE BEHIND THE BUILDING, AND 166 L.F. OF 3/4" WATER LATERAL AND HOSE BIBB CONNECTION. SEE INSET A. THE DELETION OF THE STORAGE BUILDING REQUIRES DELETING THE 1-1/2" WATER LATERAL AND ADDING THE 3/4" LATERAL. SEE INSET A FOR DETAILS.
2. DEDUCTIVE ALTERNATIVE NO. 2 CONSISTS OF DELETING A ROOF TO THE STORAGE SHED AREA. THE DEDUCTION OF ALTERNATIVE NO. 2 DOES NOT REQUIRE ADDITIONAL CIVIL WORK.
3. DEDUCTIVE ALTERNATIVE NO. 5 CONSISTS OF DELETING A ROOF TO THE EQUIPMENT SHED AREA. THE DEDUCTION OF ALTERNATIVE NO. 5 DOES NOT REQUIRE ADDITIONAL CIVIL WORK.

DATE	REVISION


STATE OF HAWAII
DEPARTMENT OF TRANSPORTATION
HIGHWAYS DIVISION

SITE LAYOUT

MOLOKAI BASEYARD
MOLOKAI INDUSTRIAL PARK
Project No. HWY-M-05-98



Scale: As Noted Date: Sept. 13, 2001

SHEET No. C2.0 OF C2.2 SHEETS

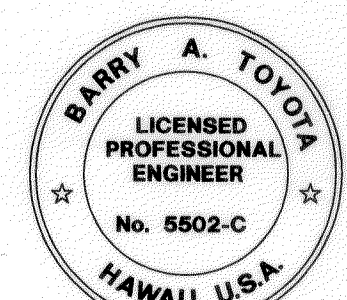

THIS WORK WAS PREPARED BY ME OR UNDER MY SUPERVISION

[Signature]

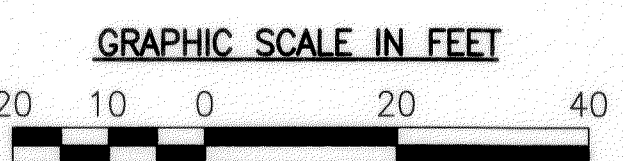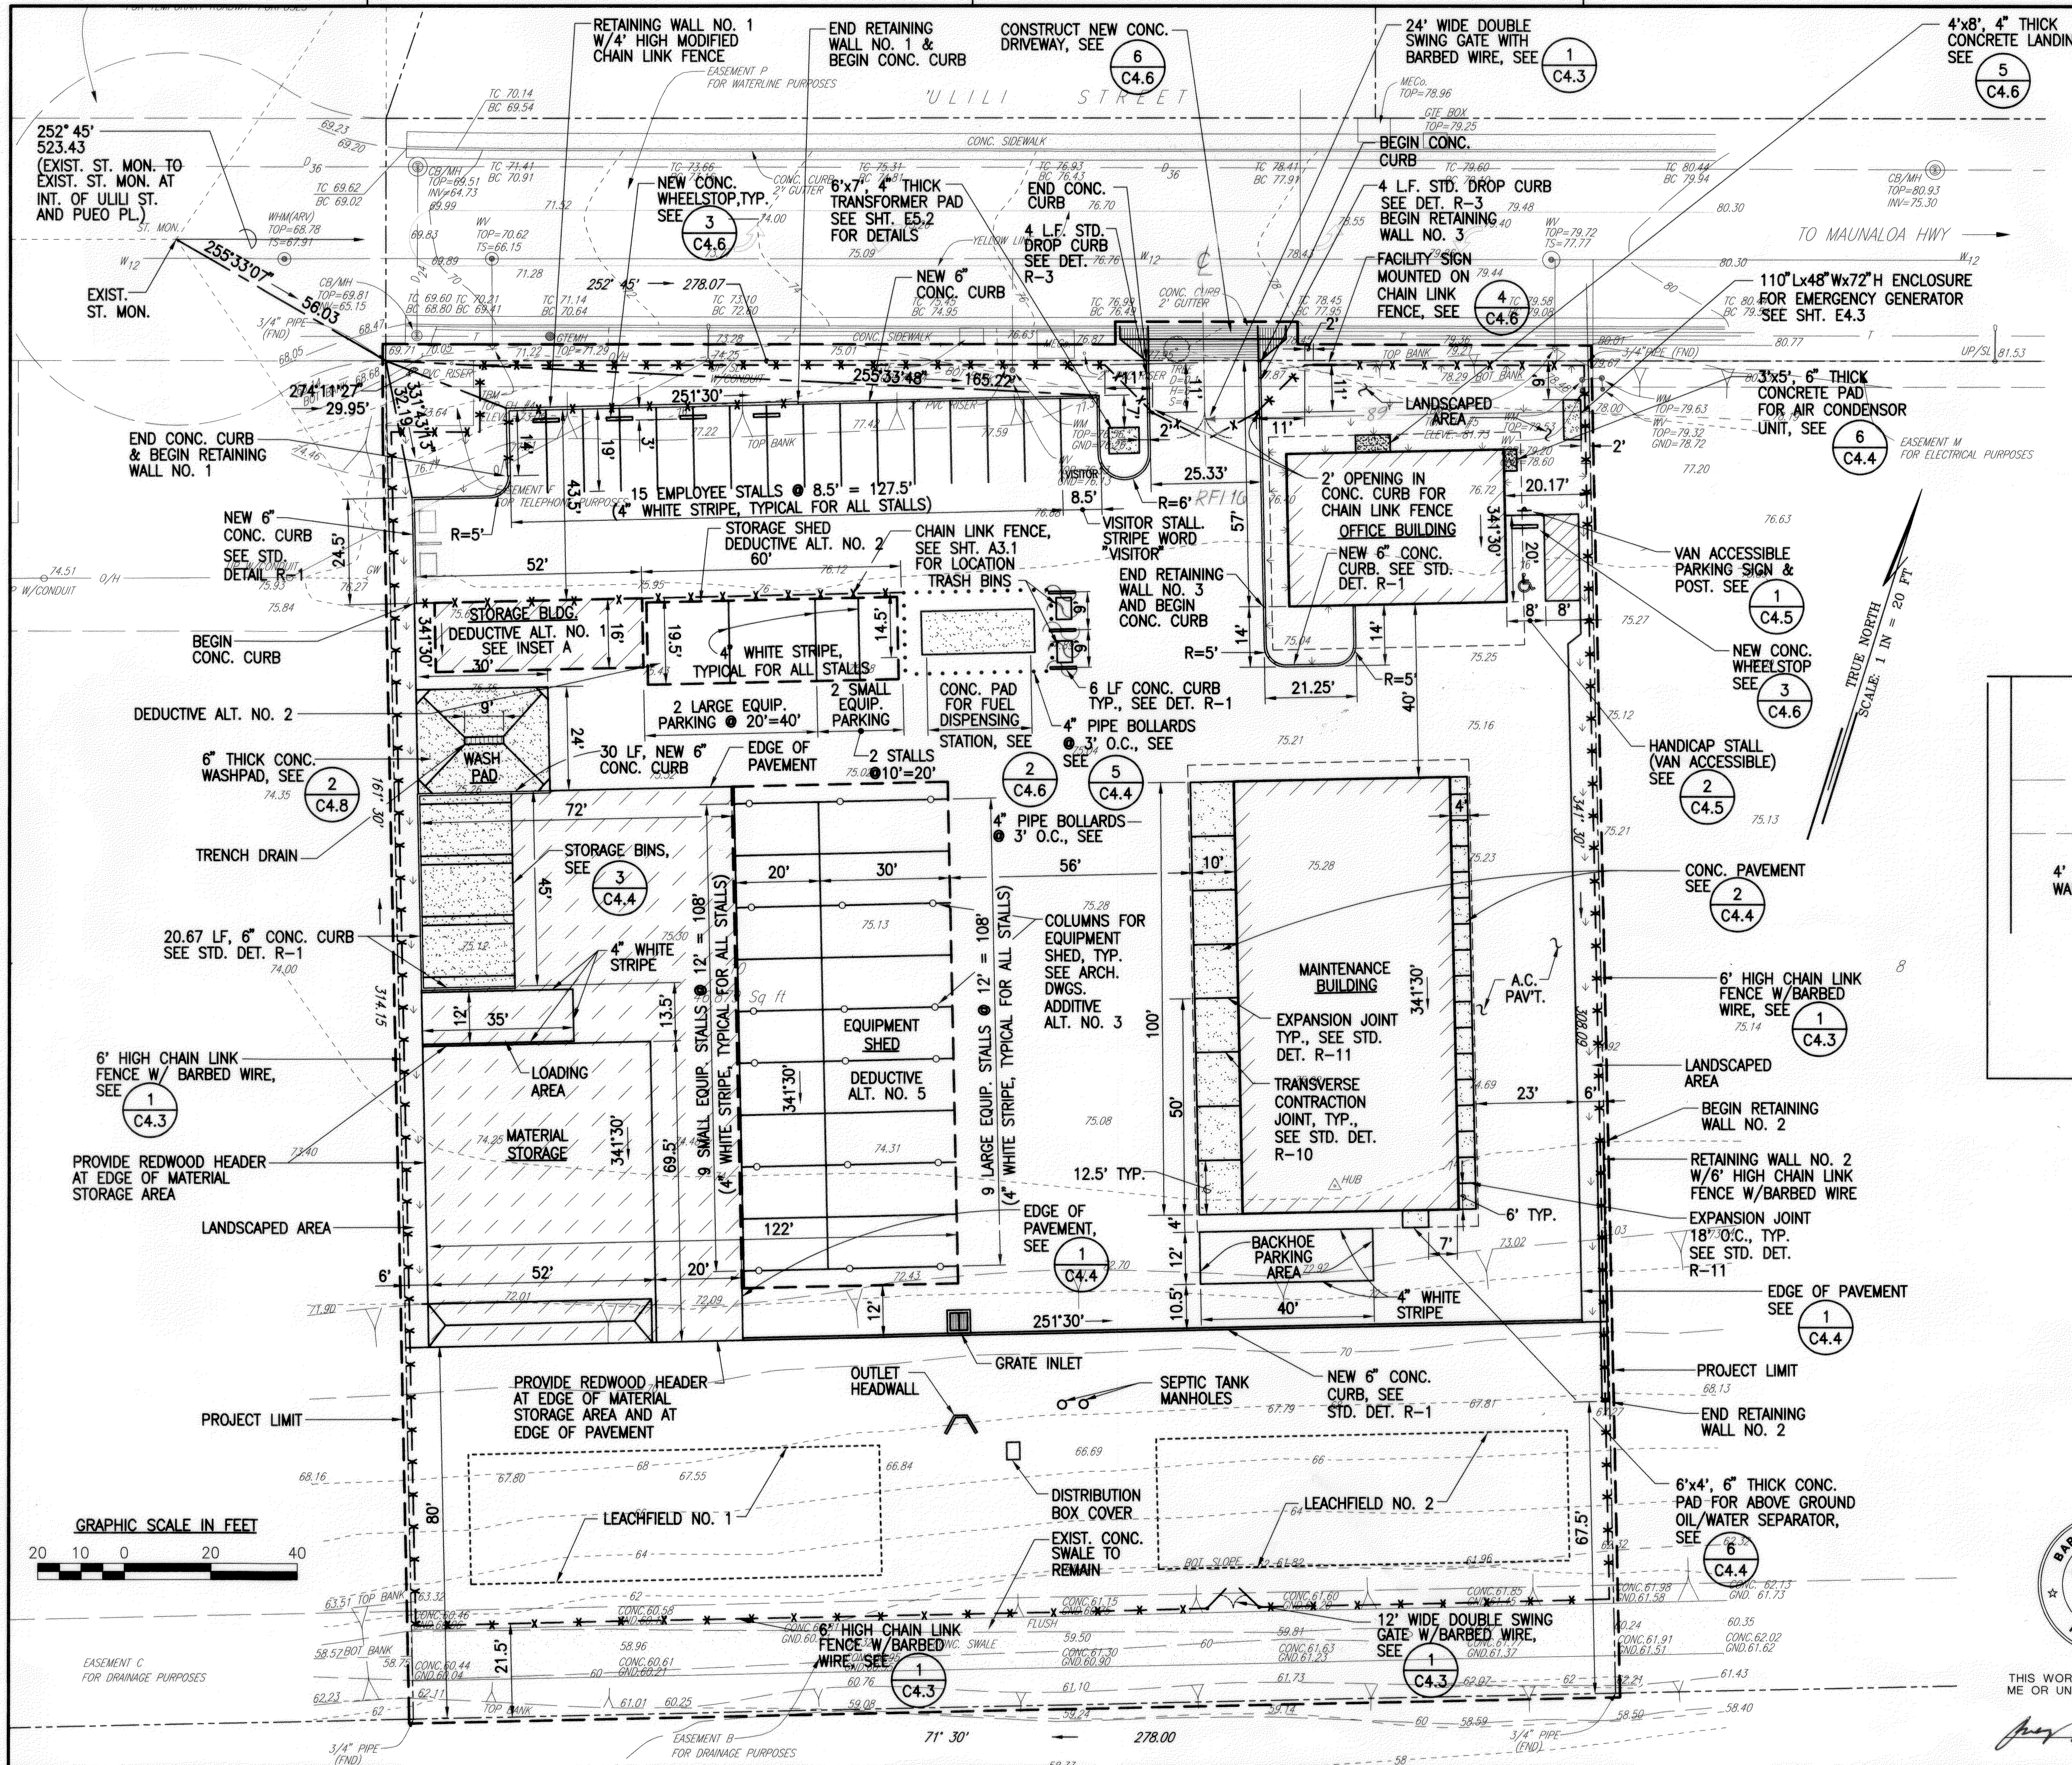

SURVEY PLOTTED BY	DATE
DRAWN BY	
DESIGNED BY	
QUANTITIES BY	
CHECKED BY	

"AS-BUILT"