


STATE OF HAWAII  
DEPARTMENT OF TRANSPORTATION  
HIGHWAYS DIVISION

HONOLULU, HAWAII  
"AS-BUILT"  
PLANS FOR

MOLOKAI BASEYARD


CHANGES MADE DURING CONSTRUCTION HAVE BEEN INCORPORATED  
ON THESE PLANS EXCET CHANGES IN THE ORIGINAL THEORETICAL  
QUANTITIES. FOR ACTUAL QUANTITIES, REFER TO PROJECT LEDGER  
AND/OR COMPUTATION BOOK.

  
RESIDENT ENGINEER  
Jul 31, 2024  
DATE

MOLOKAI INDUSTRIAL PARK  
PROJECT NO. HWY-M-05-98  
DISTRICT OF MOLOKAI  
ISLAND OF MOLOKAI


FED. ROAD DIST. NO.	STATE	PROJ. NO.	FISCAL YEAR	SHEET NO.	TOTAL SHEETS
HAWAII	HAW.	HWY-M-05-98	2002	1	99

VICINITY MAP

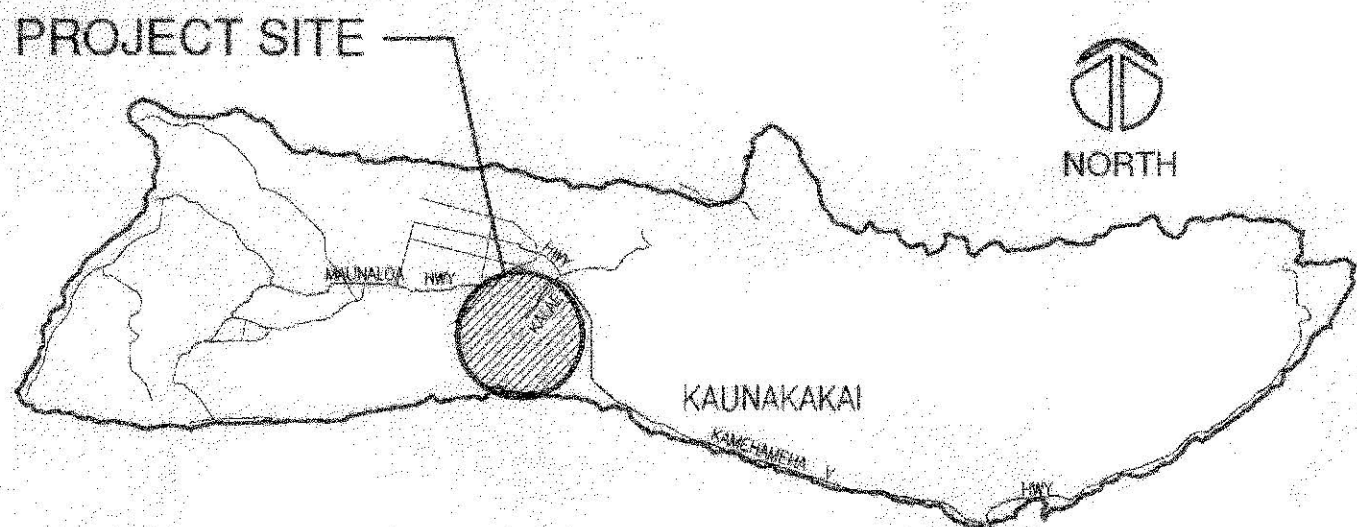

ISLAND OF MOLOKAI  
SCALE: NONE

LOCATION MAP

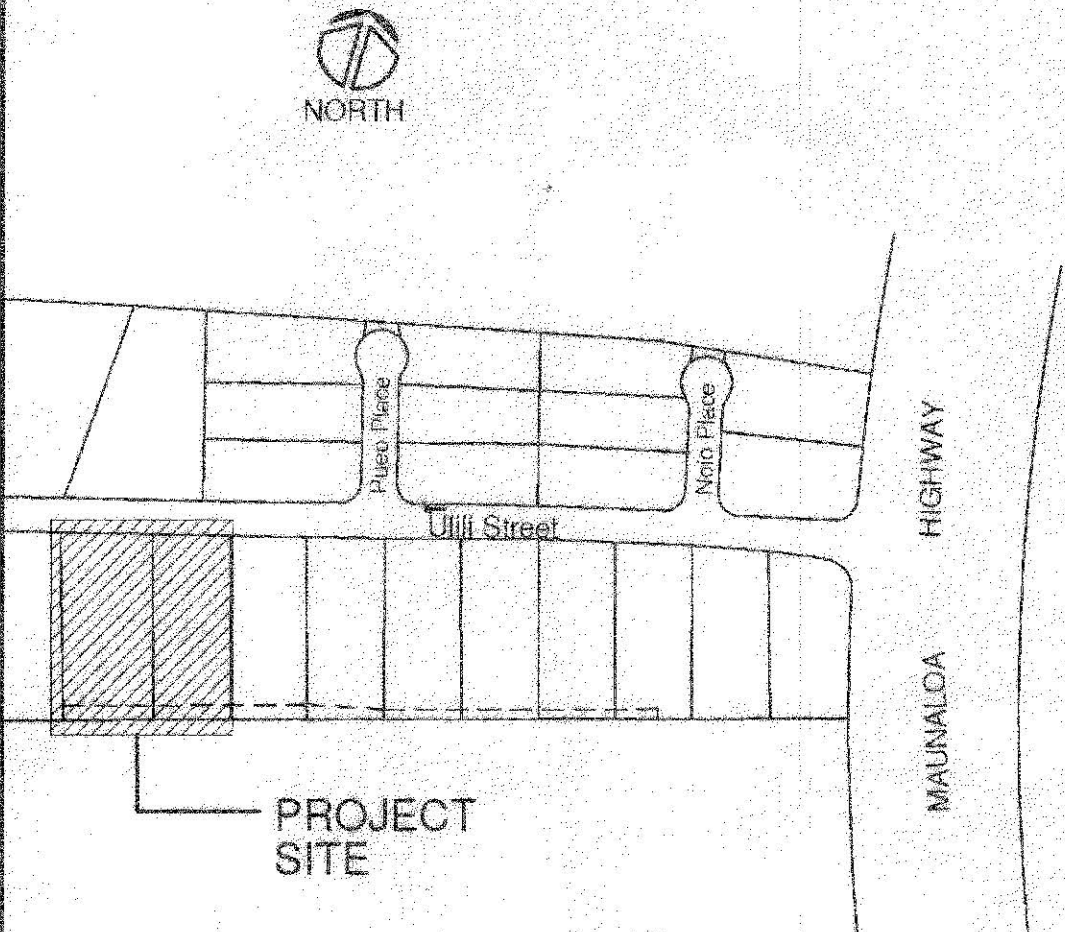

PALAAU, MOLOKAI  
SCALE: NONE

CONSULTANTS

ARCHITECT/ENGINEERS:  
WILSON OKAMOTO & ASSOCIATES, INC.  
PHONE: 808 946-2277 FAX: 808 946-2253 E-MAIL: woa@aloha.net

MECHANICAL ENGINEERS:  
THERMAL ENGINEERING CORPORATION  
PHONE: 808 848-6966/848-7833 FAX: 808 848-6964 E-MAIL: mashima@thermaleng.com

FIRE PROTECTION:  
S. S. DANNAWAY & ASSOCIATES, INC.  
PHONE: 808 526-9019 FAX: 808 537-5385 E-MAIL: fpeam@pxi.com


ELECTRICAL ENGINEERS:  
NAKAMURA, OYAMA & ASSOCIATES, INC.  
PHONE: 808 591-8887 FAX: 808 596-2383 E-MAIL: noa@poi.net


LANDSCAPE ARCHITECT:  
RANDAL FUJIMOTO  
PHONE: 808 942-5553 FAX: 808 942-2228

TOPOGRAPHIC SURVEYING CONSULTANT:  
CONTROL POINT SURVEYING, INC.  
PHONE: 808 545-2945 FAX: 808 532-6020 E-MAIL: controlps001@hawaii.rr.com

GEOTECHNICAL CONSULTANT:  
GEOLABS - HAWAII  
PHONE: 808 841-5064 FAX: 808 847-1749 E-MAIL: geolabs@gte.net

APPROVALS

DEPARTMENT OF TRANSPORTATION STATE OF HAWAII	
APPROVED:  DIR. OF TRANSPORTATION	2/7/00 DATE

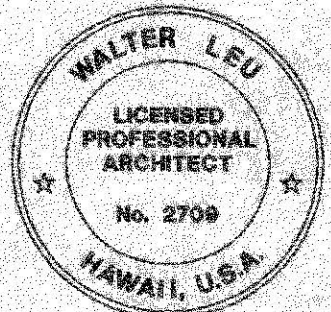

THIS WORK WAS PREPARED BY  
ME OR UNDER MY SUPERVISION