
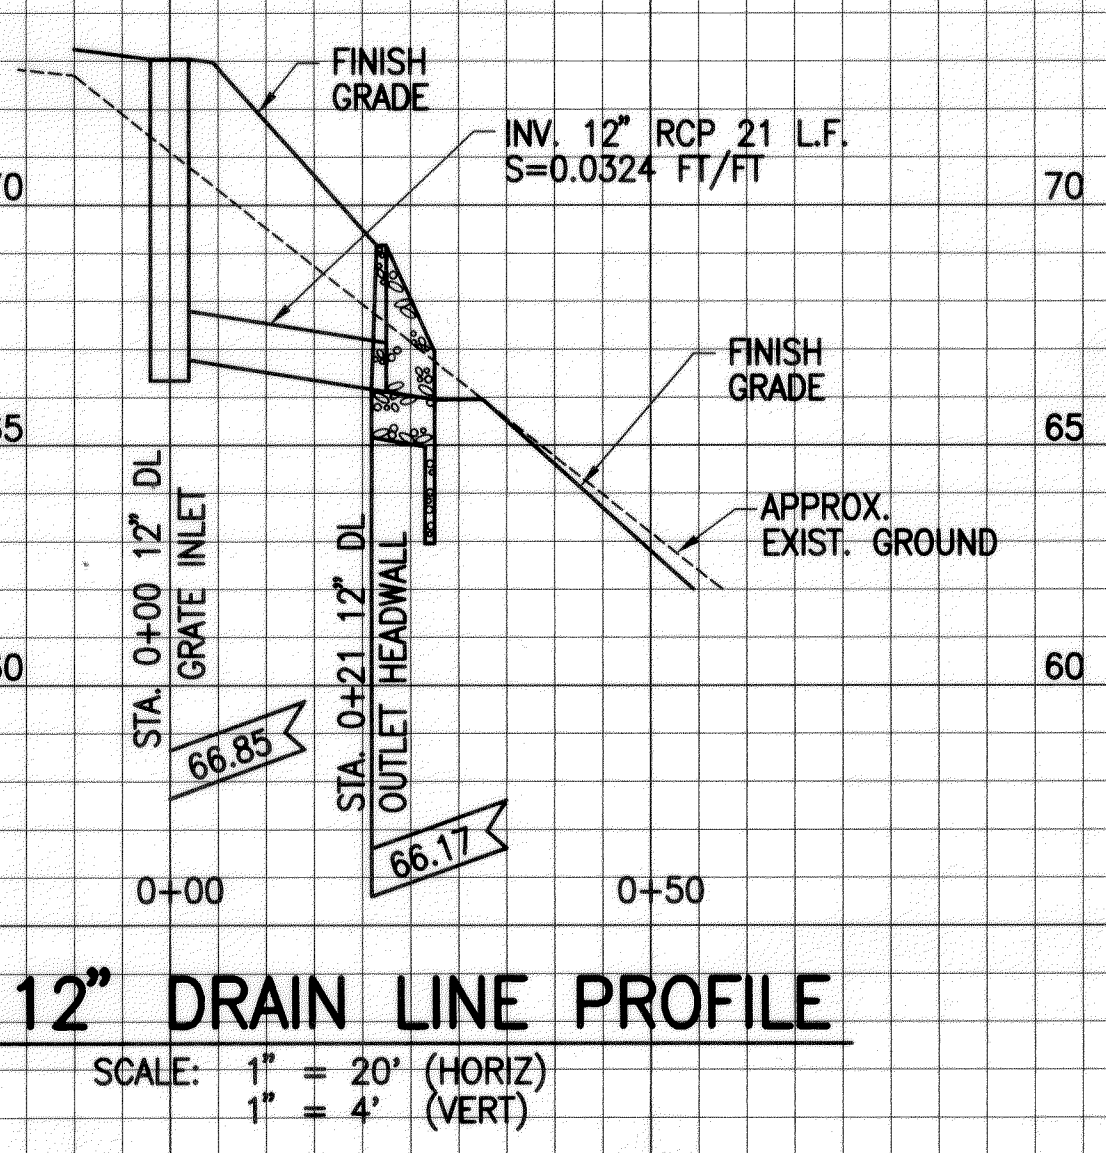
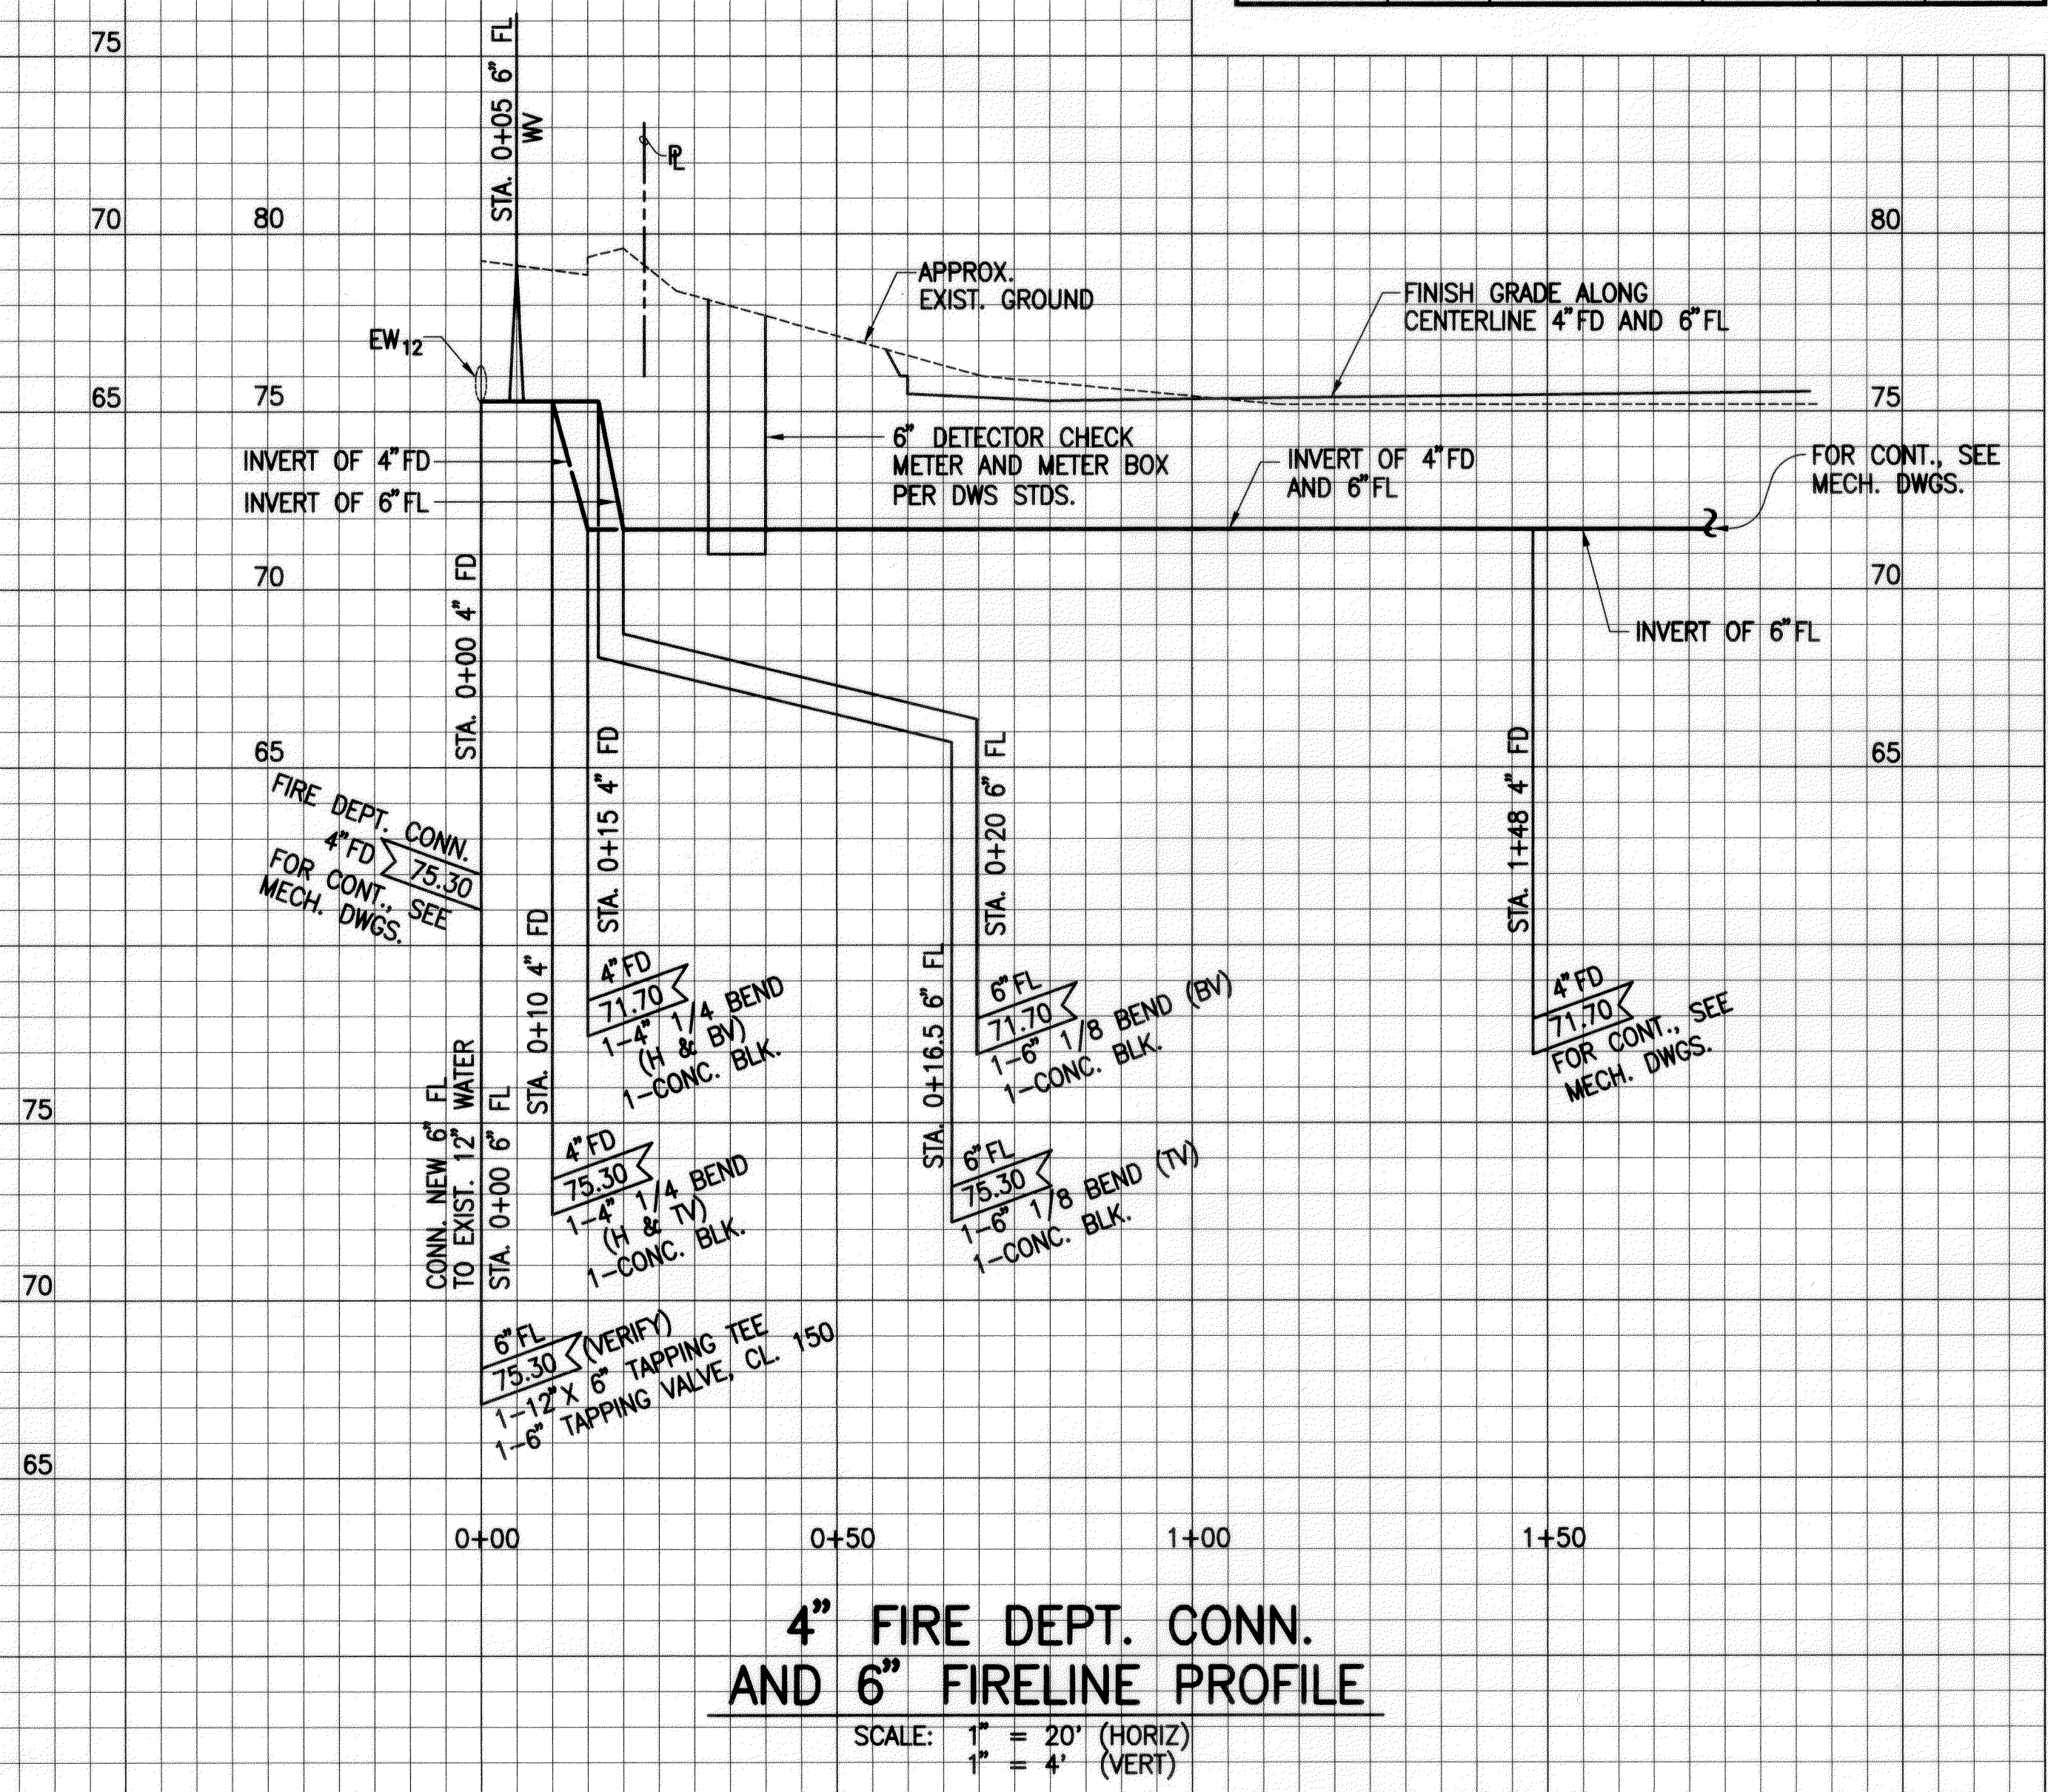
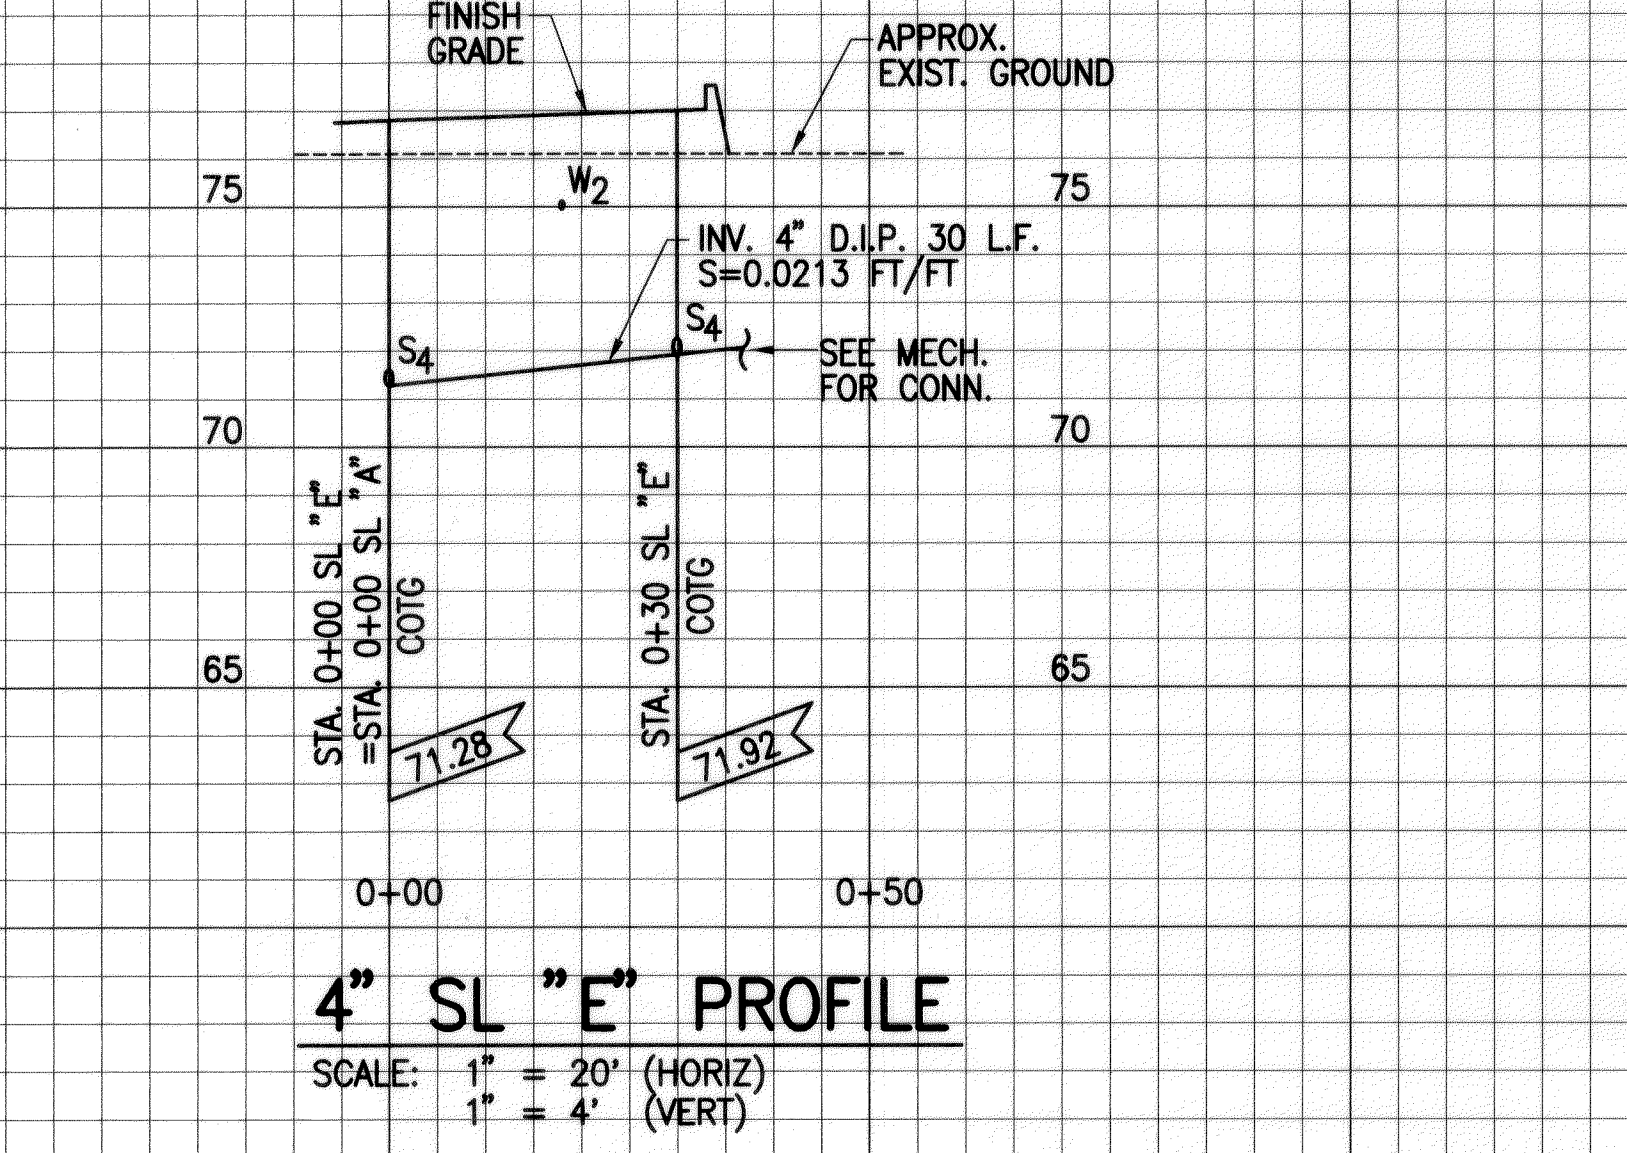
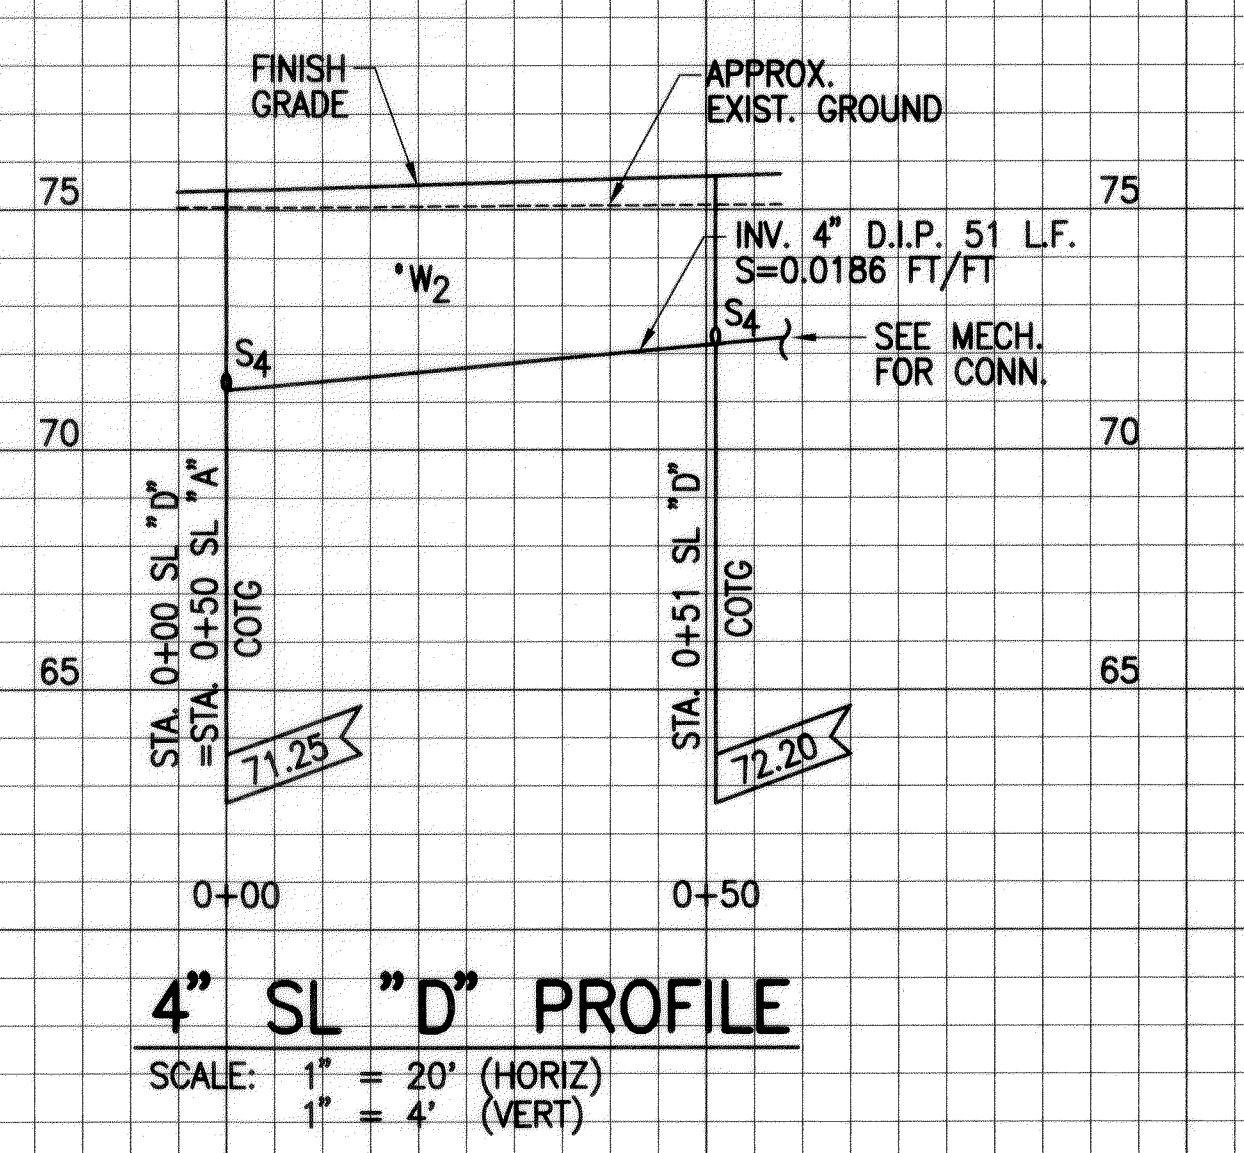
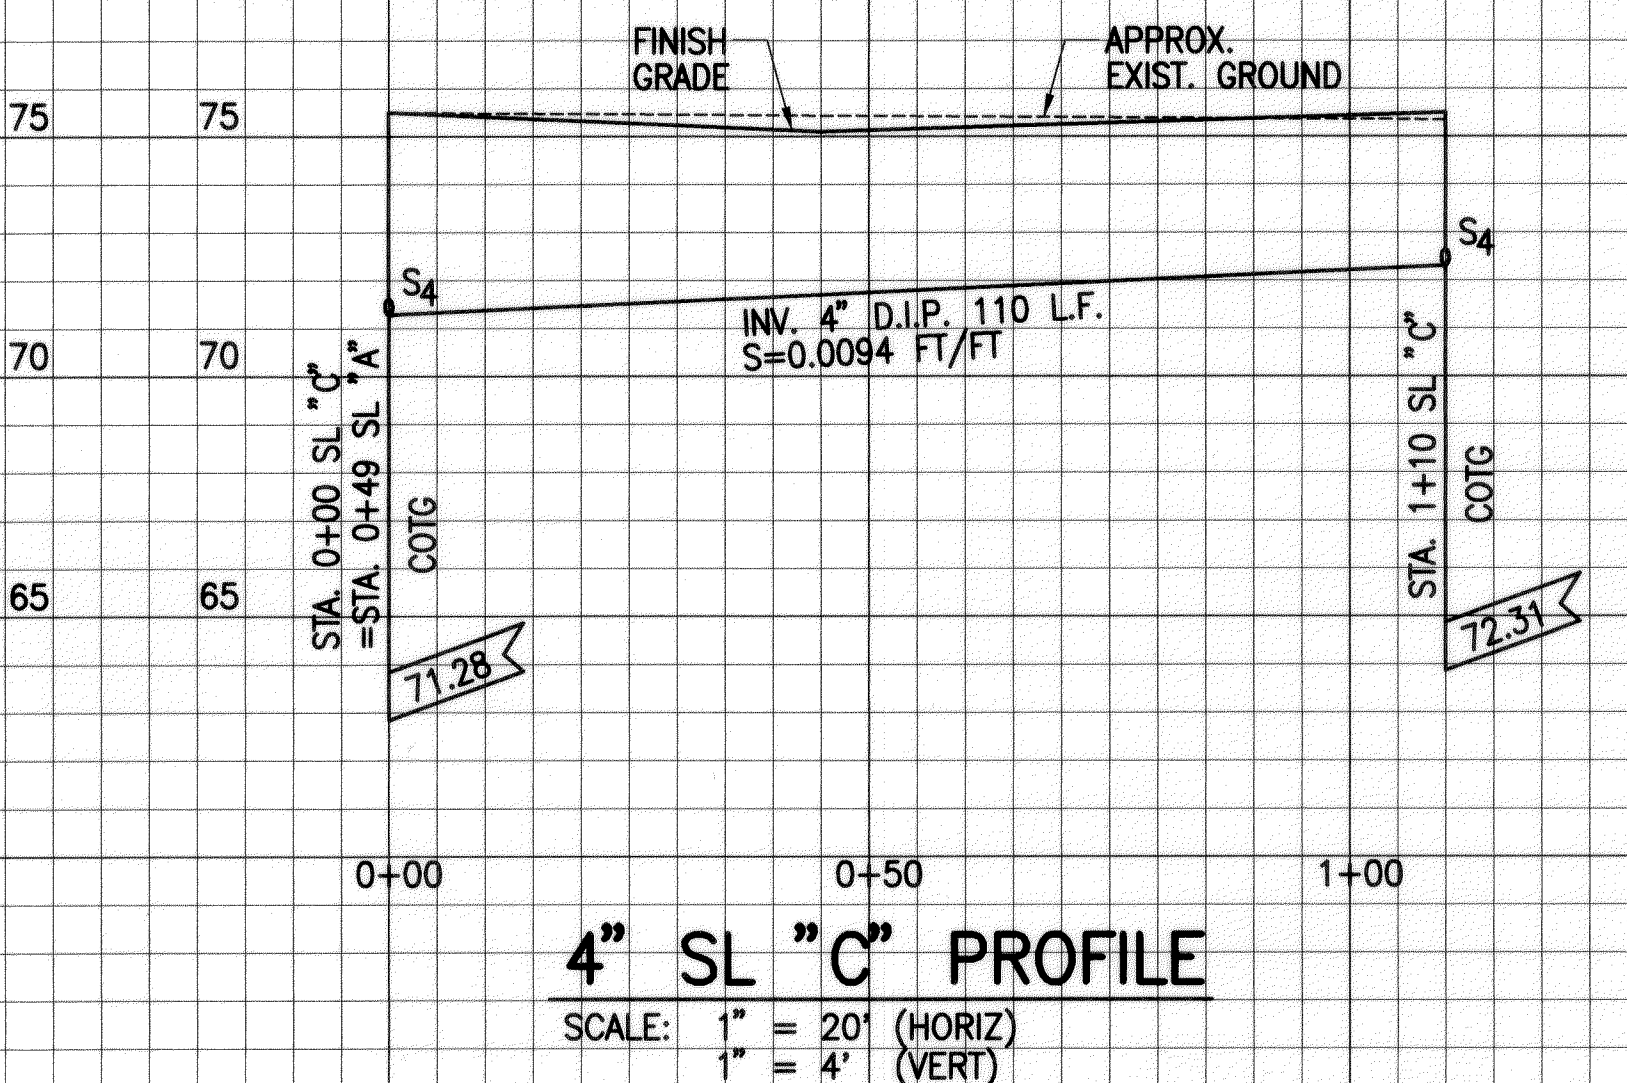
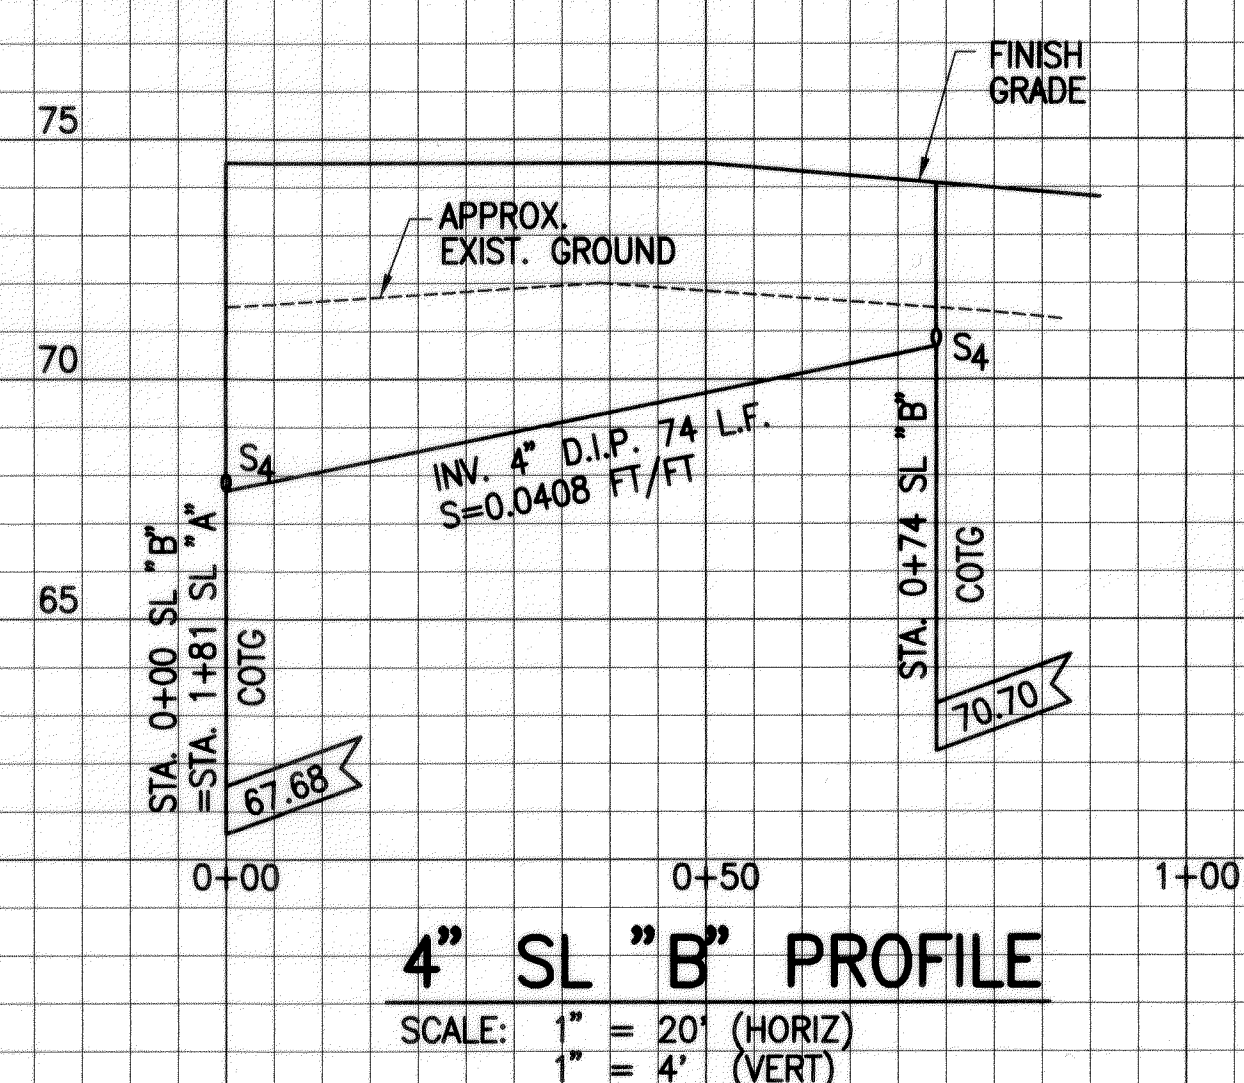


FED. ROAD DIST. NO.	STATE	FED. AID PROJ. NO.	FISCAL YEAR	SHEET NO.	TOTAL SHEETS
HAWAII	HAW.	HWY-M-05-98	2002	12	99

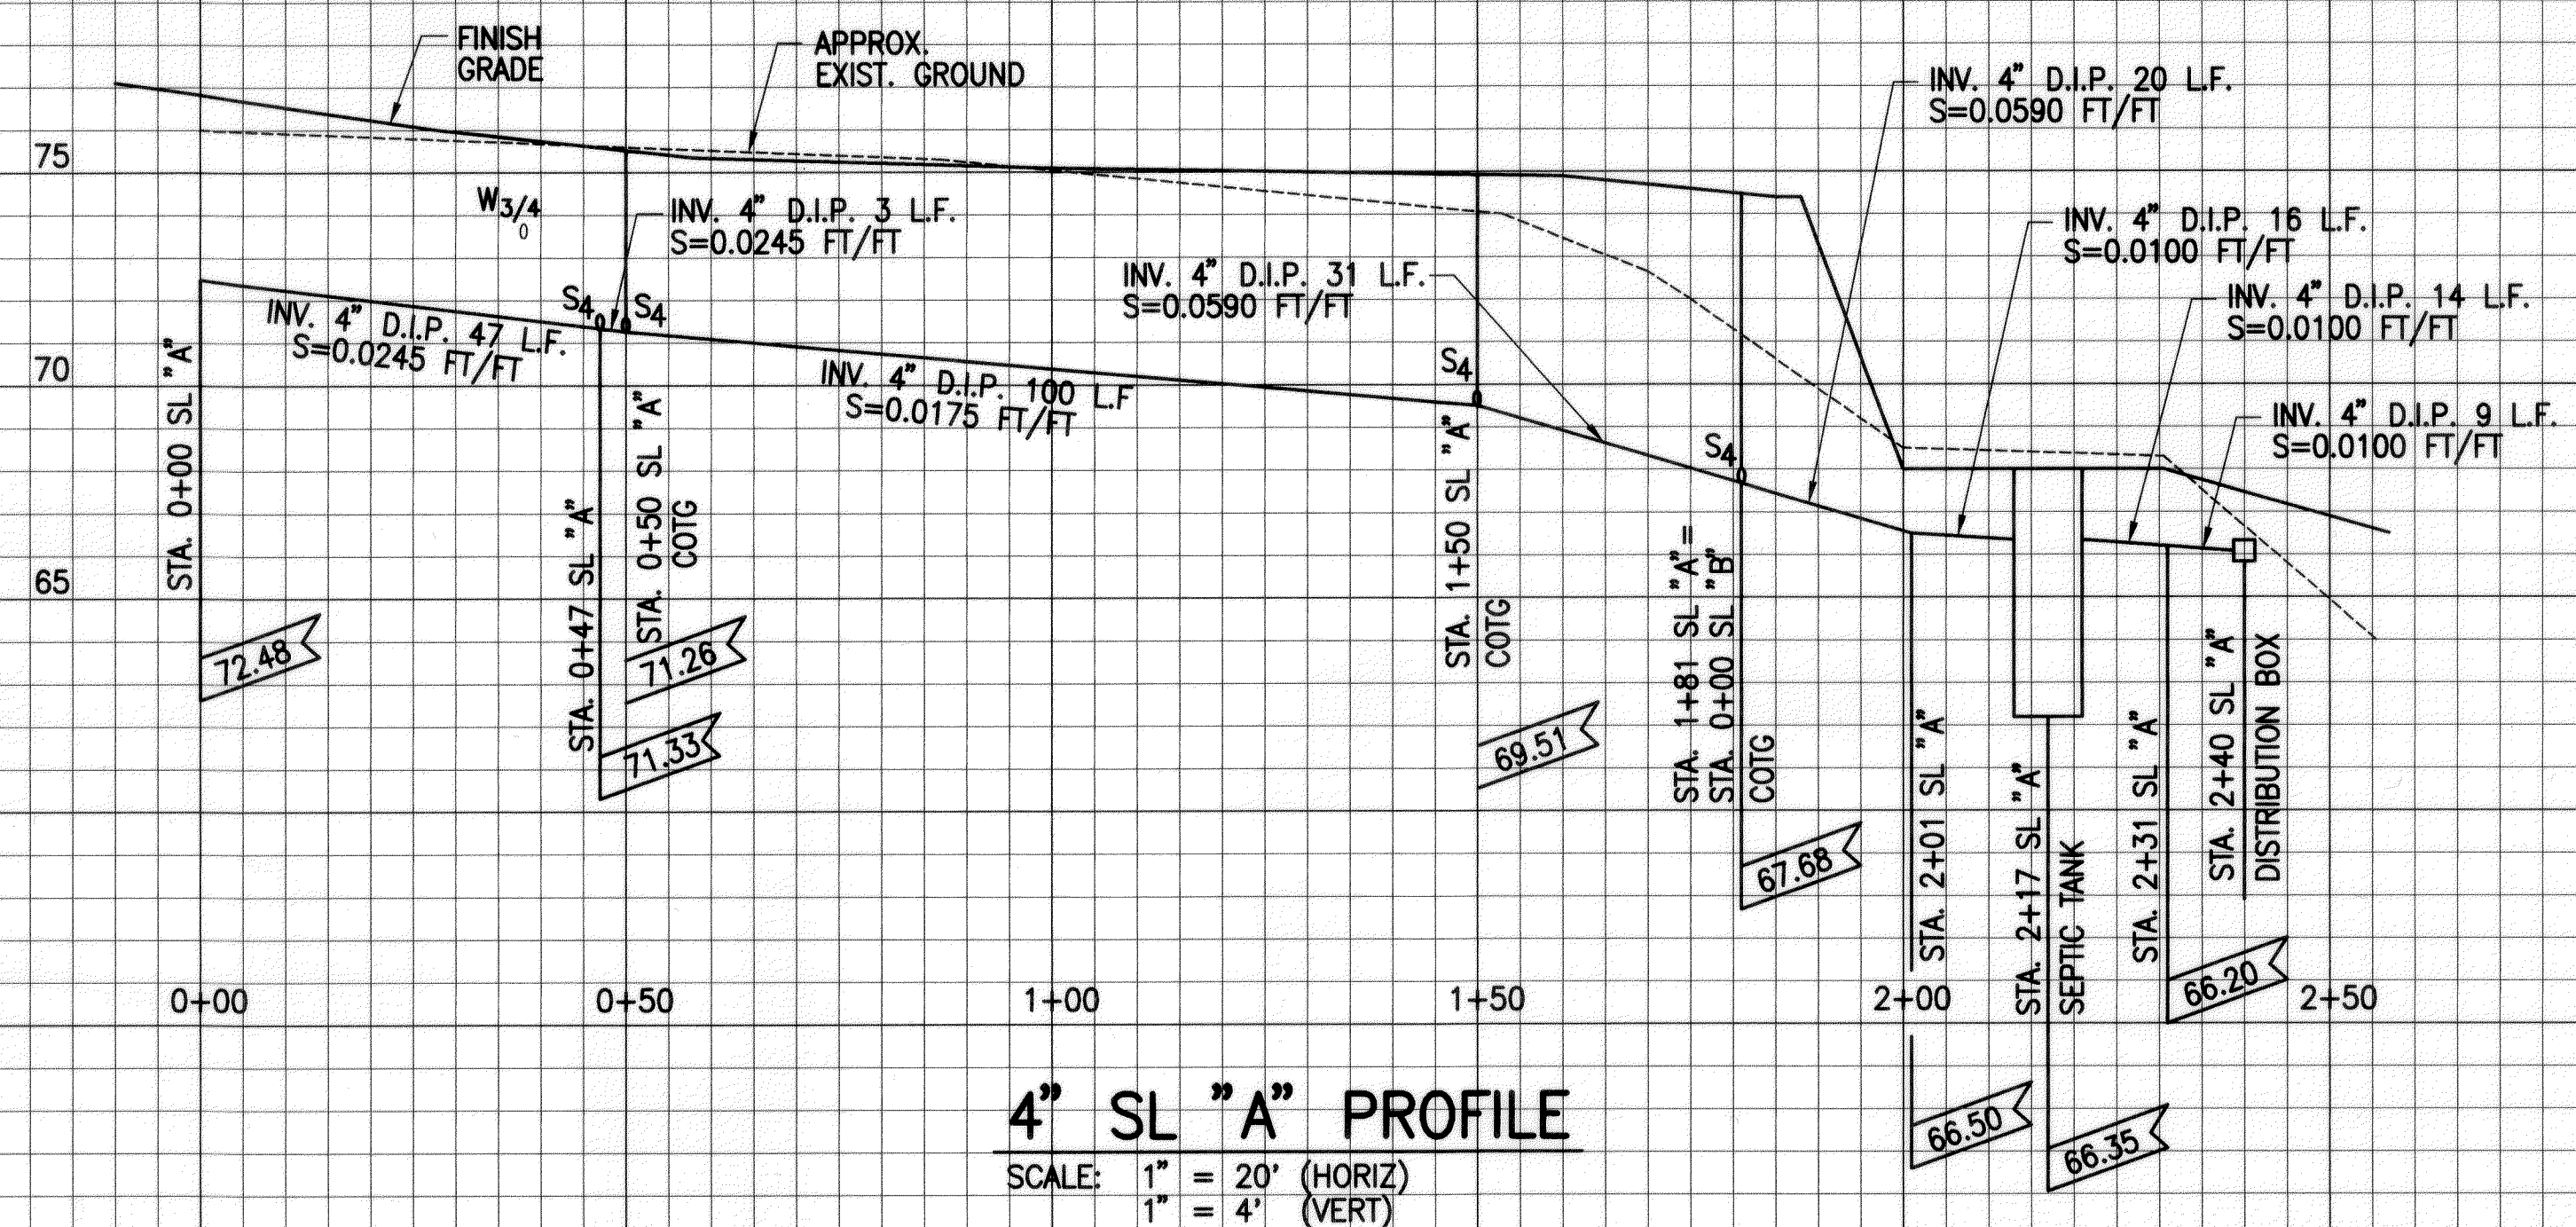

SURVEY PLOTTED BY	DATE
DRAWN BY	
DESIGNED BY	
CHECKED BY	
NOTED BY	
NO.	

DATE

REVISION

STATE OF HAWAII

DEPARTMENT OF TRANSPORTATION

HIGHWAYS DIVISION

UTILITY PROFILES

MOLOKAI BASEYARD

MOLOKAI INDUSTRIAL PARK

Project No. HWY-M-05-98

Scale: As Noted

Date: Sept. 13, 2001

SHEET No. C3.2 OF C3.2 SHEETS

BARRY A. TOYODA

LICENSED PROFESSIONAL ENGINEER

No. 5502-C

HAWAII, U.S.A.

THIS WORK WAS PREPARED BY ME OR UNDER MY SUPERVISION

Barry A. Toyoda