

FED. ROAD DIST. NO.	STATE	PROJ. NO.	FISCAL YEAR	SHEET NO.	TOTAL SHEETS
HAWAII	HAW.	HWY-M-03-99M	2001	7	15

General:

- A. Workmanship and materials shall conform to the building code of the County of Maui (amended UBC, 1991 edition). However, where reference is made to performance conforming to other standards the more stringent shall apply.
- B. The Contractor shall compare all the contract documents with each other and report in writing to the Engineer all inconsistencies and omissions.
- C. The Contractor shall take field measurements and verify field conditions and shall compare such field measurements and conditions with the drawings before commencing work. Report in writing to the Engineer all inconsistencies and omissions.
- D. The Contractor shall be responsible for coordinating the work of all trades.
- E. The Contractor shall be responsible for methods of construction, workmanship and job safety. The Contractor shall provide temporary shoring and bracing as required for stability of structural members and systems.
- F. The Contractor shall be responsible for protection of the adjacent properties, structures, streets and utilities during the construction period.
- G. Details noted as typical on the structural drawings shall apply in all conditions unless specifically shown or noted.

Design criteria:

- A. Seismic \_\_\_\_\_ Zone 2B
- B. Basic wind speed and exposure \_\_\_\_\_ 80 mph, Exposure C
- C. Design live loads
  - a. Roof \_\_\_\_\_ 20 psf
  - b. Offices \_\_\_\_\_ 50 psf
  - c. Stairs and corridors \_\_\_\_\_ 100 psf
  - d. Light storage \_\_\_\_\_ 125 psf
- D. Allowable foundation bearing capacities
  - a. Dead Load + Live Load \_\_\_\_\_ 2,000 psf
  - b. Dead Load + Live Load + Lateral Load \_\_\_\_\_ 2,700 psf

Foundation:

- A. Contractor shall provide for de-watering of excavation from surface water, ground water or seepage.
- B. Contractor shall provide for design and installation of all cribbing, sheeting, and shoring necessary to preserve excavations and earth banks.
- C. Footings shall bear on undisturbed in-situ firm soils. Bottom of footings shall be compacted to provide a relatively firm and smooth bearing surface prior to placement of reinforcing steel and concrete. If soft and/or loose materials are encountered at the bottom of footing excavations, they shall be over-excavated to expose the underlying firm materials. The over-excavation shall be backfilled with select granular material compacted to a minimum of 95% relative compaction or the footing bottom may be extended down to the underlying competent material.

- D. Excavations for footings shall be observed by a qualified Geotechnical Engineer prior to placement of concrete and reinforcing.
- E. Contractor shall brace or protect all walls below grade from lateral loads until attaching floors are completely in place and have attained their full design strength.

Concrete:

- A. Concrete construction shall conform to American Concrete Institute ACI 318R-89.
- B. Concrete shall be regular weight hard rock concrete and shall have the following minimum 28 day compressive strengths:
  - a. Footings, tie beams \_\_\_\_\_ 3,000 psi
  - b. Slabs on grade \_\_\_\_\_ 3,000 psi
  - c. Columns \_\_\_\_\_ 3,000 psi
  - d. All other concrete \_\_\_\_\_ 3,000 psi
- C. Concrete delivery tickets shall record all free water in the mix: at batching by plant, for consistency by driver, and any additional request by Contractor if permitted by the mix design.
- D. All inserts, anchor bolts, plates, and other items to be cast in the concrete shall be hot-dipped galvanized unless otherwise noted.
- E. Reinforcing bars, anchor bolts, inserts, and other items to be cast in the concrete shall be secured in position prior to placement of concrete.
- F. Conduits, pipes, and sleeves passing through a slab or footing and not conforming to typical details shall be located and submitted to the Engineer for approval.
- G. Conduits, pipes, and sleeves embedded within a slab or wall (other than those merely passing through) shall be:
  - a. No larger in outside dimensions than one third the overall slab or wall thickness in which they are embedded.
  - b. Placed in the middle one third of slab or wall thickness
  - c. Spaced no closer than three diameters or widths on center.
- H. The Contractor shall locate construction joints so as not to impair the strength of the structure and to minimize shrinkage stresses. Submit location of construction joints to the Engineer for approval, unless otherwise noted.

- I. See Architectural drawings for chamfers, edge radii, drips, reglets, finishes and other non-structural items not shown or specified on the structural drawings.
- J. Non-shrink grout shall be a premixed non-metallic formula, capable of developing a minimum compressive strength of 3,000 psi in 1 day and 5,000 psi in 28 days.

Reinforcing steel:

- A. Reinforcing steel shall be deformed bars conforming to ASTM A615, grade 60.
- B. Welded wire fabric shall conform to ASTM A185, galvanized.

- C. Clear concrete cover for reinforcing bars shall be as follows, unless otherwise noted:
  - a. Footings, grade beams, etc. cast against earth \_\_\_\_\_ 3"
  - b. Footings, grade beams, etc. formed and exposed to earth or weather \_\_\_\_\_ 2"
  - c. Walls
    - 1. Faces exposed to earth or weather
      - #5 bars and smaller \_\_\_\_\_ 1 1/2"
      - #6 bars and larger \_\_\_\_\_ 2"
    - 2. Interior faces \_\_\_\_\_ 1"
  - d. Beams and columns
    - primary reinforcement, stirrups, ties and spirals \_\_\_\_\_ 1 1/2"
  - e. Structural slabs
    - 1. Faces exposed to earth or weather \_\_\_\_\_ 1 1/2"
    - 2. Interior faces \_\_\_\_\_ 1"
- D. Reinforcing steel shall be spliced where indicated on plans. Provide lap splice length per typical details and schedule, unless otherwise noted.
- E. Welded wire fabric shall be lapped 8 inches or one full mesh plus 2 inches, whichever is greater.
- F. Mechanical splice connectors shall develop in tension 125 percent of the specified minimum yield strength of reinforcing bars.
- G. Bar bends and hooks shall be "standard hooks" in accordance with ACI 318.

DATE	.....
DESIGNED BY	.....
CHECKED BY	.....
NO.	.....



**S1.0**

STATE OF HAWAII  
DEPARTMENT OF TRANSPORTATION  
HIGHWAYS DIVISION



**GAS STATION BUILDING—  
GENERAL NOTES**

MAUI DISTRICT BASEYARD  
Project No. HWY-M-03-99M  
Scale: AS SHOWN Date: APR. 2001


SHEET No. S1.0 OF 5 SHEETS



FED. ROAD DIST. NO.	STATE	PROJ. NO.	FISCAL YEAR	SHEET NO.	TOTAL SHEETS
HAWAII	HAW.	HWY-M-03-99M	2001	9	15

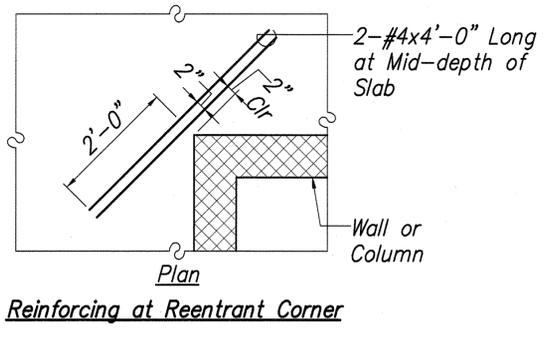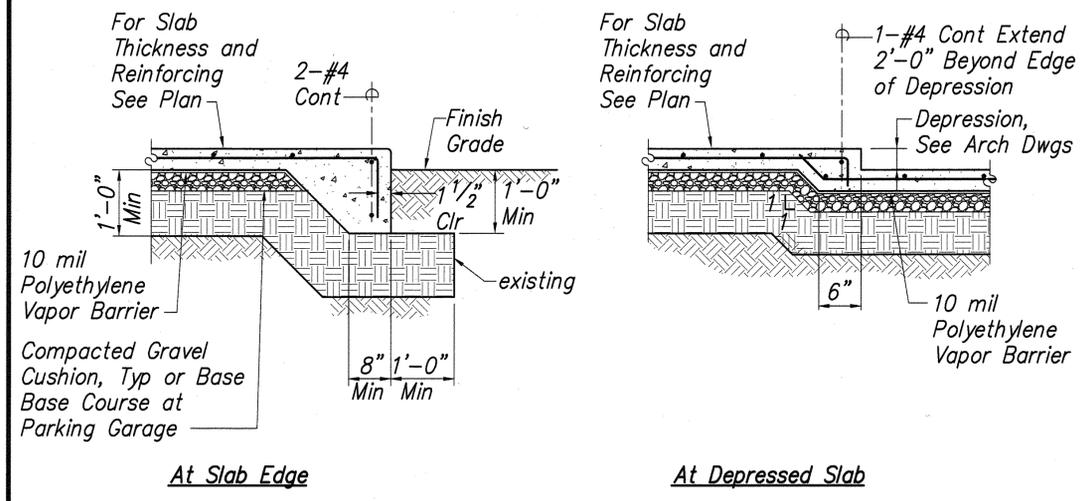


**TYPICAL SLAB-ON-GRADE DETAILS** 1  
 Not To Scale S1.2|S1.2

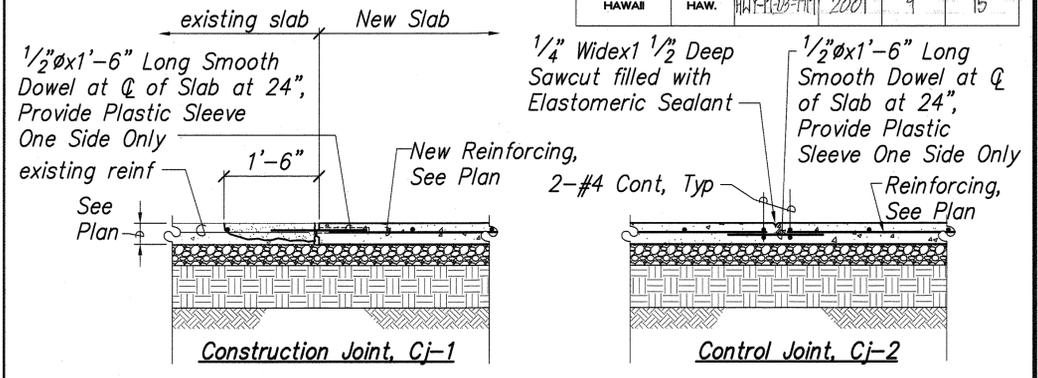



- Note:**
1. Saw Cutting Shall Occur as Soon as Concrete Surface is Firm Enough not be Torn by Cutting Blade and Before Shrinkage Cracking Occurs, But no Later Than 12 Hours After Concrete Has Been Poured.
  2. Remove 1'-6" x 6" widex 3" deep portion of existing slab.
  3. Clean Reinforcing Steel, remove Grease, Oil and other Bond-Inhibiting Matter.
  4. Apply Bonding Bridge Coating.
  5. Fill with Concrete Epoxy (Sika 222 or Equivalent).

**TYPICAL SLAB JOINT DETAILS** 2  
 Not To Scale S1.2|S1.2

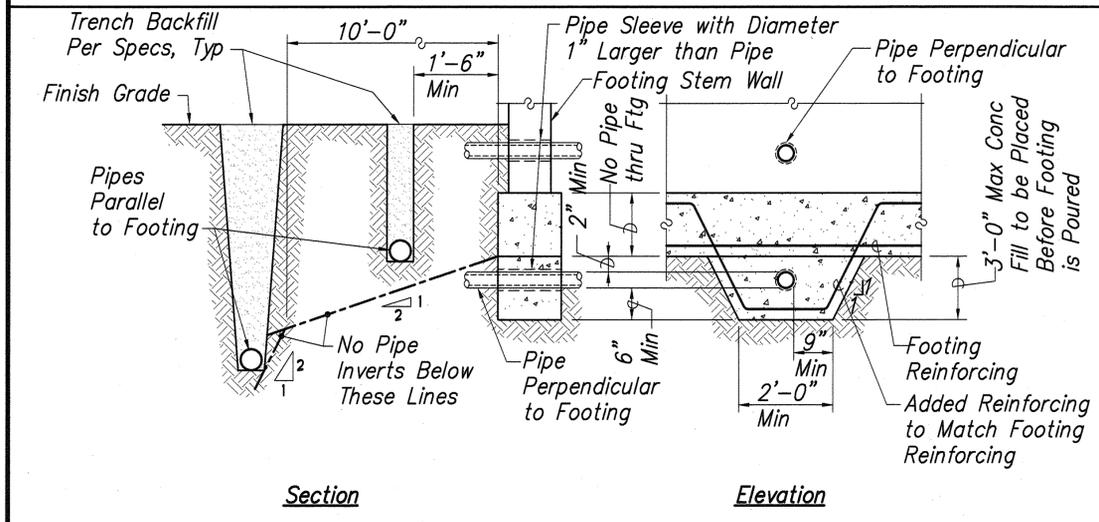

- Note:**
1. For pipe perpendicular to footing more than 3'-0" below bottom of footing, trench may be backfilled with compacted fill. See Specifications.
  2. Depth of footing may be affected by location of pipes. General Contractor shall determine exact depth and location of pipes prior to excavation for footings.

**TYPICAL PIPE AT FOOTING DETAIL** 3  
 Not To Scale S1.2|S1.2

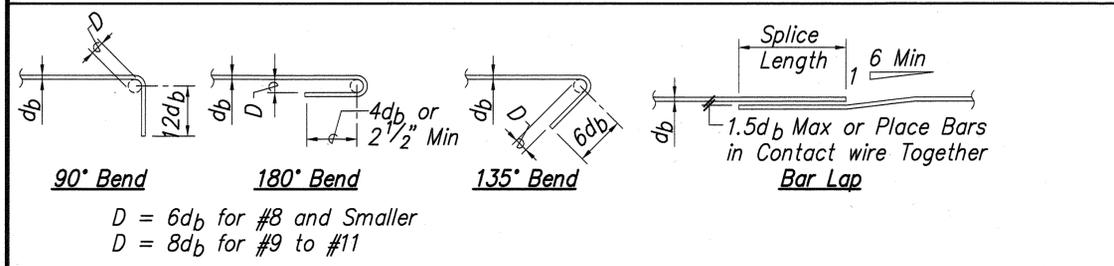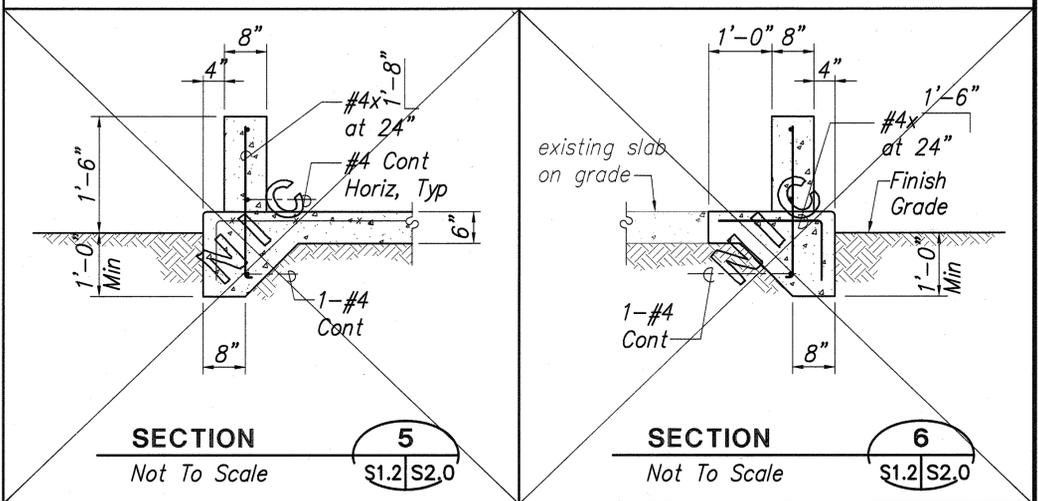

**TYPICAL REBAR SPLICE AND EMBEDMENT LENGTH SCHEDULE** 4  
 Not To Scale S1.2|S1.2

**MINIMUM SPLICE and EMBEDMENT LENGTHS**

Bar Size	Concrete Strength = 3,000 psi					Concrete Strength = 2,500 psi				
	Lap Splice		Embedment			Lap Splice		Embedment		
	Bottom Bar or Wall Bar	Top Bar	Bottom Bar or Wall Bar	Top Bar	with Std Hook	Bottom Bar or Wall Bar	Top Bar	Bottom Bar or Wall Bar	Top Bar	with Std Hook
#3	24"	28"	17"	22"	8"	24"	32"	18"	24"	9"
#4	24"	28"	17"	22"	8"	32"	42"	24"	32"	12"
#5	28"	36"	21"	27"	10"	39"	51"	30"	39"	15"
#6	32"	42"	25"	32"	12"	47"	62"	36"	47"	18"
#7	38"	50"	29"	38"	14"	55"	72"	42"	55"	21"
#8	44"	56"	33"	43"	16"	63"	82"	48"	63"	24"
#9	48"	64"	37"	48"	18"	72"	94"	55"	71"	28"
#10	58"	76"	45"	58"	20"	80"	104"	61"	80"	31"
#11	72"	93"	55"	71"	22"	89"	115"	68"	88"	34"

DATE: \_\_\_\_\_  
 DRAWN BY: \_\_\_\_\_  
 CHECKED BY: \_\_\_\_\_  
 QUANTITIES BY: \_\_\_\_\_  
 NO. \_\_\_\_\_

KEVIN KAZUO HAYASHIDA  
 LICENSED PROFESSIONAL ENGINEER  
 No. 6818-S  
 HAWAII, U.S.A.  
 THIS WORK WAS PREPARED BY ME OR UNDER MY SUPERVISION

**S1.2**





STATE OF HAWAII  
 DEPARTMENT OF TRANSPORTATION  
 HIGHWAYS DIVISION  
**GAS STATION BUILDING - TYPICAL DETAILS**

MAUI DISTRICT BASEYARD  
 Project No. HWY-M-03-99M  
 Scale: AS SHOWN Date: APR. 2001

SHEET No. S1.2 OF 5 SHEETS

**"AS-BUILT"**

FED. ROAD DIST. NO.	STATE	PROJ. NO.	FISCAL YEAR	SHEET NO.	TOTAL SHEETS
HAWAII	HAW.	HWY-M-03-99M	2001	10	15

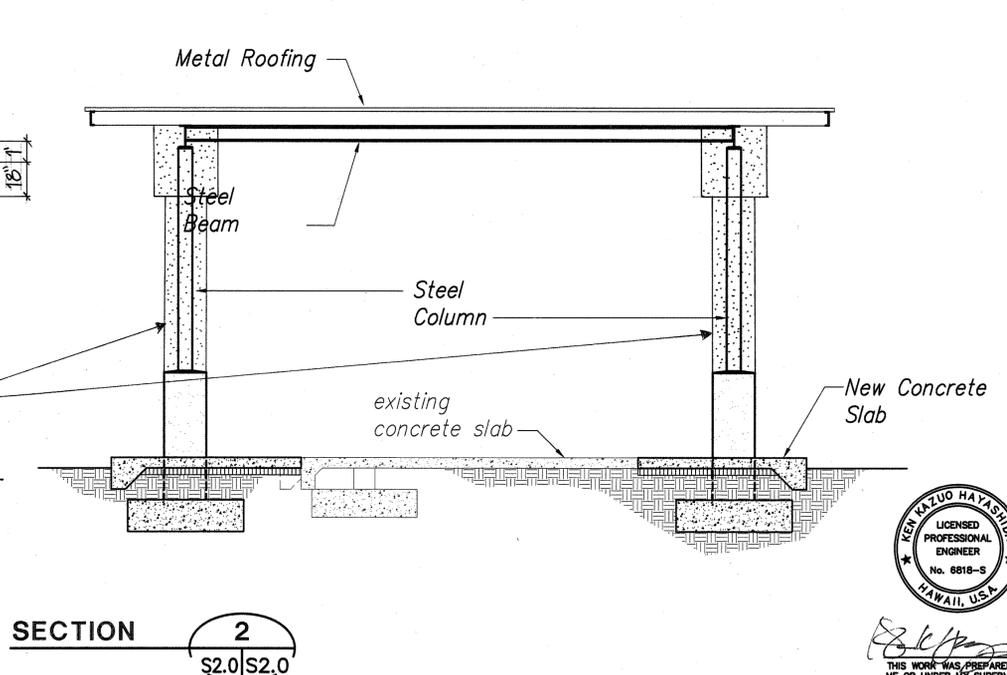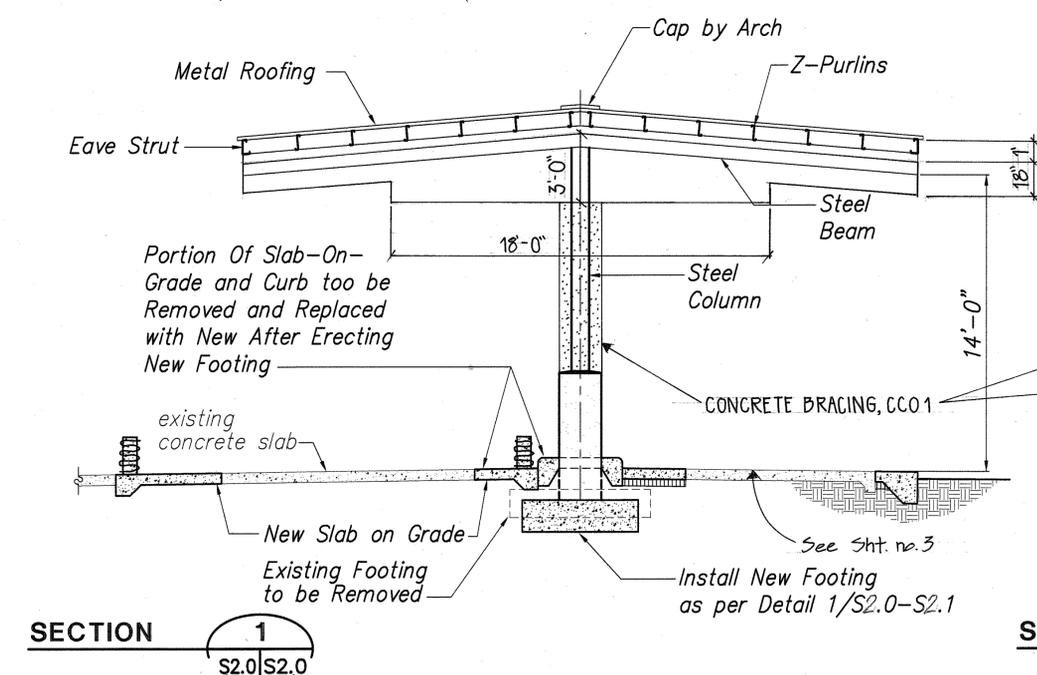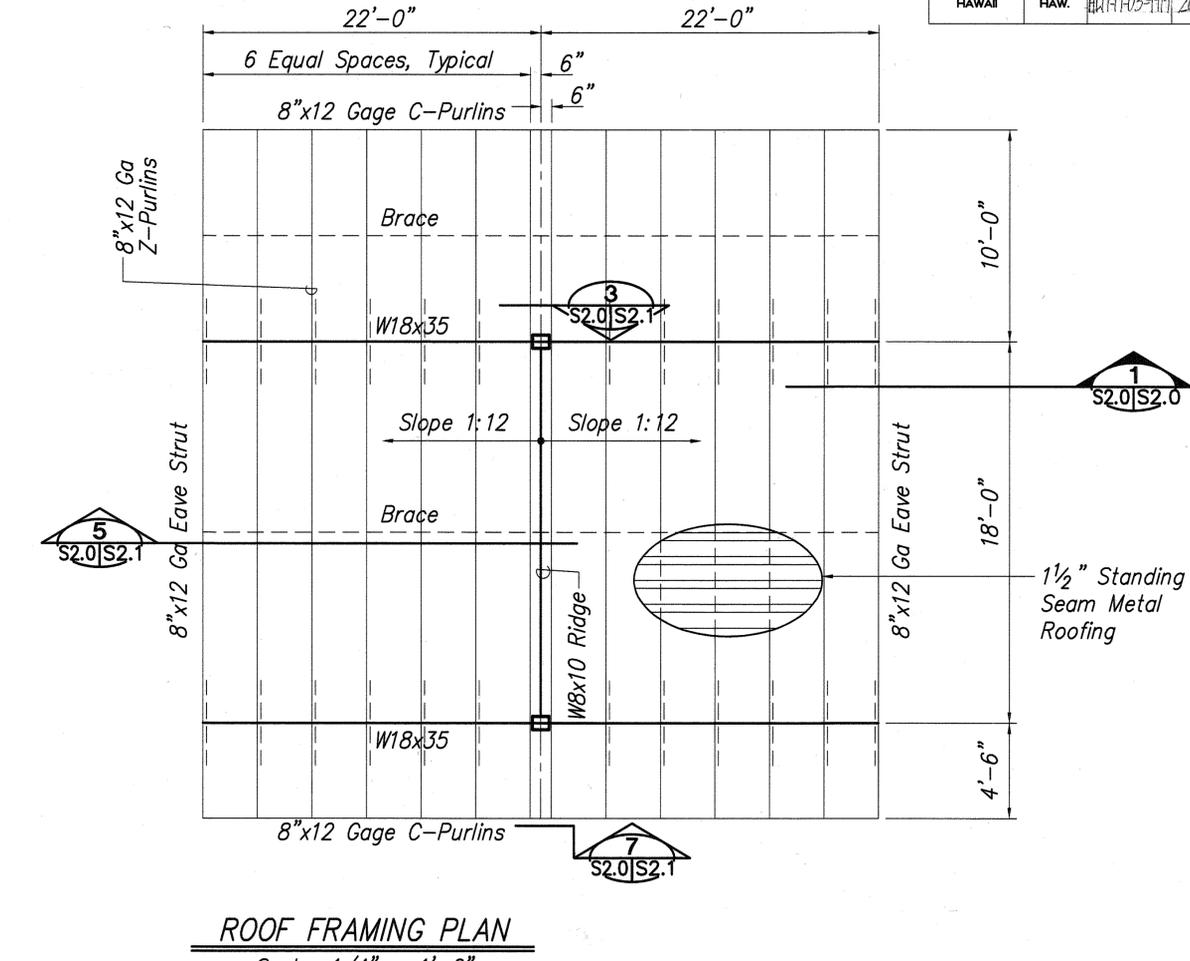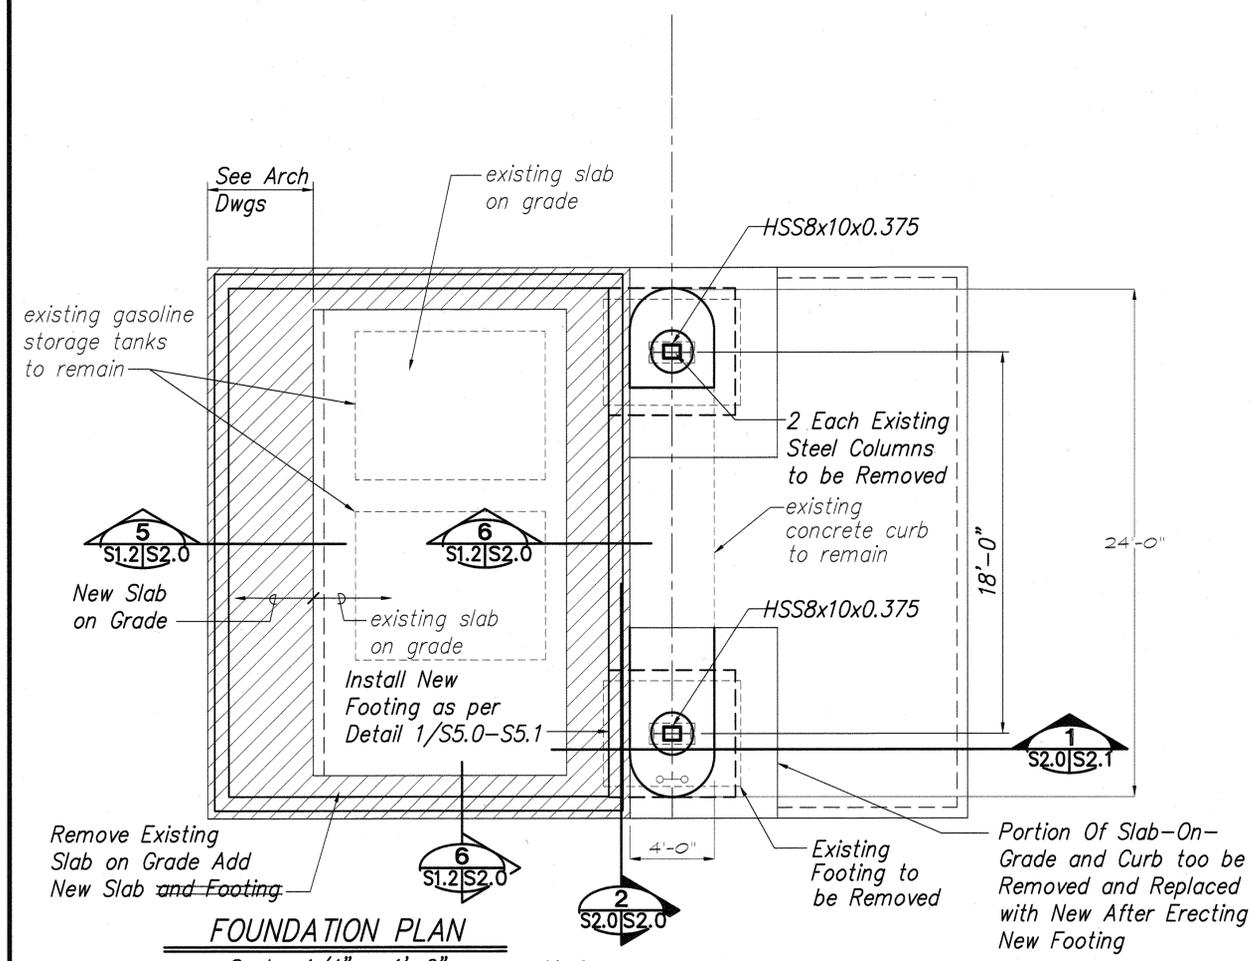

DATE	_____
DESIGNED BY	_____
DRAWN BY	_____
CHECKED BY	_____
QUANTITIES BY	_____
NOTE BOOK	_____
ORIGINAL PLAN	_____



**S2.0**

STATE OF HAWAII  
DEPARTMENT OF TRANSPORTATION  
HIGHWAYS DIVISION

**GAS STATION BUILDING—  
FOUNDATION AND ROOF  
FRAM'G PLANS & SECTIONS**

MAUI DISTRICT BASEYARD  
Project No. HWY-M-03-99M  
Scale: AS SHOWN Date: APR. 2001

SHEET No. S2.0 OF 5 SHEETS

"AS-BUILT"

