
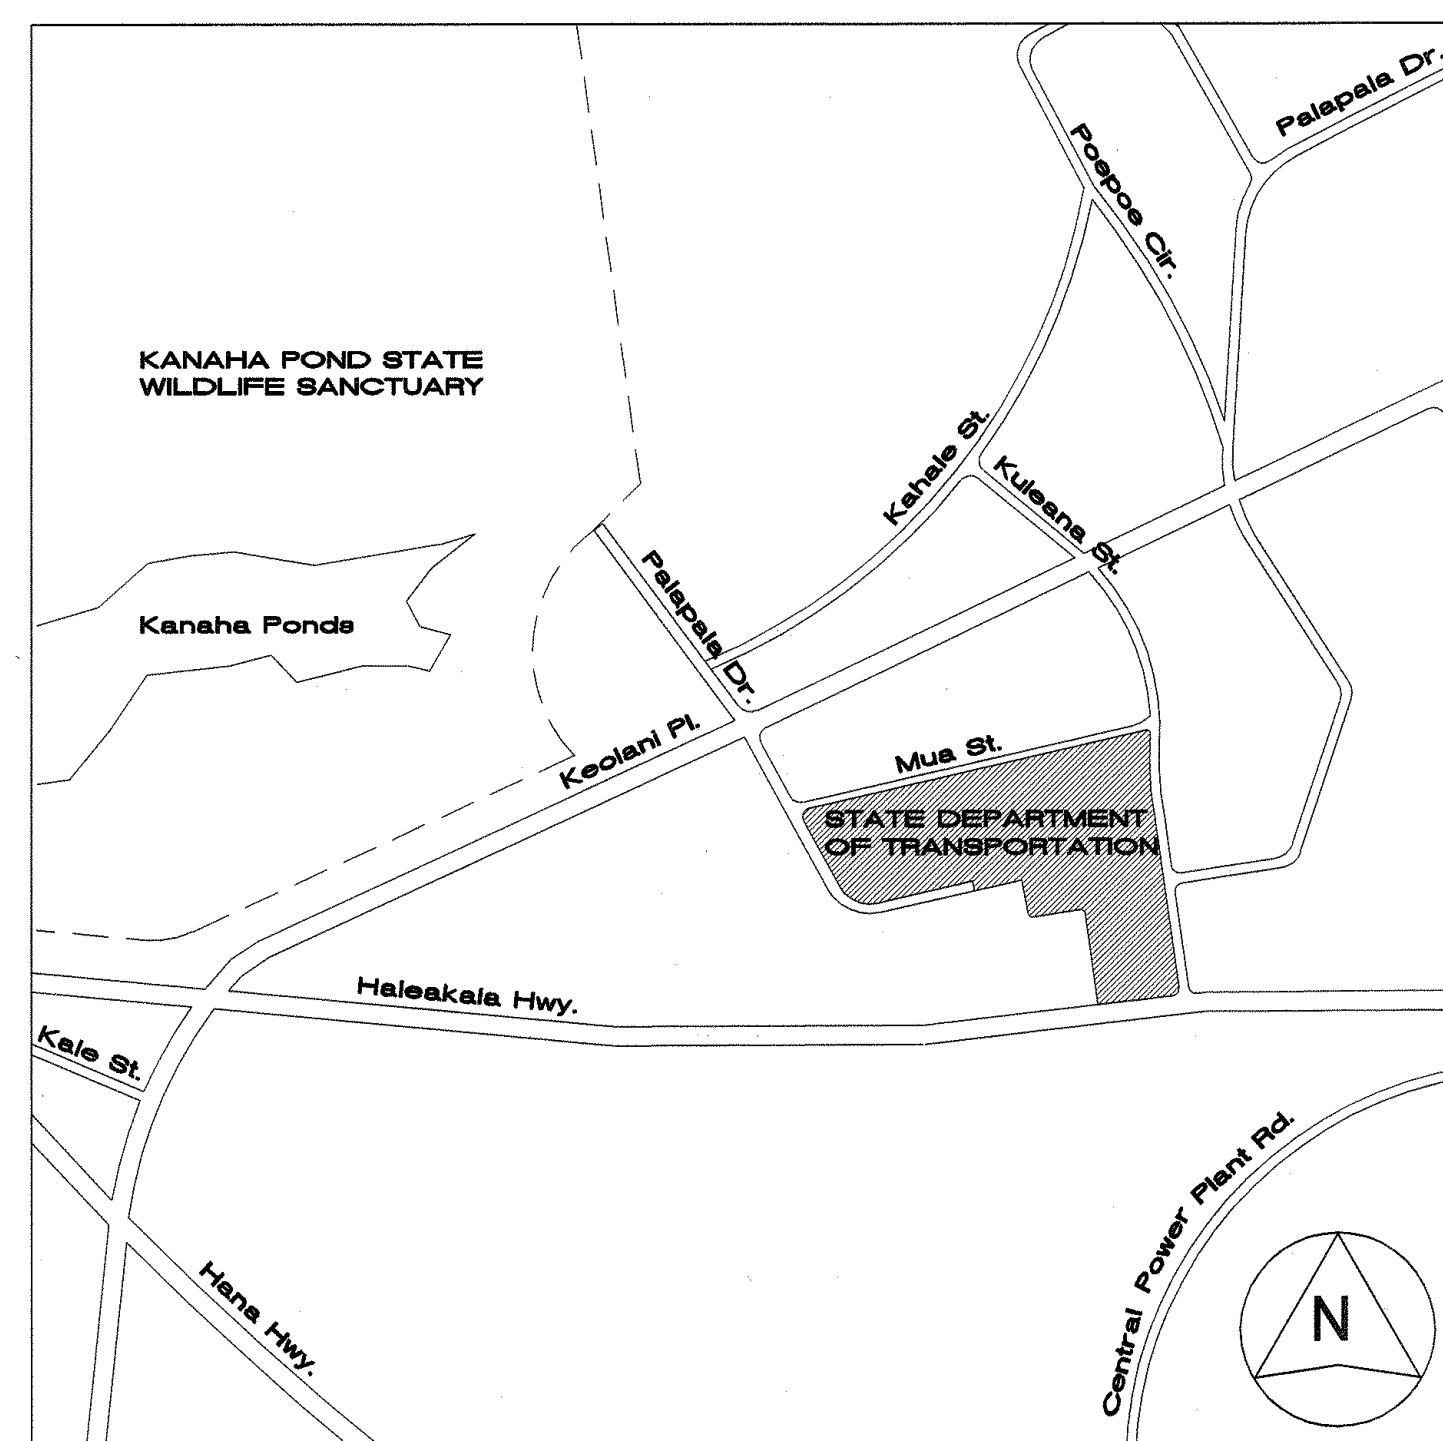
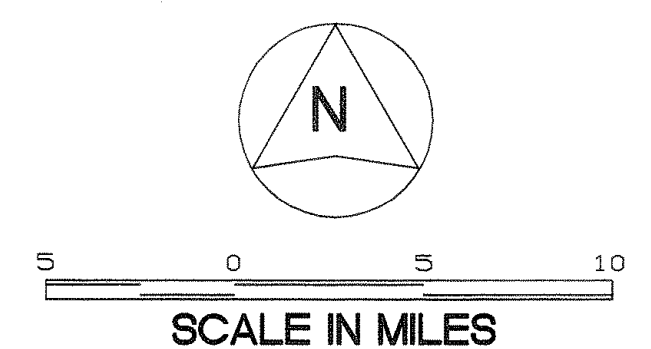
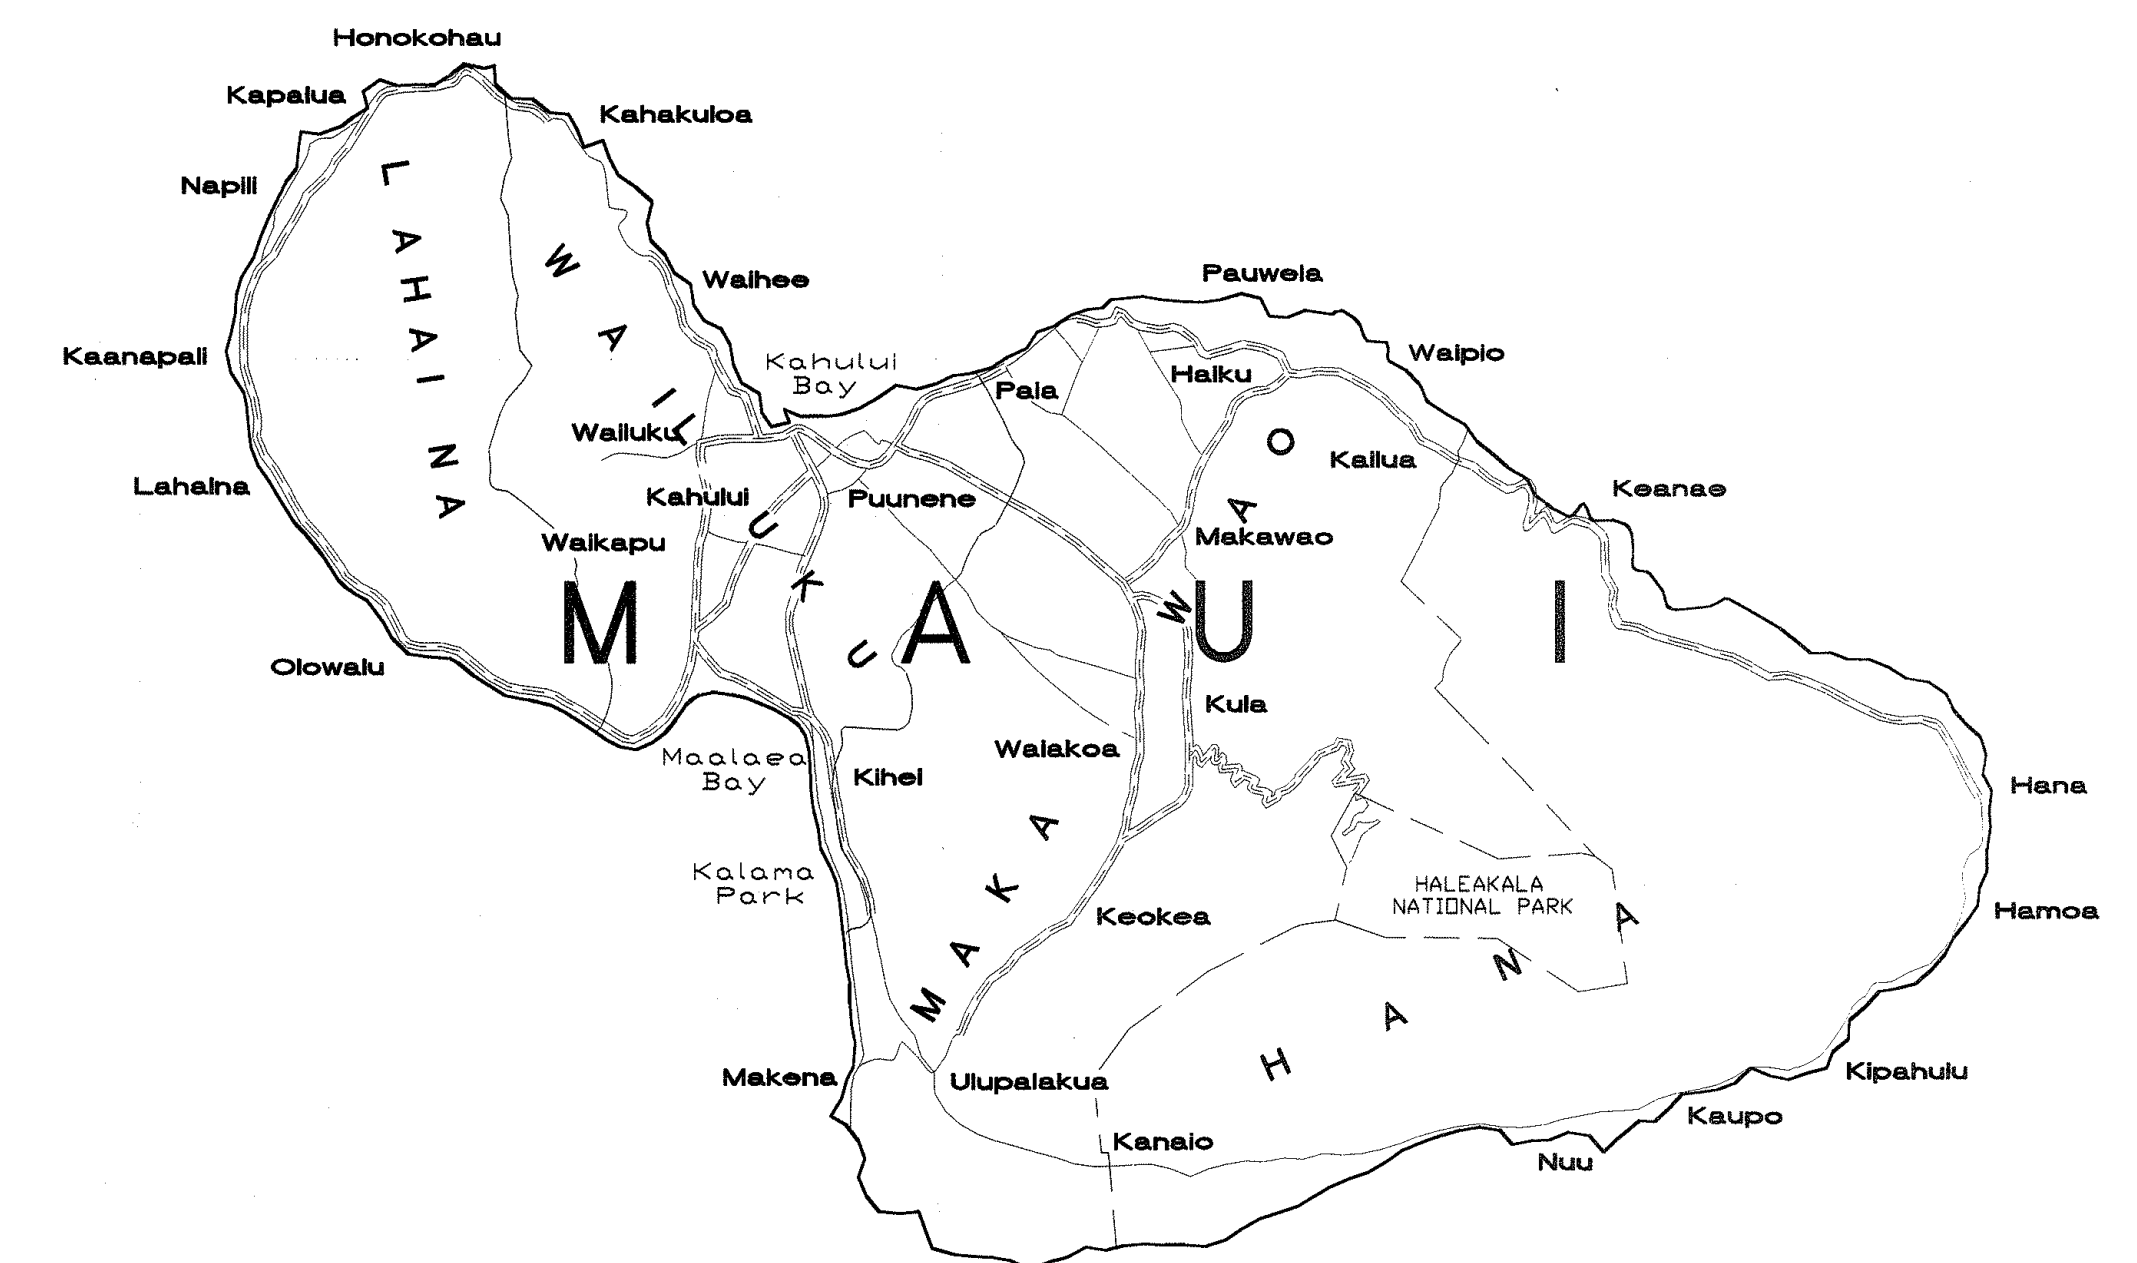


FED. ROAD DIST. NO.	STATE	PROJ. NO.	FISCAL YEAR	SHEET NO.	TOTAL SHEETS
HAWAII	HAW.	HWY-M-09-02M	2002	1	39

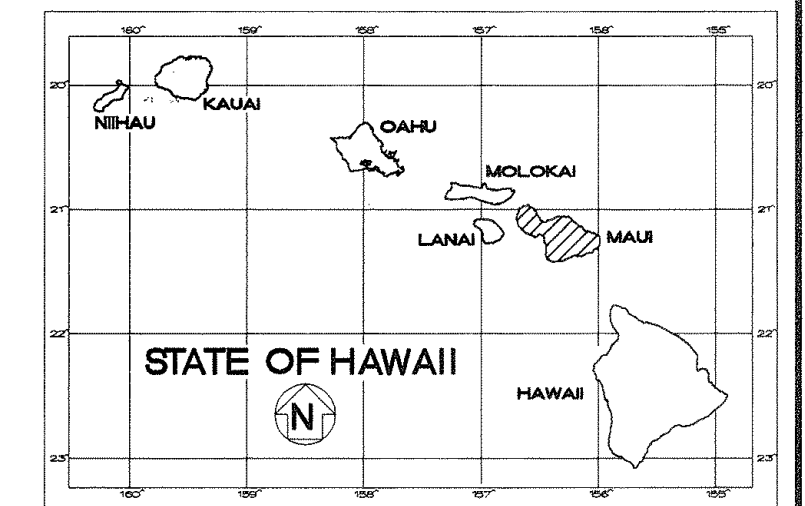

VICINITY MAP
NOT TO SCALE

CONSULTANTS:

ARCHITECT:

PAUL S. OSUMI, JR. AIA, INC.
700 BISHOP ST., SUITE 228
HONOLULU, HAWAII 96813
PHONE: (808) 528-3500
FAX: (808) 532-0828

STRUCTURAL ENGINEER:

KAI HAWAII, INC.
705 SOUTH KING ST., SUITE 106
HONOLULU, HAWAII 96813
PHONE: (808) 533-2210
FAX: (808) 533-2686

ELECTRICAL ENGINEER:

RS ENGINEERING, INC.
1376 KALANIKI ST.
HONOLULU, HAWAII 96821
PHONE: (808) 377-9210
FAX: (808) 377-9210

CHANGES MADE DURING CONSTRUCTION HAVE BEEN INCORPORATED ON THESE PLANS EXCEPT CHANGES IN THE ORIGINAL THEORETICAL QUANTITIES. FOR ACTUAL QUANTITIES, REFER TO PROJECT LEDGER AND/OR COMPUTATION BOOK.

DEPARTMENT OF TRANSPORTATION
STATE OF HAWAII

APPROVED: _____ 5/8/02
for DIR. OF TRANSPORTATION DATE

PAUL S. OSUMI JR., AIA, INC.
DESIGNED BY

HWY-M
P. S. + E. BY

873-3535
PHONE

FEB 2002
DATE