




## NOTES:

- 1. REPLACE EXISTING DUPLEX RECEPTACLES WITH NEW GROUND FAULT CIRCUIT INTERRUPTING (GFI) RECEPTACLES.
- 2. AT THE NEW EIGHT(8) WORK STATIONS ELECTRICAL CONTRACTOR SHALL COORDINATE WITH OWNER AND WORK STATIONS CONTRACTOR AND PROVIDE CONDUITS AND WIRES TO EACH WORK STATION RECEPTACLES. THE FEEDERS TO EACH STATION RECEPTACLES SHALL BE PROVIDED FROM THE SPARE CIRCUIT @ EXISTING PANEL B.
- 3. ALL WORK SHALL BE DONE ACCORDING TO NEC REQUIREMENTS.

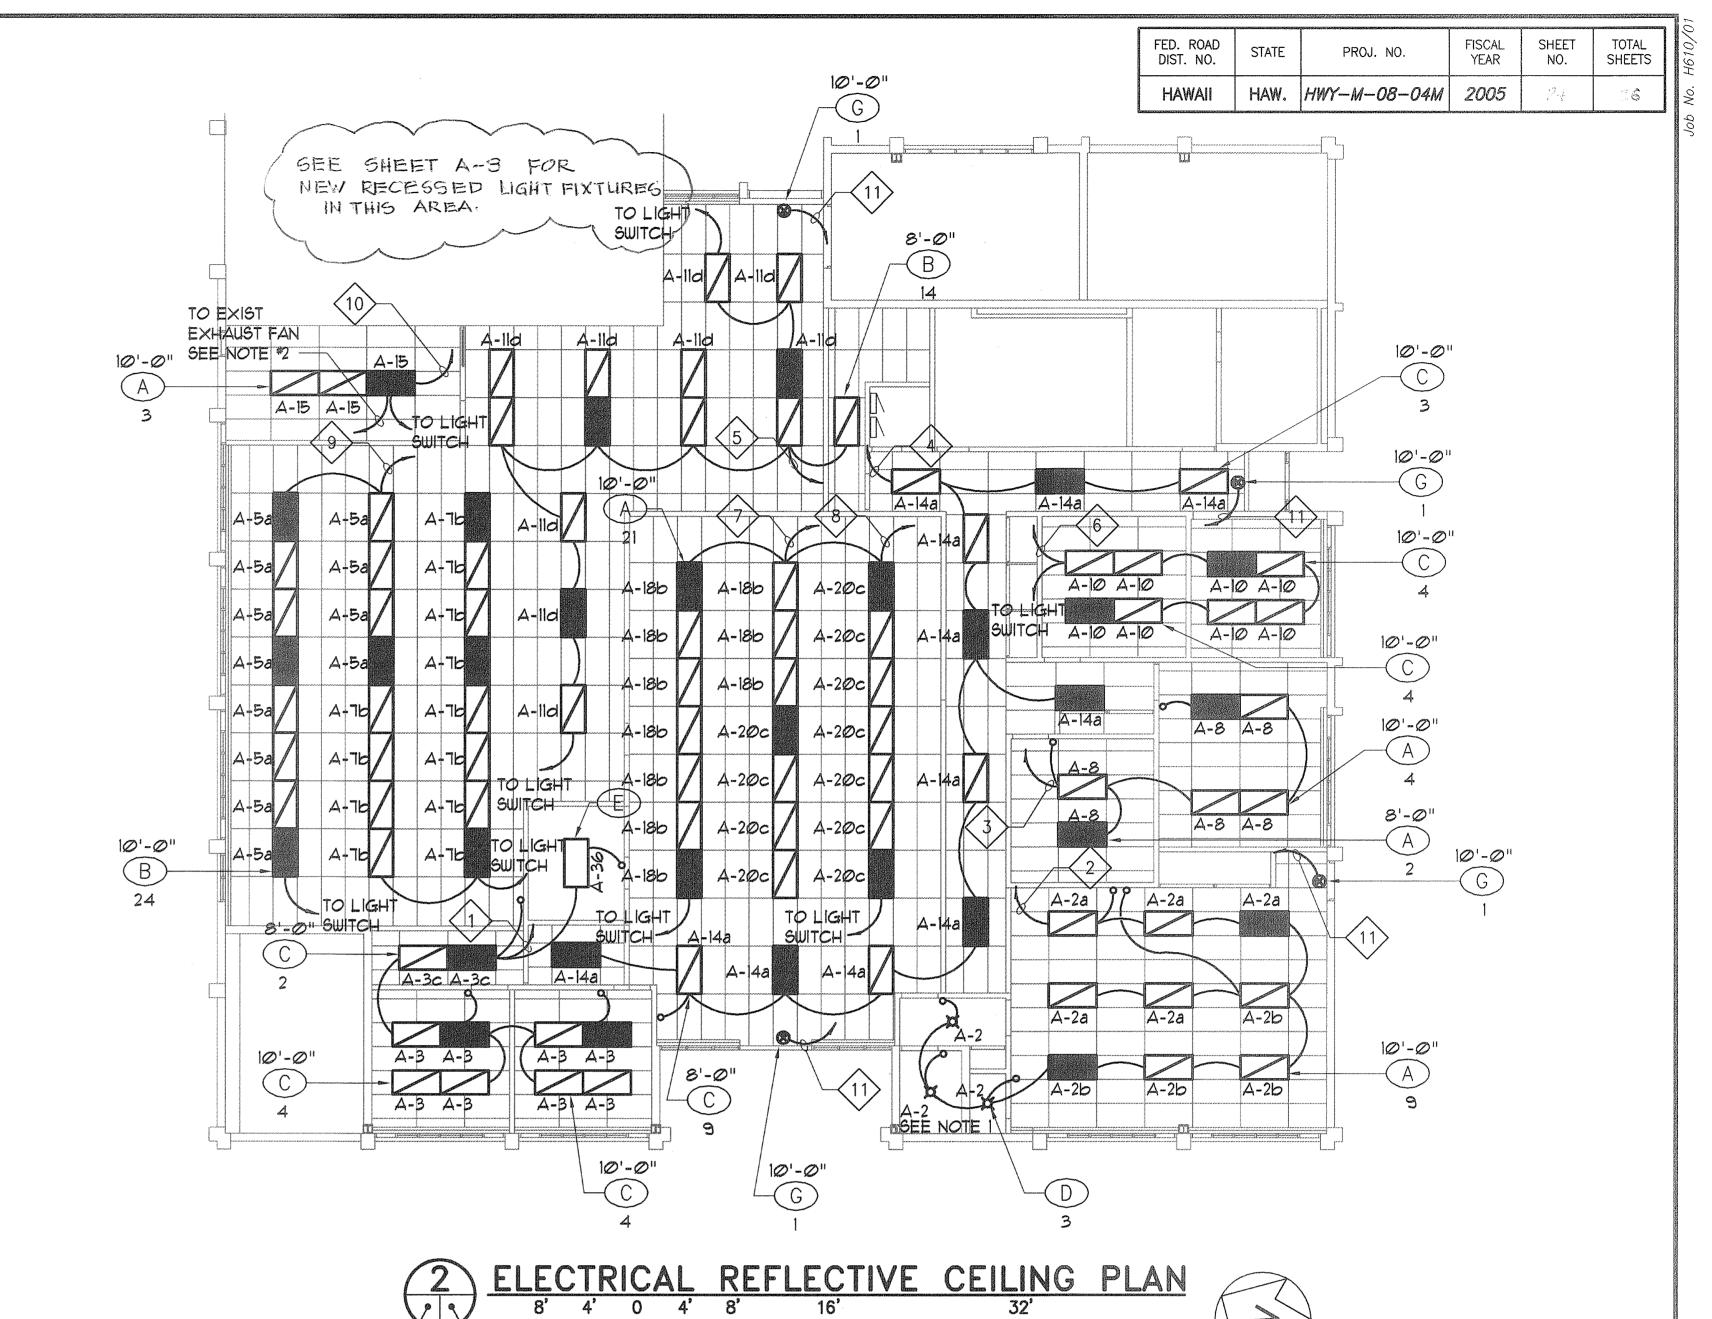

## **KEY NOTES:**

(FROM EXISTING PANEL A CKT#3 TO THE NEW 2#12 & 1#12 GND - 3/4°C LIGHTING FIXTURES) (FROM EXISTING PANEL A CKT#2 TO THE NEW LIGHTING FIXTURES) (FROM EXISTING PANEL A CKT#8 TO THE NEW 2#12 & 1#12 GND - 3/4°C LIGHTING FIXTURES) (FROM EXISTING PANEL A CKT#14 TO THE NEW 2#12 & 1#12 GND - 3/4°C LIGHTING FIXTURES) (FROM EXISTING PANEL A CKT#11 TO THE NEW 2#12 & 1#12 GND - 3/4"C LIGHTING FIXTURES) (FROM EXISTING PANEL A CKT#10 TO THE NEW 2#12 & 1#12 GND - 3/4"C LIGHTING FIXTURES) (FROM EXISTING PANEL A CKT#18 TO THE NEW 2#12 & 1#12 GND - 3/4"C LIGHTING FIXTURES) (FROM EXISTING PANEL A CKT#20 TO THE NEW 2#12 & 1#12 GND - 3/4"C LIGHTING FIXTURES) (FROM EXISTING PANEL A CKT#5 & #7 TO THE 9 2#12 & 1#12 GND - 3/4"C NEW LIGHTING FIXTURES) (FROM EXISTING PANEL A CKT#15 TO THE NEW 2#12 & 1#12 GND - 3/4°C LIGHTING FIXTURES & EXISTING EXHAUST FAN)

EXIT LIGHTS)

## NOTES:

2#12 & 1#12 GND - 3/4°C

- 1. THE EXISTING EXHAUST FAN AT THE TOILET SHALL BE CONNECTED TO THE NEW LIGHTING CIRCUIT CKT#2, THE LIGHT SWITCH SHALL CONTROL THE FAN AND THE LIGHTS.
- 2. THE EXISTING EXHAUST FAN AT THE TOILET SHALL BE CONNECTED TO THE NEW LIGHTING CIRCUIT CKT#15, THE LIGHT SWITCH SHALL CONTROL THE FAN AND THE LIGHTS.

(FROM EXISTING PANEL A CKT#4 TO THE NEW

## **DEMOLITION NOTES:**

1/8"=1'-0"

- REMOVE ALL EXISTING RECESSED AND SURFACE MOUNTED LIGHTING FIXTURES AT ADMIN. BLDG. WHERE THE EXISTING LAY-IN CEILING WILL BE REMOVE AND REPLACE.
- 2. REMOVE ALL EXISTING CONDUITS, J.BOX AND WIRES FEEDING THE EXISTING LIGHTING FIXTURES WILL BE REMOVED.
- 3. ELECTIRCAL CONTRACTORS SHALL PROVIDE AND INSTALL NEW CONDUITS AND WIRES IN ANY EXISTING CIRCUIT FEEDING OTHER LIGHTING FIXTURES OUTSIDE THE DEMOLATION AREA OR ANY CONDUITS HAS OTHER CIRCUITS (WIRES) FEEDING OTHER LIGHTING FIXTURES OR ELECTRICAL EQUIPMENTS.
- 4. SEE SHEET. E-1 GENERAL NOTES.



THIS WORK WAS PREPARED BY ME OR UNDER MY SUPERVISION. Armanino lum \$ignature

STATE OF HAWAII DEPARTMENT OF TRANSPORTATION HIGHWAYS DIVISION

> EXISTING ADMINISTRATION BLDG NEW LIGHTING PLAN

MAUI DISTRICT BASEYARD REPAIR AND MAINTENANCE OF **BUILDINGS AND GROUNDS, PHASE 3** PROJECT NO. HWY-M-08-04M

SCALE: AS SHOWN

DATE: MAY 2005 SHEET No. E-8 OF 10 SHEETS

"AS-BUILT"