

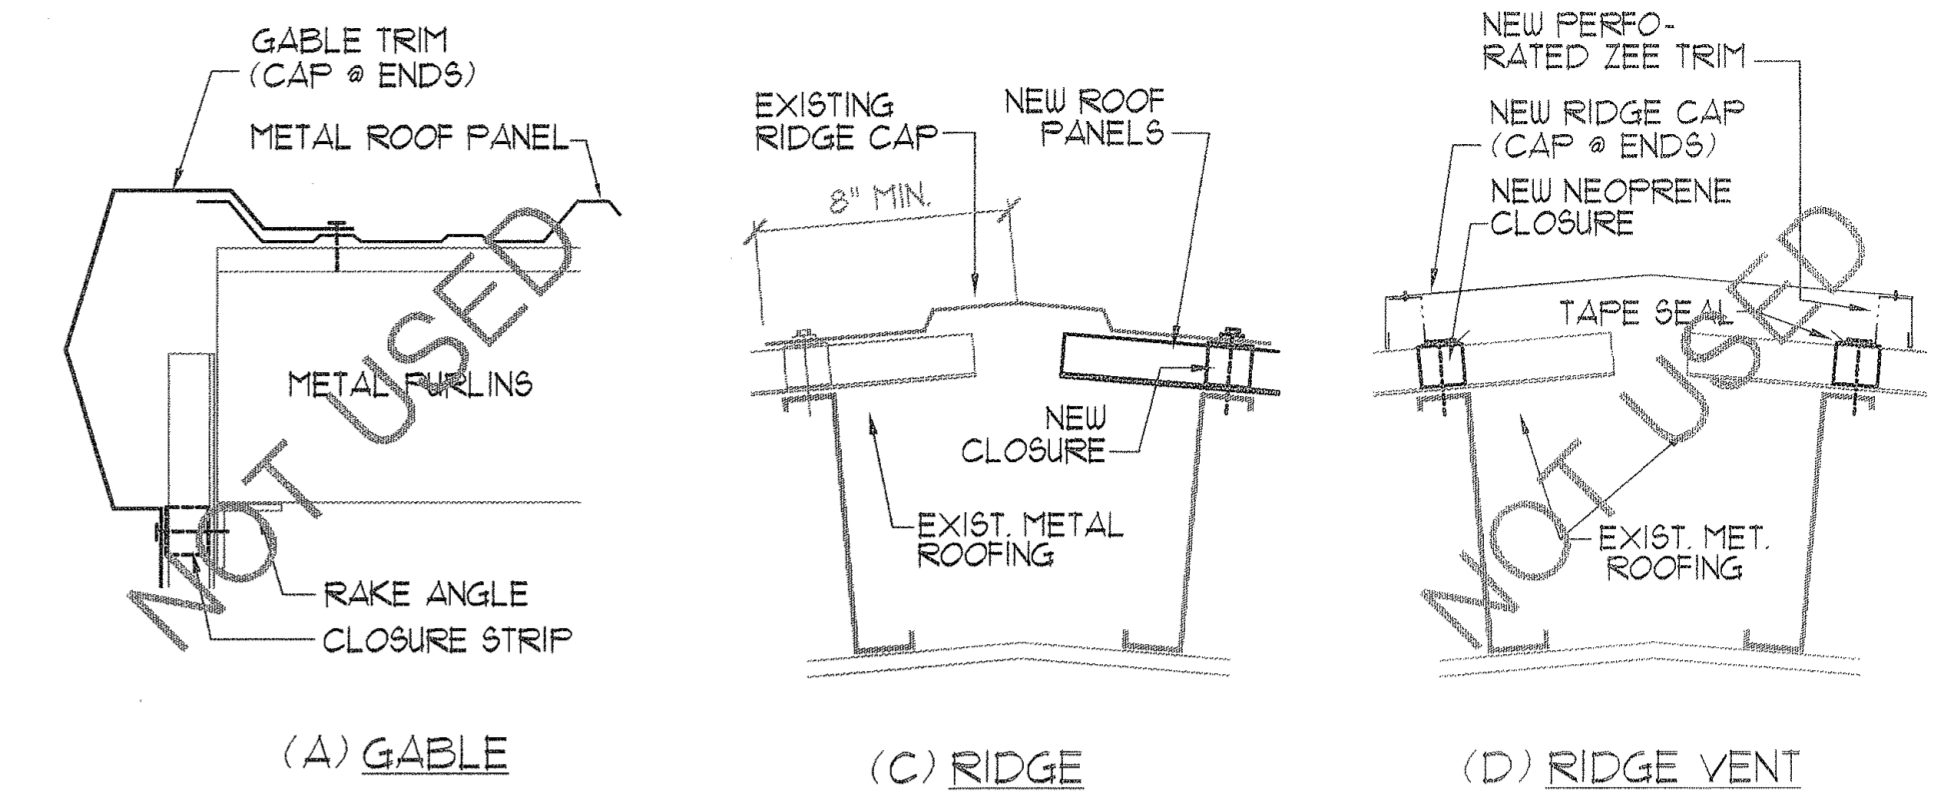




FED. ROAD DIST. NO.	STATE	PROJ. NO.	FISCAL YEAR	SHEET NO.	TOTAL SHEETS
HAWAII	HAW.	HWY-M-08-04M	2005	9	26

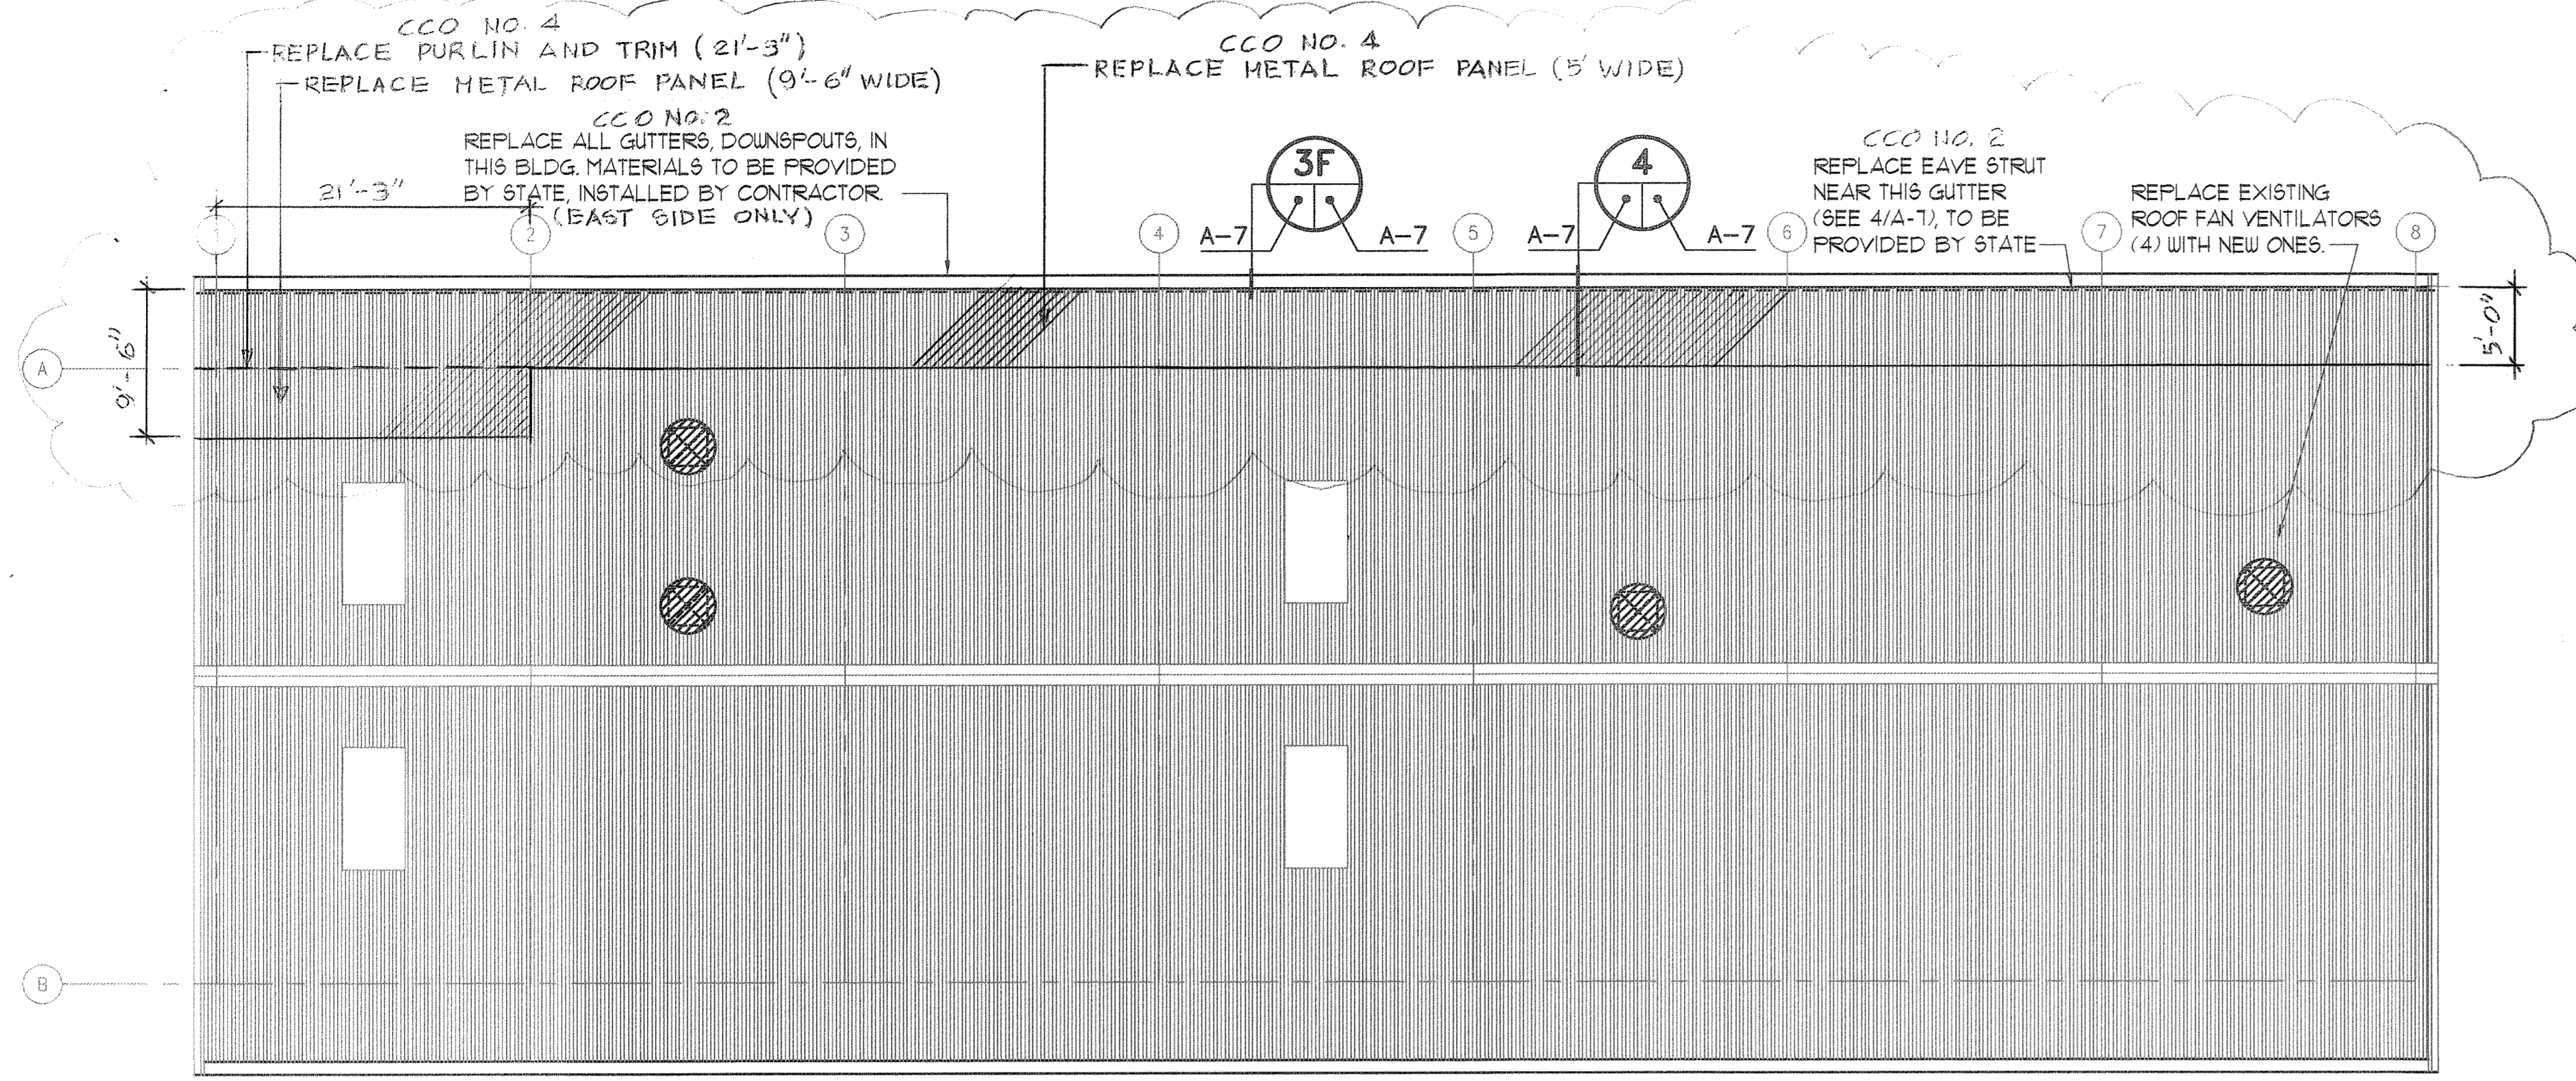


1 MAINTENANCE BLDG. ROOF PLAN
SCALE: 1/8" = 1'-0"

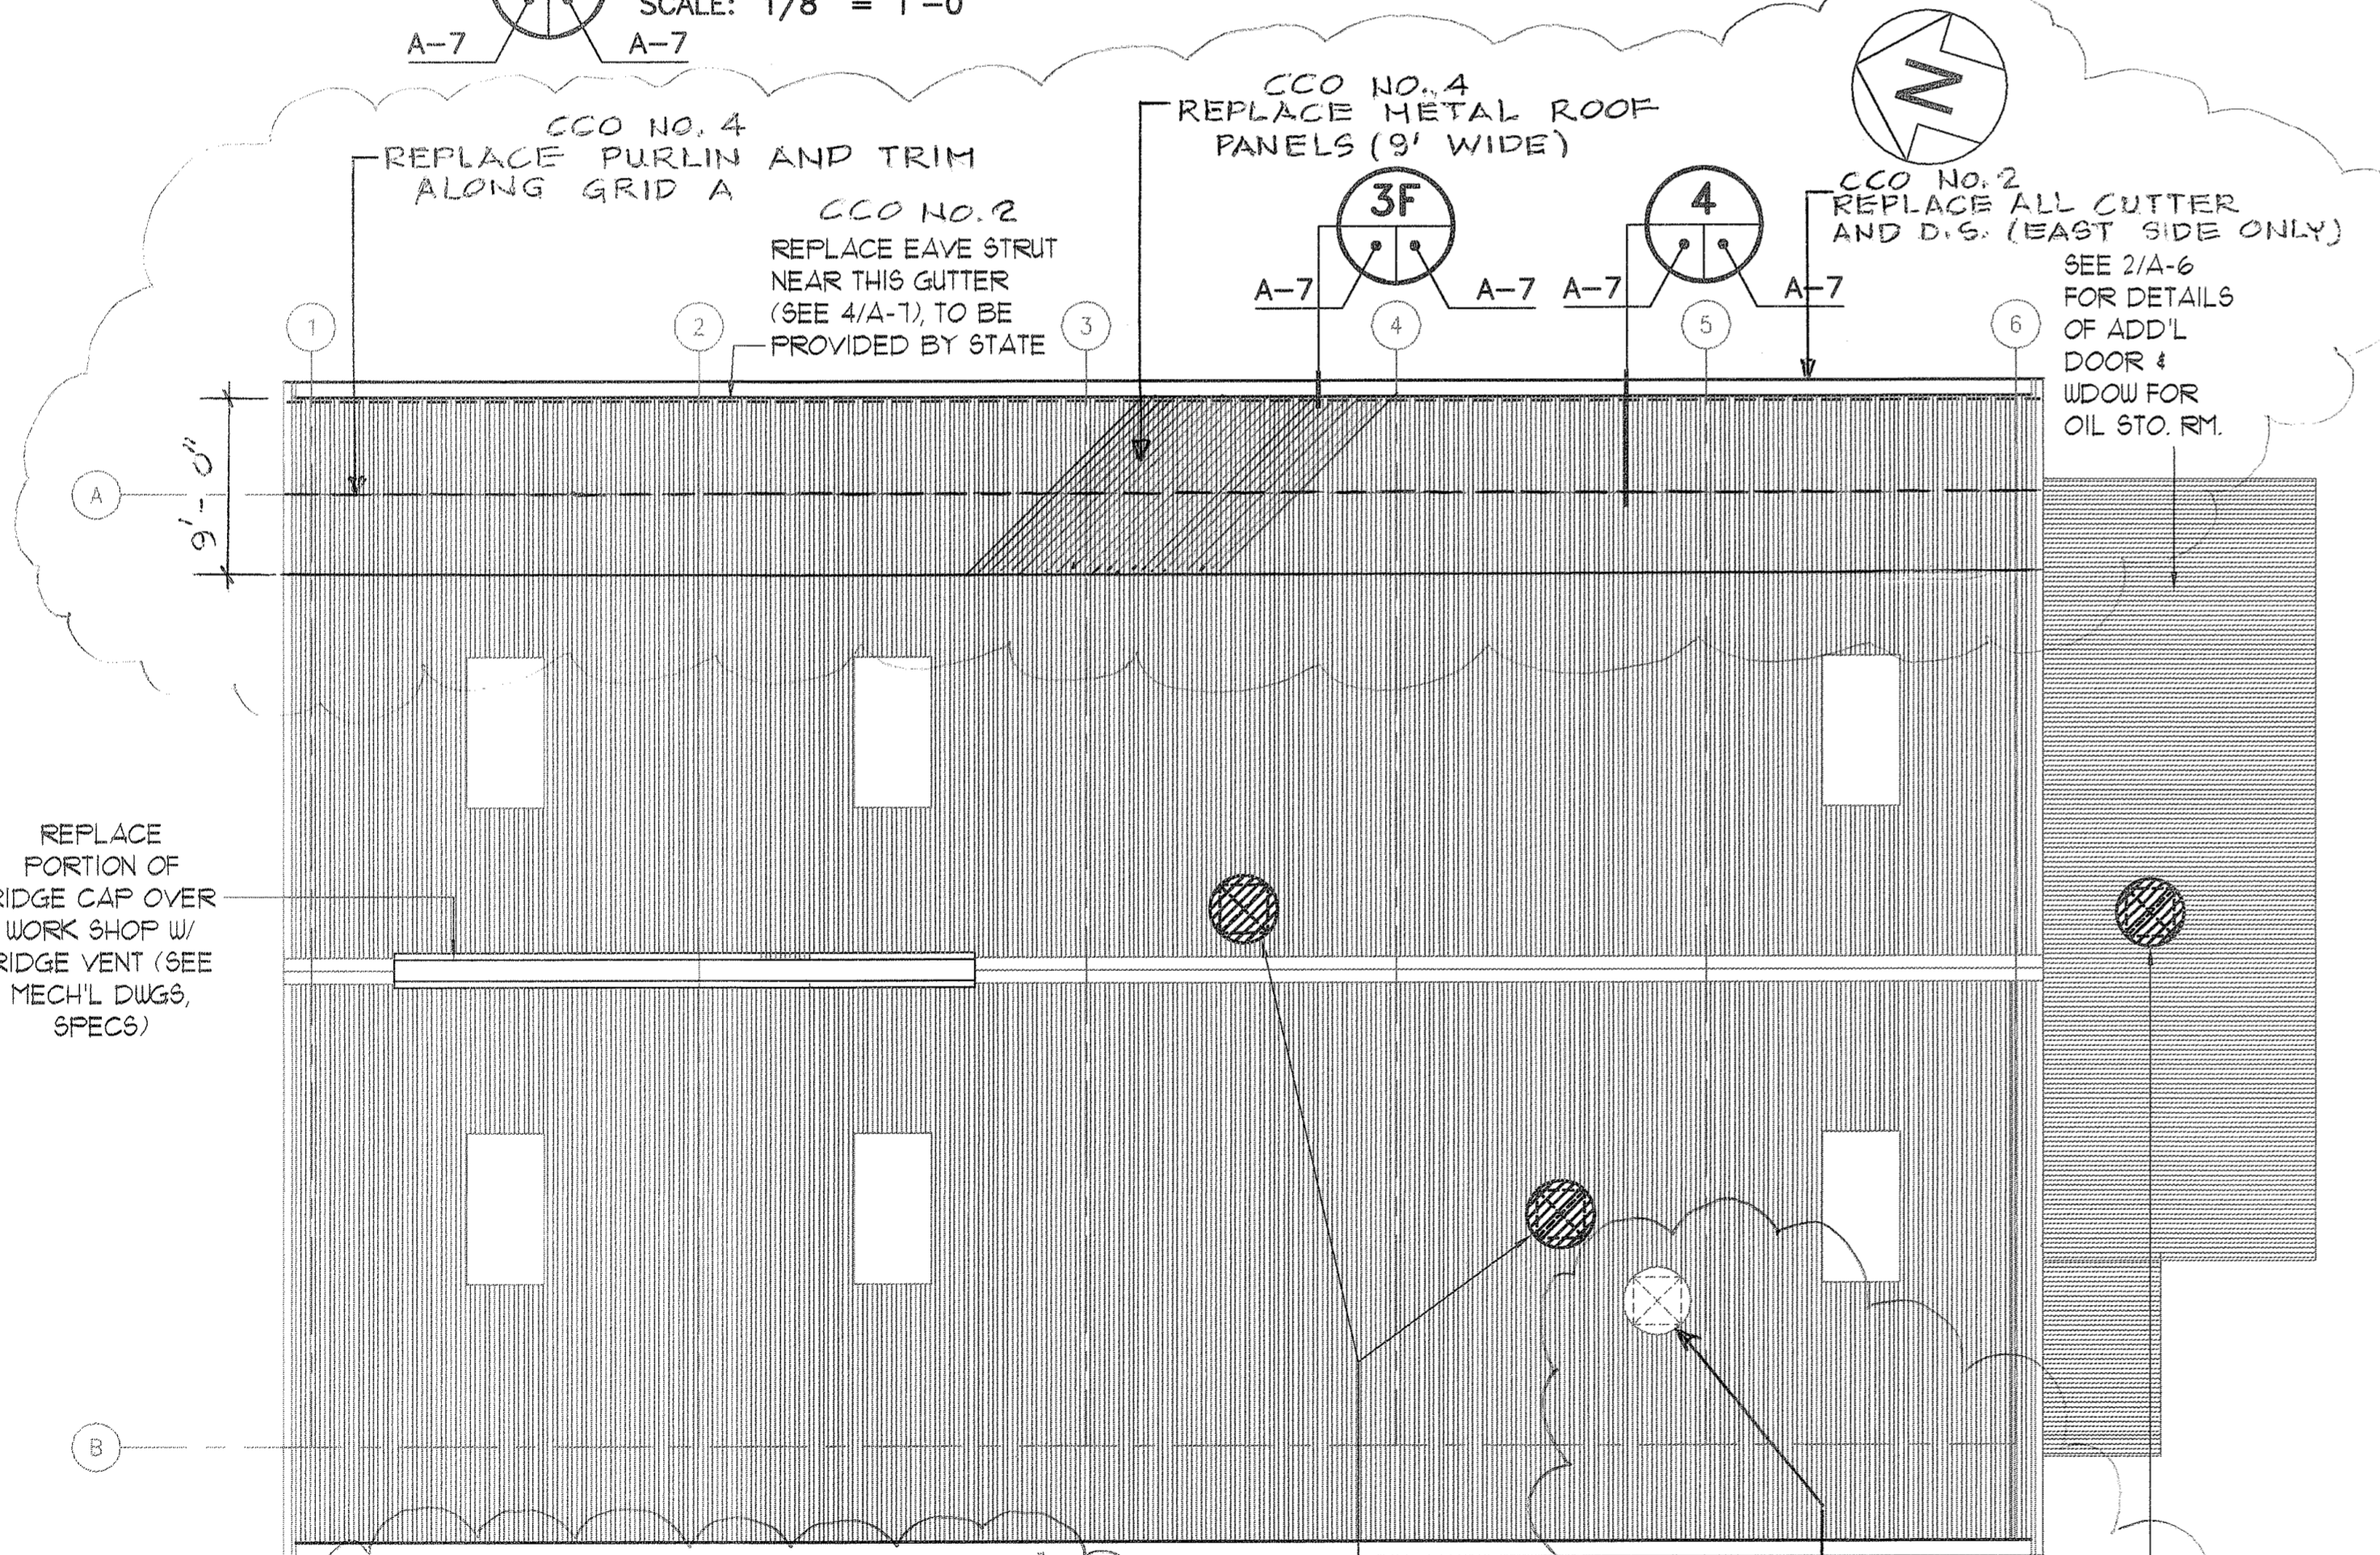

2 REPAIR SHOP BLDG. ROOF PLAN
SCALE: 1/8" = 1'-0"

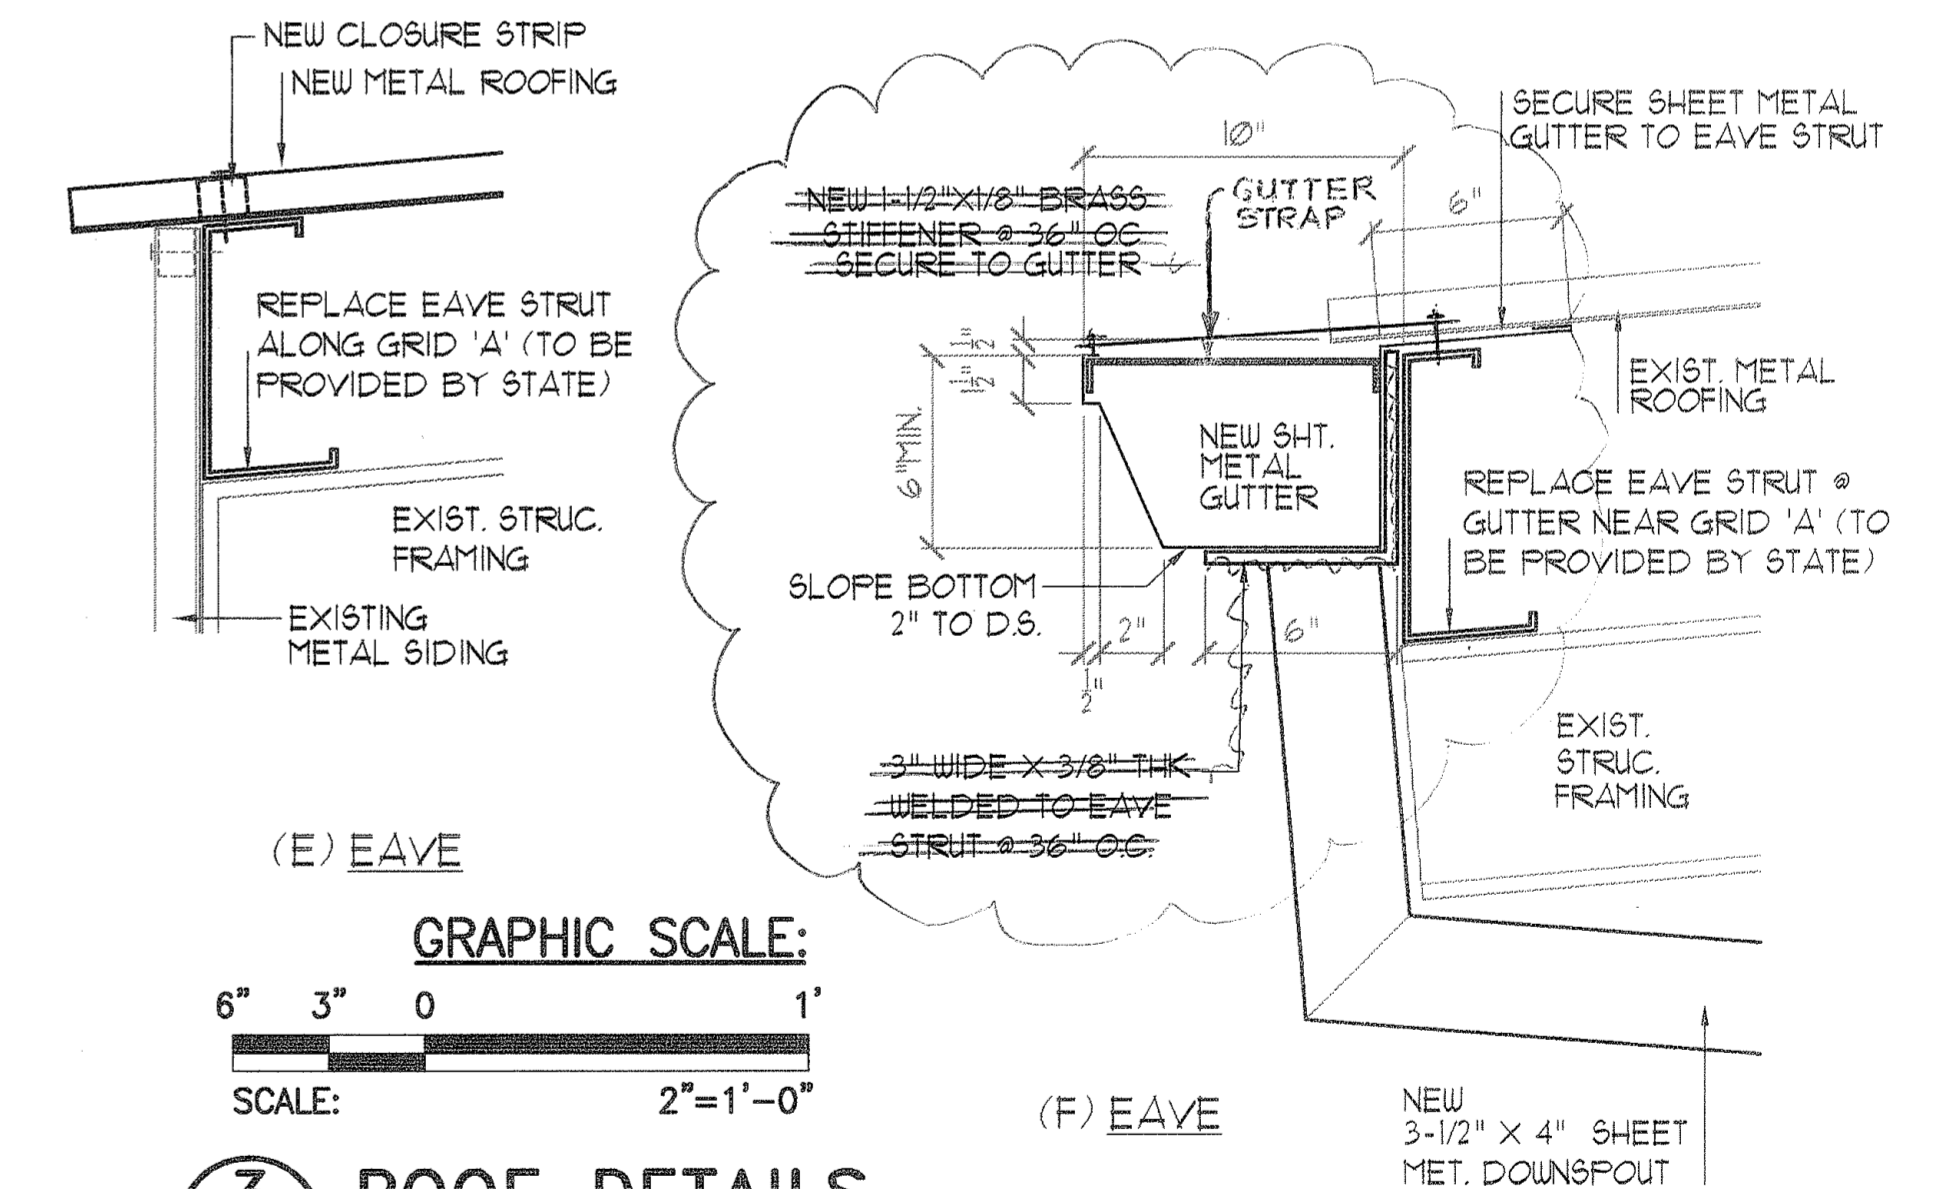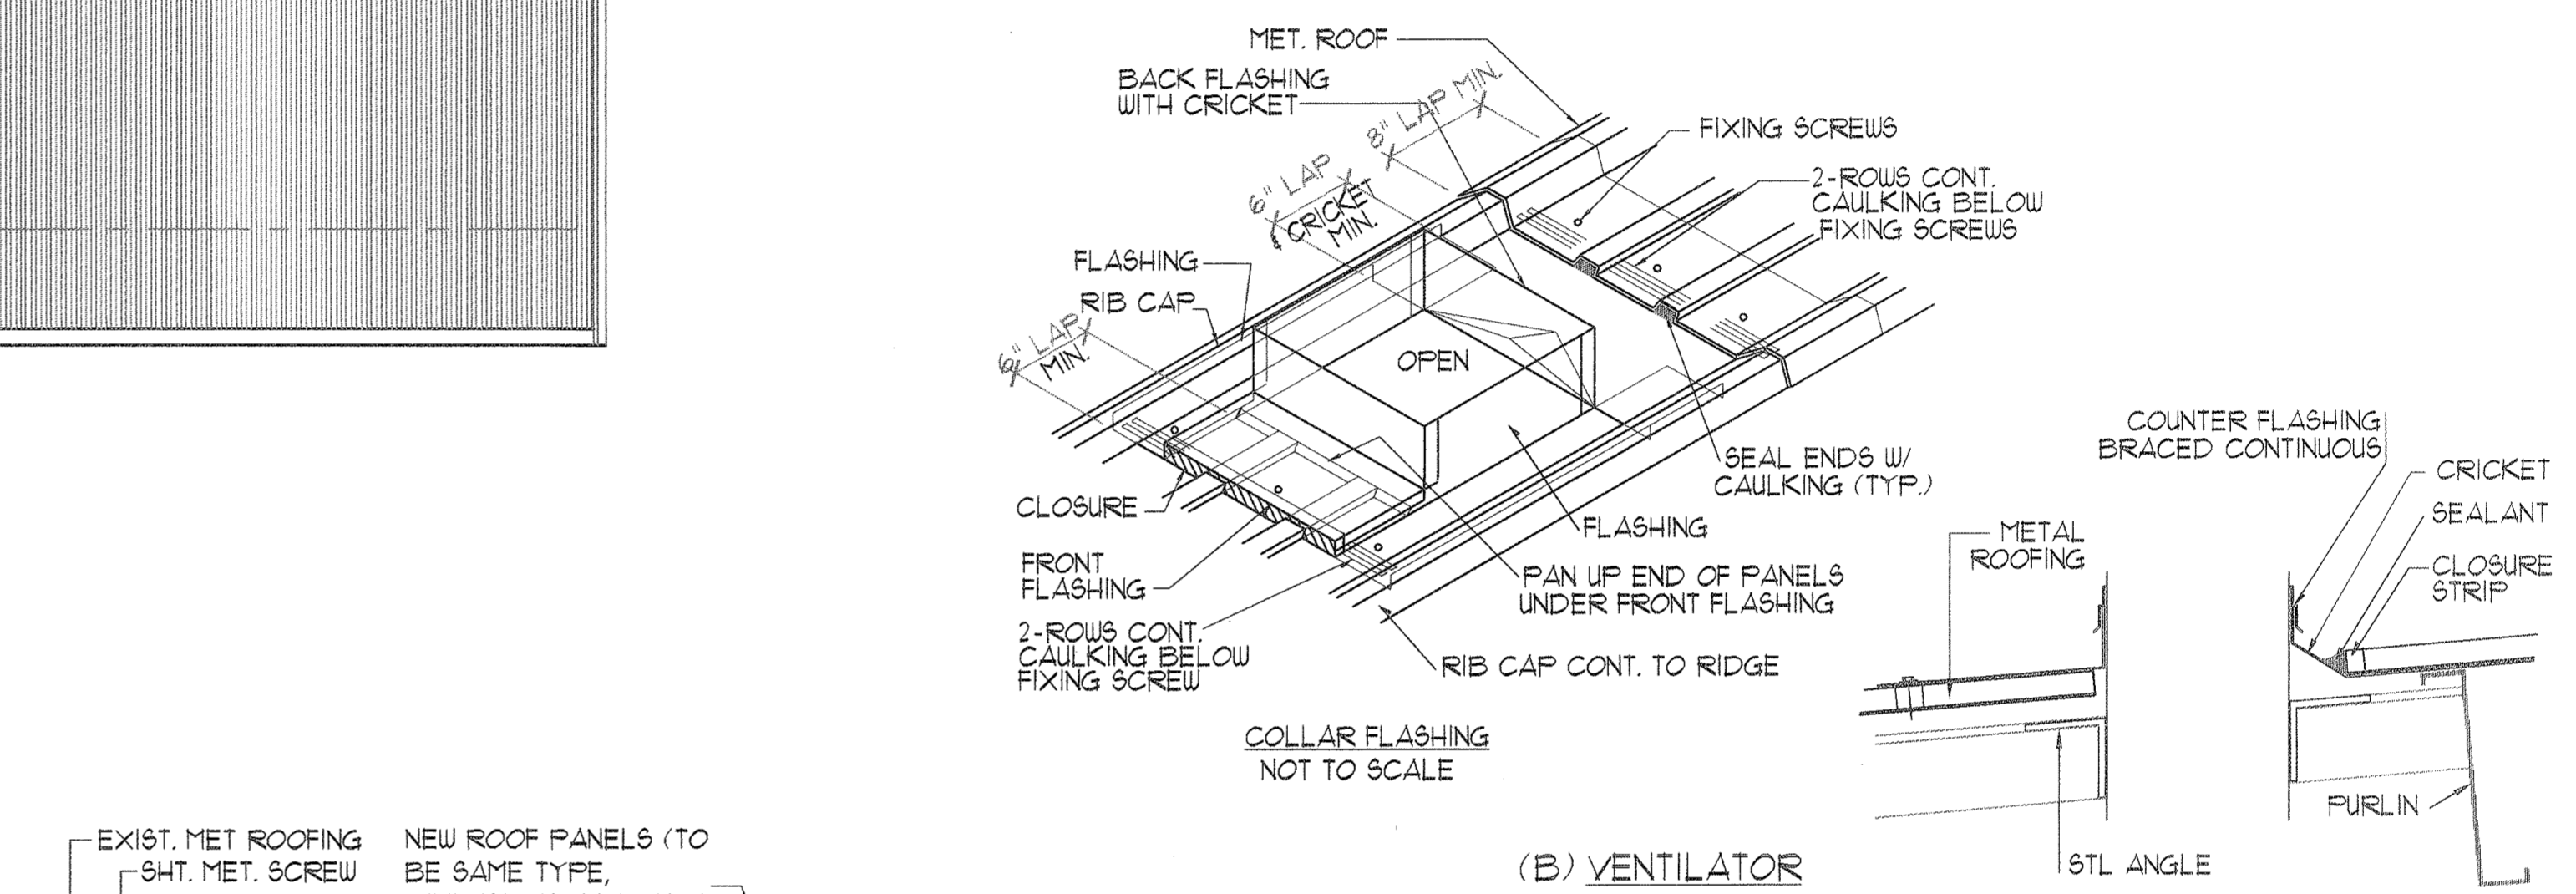

3 ROOF DETAILS
SCALE: 2" = 1'-0"

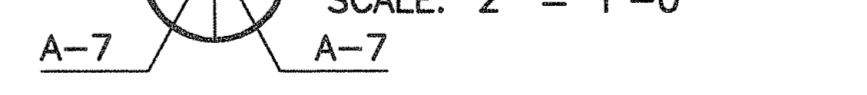

4 DOWNSPOUT DETAILS
SCALE: 1/2" = 1'-0"



DENNIS F. SATO
LICENSED PROFESSIONAL ARCHITECT
NO. 592
HAWAII, USA

THIS WORK WAS PREPARED BY ME OR UNDER MY SUPERVISION.
Signature 4/24/06

STATE OF HAWAII
DEPARTMENT OF TRANSPORTATION
HIGHWAYS DIVISION

MAINTENANCE & REPAIR SHOP BLDG.
ROOF PLANS: ROOF & DOWNSPOUT DETAILS

MAUI DISTRICT BASEYARD
REPAIR AND MAINTENANCE OF BUILDINGS AND GROUNDS, PHASE 3
PROJECT NO. HWY-M-08-04M

SCALE: AS NOTED
DATE: MAY 2005
SHEET No. A-7 OF 9 SHEETS