

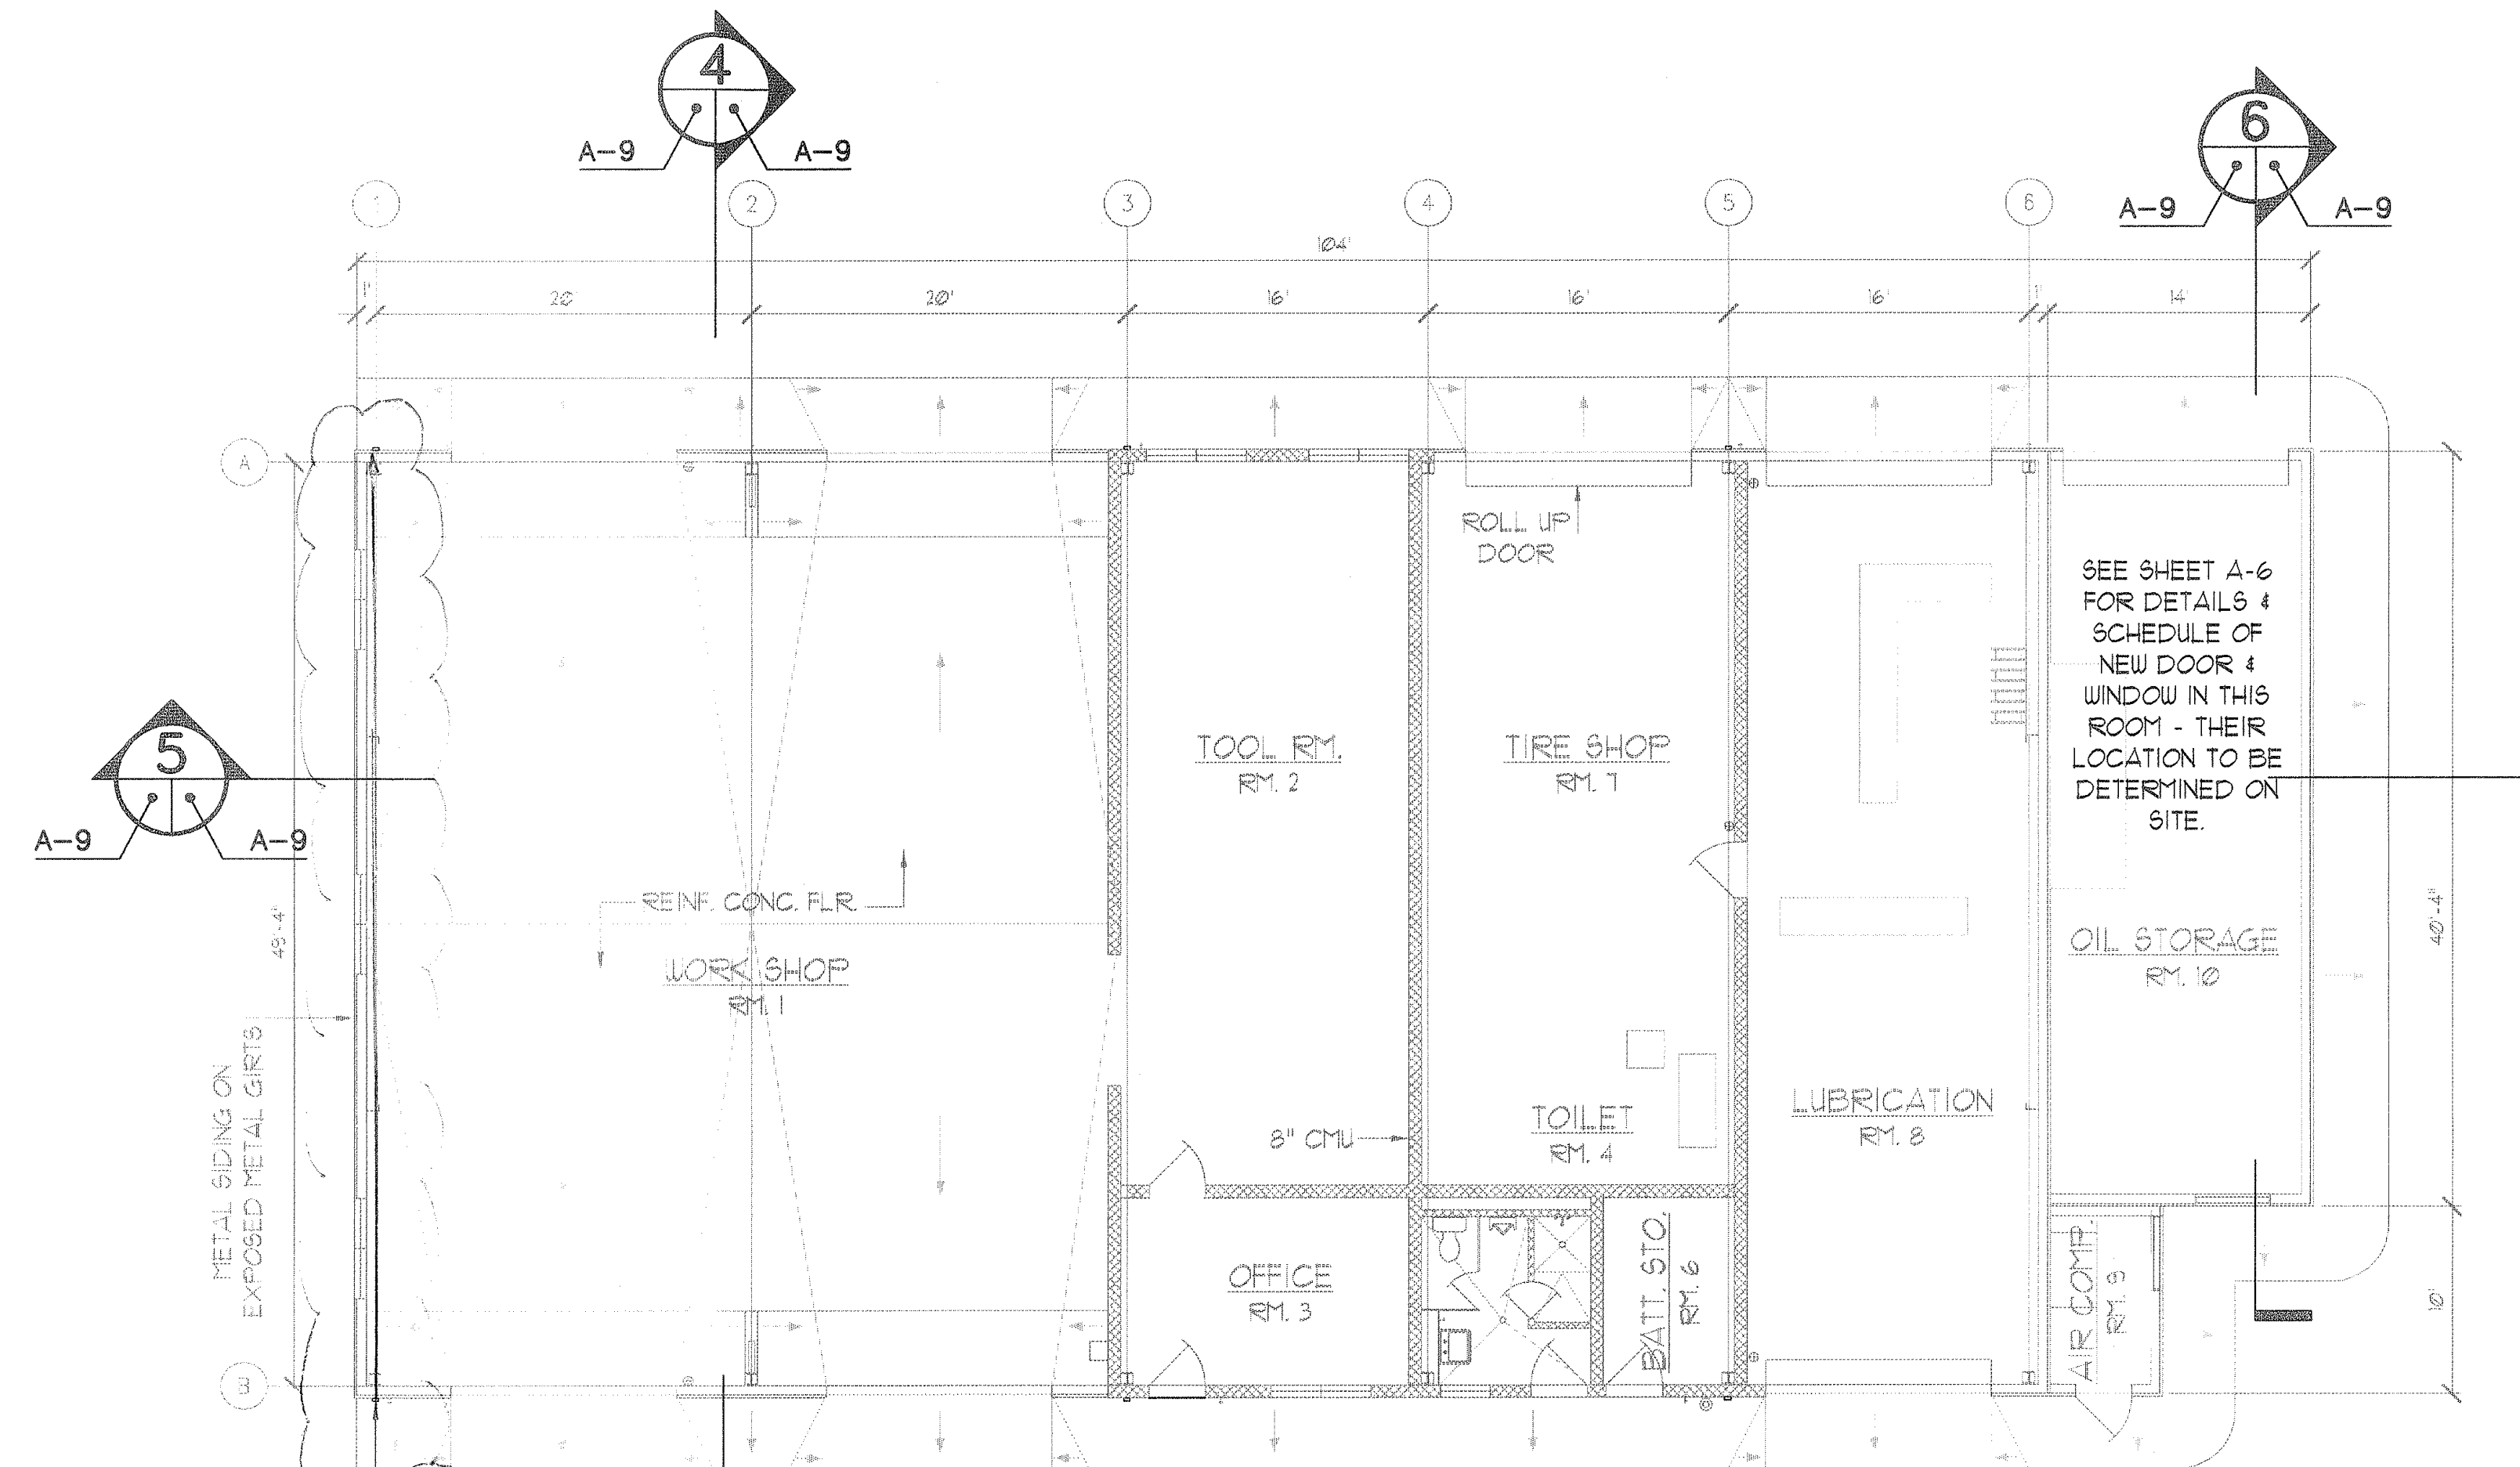


FED. ROAD DIST. NO.	STATE	PROJ. NO.	FISCAL YEAR	SHEET NO.	TOTAL SHEETS
HAWAII	HAW.	HWY-M-08-04M	2005	11	26

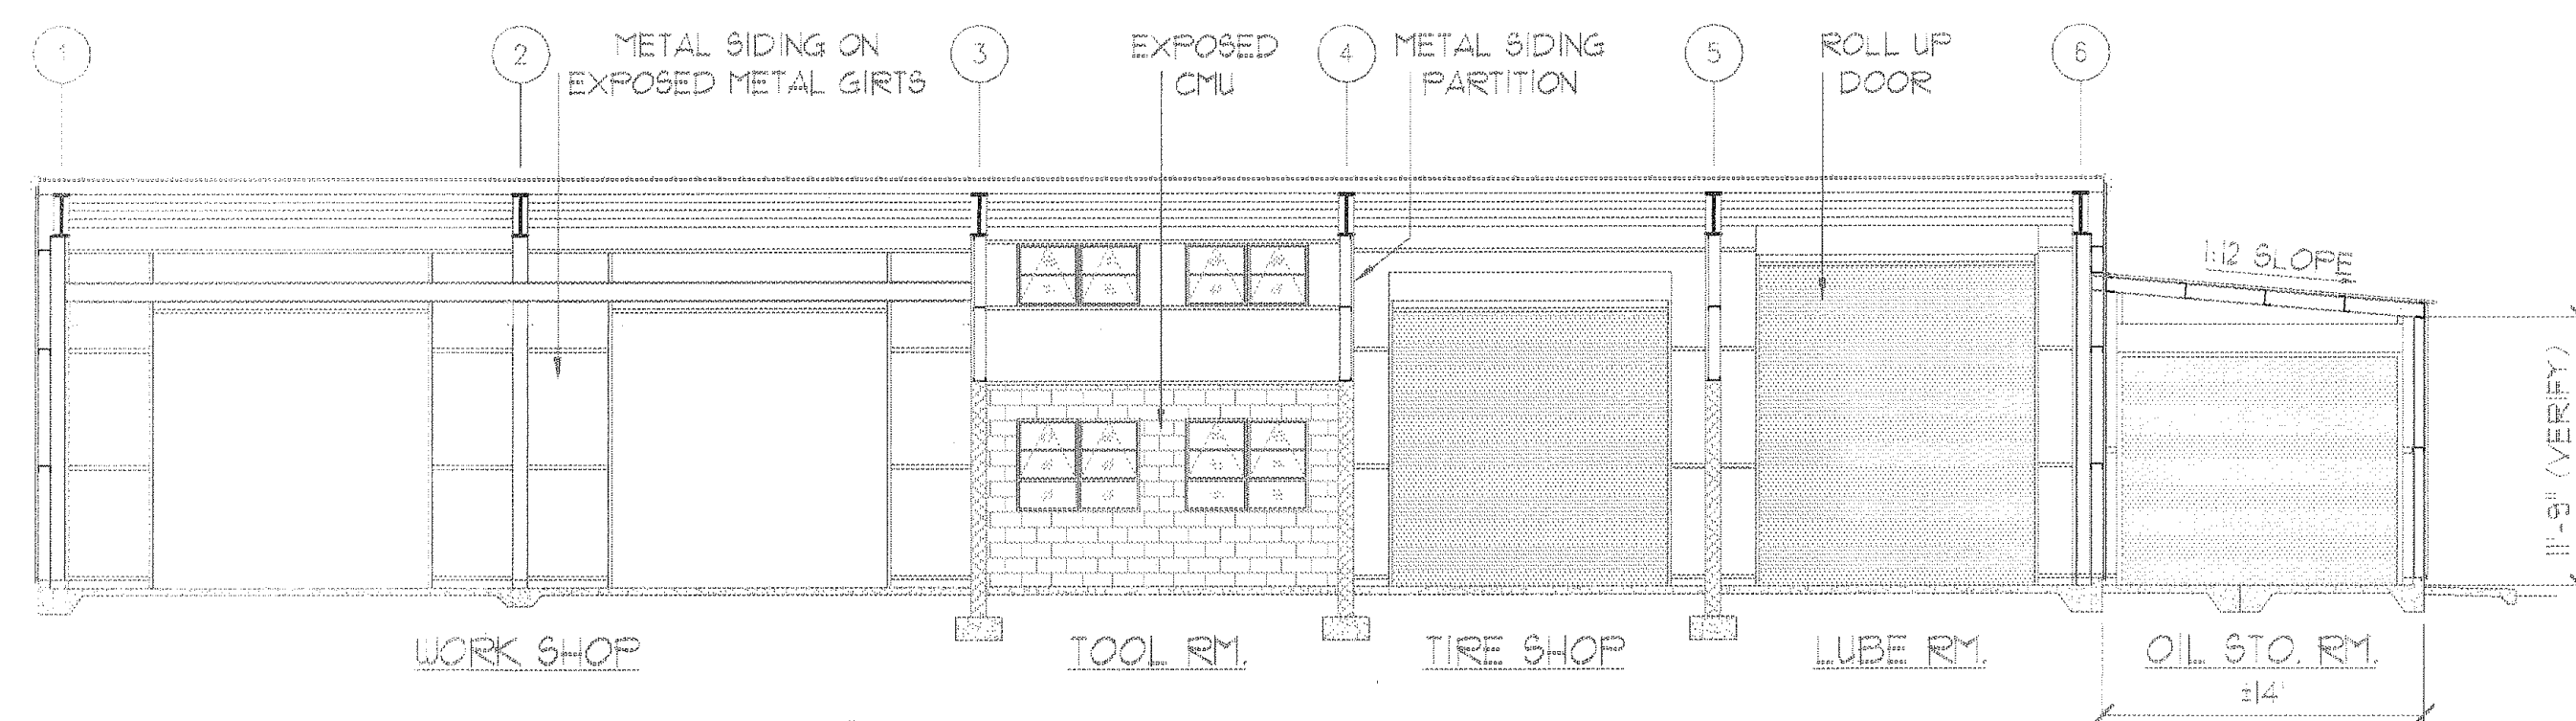


REPLACE ALL DOWNSPOUTS IN THE EAST SIDE OF THE BLDG. MATERIALS TO BE PROVIDED BY STATE.

1 FLOOR PLAN
SCALE: 1/8" = 1'-0"

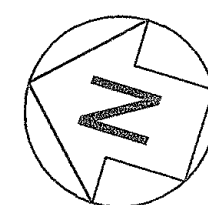


5 LONGITUDINAL SECTION
SCALE: 1/8" = 1'-0"

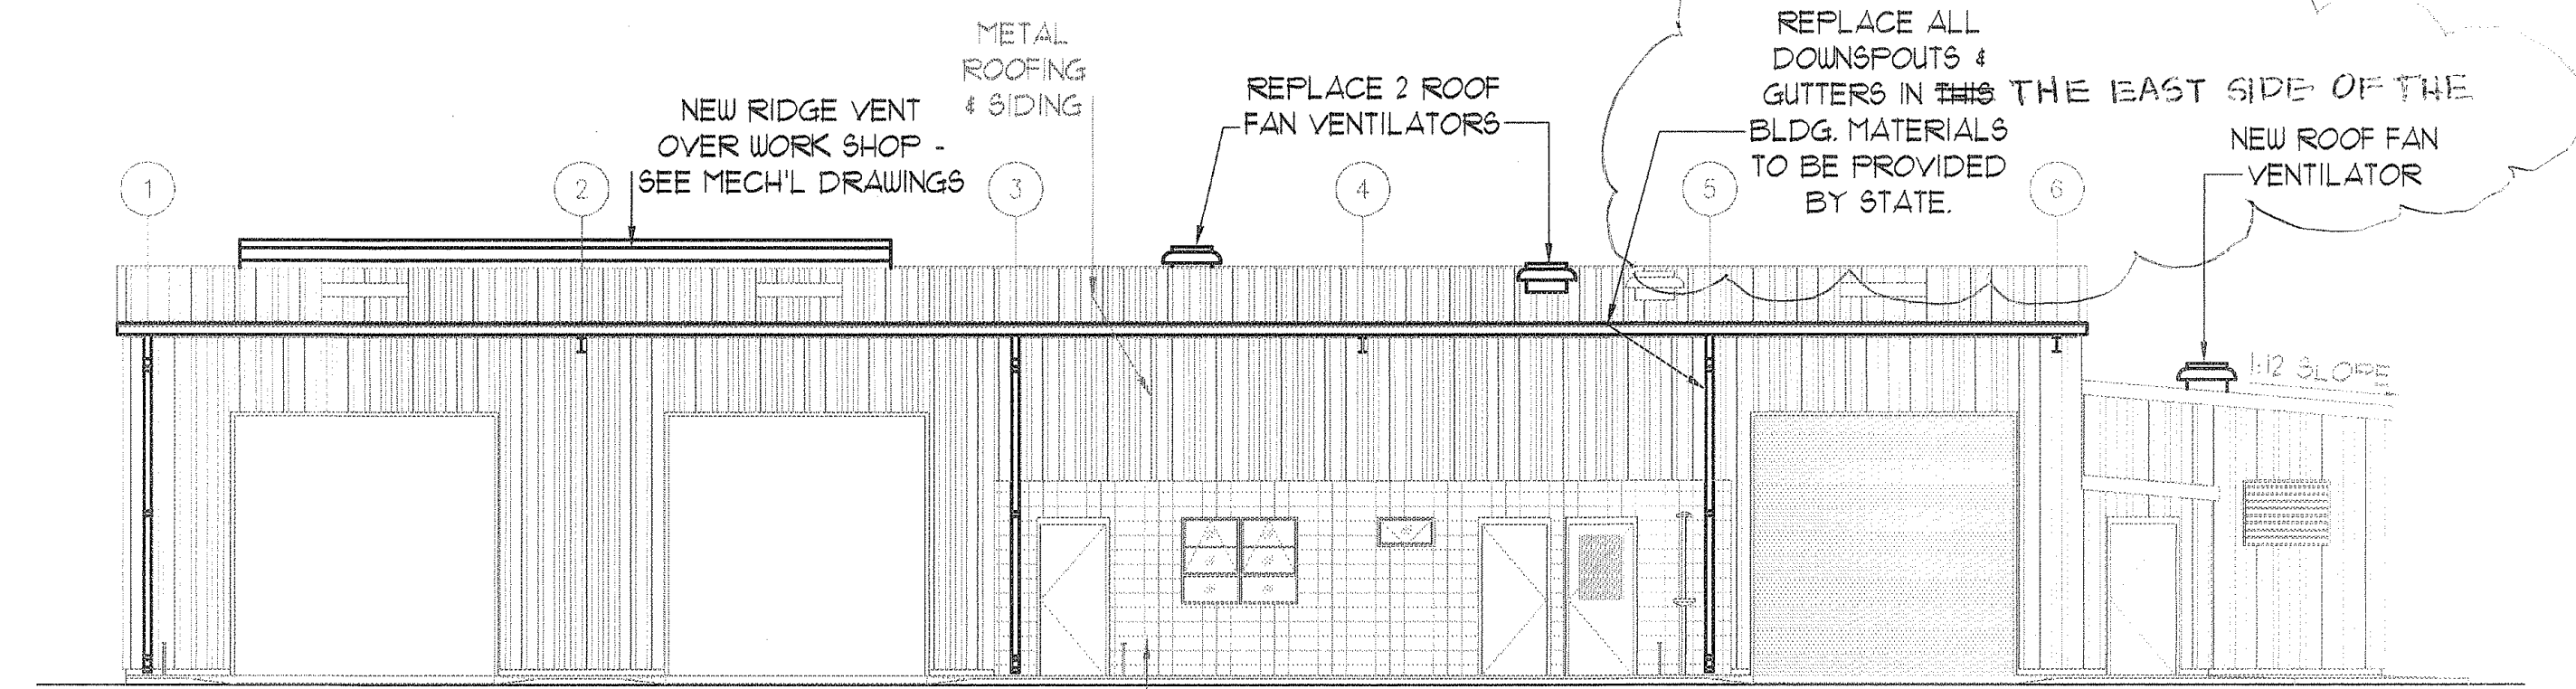


2 WEST EAST ELEVATION
SCALE: 1/8" = 1'-0"

NOTES


- 1) ALL ELEMENTS IN THIS BLDG. ARE EXISTING UNLESS NOTED OTHERWISE.
- 2) THESE DRAWINGS WERE BASED ON OLD PROJECT DRAWINGS & PHOTOS. SOME ELEMENTS MAY HAVE CHANGED.

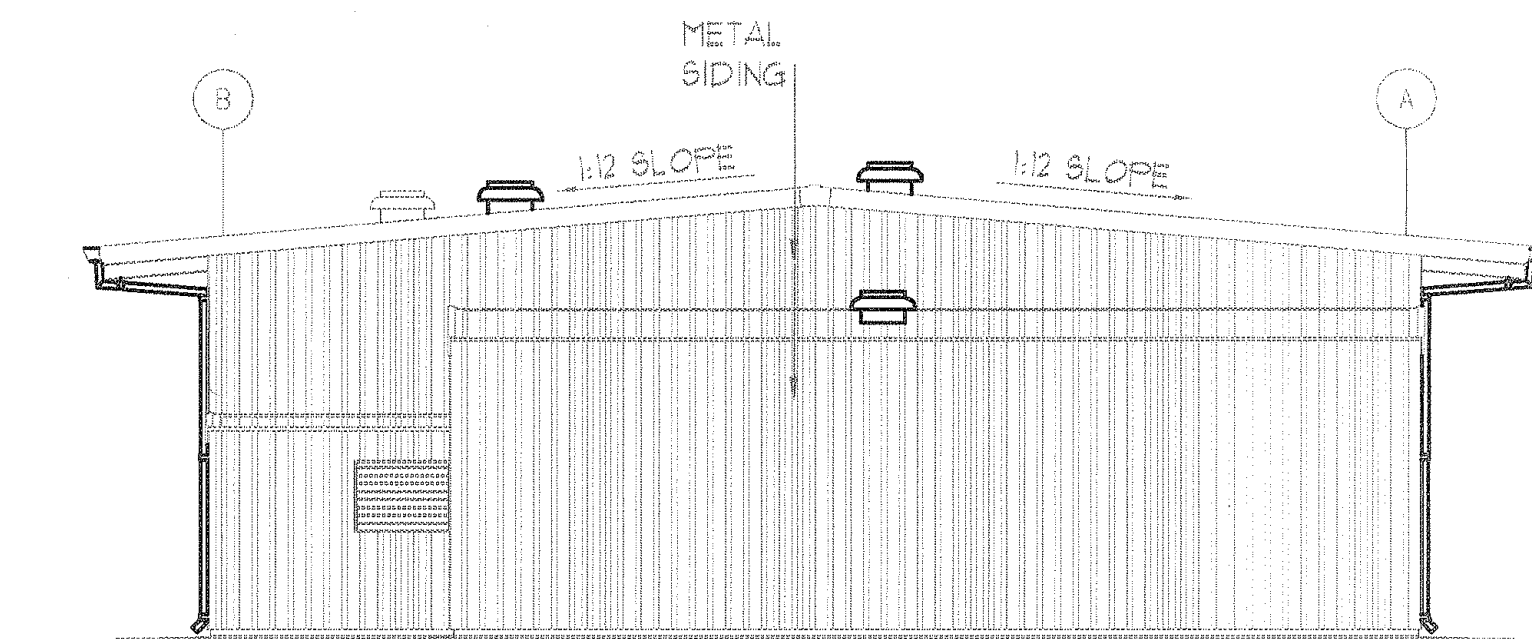



3 SOUTH NORTH ELEVATION
SCALE: 1/8" = 1'-0"

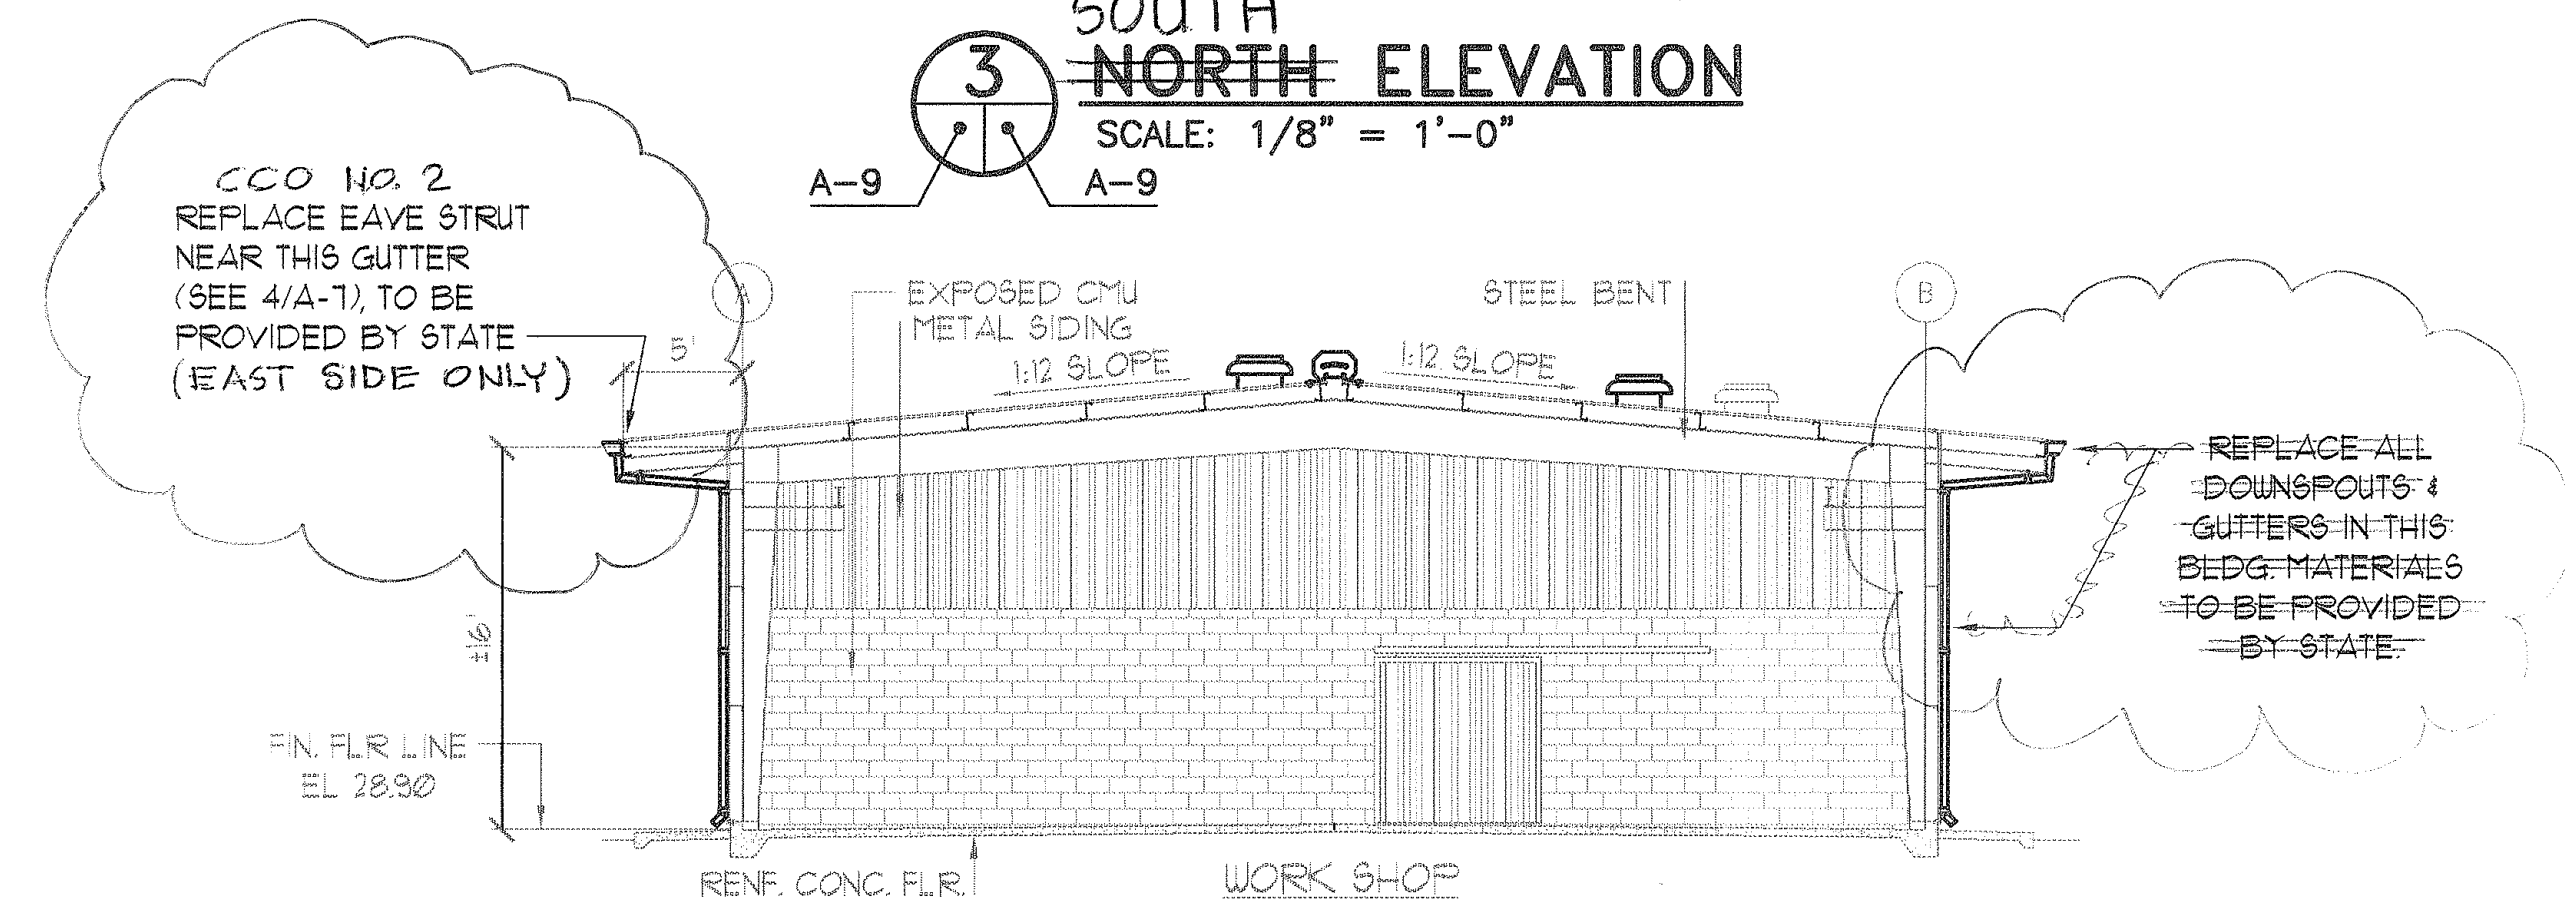

4 CROSS SECTION
SCALE: 1/8" = 1'-0"

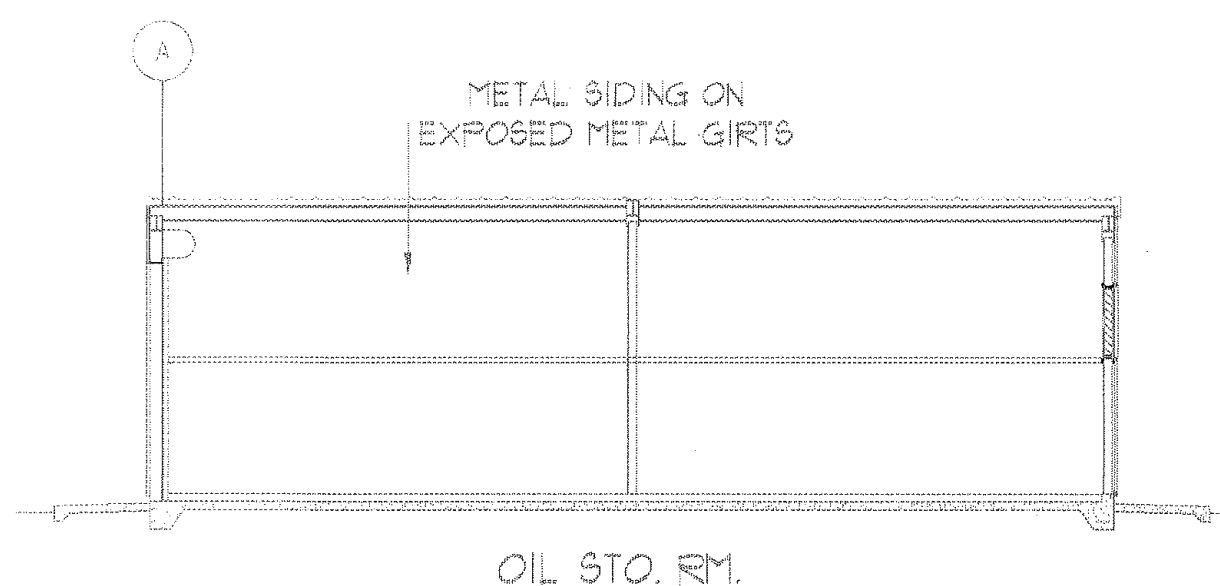

6 SECTION
SCALE: 1/8" = 1'-0"

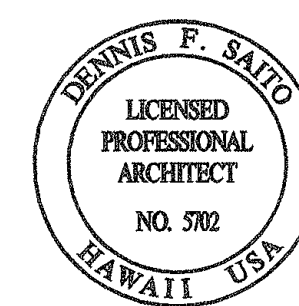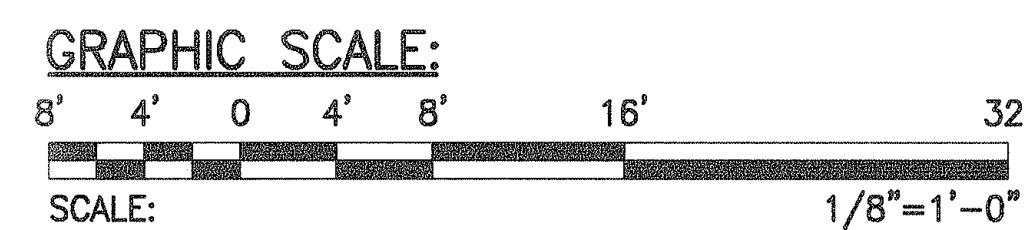

THIS WORK WAS PREPARED BY ME OR UNDER MY SUPERVISION.
Signature *Dennis F. Saido*
Date 4/14/06

STATE OF HAWAII
DEPARTMENT OF TRANSPORTATION
HIGHWAYS DIVISION


**REPAIR SHOP BUILDING
ELEVATIONS & SECTIONS**

MAUI DISTRICT BASEYARD
REPAIR AND MAINTENANCE OF
BUILDINGS AND GROUNDS, PHASE 3
PROJECT NO. HWY-M-08-04M


SCALE: 1/8" = 1'-0" DATE: MAY 2005

SHEET No. A-9 OF 9 SHEETS

"AS-BUILT"

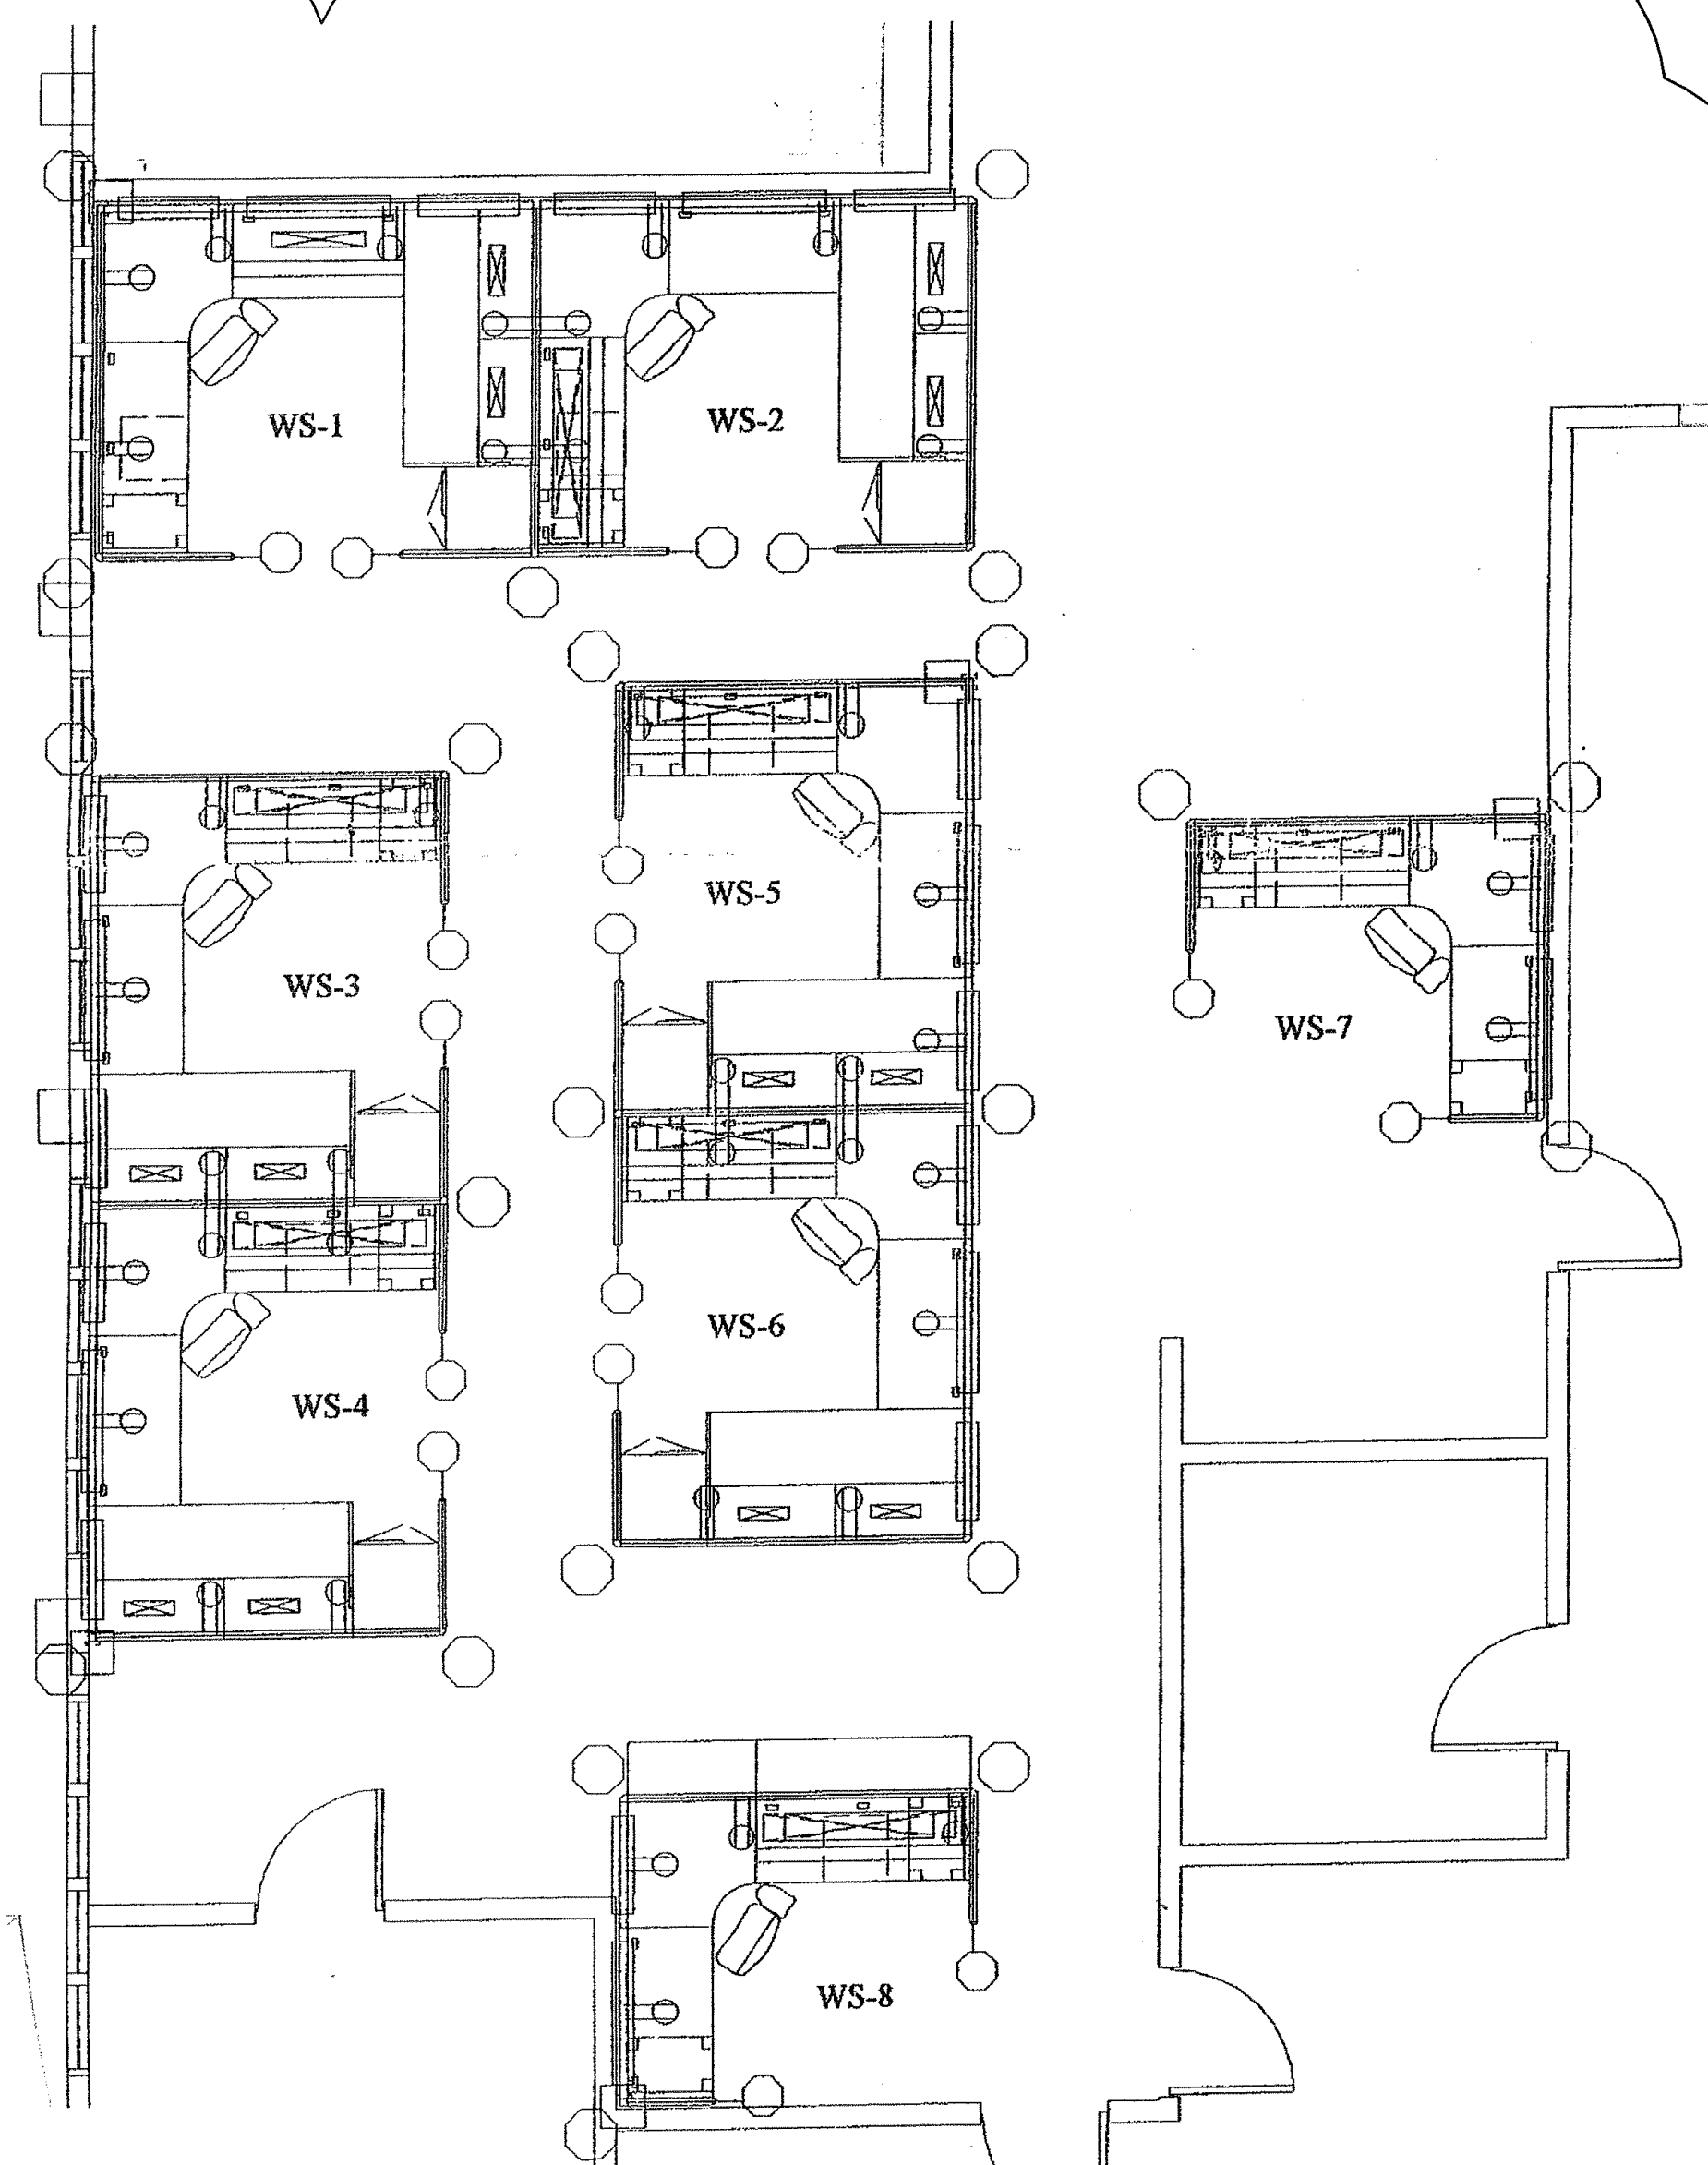

REV. WORK STATIONS LAYOUT
SCALE: 1/4"=1'-0"

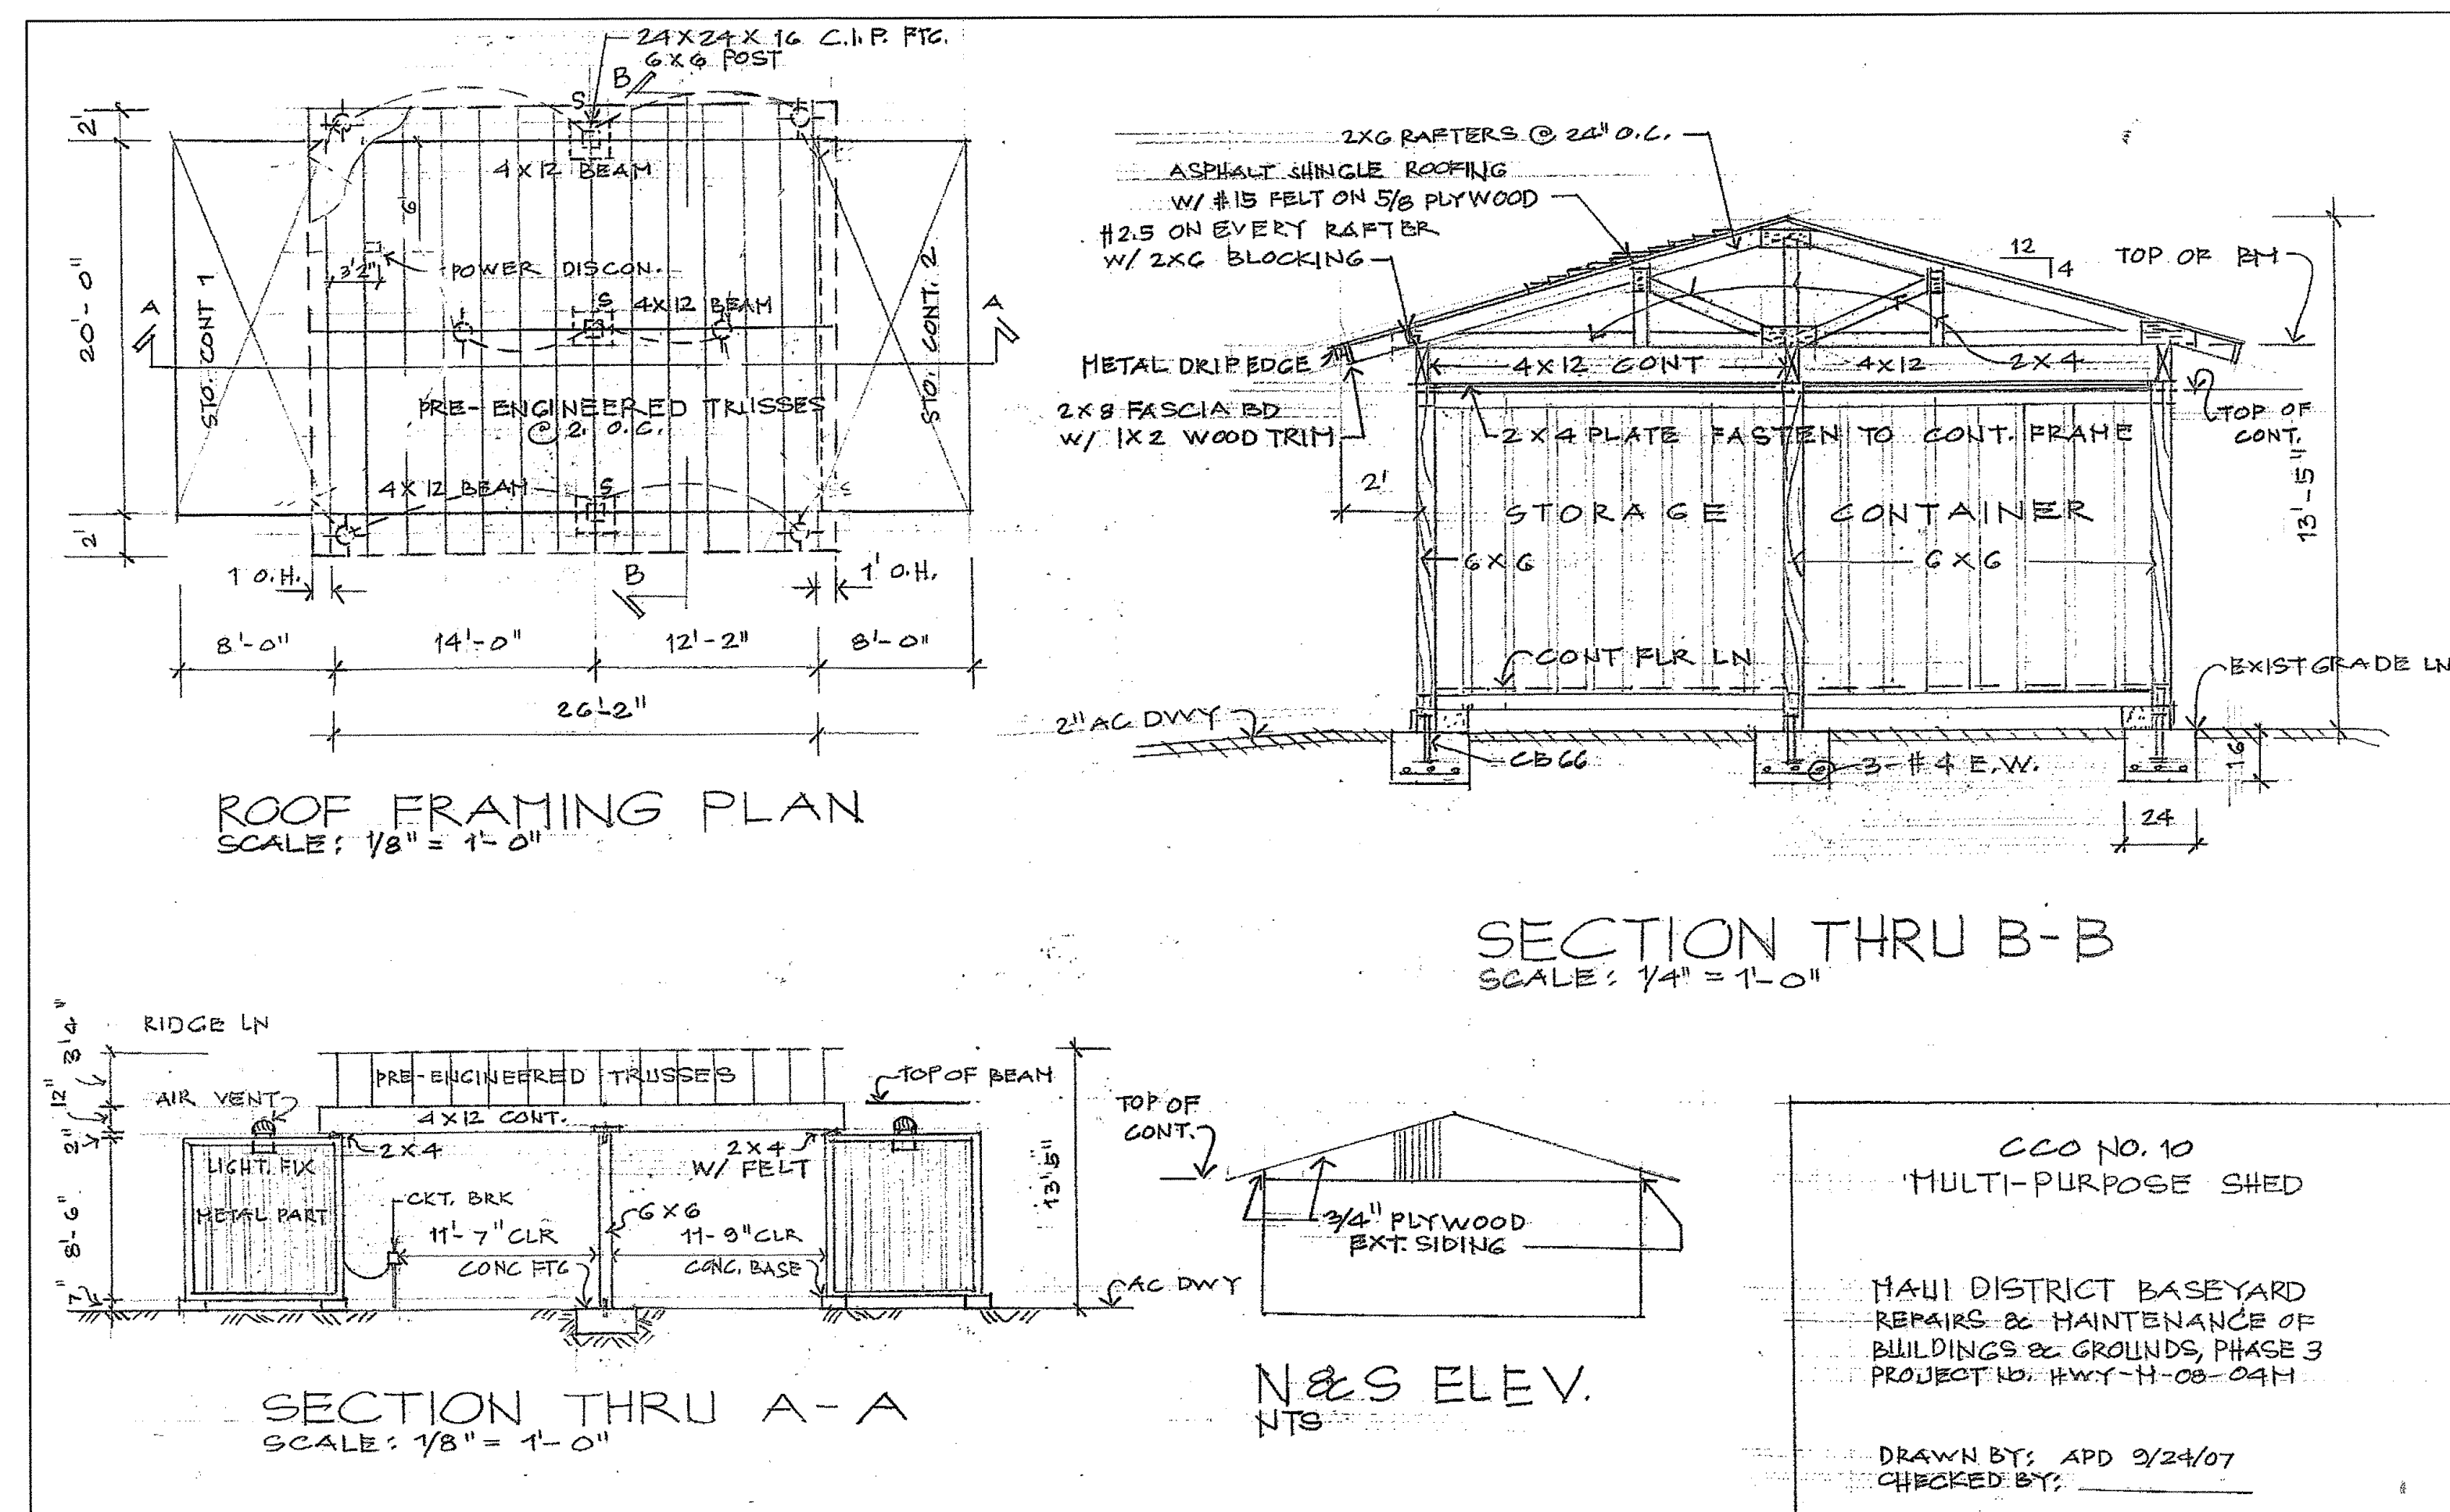

MULTI-PURPOSE SHED

AS-BUILT FEB 2008
ADDED THIS SHEET