

INDEX OF DRAWINGS

SHEET NUMBER	DRAWING NUMBER	DESCRIPTION
1	G-1	TITLE SHEET
2	G-2	PROJECT ORIENTATION
3	A-1	FLOOR PLAN, DEMOLITION PLAN, INTERIOR ELEVATIONS, SCHEDULE OF FINISHES, ABBREVIATIONS
4	A-2	COUNTER DETAILS, MOUNTING HEIGHTS, FLOOR / WALL TILE PATTERNS, FIXTURES & ACCESSORIES SCHEDULE
5	A-3	ADMIN BLDG. FLOOR AND CEILING PLAN
6	A-4	ADMIN BLDG. ROOF PLAN, DETAILS
7	A-5	TRUCK SHED FLOOR AND ROOF PLANS
8	A-6	TRUCK SHED SECTION AND ELEVATIONS
9	A-7	MAINTENANCE BLDG. AND REPAIR SHOP BLDG. ROOF PLANS, DETAILS
10	A-8	WORK STATIONS LAYOUT AND ISOMETRIC VIEWS, FURNITURE & EQUIPMENT SCHEDULE
11	A-9	REPAIR SHOP BUILDING ELEVATIONS & SECTIONS
12	M-1	MECHANICAL ABBREVIATIONS AND SCHEDULE
13	M-2	EXISTING MAINTENANCE OFFICE & SHOP BLDG MECHANICAL DEMOLITION PLANS
14	M-3	EXISTING MAINTENANCE OFFICE & SHOP BLDG MECHANICAL FLOOR AND ROOF PLAN
15	M-4	EXISTING REPAIR SHOP BLDG, MECHANICAL DEMOLITION PLANS
16	M-5	EXISTING REPAIR SHOP BLDG, MECHANICAL FLOOR AND ROOF PLAN
17	E-1	ELECTRICAL LEGEND, ABBREVIATIONS AND GENERAL NOTES
18	E-2	LIGHTING FIXTURES SCHEDULE & PANEL SCHEDULE
19	E-3	ELECTRICAL DETAILS - 1
20	E-4	ELECTRICAL DETAILS - 2
21	E-5	ELECTRICAL SITE PLAN
22	E-6	MODIFICATION OF EXISTING SINGLE LINE DIAGRAM
23	E-7	NEW PANEL E ELEVATION PLAN AND SCHEDULE
24	E-8	EXISTING ADMINISTRATION BLDG NEW LIGHTING PLAN
25	E-9	EXISTING MAINTENANCE OFFICE AND SHOP BLDG. FLOOR & ROOF PLAN, NEW EXHAUST FAN DIAGRAM
26	E-10	EXISTING REPAIR SHOP BLDG FLOOR & ROOF PLAN, NEW EXHAUST FAN DIAGRAM

115-1 A-9A REV. WORK STATIONS LAYOUT-CCO NO. 3, MULTI-PURPOSE SHED-CCO NO. 10

SHEET No. 115-1 IS SUPPLEMENTARY SHEET TO THIS PROJECT. TOTAL SHEET COUNT AFTER "AS BUILT" POSTINGS IS 27 SHEETS.

STATE OF HAWAII DEPARTMENT OF TRANSPORTATION


HIGHWAYS DIVISION
HONOLULU, HAWAII

AS - BUILT
PLANS FOR

MAUI DISTRICT BASEYARD



REPAIR AND MAINTENANCE OF
BUILDINGS AND GROUNDS PHASE 3
PROJECT NO. HWY-M-08-04M

DISTRICT OF WAILUKU
ISLAND OF MAUI

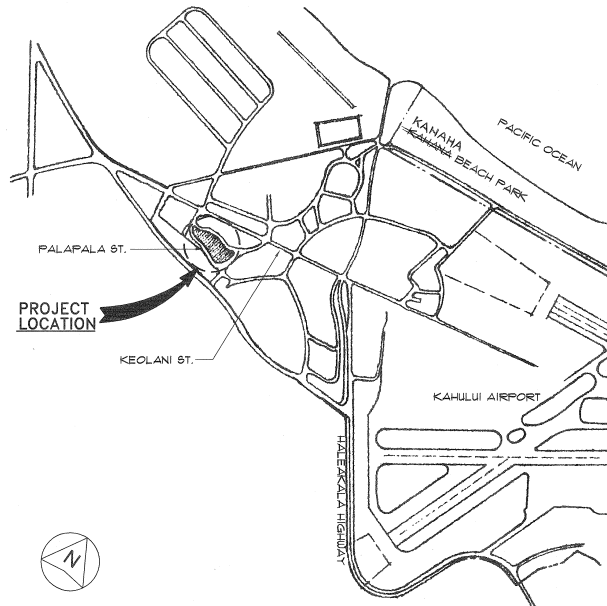

LOCATION MAP

FED. ROAD DIST. NO.	STATE	PROJ. NO.	FISCAL YEAR	SHEET NO.	TOTAL SHEETS
HAWAII	HAW.	HWY-M-08-04M	2005	1	27

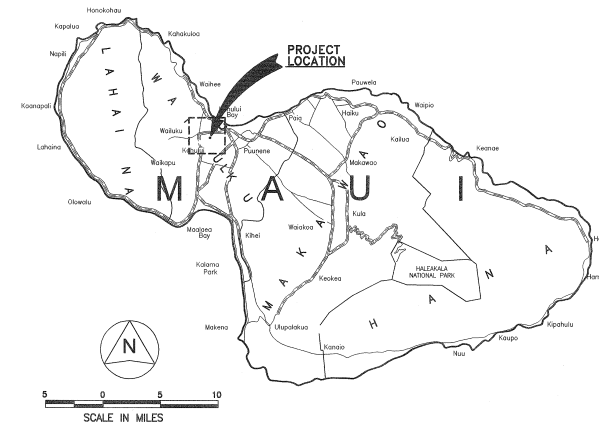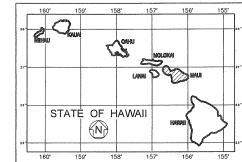

VICINITY MAP

ARCHITECT:
MATSUSHITA SAITO AND ASSOCIATES, INC.
PHONE: 808 944-1881 FAX: 808 943-1071 E-MAIL: msa-mailbox@hawaii.rr.com

MECHANICAL ENGINEERS:
GMP HAWAII, INC.
PHONE: 808 521-4711 FAX: 808 538-3269 E-MAIL: sgergis@gmpassociates.com

ELECTRICAL ENGINEERS:
GMP HAWAII, INC.
PHONE: 808 521-4711 FAX: 808 538-3269 E-MAIL: sgergis@gmpassociates.com

NO SIGNIFICANT CHANGES WERE MADE DURING CONSTRUCTION ON THESE PLANS EXCEPT CHANGES IN THE ORIGINAL THEORETICAL QUANTITIES. FOR ACTUAL QUANTITIES, REFER TO PROJECT LEDGER AND/OR COMPUTATION BOOK.

DESIGNED BY: DATE: 5-04-05



THIS WORK WAS PREPARED BY ME OR UNDER MY SUPERVISION.

DEPARTMENT OF TRANSPORTATION STATE OF HAWAII	
APPROVED:	DATE: 5-04-05
DIR. OF TRANSPORTATION	DATE

SHEET No. G-1 OF 2 SHEETS

HWY-M
MANAGED BY:
DESIGNED BY:
GMP HAWAII, INC.
PHONE: (808) 873-3535
DATE: MAY 2005