

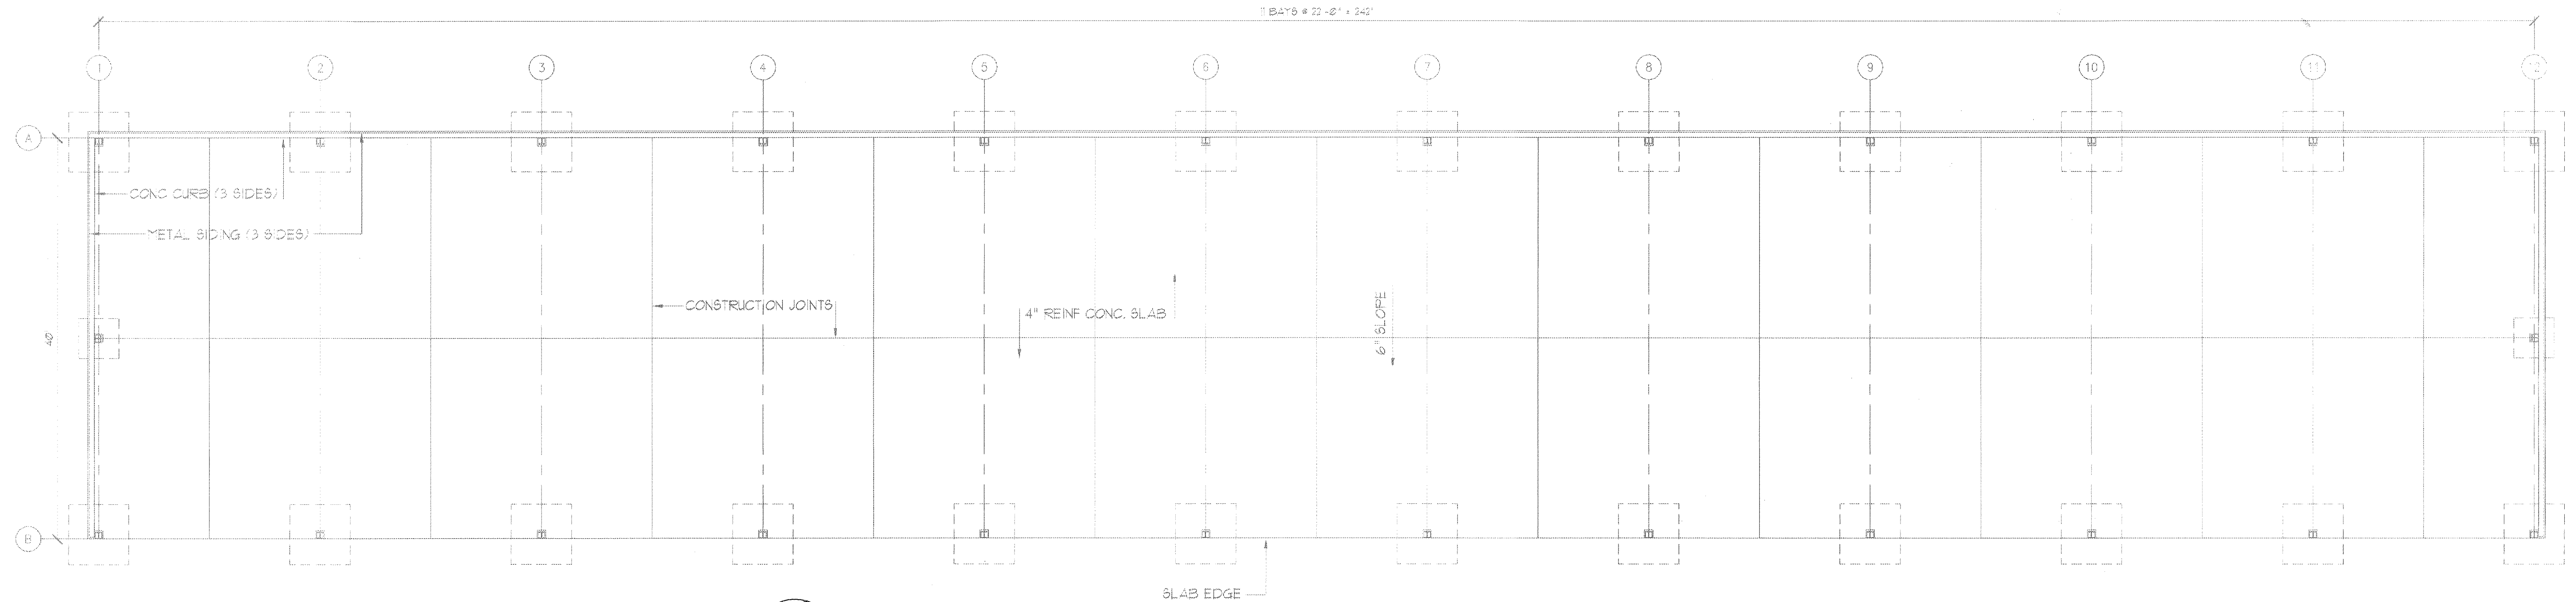


FED. ROAD DIST. NO.	STATE	PROJ. NO.	FISCAL YEAR	SHEET NO.	TOTAL SHEETS
HAWAII	HAW.	HWY-M-08-04M	2005	7	26

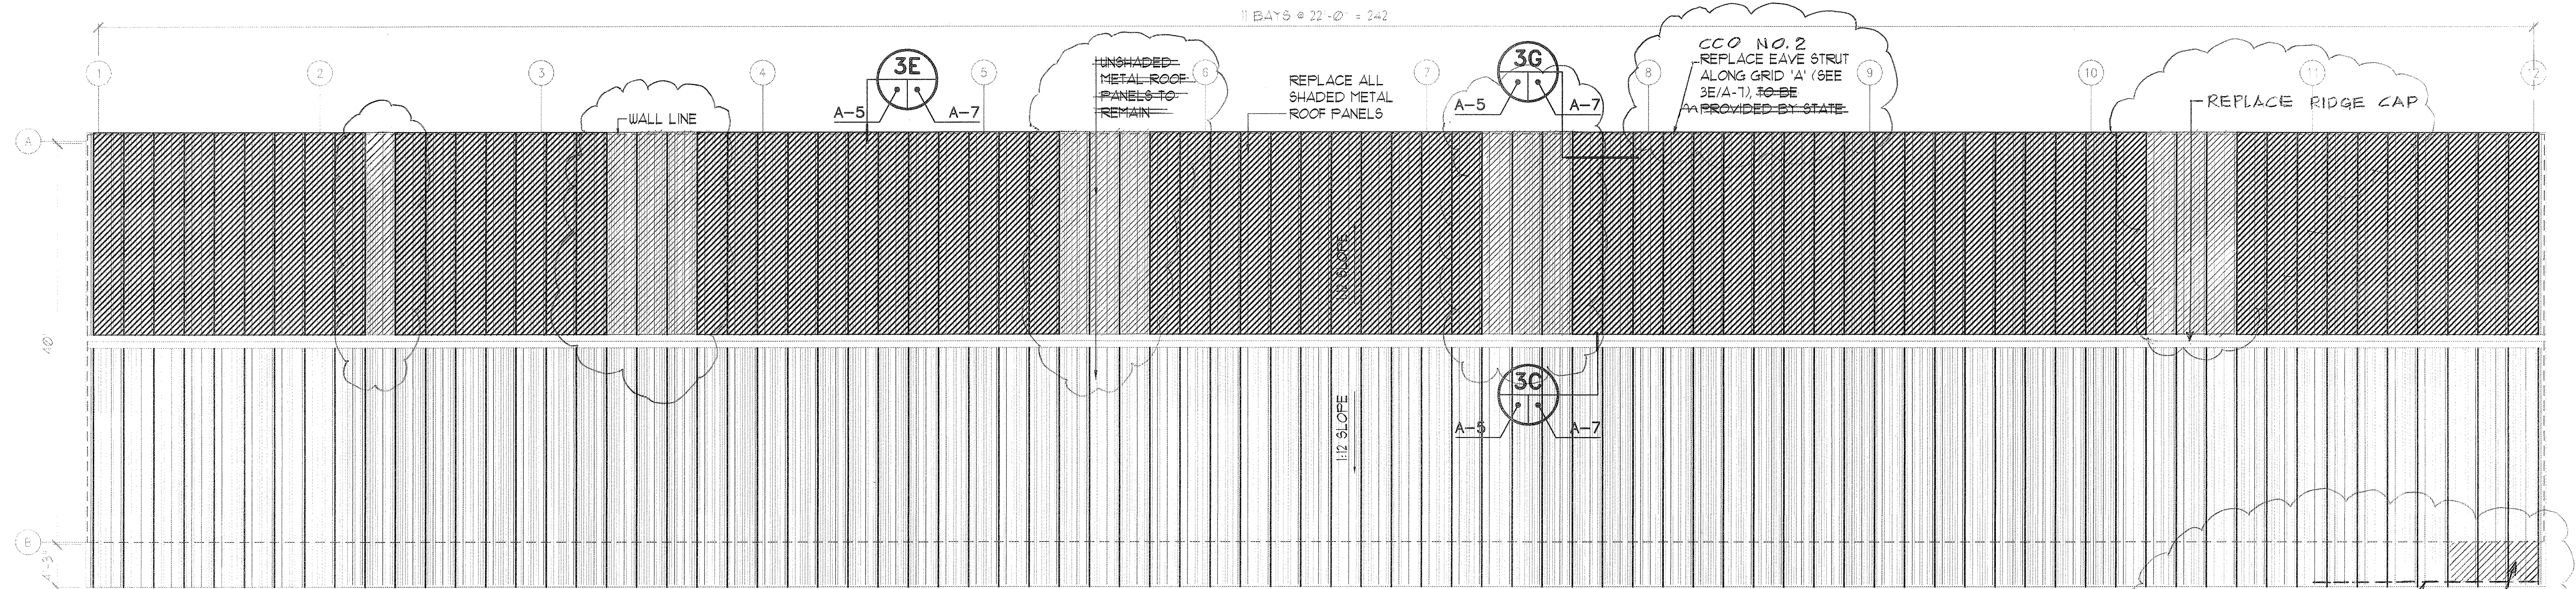

1 TRUCK SHED FLOOR PLAN
SCALE: 1/8" = 1'-0"
A-5

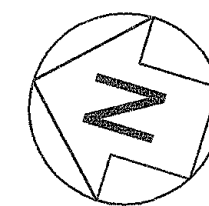



2 TRUCK SHED ROOF PLAN
SCALE: 1/8" = 1'-0"
A-5

NOTES

1) INVESTIGATE STRUCTURAL FRAMING, ENSURE STRUCTURAL INTEGRITY OF BUILDING BY PROVISION / REPAIR OR REPLACEMENT OF ANY MISSING OR DAMAGED MEMBERS SUCH AS CROSS TIES, ETC.

2) REMOVE AND DISPOSE OF DESIGNATED METAL ROOF PANELS (VERIFY EXACT LOCATION), REPLACE WITH NEW ONES OF THE SAME TYPE.

GRAPHIC SCALE:

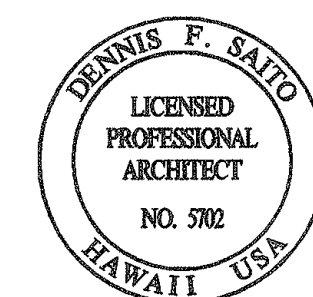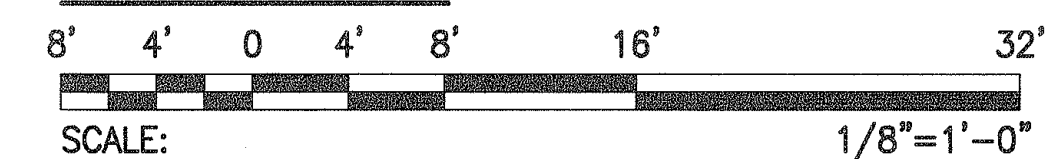

THIS WORK WAS PREPARED BY ME OR UNDER MY SUPERVISION.
Dennis F. Saito
Signature 4/14/06

STATE OF HAWAII
DEPARTMENT OF TRANSPORTATION
HIGHWAYS DIVISION

**TRUCK SHED BLDG
FLOOR & ROOF PLANS**


MAUI DISTRICT BASEYARD
REPAIR AND MAINTENANCE OF
BUILDINGS AND GROUNDS, PHASE 3
PROJECT NO. HWY-M-08-04M

SCALE: 1/8" = 1'-0" DATE: MAY 2005
SHEET No. A-5 OF 9 SHEETS

"AS-BUILT"


FED. ROAD DIST. NO.	STATE	PROJ. NO.	FISCAL YEAR	SHEET NO.	TOTAL SHEETS
HAWAII	HAW.	HWY-M-08-04M	2005	8	26

NOTE: LOCATION OF DOOR & WINDOW TO BE DETERMINED ON SITE


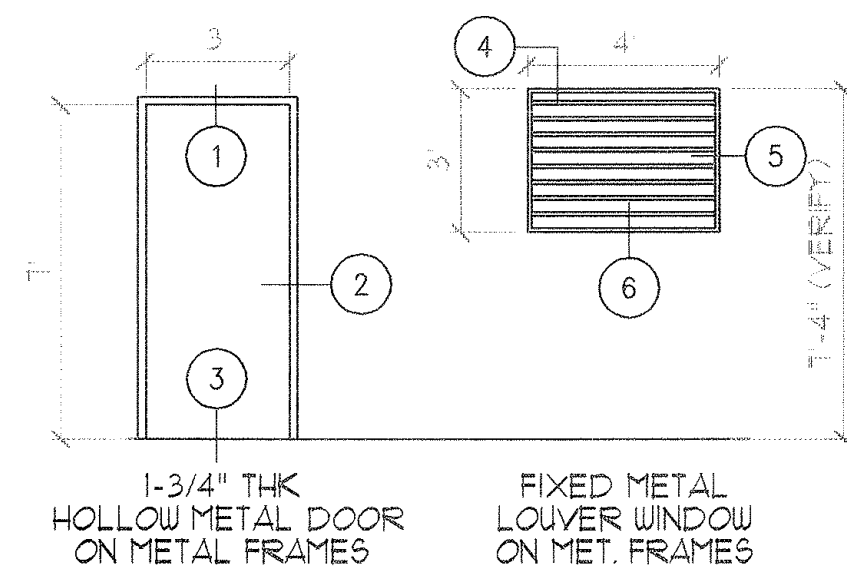


OIL STORAGE ROOM (REPAIR SHOP BLDG) DOOR & WINDOW SCHEDULE

SCALE: 1/4" = 1'-0"

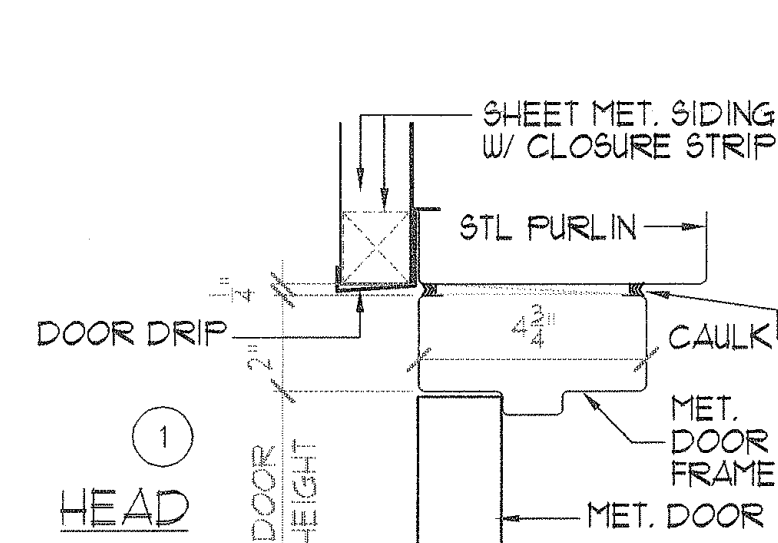


DETAILS
SCALE: 3" = 1'-0"

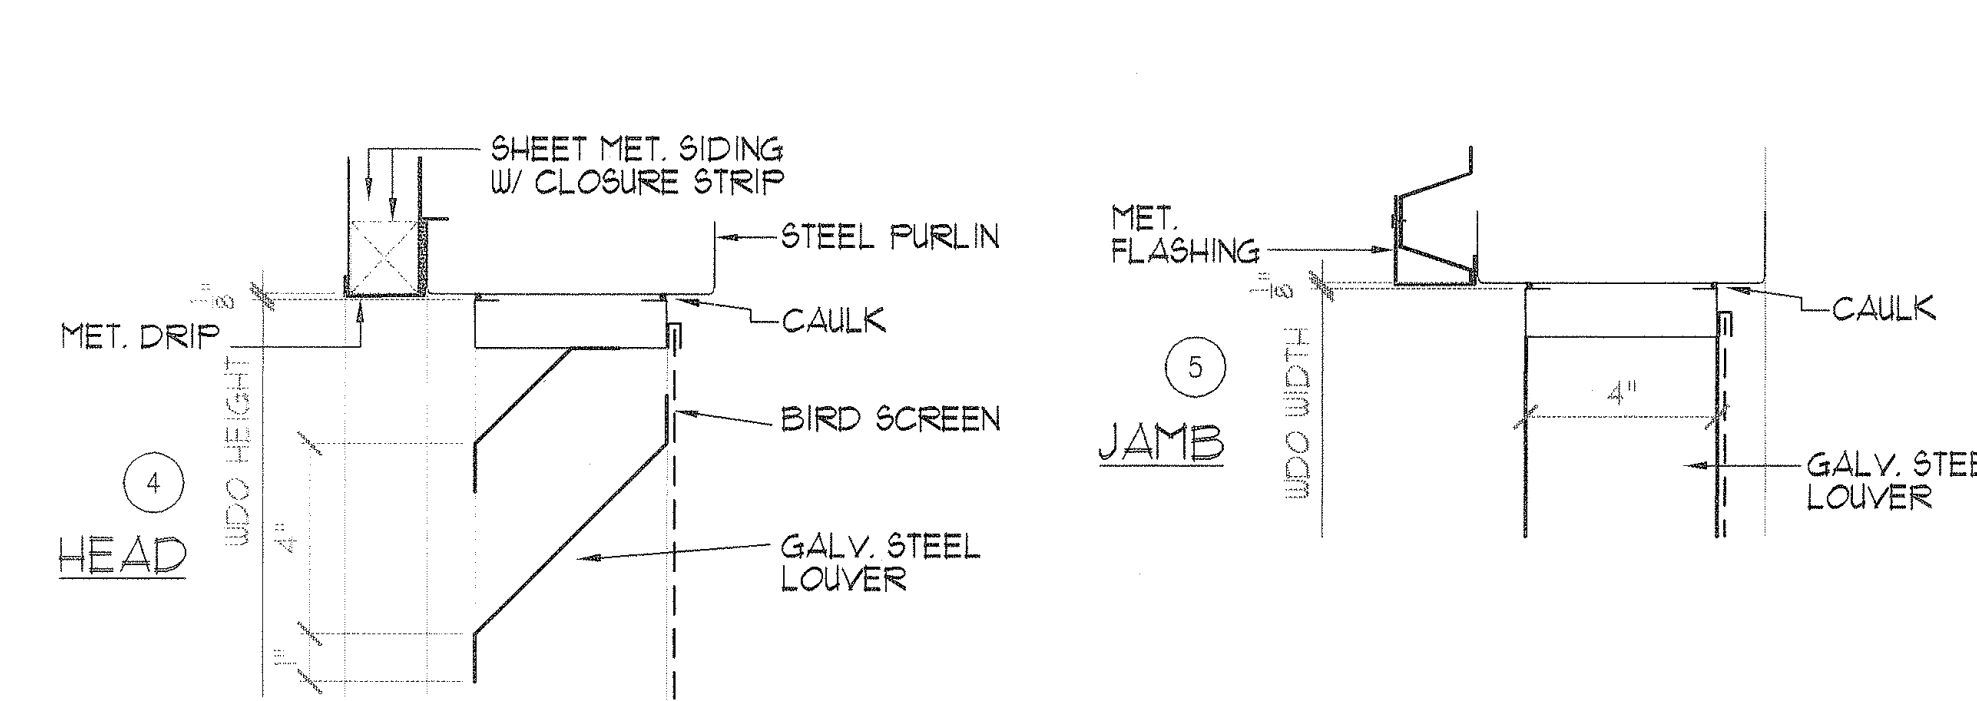
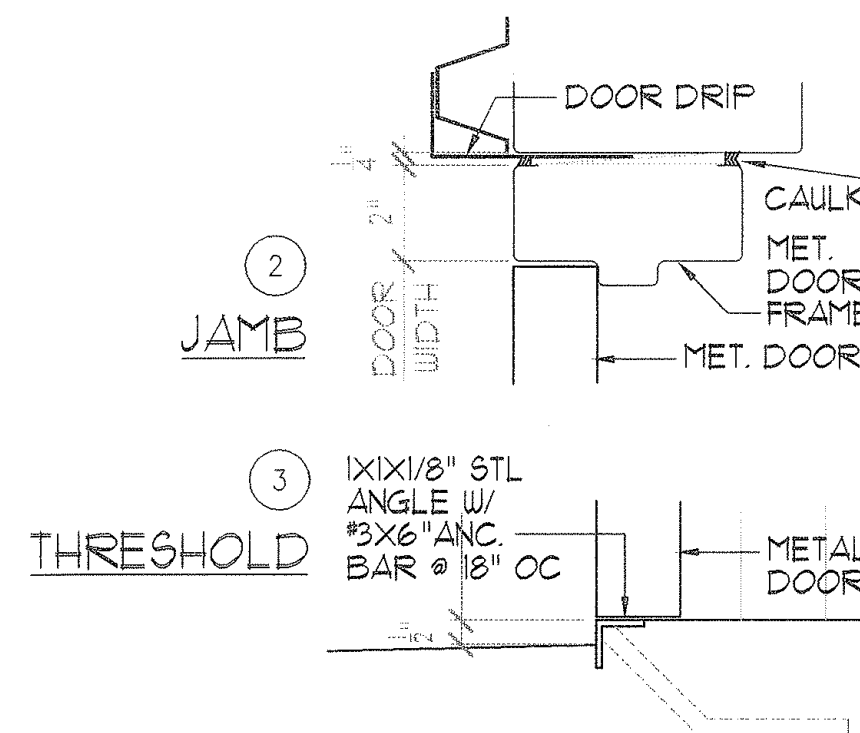


DOOR & WINDOW DETAILS

SCALE: 3" = 1'-0"


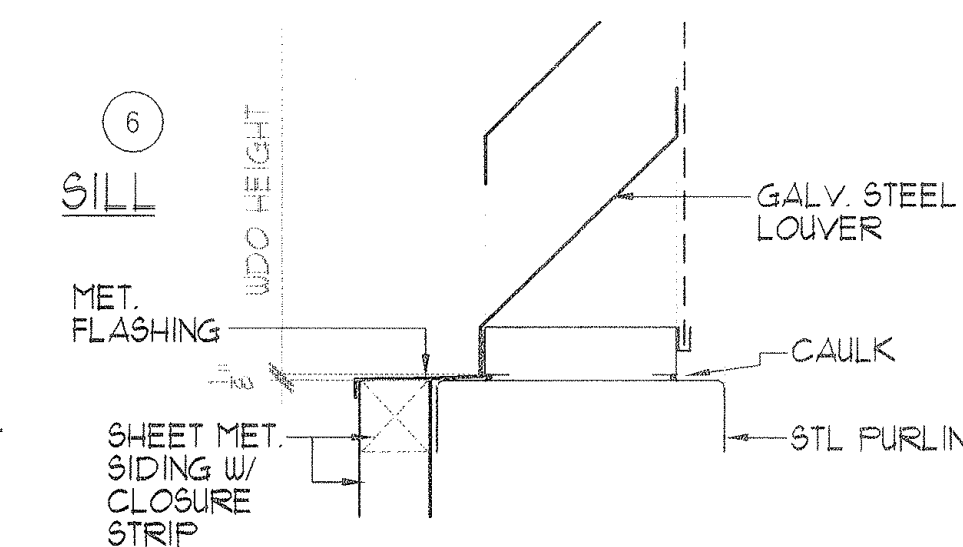


GRAPHIC SCALE:
6" 3" 0 1'
SCALE: 3" = 1'-0"

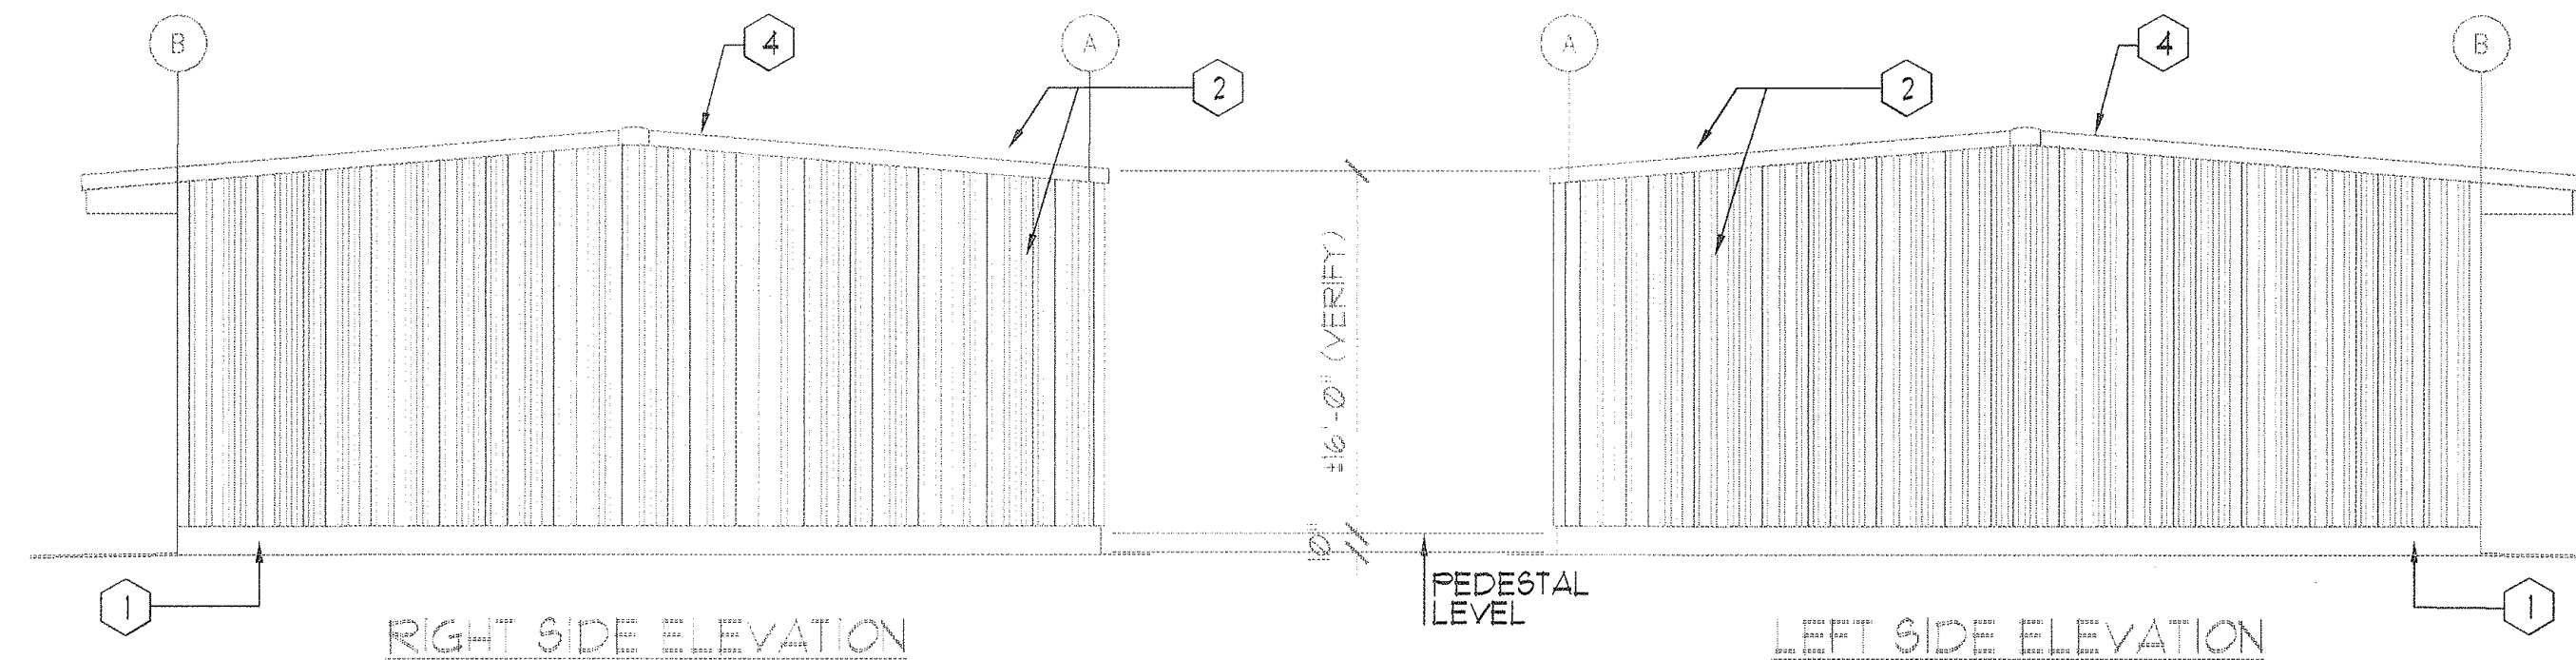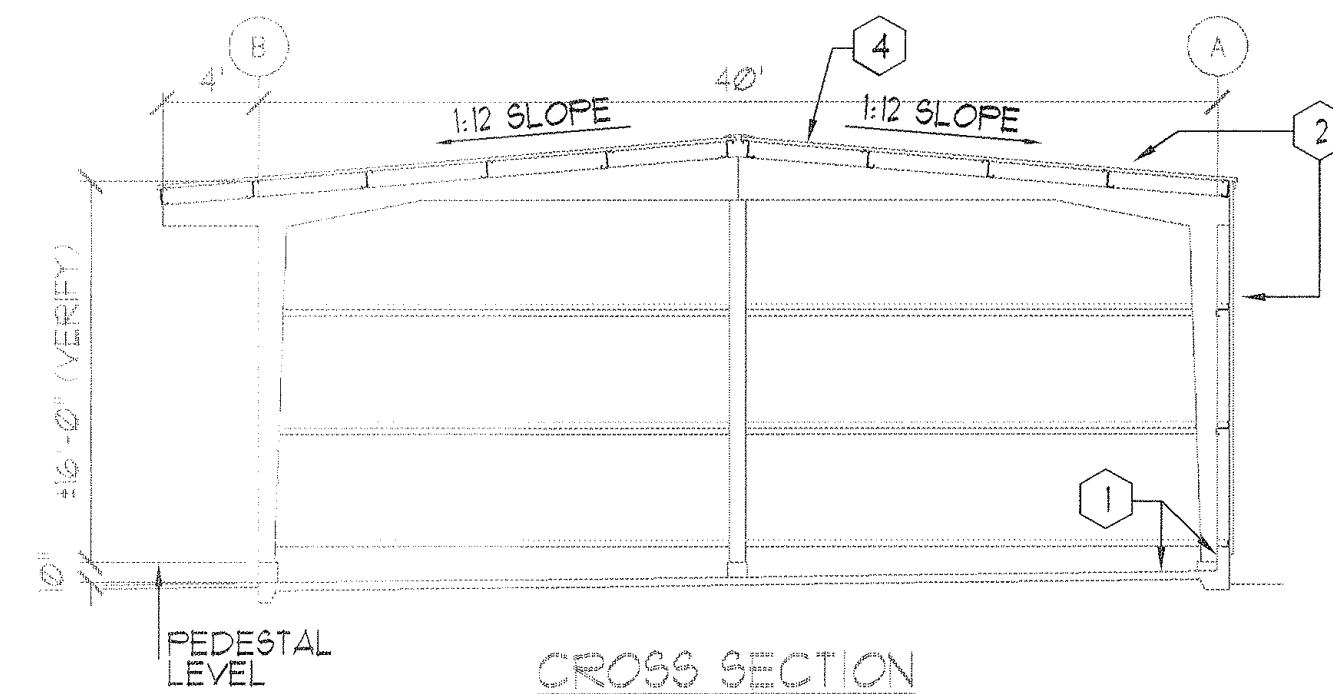

KEYNOTES


- 1 EXISTING CONC. SLAB & CURB
- 2 EXIST. METAL ROOFING & SIDING ON EXIST. STEEL STRUCT'L FRAMING SYSTEM (SEE 2/A-5 NOTE #1)
- 3 NOT USED
- 4 SEE SHEET A-5 FOR WORK REQUIRED ON ROOF.

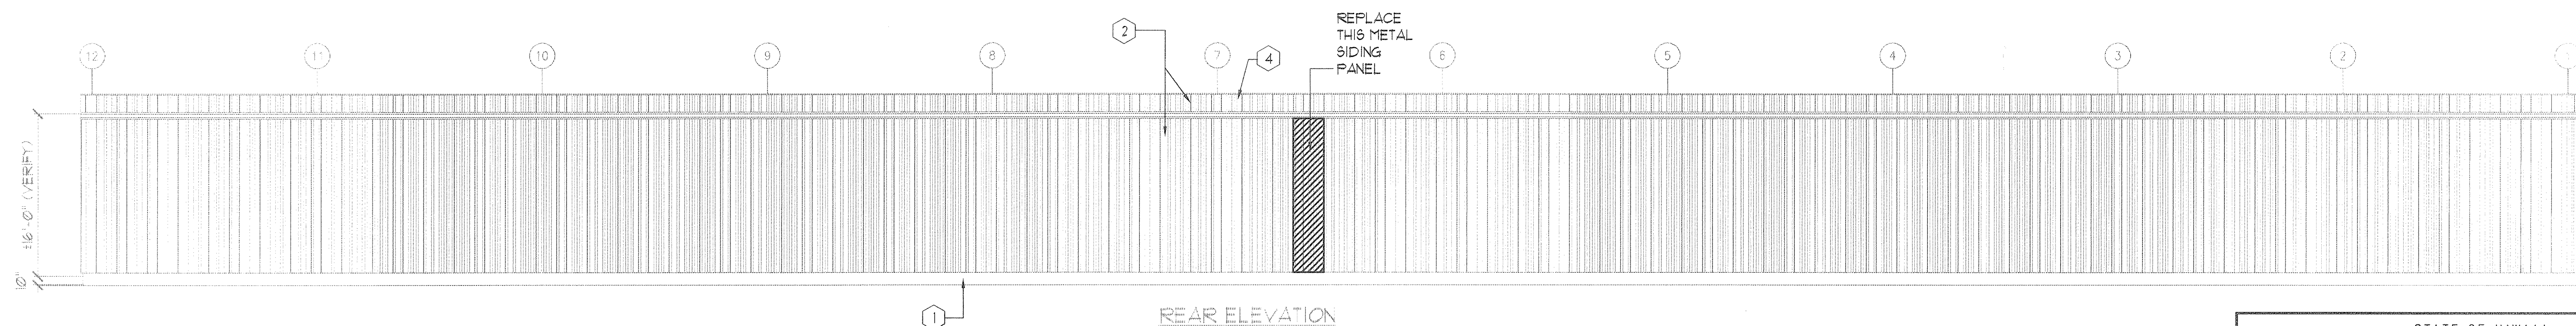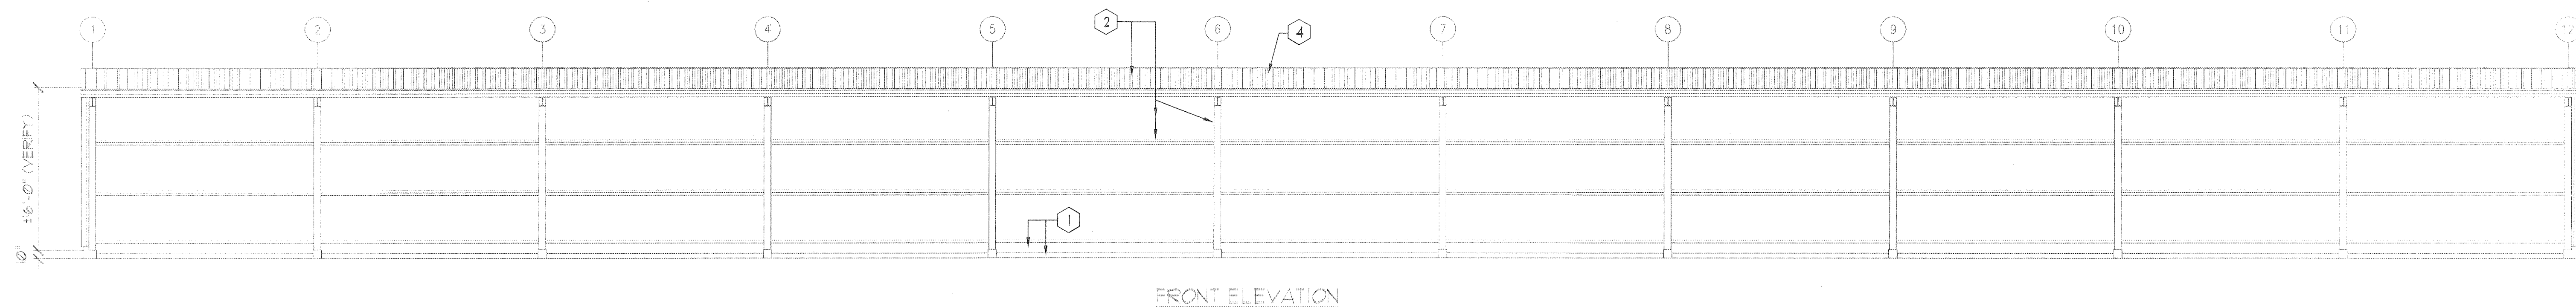

TRUCK SHED SECTION & ELEVATIONS

SCALE: 1/8" = 1'-0"

GRAPHIC SCALE:
8' 4' 0 4' 8' 16' 32'
SCALE: 1/8" = 1'-0"

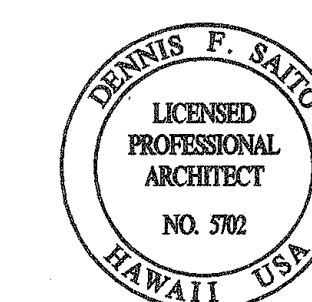

THIS WORK WAS PREPARED BY ME OR UNDER MY SUPERVISION.
Signature 4/10/06

STATE OF HAWAII
DEPARTMENT OF TRANSPORTATION
HIGHWAYS DIVISION
TRUCK SHED SECTION & ELEVATIONS
OIL STORAGE RM DOOR & WINDOW SCHED & DETAILS
MAUI DISTRICT BASEYARD
REPAIR AND MAINTENANCE OF
BUILDINGS AND GROUNDS, PHASE 3
PROJECT NO. HWY-M-08-04M
SCALE: AS NOTED
DATE: MAY 2005
SHEET No. A-6 OF 9 SHEETS