


FED. ROAD DIST. NO.	STATE	PROJ. NO.	FISCAL YEAR	SHEET NO.	TOTAL SHEETS
HAWAII	HAW.	HWY-M-04-14M	2014	9	11

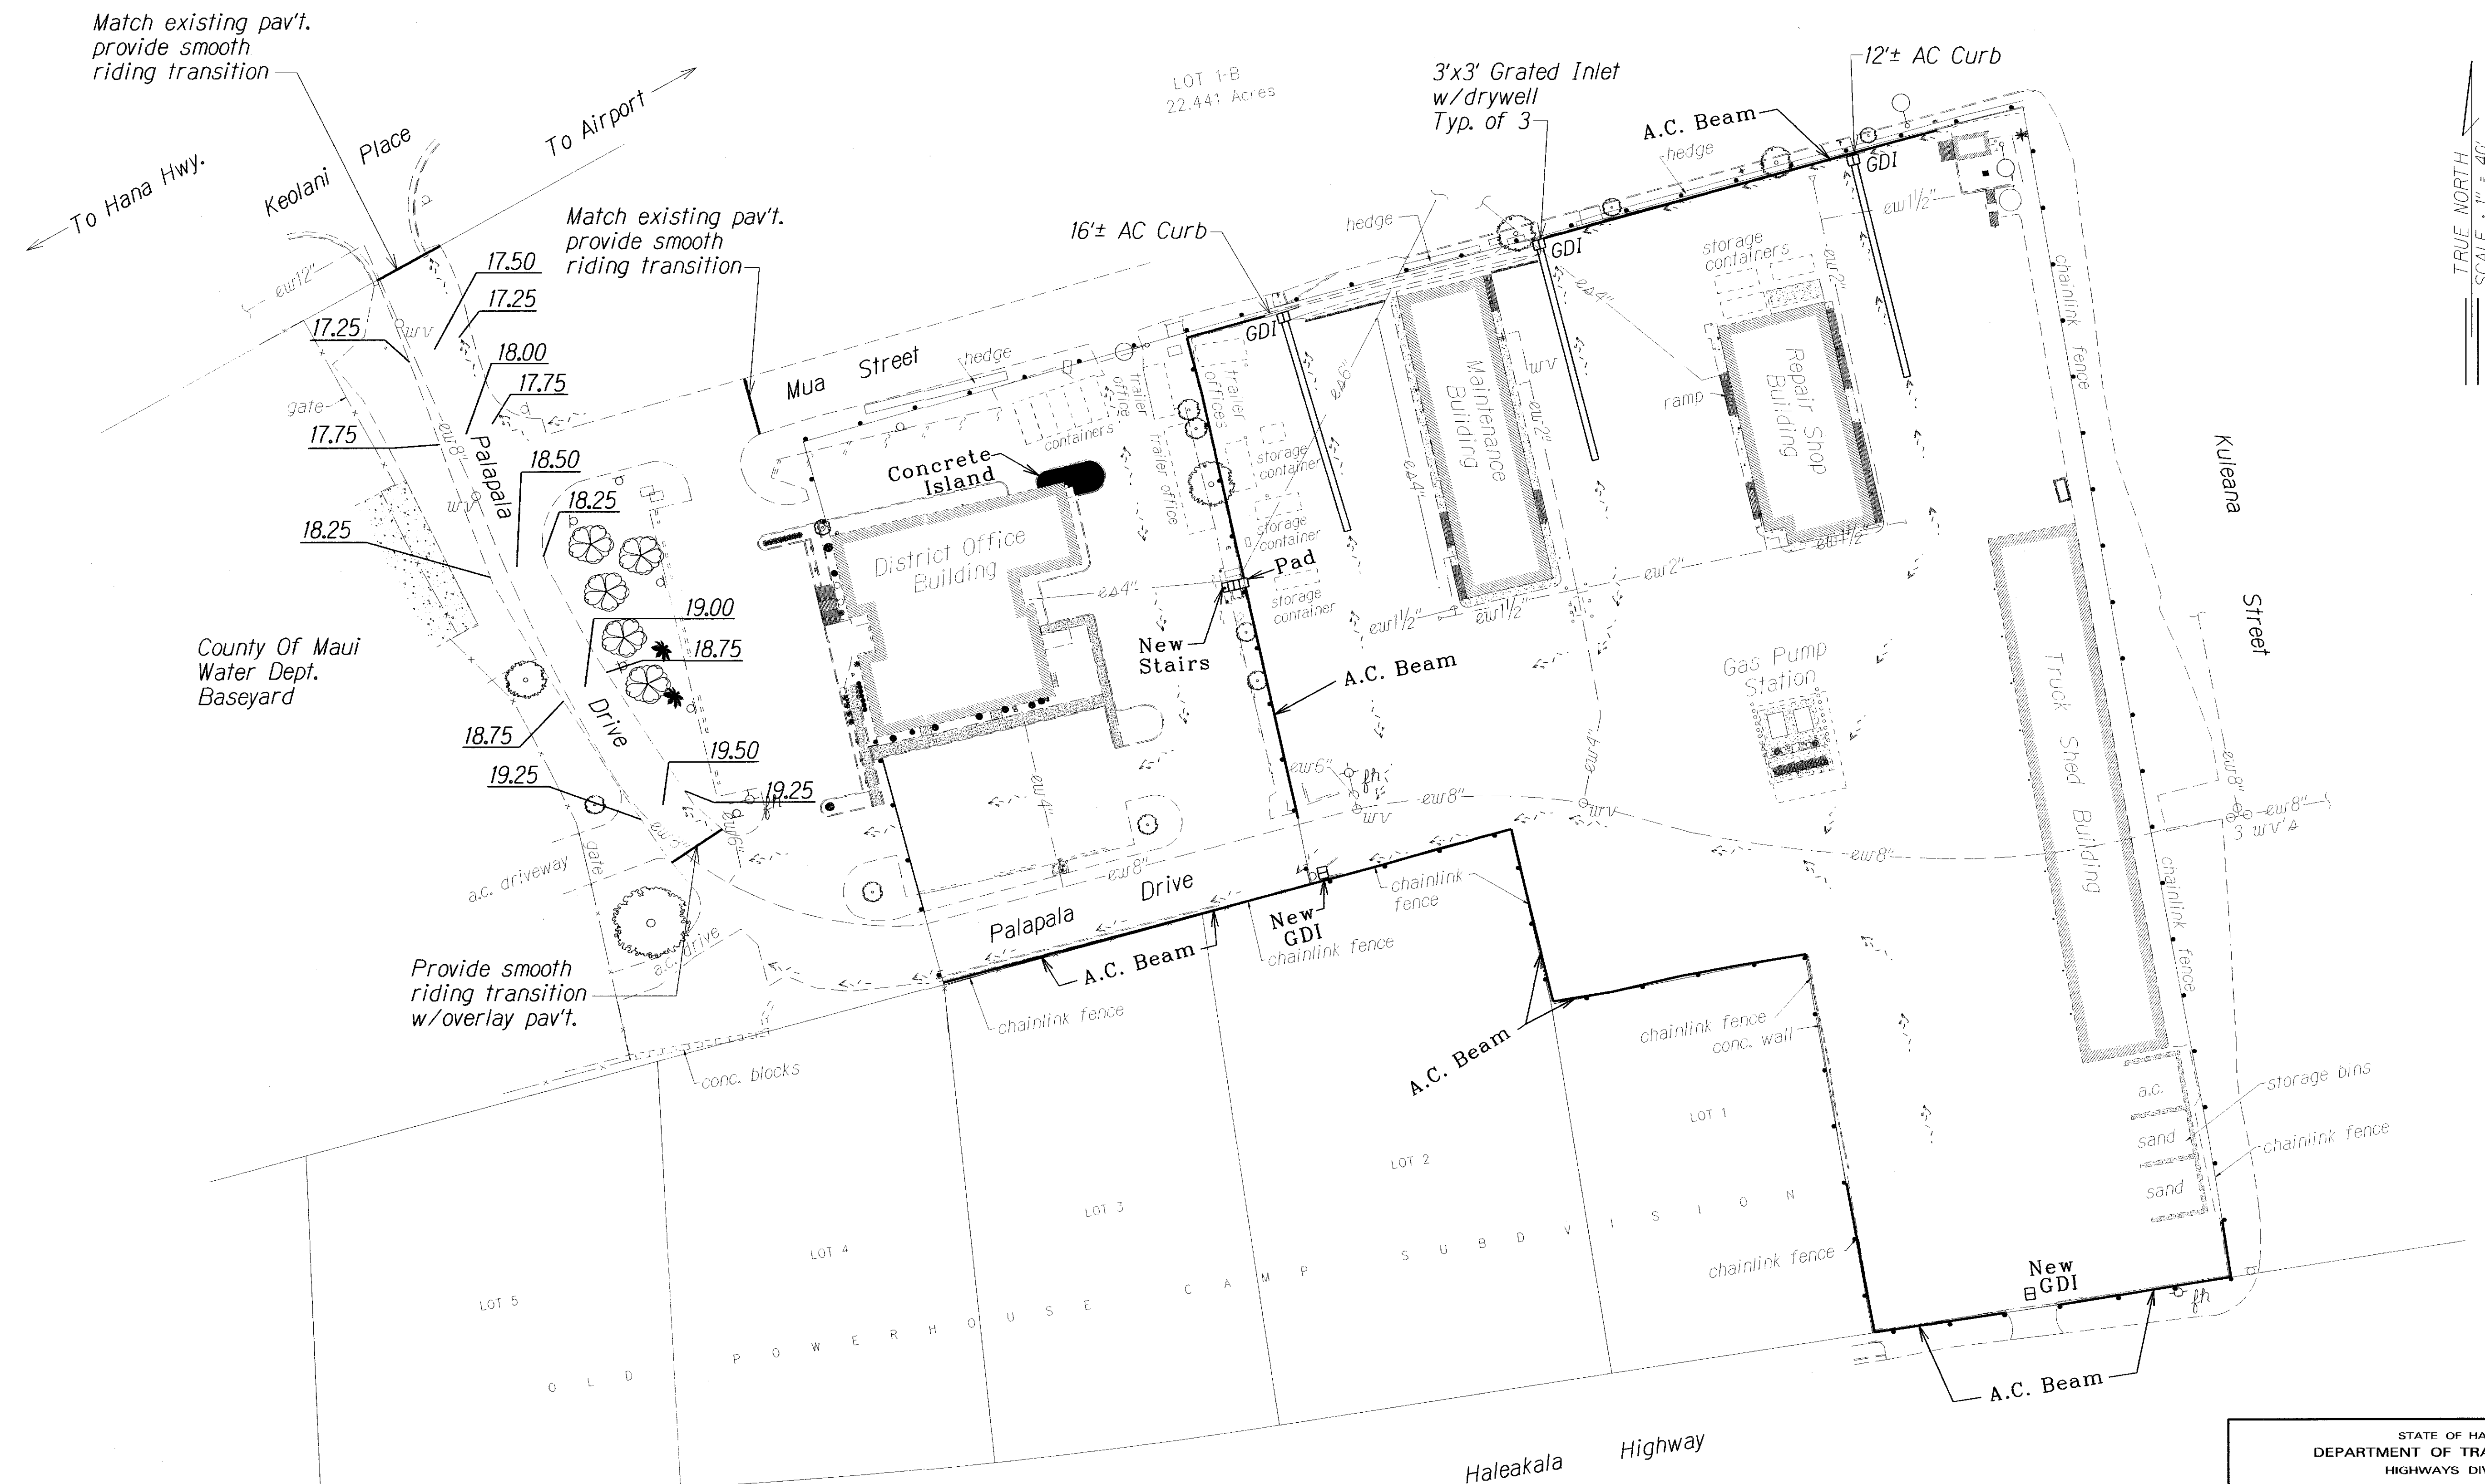

ORIGINAL PLAN	DATE
DESIGNED BY	
DRAWN BY	
CHECKED BY	
NOTED BY	
QUANTITIES BY	
CHECKED BY	

LEGEND FOR AS-BUILT POSTINGS	
	Squiggly line for as-built deletion
	Double line for as-built deletion
Roadway	Text for as-built posting

STATE OF HAWAII DEPARTMENT OF TRANSPORTATION HIGHWAYS DIVISION	
<b>GRADING &amp; DRAINAGE PLAN</b>	
MAUI DISTRICT BASEYARD	
Repair and Maintenance of Buildings and Grounds	
Project No. HWY-M-04-14M	
Scale: As Shown	Date: May, 2014
SHEET No. 1 OF 1 SHEETS	

"AS-BUILT"