

STATE OF HAWAII

DEPARTMENT OF TRANSPORTATION

HIGHWAYS DIVISION HONOLULU, HAWAII


"AS-BUILT"


PLANS FOR

MAUI DISTRICT BASEYARD

REPAIR AND MAINTENANCE OF BUILDINGS AND GROUNDS
PROJECT NO. HWY-M-04-14M

DISTRICT OF WAILUKU
ISLAND OF MAUI

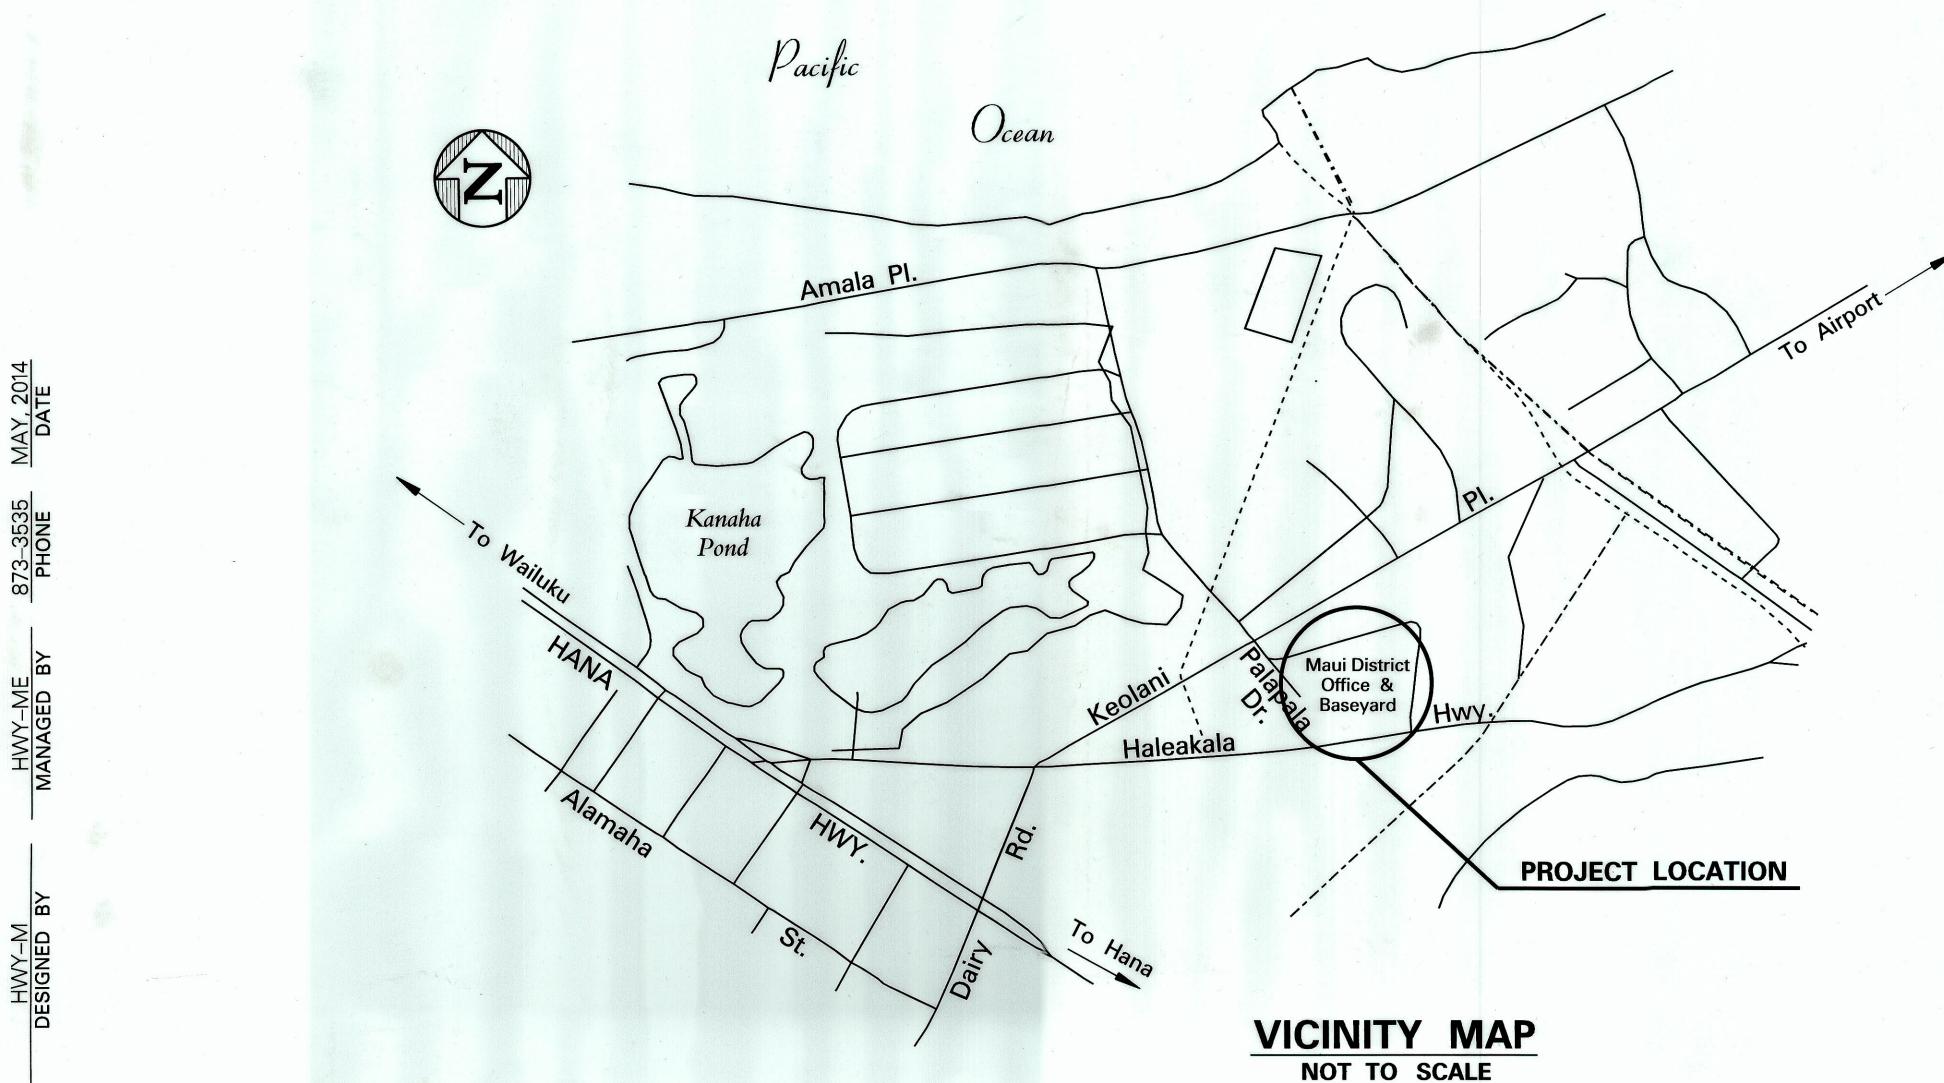

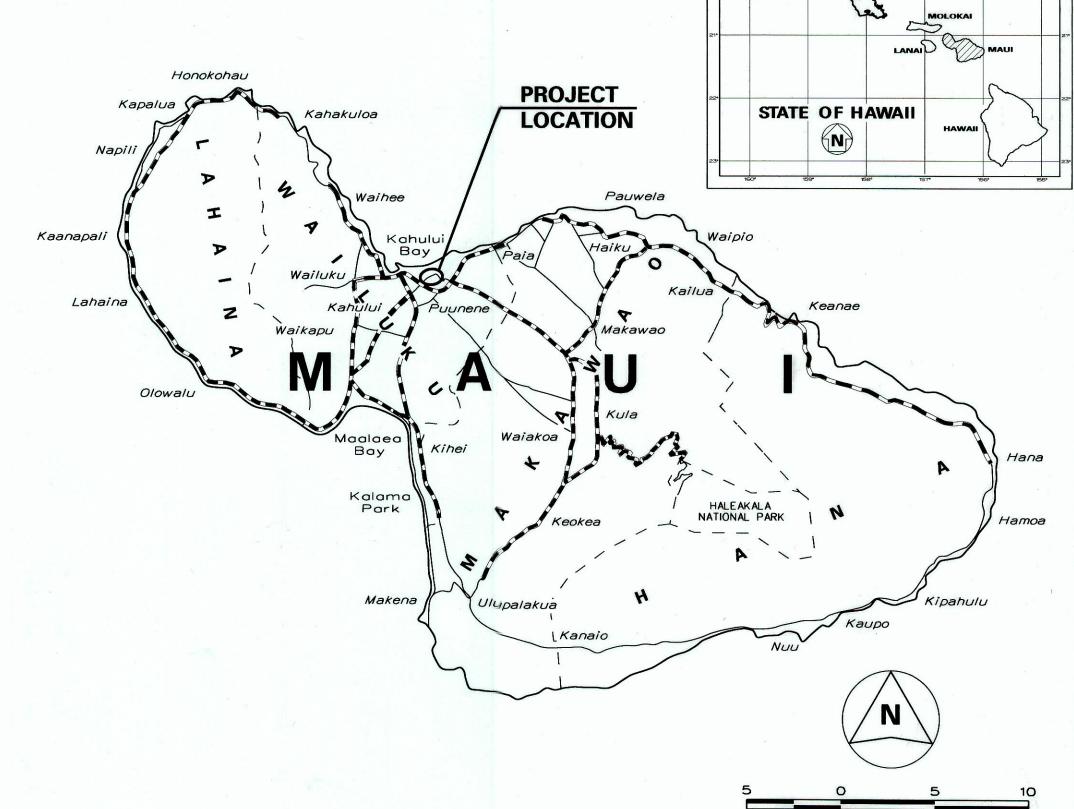

FED. ROAD DIST. NO. FISCAL SHEET YEAR NO.

HAW. HWY-M-04-14M 2014

FEDERAL AID PROJECTS PREVIOUSLY CONSTRUCTED OR UNDER CONSTRUCTION

Mm July 5/25/17

DEPARTMENT OF TRANSPORTATION
STATE OF HAWAII
APPROVED:

for DIR. OF TRANSPORTATION

5/13/14 DATE