




FED. ROAD DIST. NO.	STATE	PROJ. NO.	FISCAL YEAR	SHEET NO.	TOTAL SHEETS
HAWAII	HAW.	HWY-M-04-14M	2014	6	11

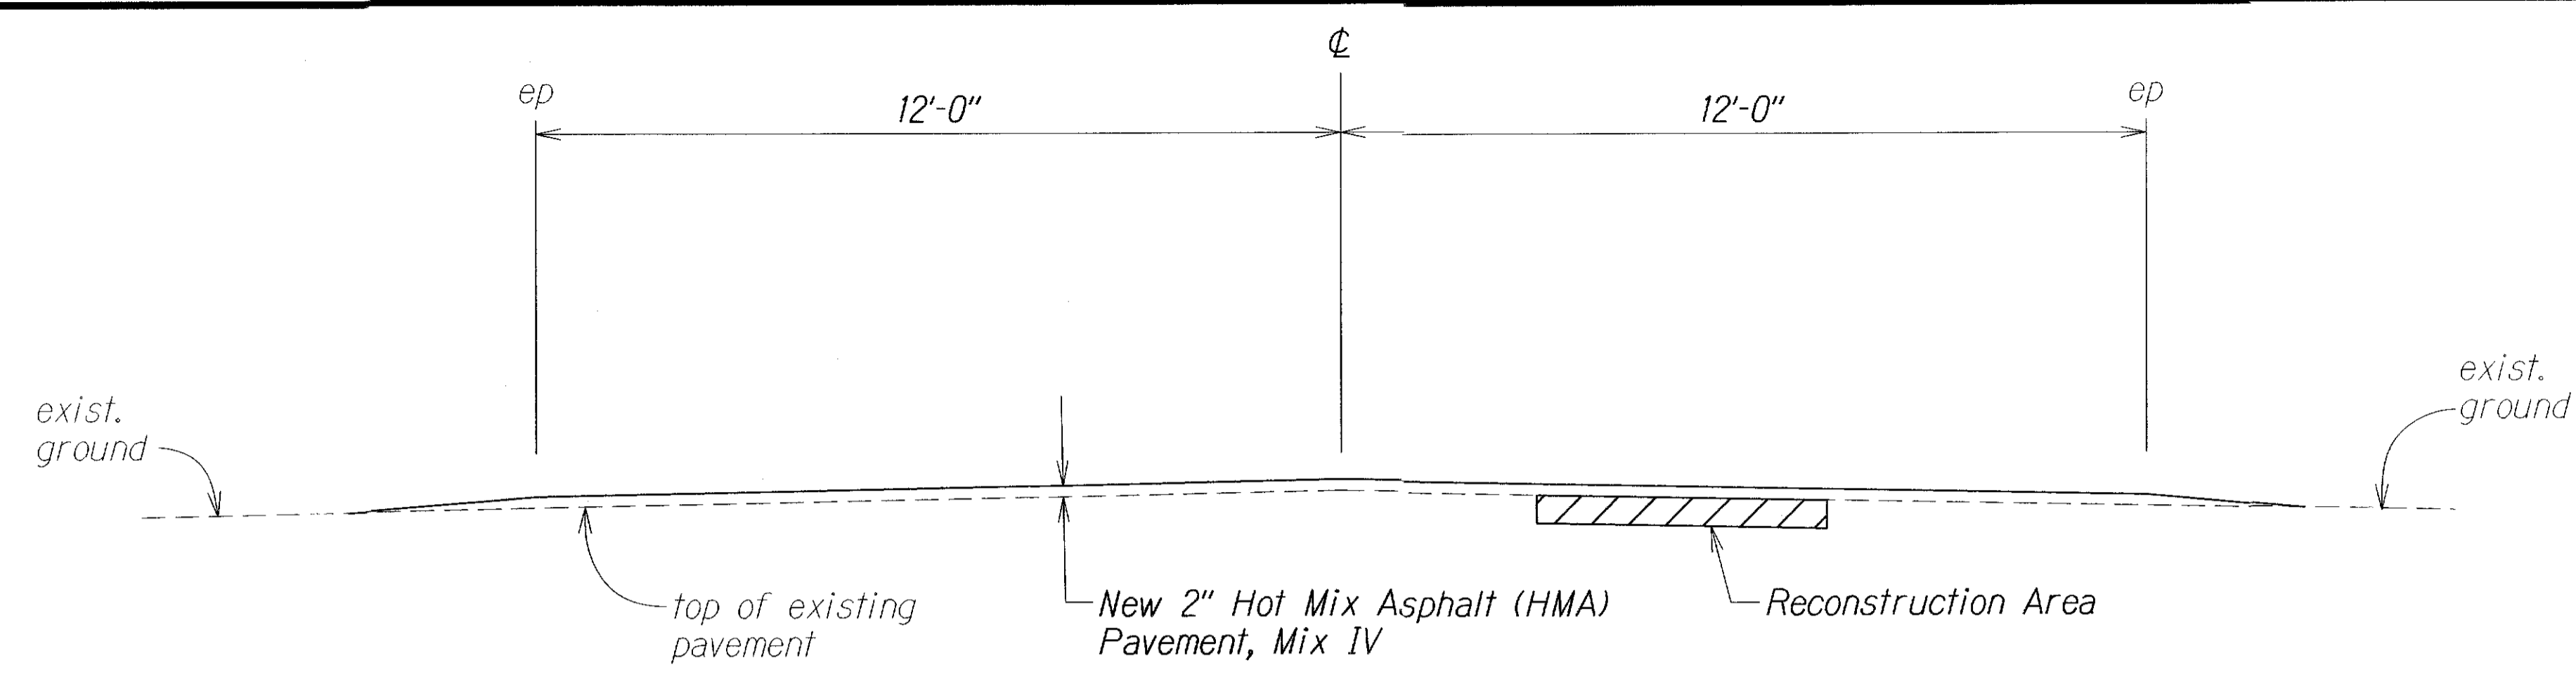


TYPICAL TANGENT SECTION  
Scale: 1/2" = 1'-0"

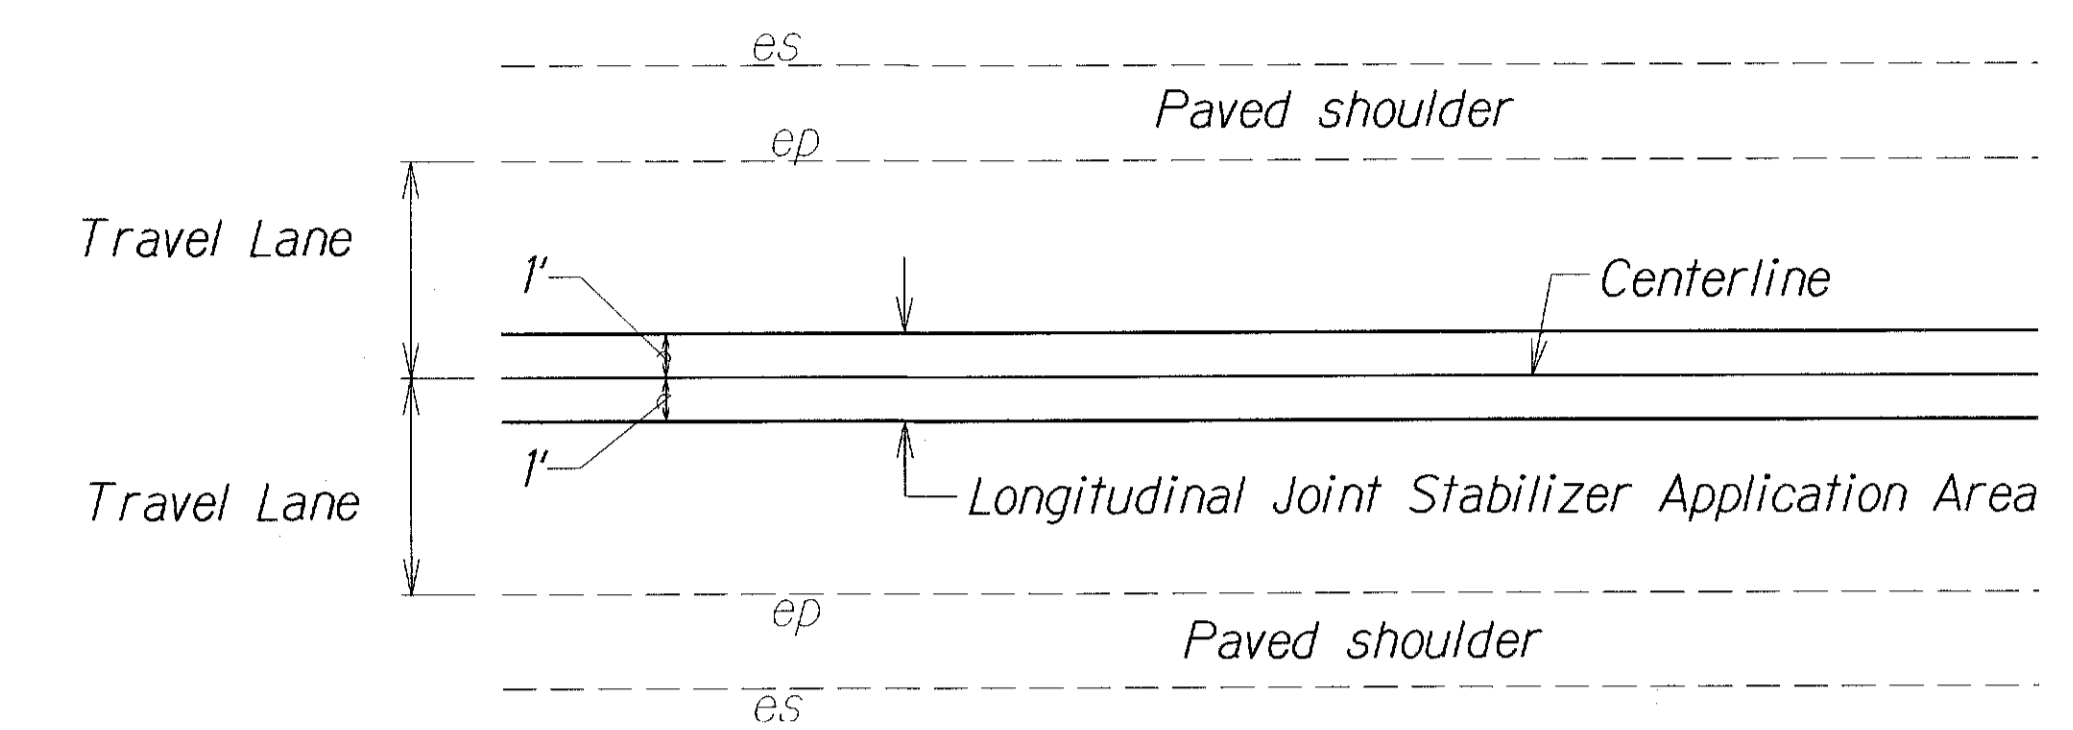


TYPICAL SECTION FOR LONGITUDINAL JOINT STABILIZER  
Not To Scale

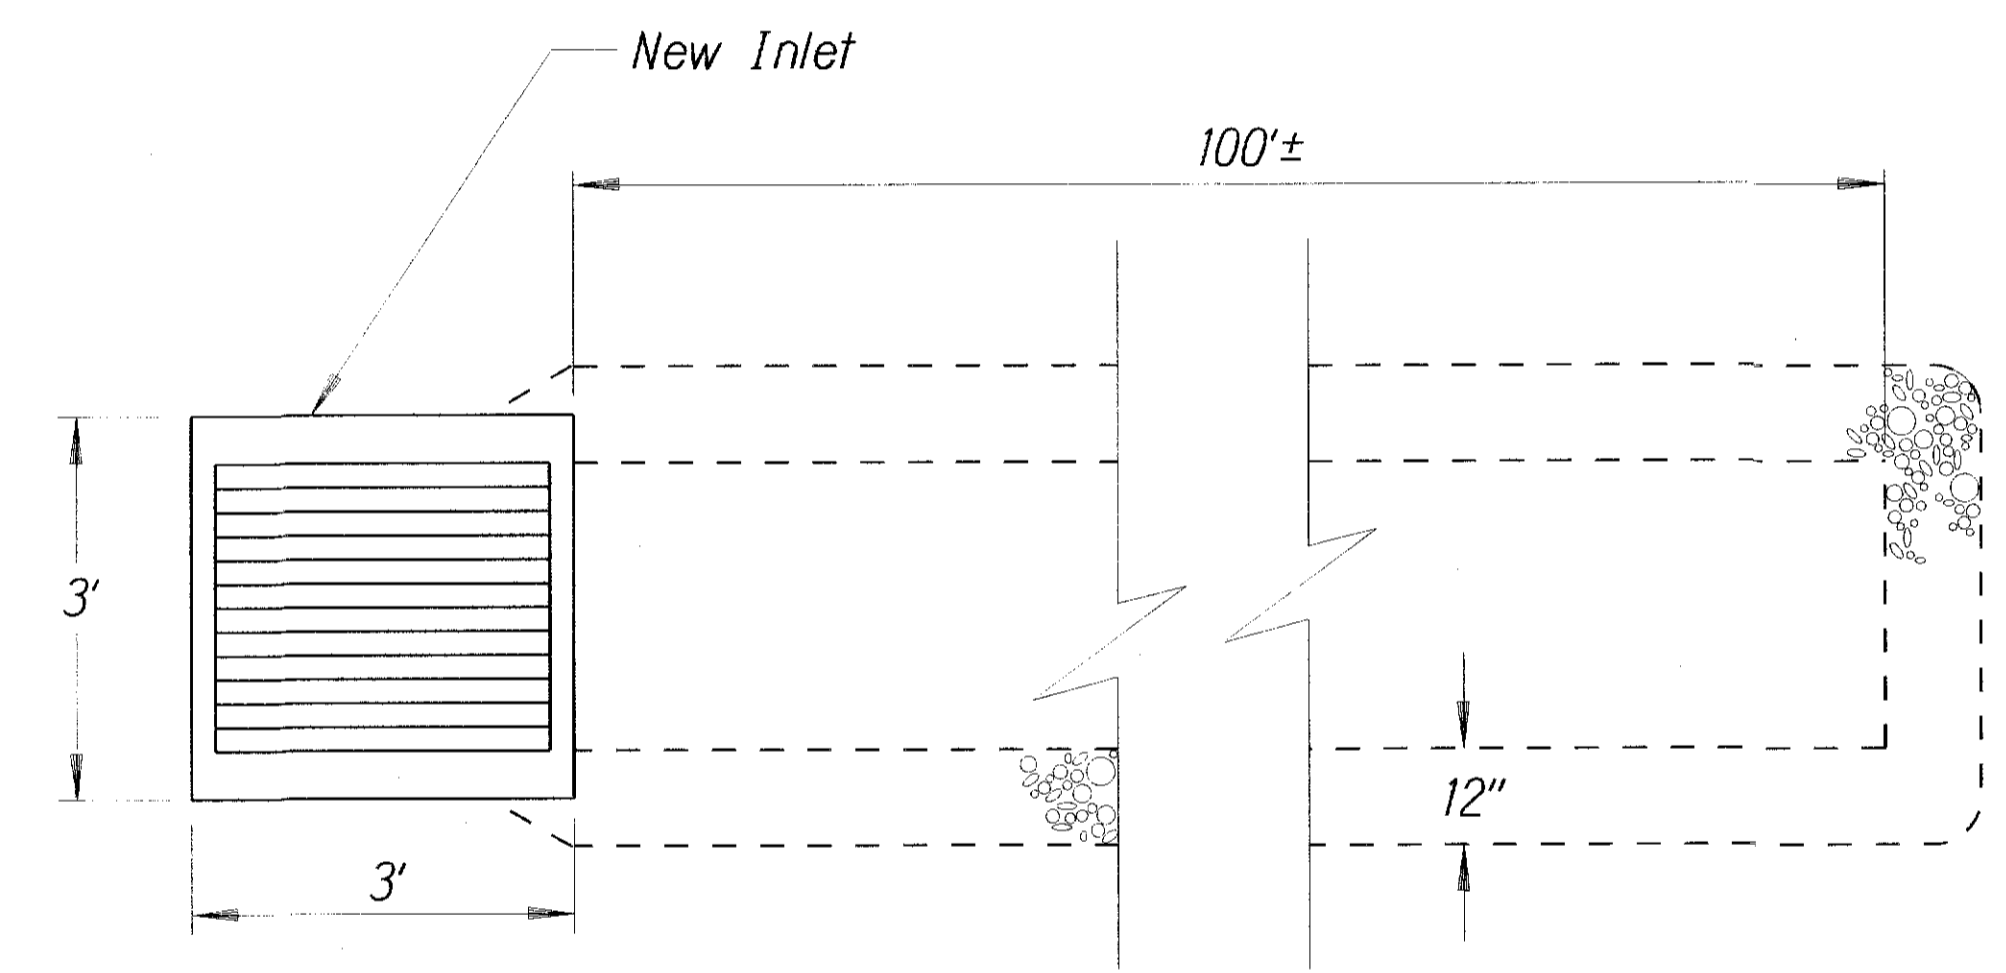

PLAN

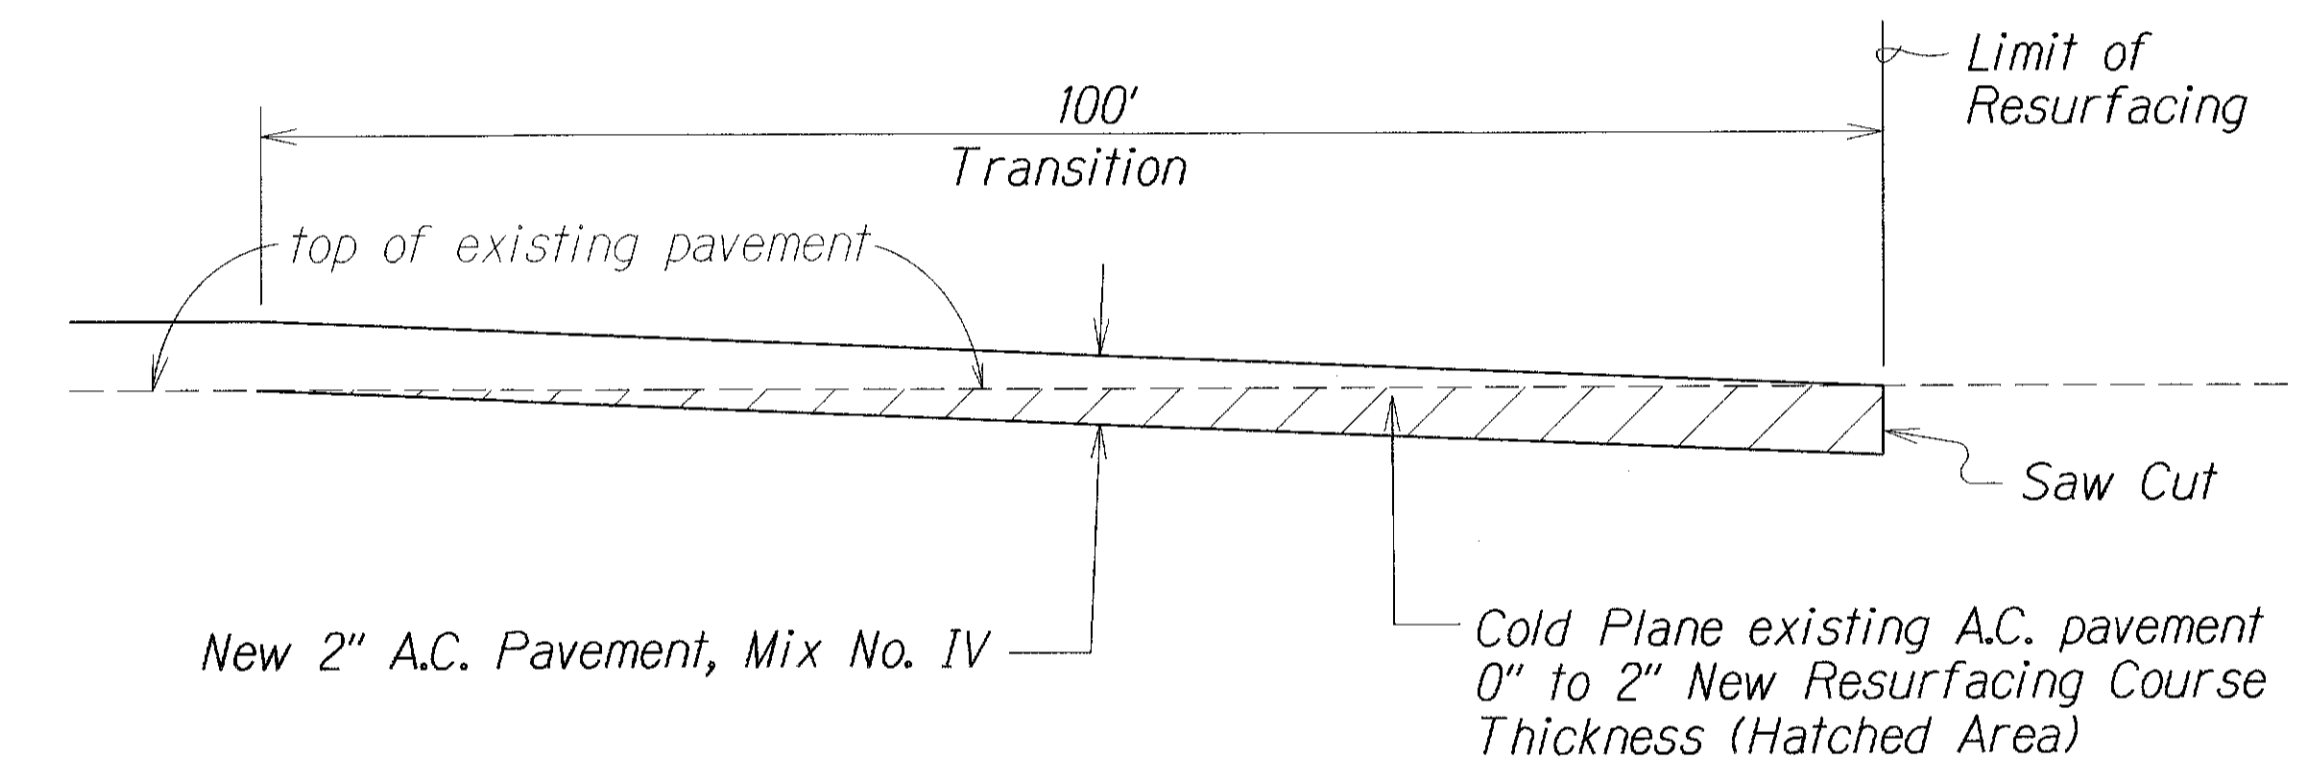


COLD PLANED TRANSITION TO EXISTING A.C. PAVEMENT  
Not To Scale

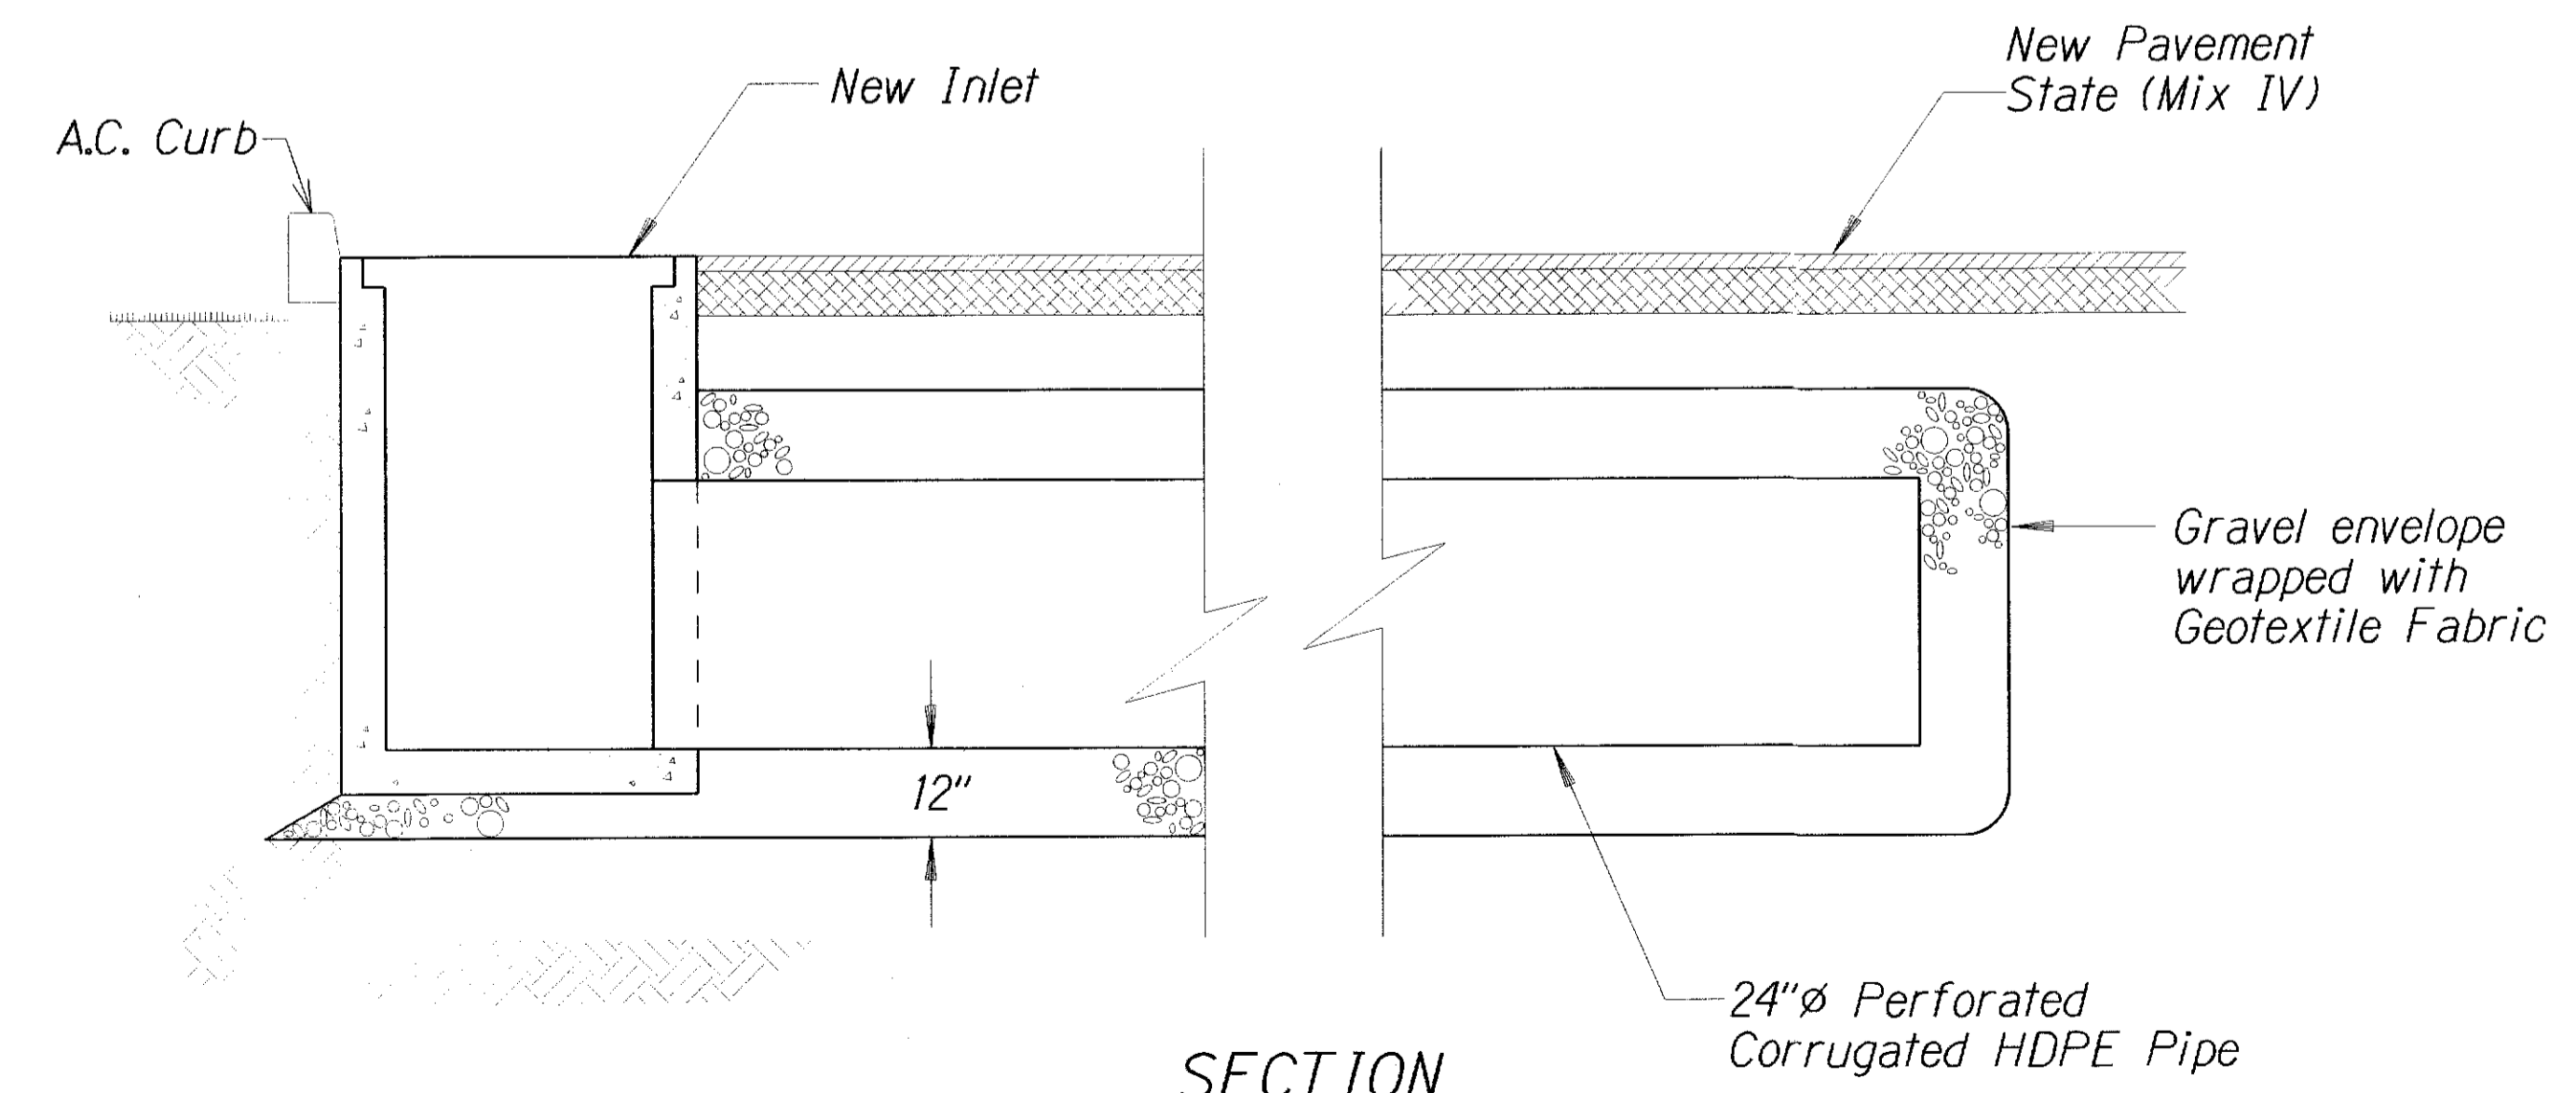

SECTION

3'X3' DRYWELL DETAIL  
Not To Scale

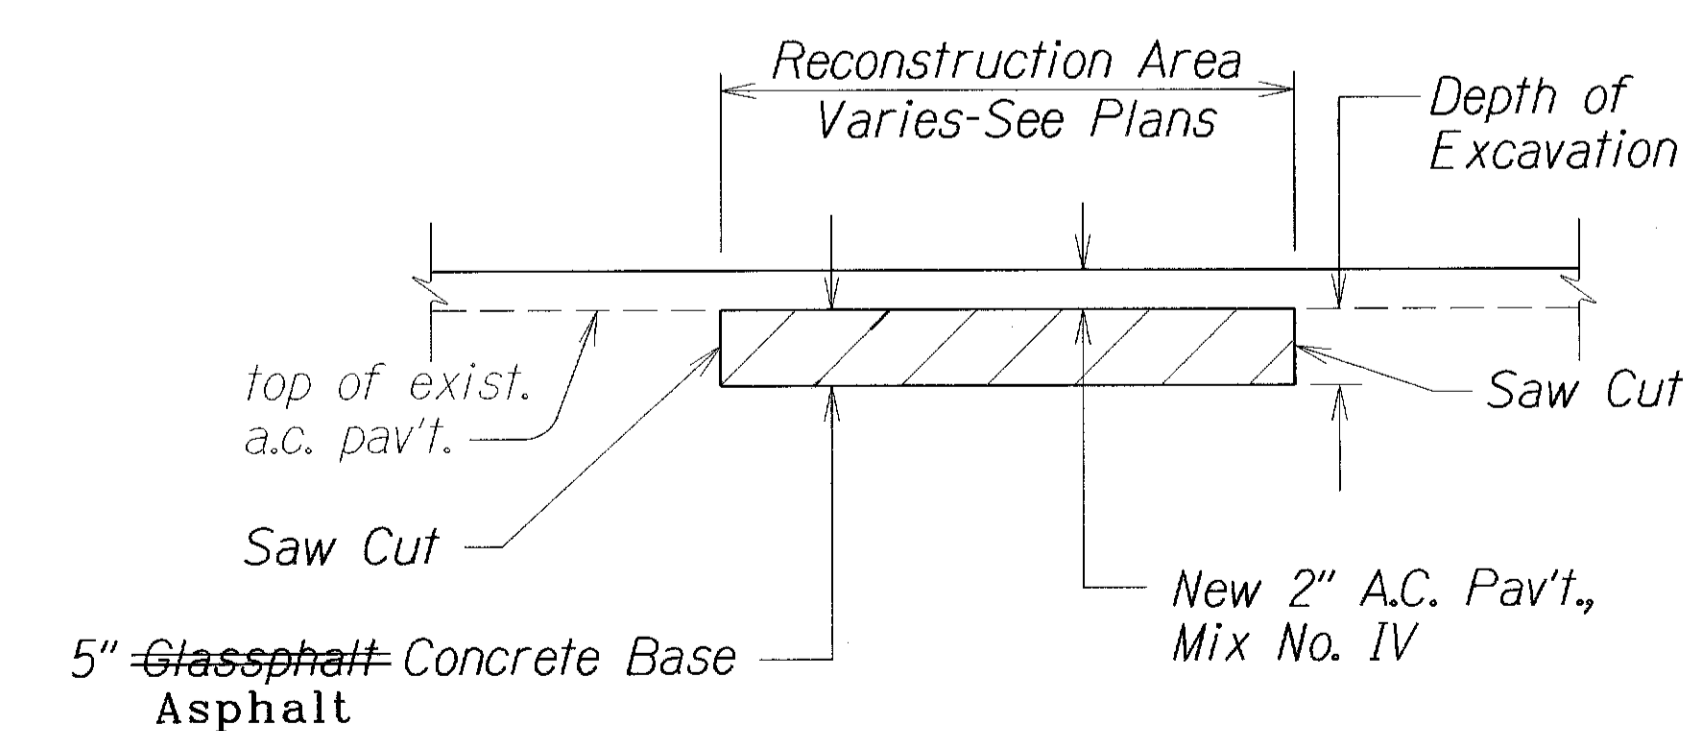

A.C. PAVEMENT RECONSTRUCTION DETAIL  
Not To Scale

LEGEND FOR AS-BUILT POSTINGS	
	Squiggly line for as-built deletion
	Double line for as-built deletion
	Text for as-built posting


STATE OF HAWAII  
DEPARTMENT OF TRANSPORTATION  
HIGHWAYS DIVISION

TYPICAL SECTIONS & DETAILS  
MAUI DISTRICT BASEYARD  
Repair and Maintenance of Buildings and Grounds  
Project No. HWY-M-04-14M  
Scale: As Shown  
Date: May, 2014


SHEET No. 1 OF 2 SHEETS

ORIGINAL PLAN	DATE
SURVEY PLOTTED BY	
DESIGNED BY	
NOTED BY	
CHECKED BY	


FED. ROAD DIST. NO.	STATE	PROJ. NO.	FISCAL YEAR	SHEET NO.	TOTAL SHEETS
HAWAII	HAW.	HWY-M-04-14M	2014	7	11

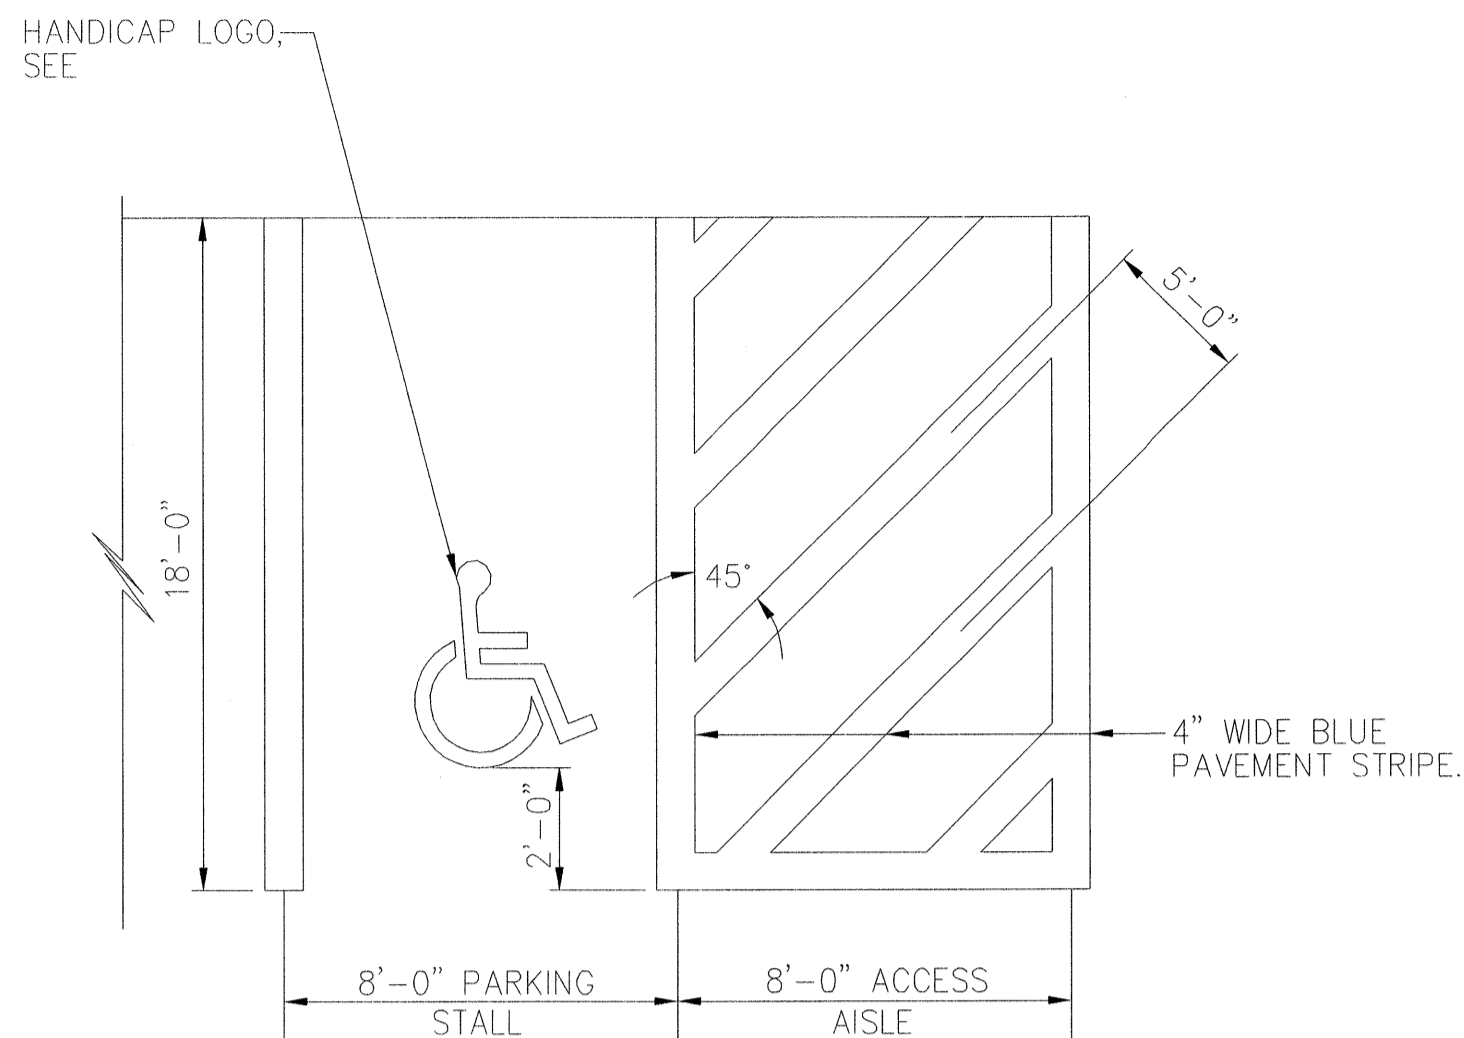


**ACCESSIBLE PARKING STALL MARKING DETAIL**  
*Not To Scale*

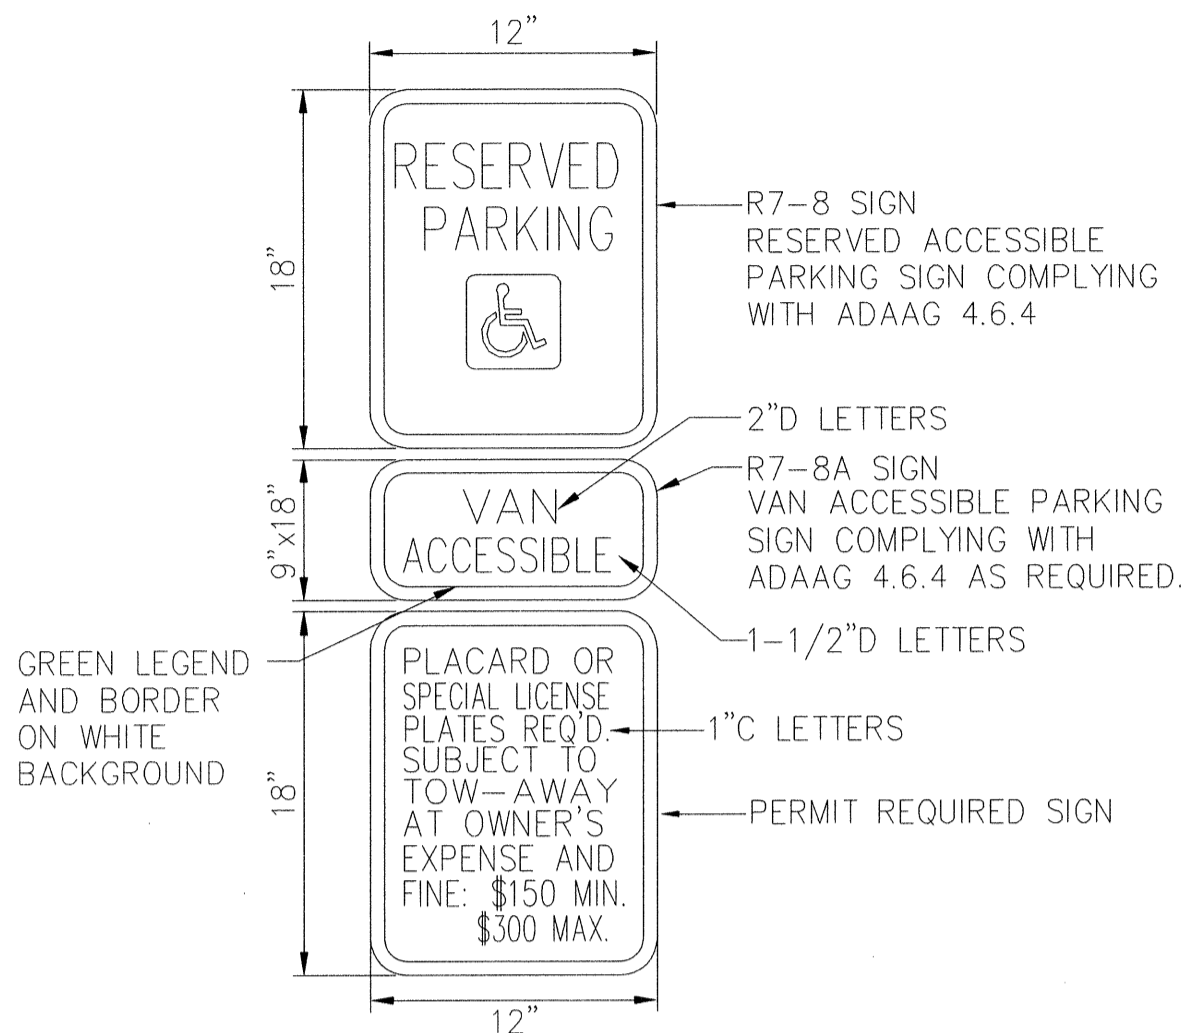

**TYPICAL ACCESSIBLE SIGN POST DETAIL**  
*Not To Scale*

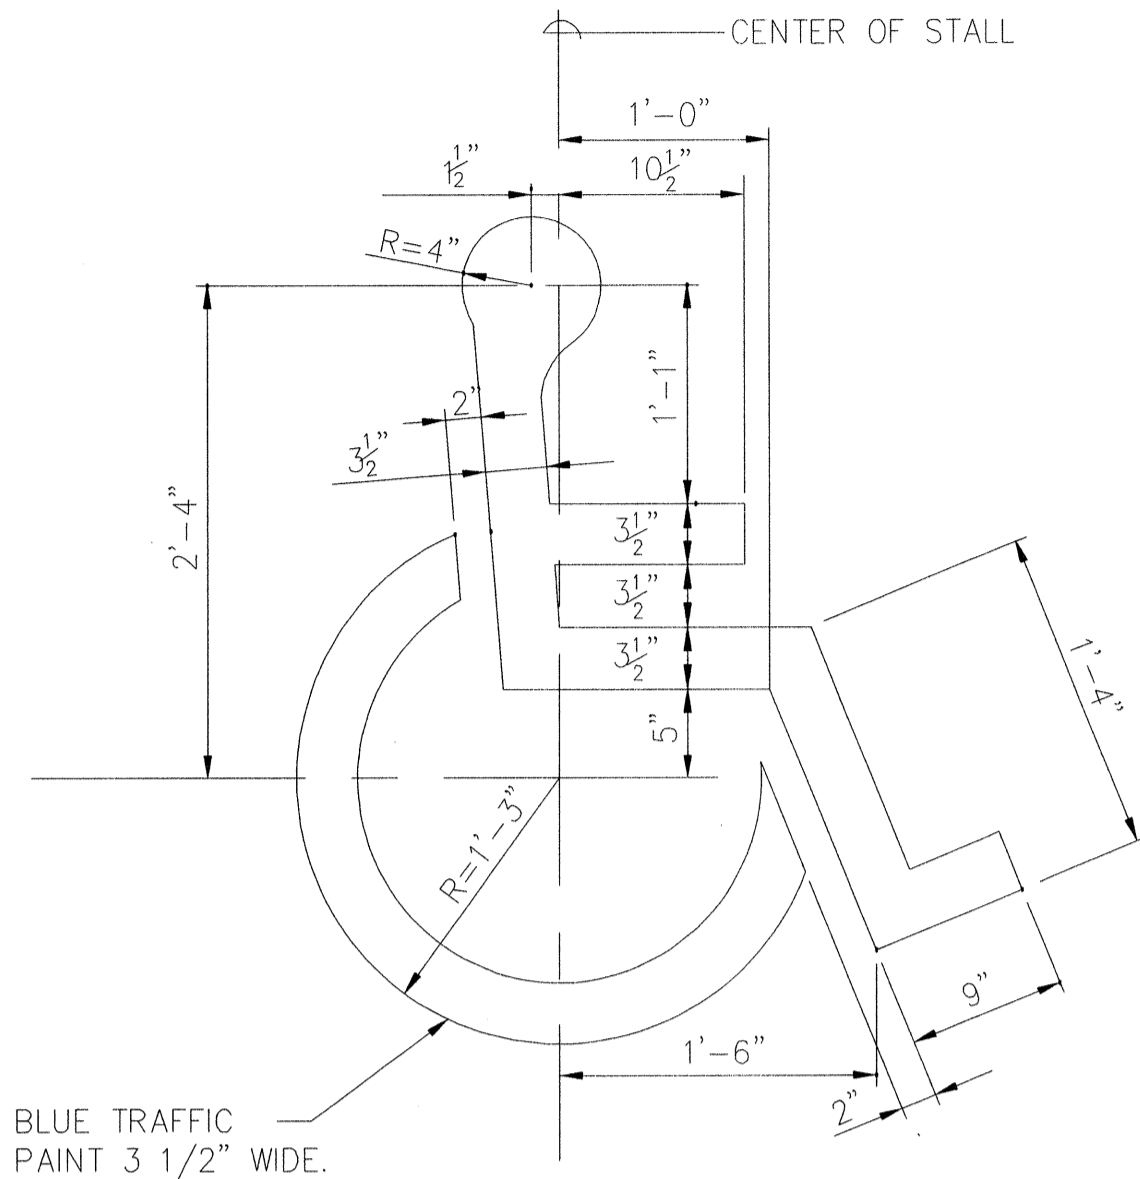


**ACCESSIBLE LOGO DETAIL**  
*Not To Scale*

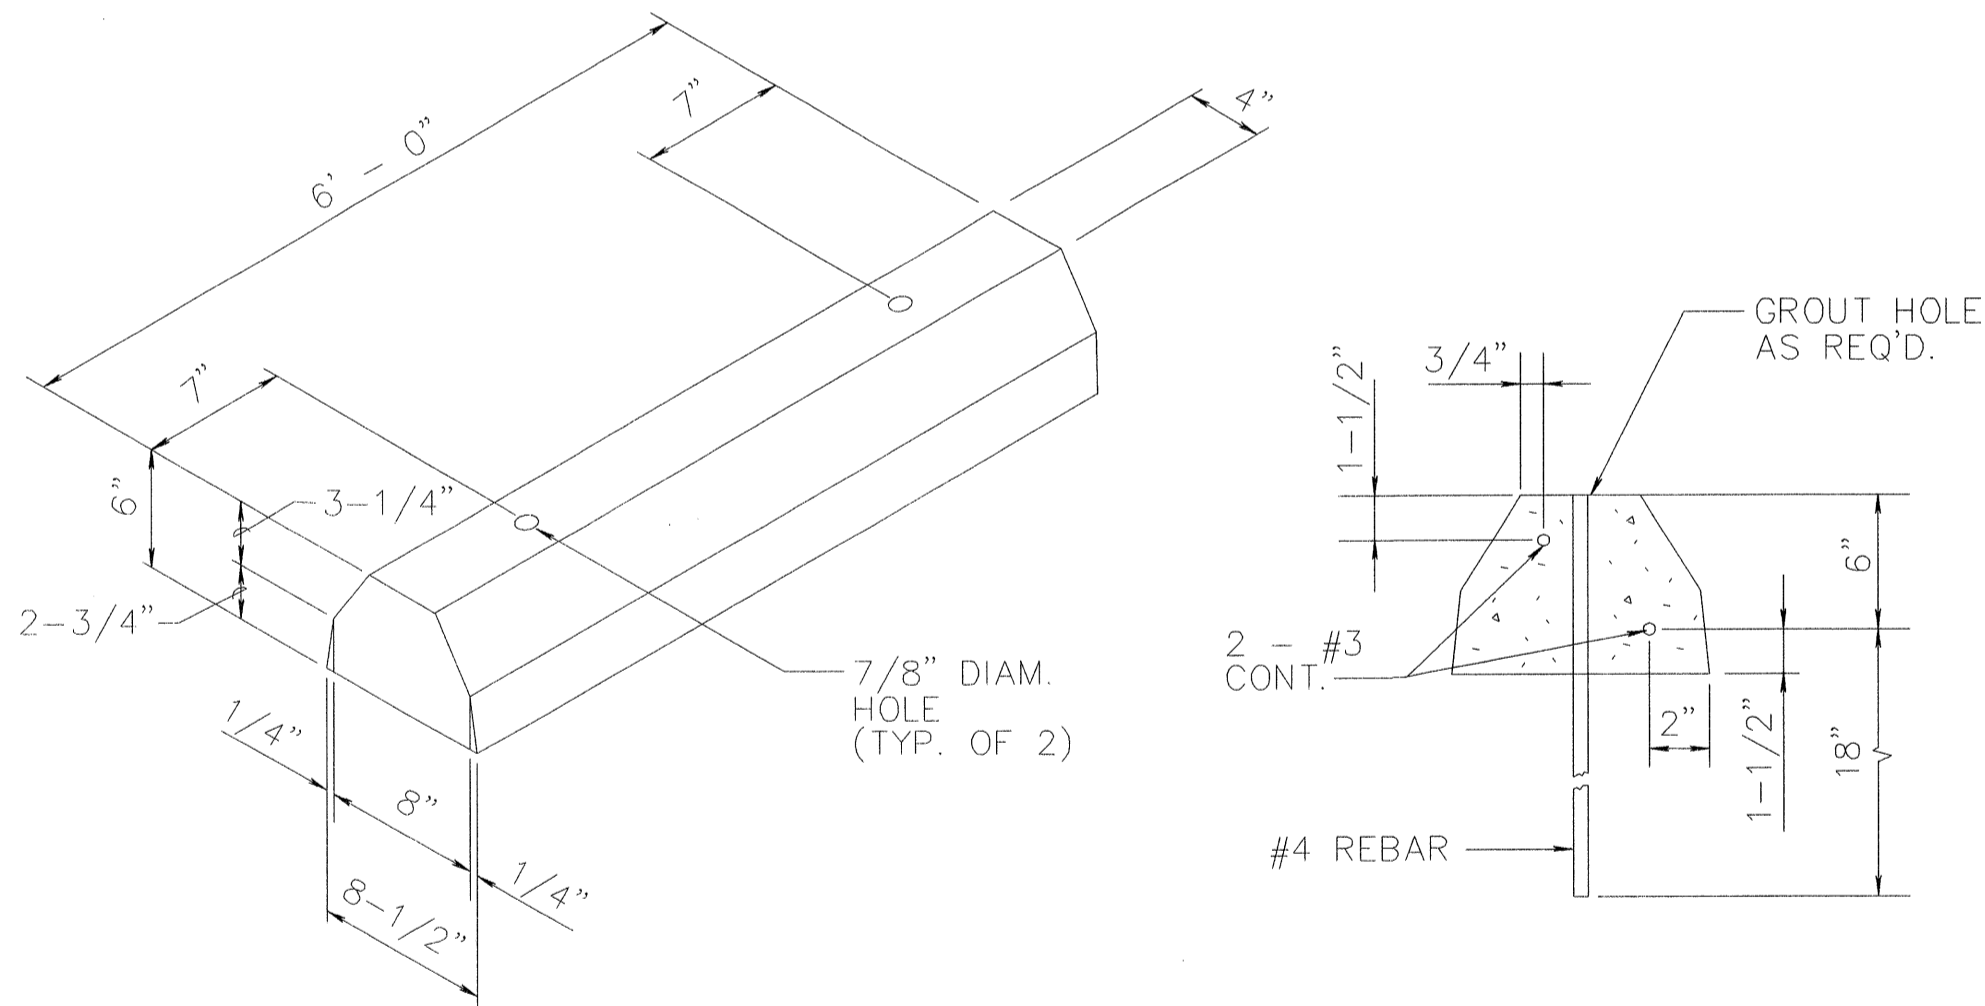

**ISOMETRIC**

**TYPICAL SECTION**


**CONCRETE WHEELSTOP DETAIL**  
*Not To Scale*

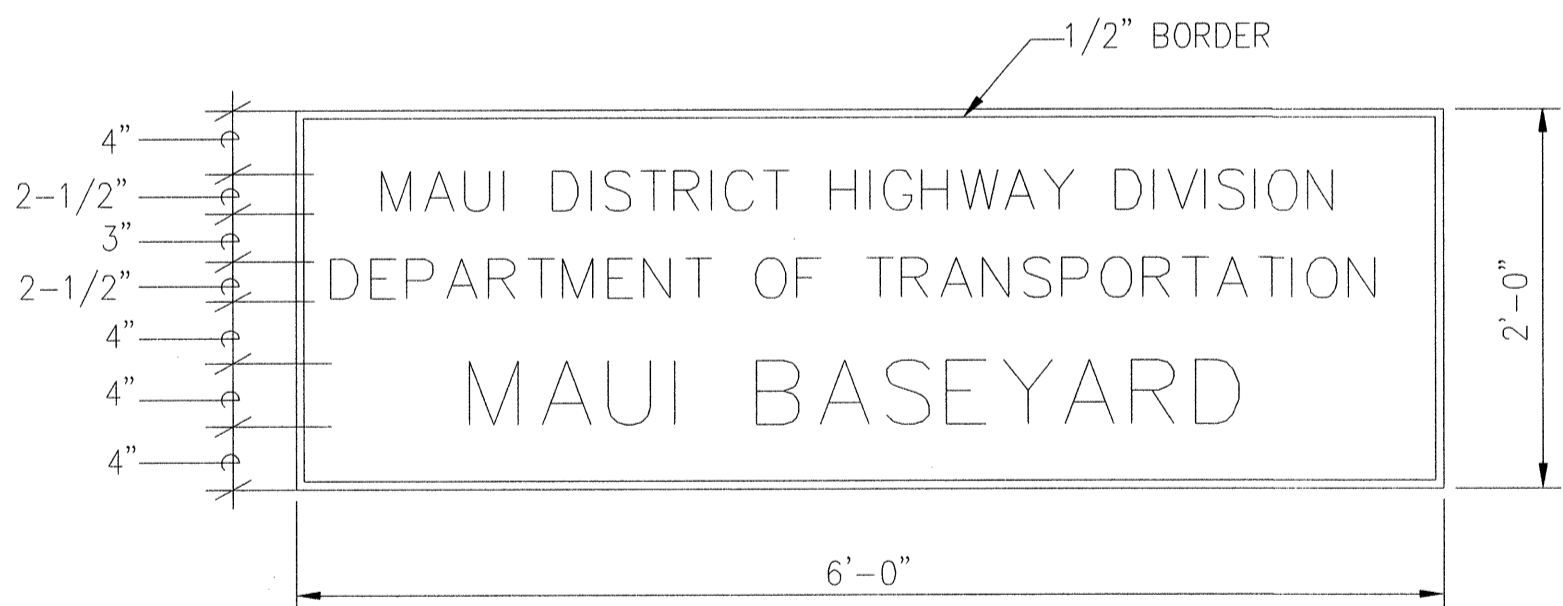

**METAL SIGN**

NOTE:  
 THE LETTER STYLE FOR THE FACILITY SIGN SHALL BE FUTURA DEMI BOLD.

**FACILITY SIGN**  
*Not To Scale*

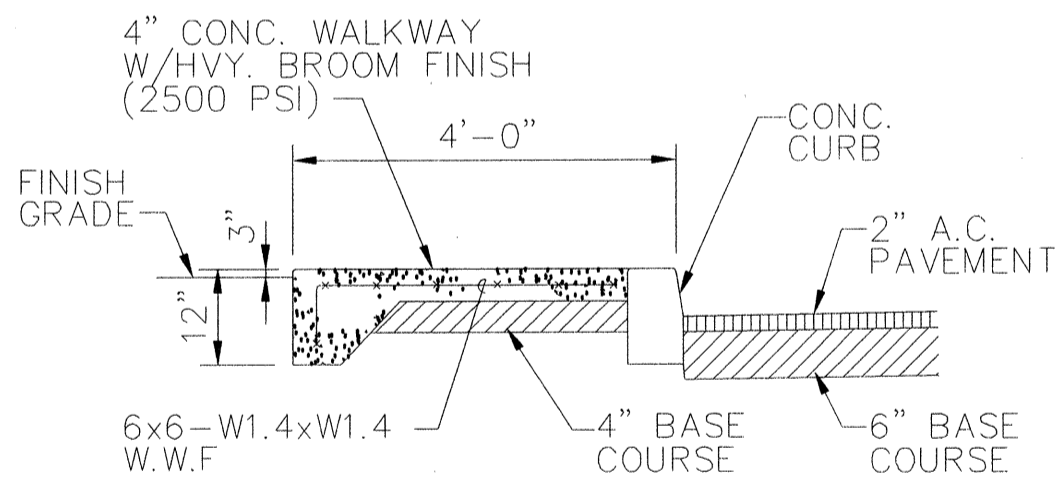

**CONCRETE WALKWAY/LANDING DETAIL**  
*Not To Scale*

SURVEY PLOTTED BY	DATE
DRAWN BY	
DESIGNED BY	
QUANTITIES BY	
CHECKED BY	
ORIGINAL PLAN	
NOTE BOOK	
NO.	

STATE OF HAWAII  
DEPARTMENT OF TRANSPORTATION  
HIGHWAYS DIVISION

**MISCELLANEOUS DETAILS**  
**MAUI DISTRICT BASEYARD**  
*Repair and Maintenance of Buildings and Grounds*  
*Project No. HWY-M-04-14M*  
Scale: As Shown      Date: May, 2014  
SHEET No. 2 OF 2 SHEETS