
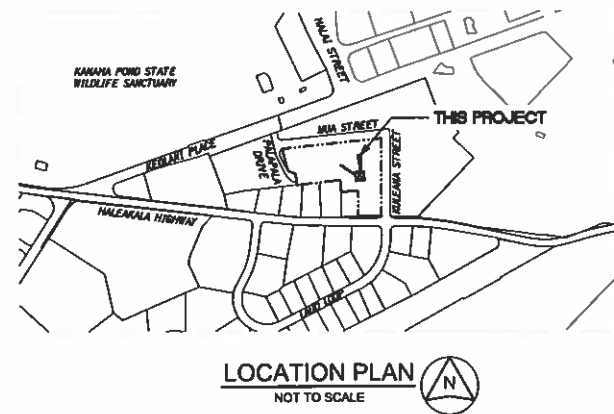
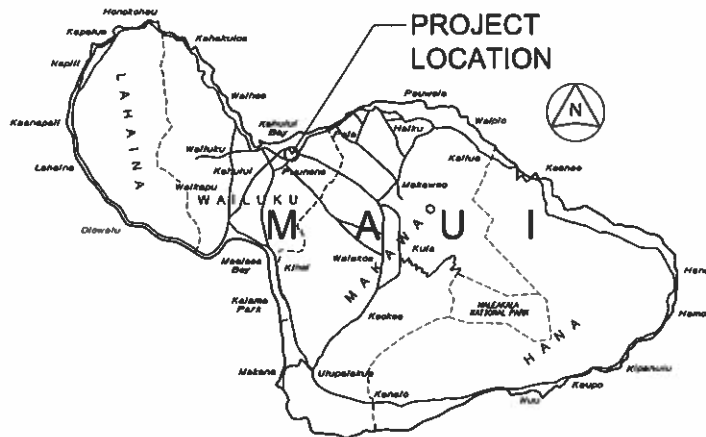


FED. ROAD DIST. NO.	STATE	PROJ. NO.	FISCAL YEAR	SHEET NO.	TOTAL SHEETS
HAWAII	HAW.	HWY-3A-03-21, PHASE 2	2022	1	48

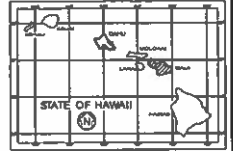

LOCATION PLAN
NOT TO SCALE

DEPARTMENT OF TRANSPORTATION STATE OF HAWAII	
APPROVED: 	Sep 2 1992
DIR. OF TRANSPORTATION	DATE

MITTACO CONSULTING GROUP DESIGNED BY	HWY-MW MANAGED BY	(808) 873-3535 PHONE	JULY 2022 DATE
---	----------------------	-------------------------	-------------------