


FINAL SURVEY	BY	DATE	SURVEYED	
			NOTED	
			REPLATE	
			AREAS CHECKED	
NO.				


ORIGINAL SURVEY	BY	DATE	SURVEYED	
			NOTED	
			REPLATE	
			AREAS CHECKED	
NO.				

FED. ROAD DIST. No.	STATE	FED. AID PROJ. No.	FISCAL YEAR	SHEET No.	TOTAL SHEETS
HAWAII	HAW.	3044061	1952	12	73

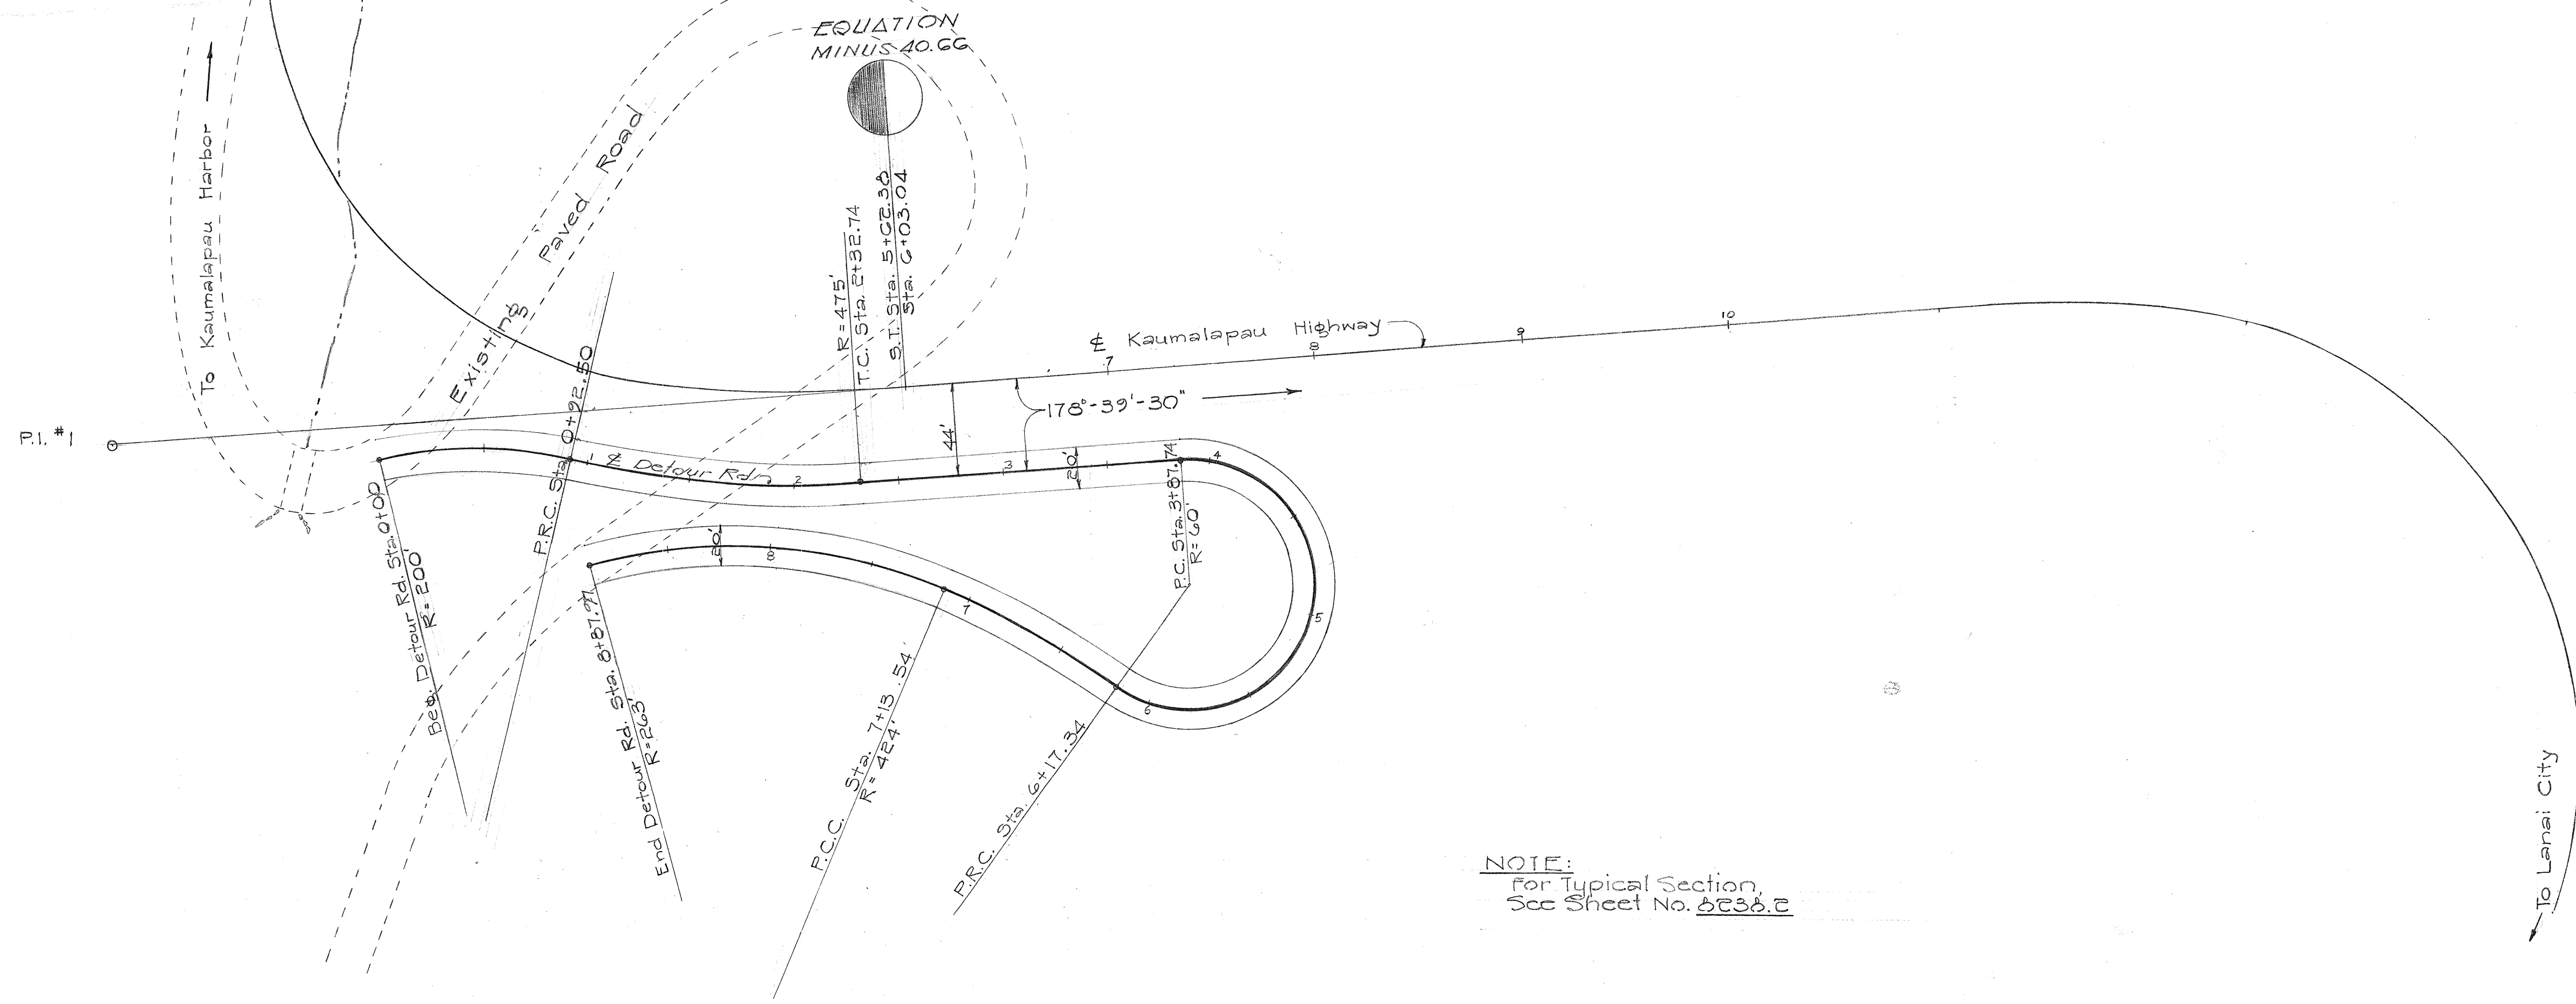

TRUE NORTH
Scale: 1"=50'

NOTE:
For Typical Section,
See Sheet No. S238.2

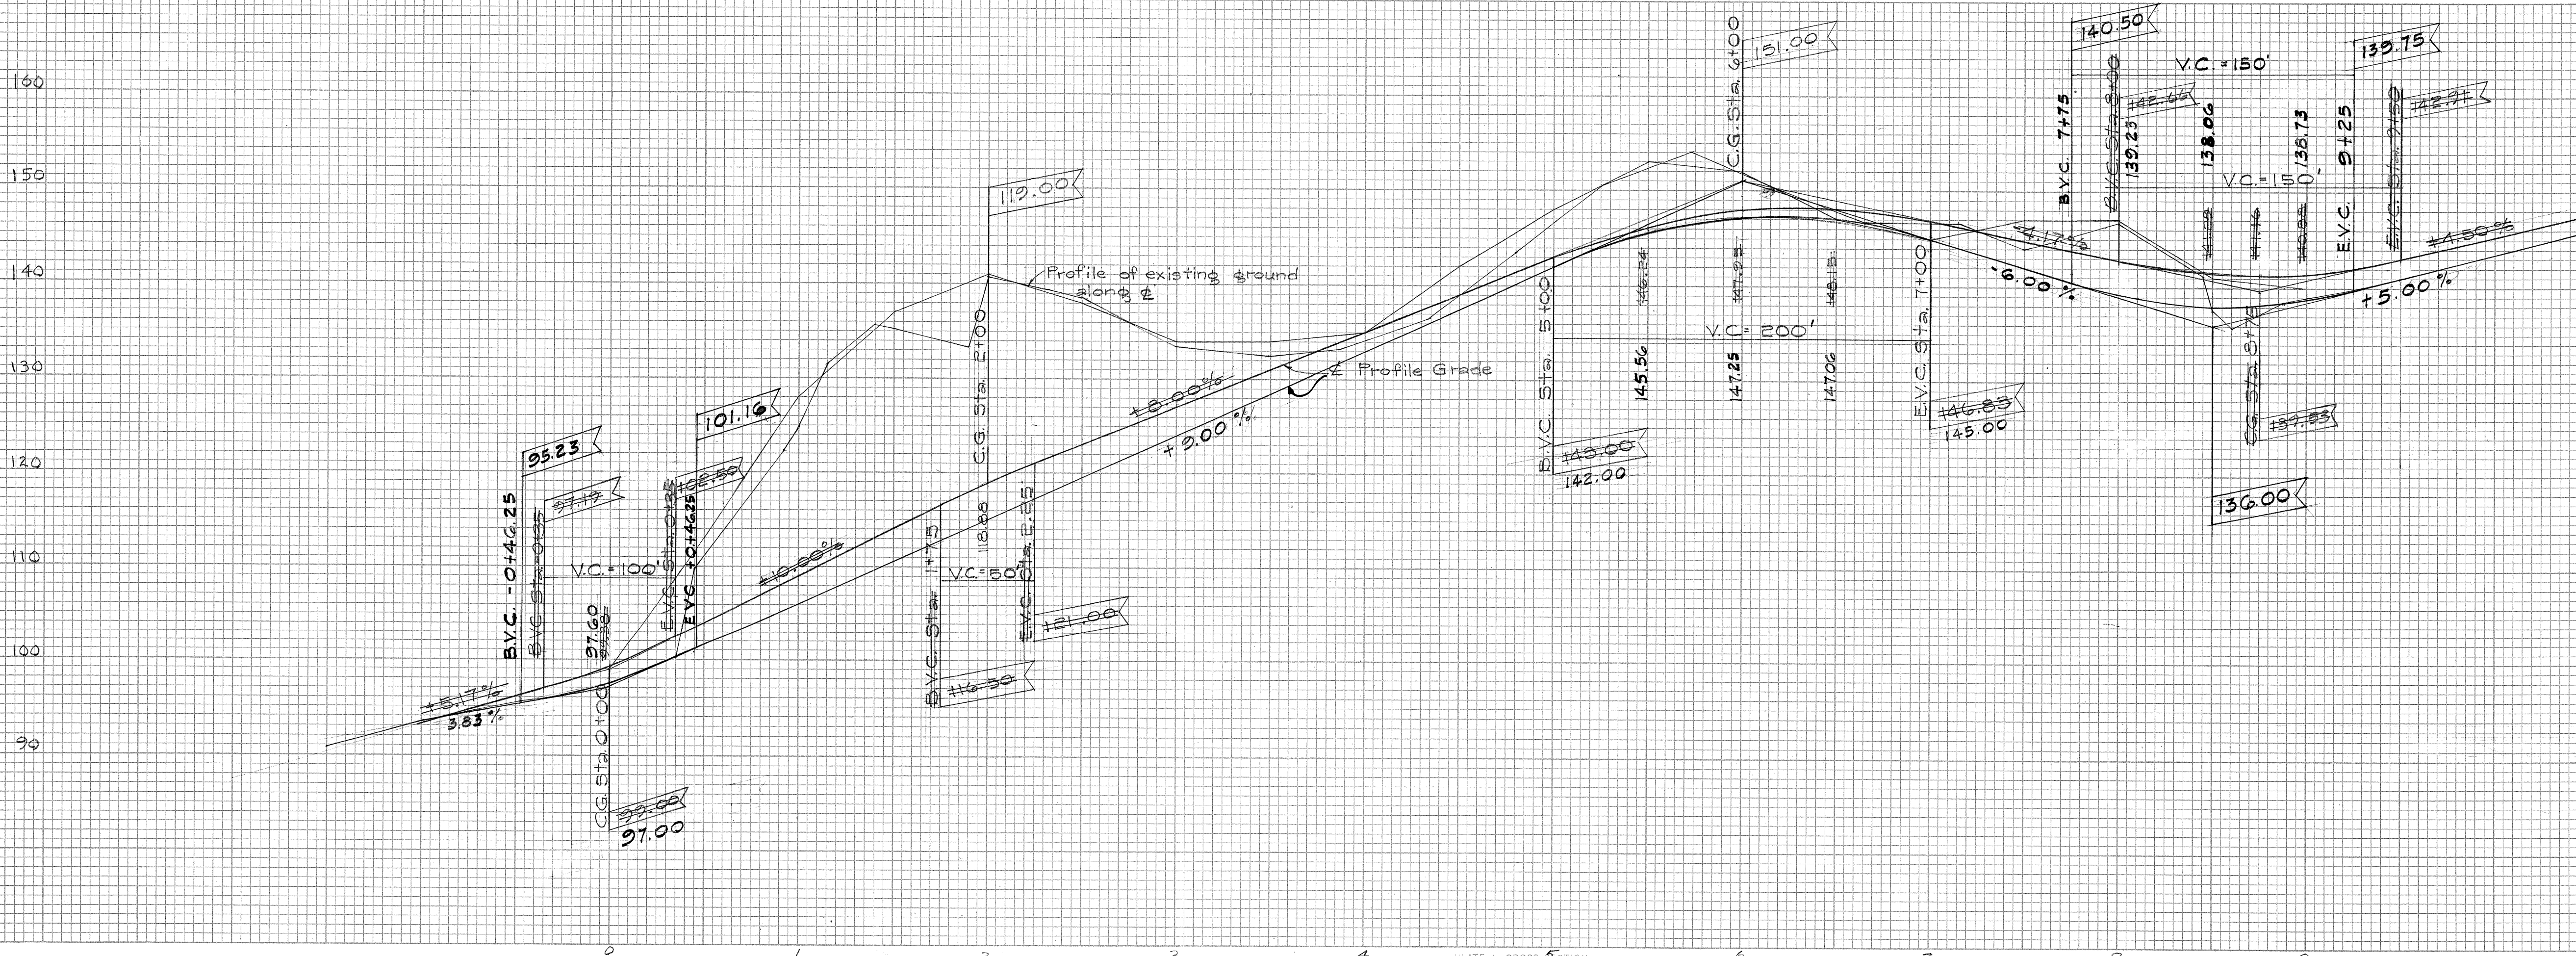

DETOUR ROAD